


No.	Date	Rev. by	Description
T01	29.10.2025	HE	Coordinated with Structures & Civils
T02	10.11.2025	LP	Coordinated with latest site levels
			substructure detail references,
			window & door references added
C01	16.12.2025	LP	Superstructure Construction Issue
C02	10.03.2026	LP	Swift box added and set out.
C03	15.04.2026	LP	Updated to coordinate with truss
			manufacturer design to change
			trusses to 222mm
C04	20.04.2026	MTP	Additional Swift Boxes as clouded
C05	27.04.2026	LP	Material key updated to include note
			for coloured mortar & patio doors
			updates to client markup
C06	27.05.2026	HE	External electric box shown as per client
			email 21/05/2026. See revision cloud.




FRONT ELEVATION

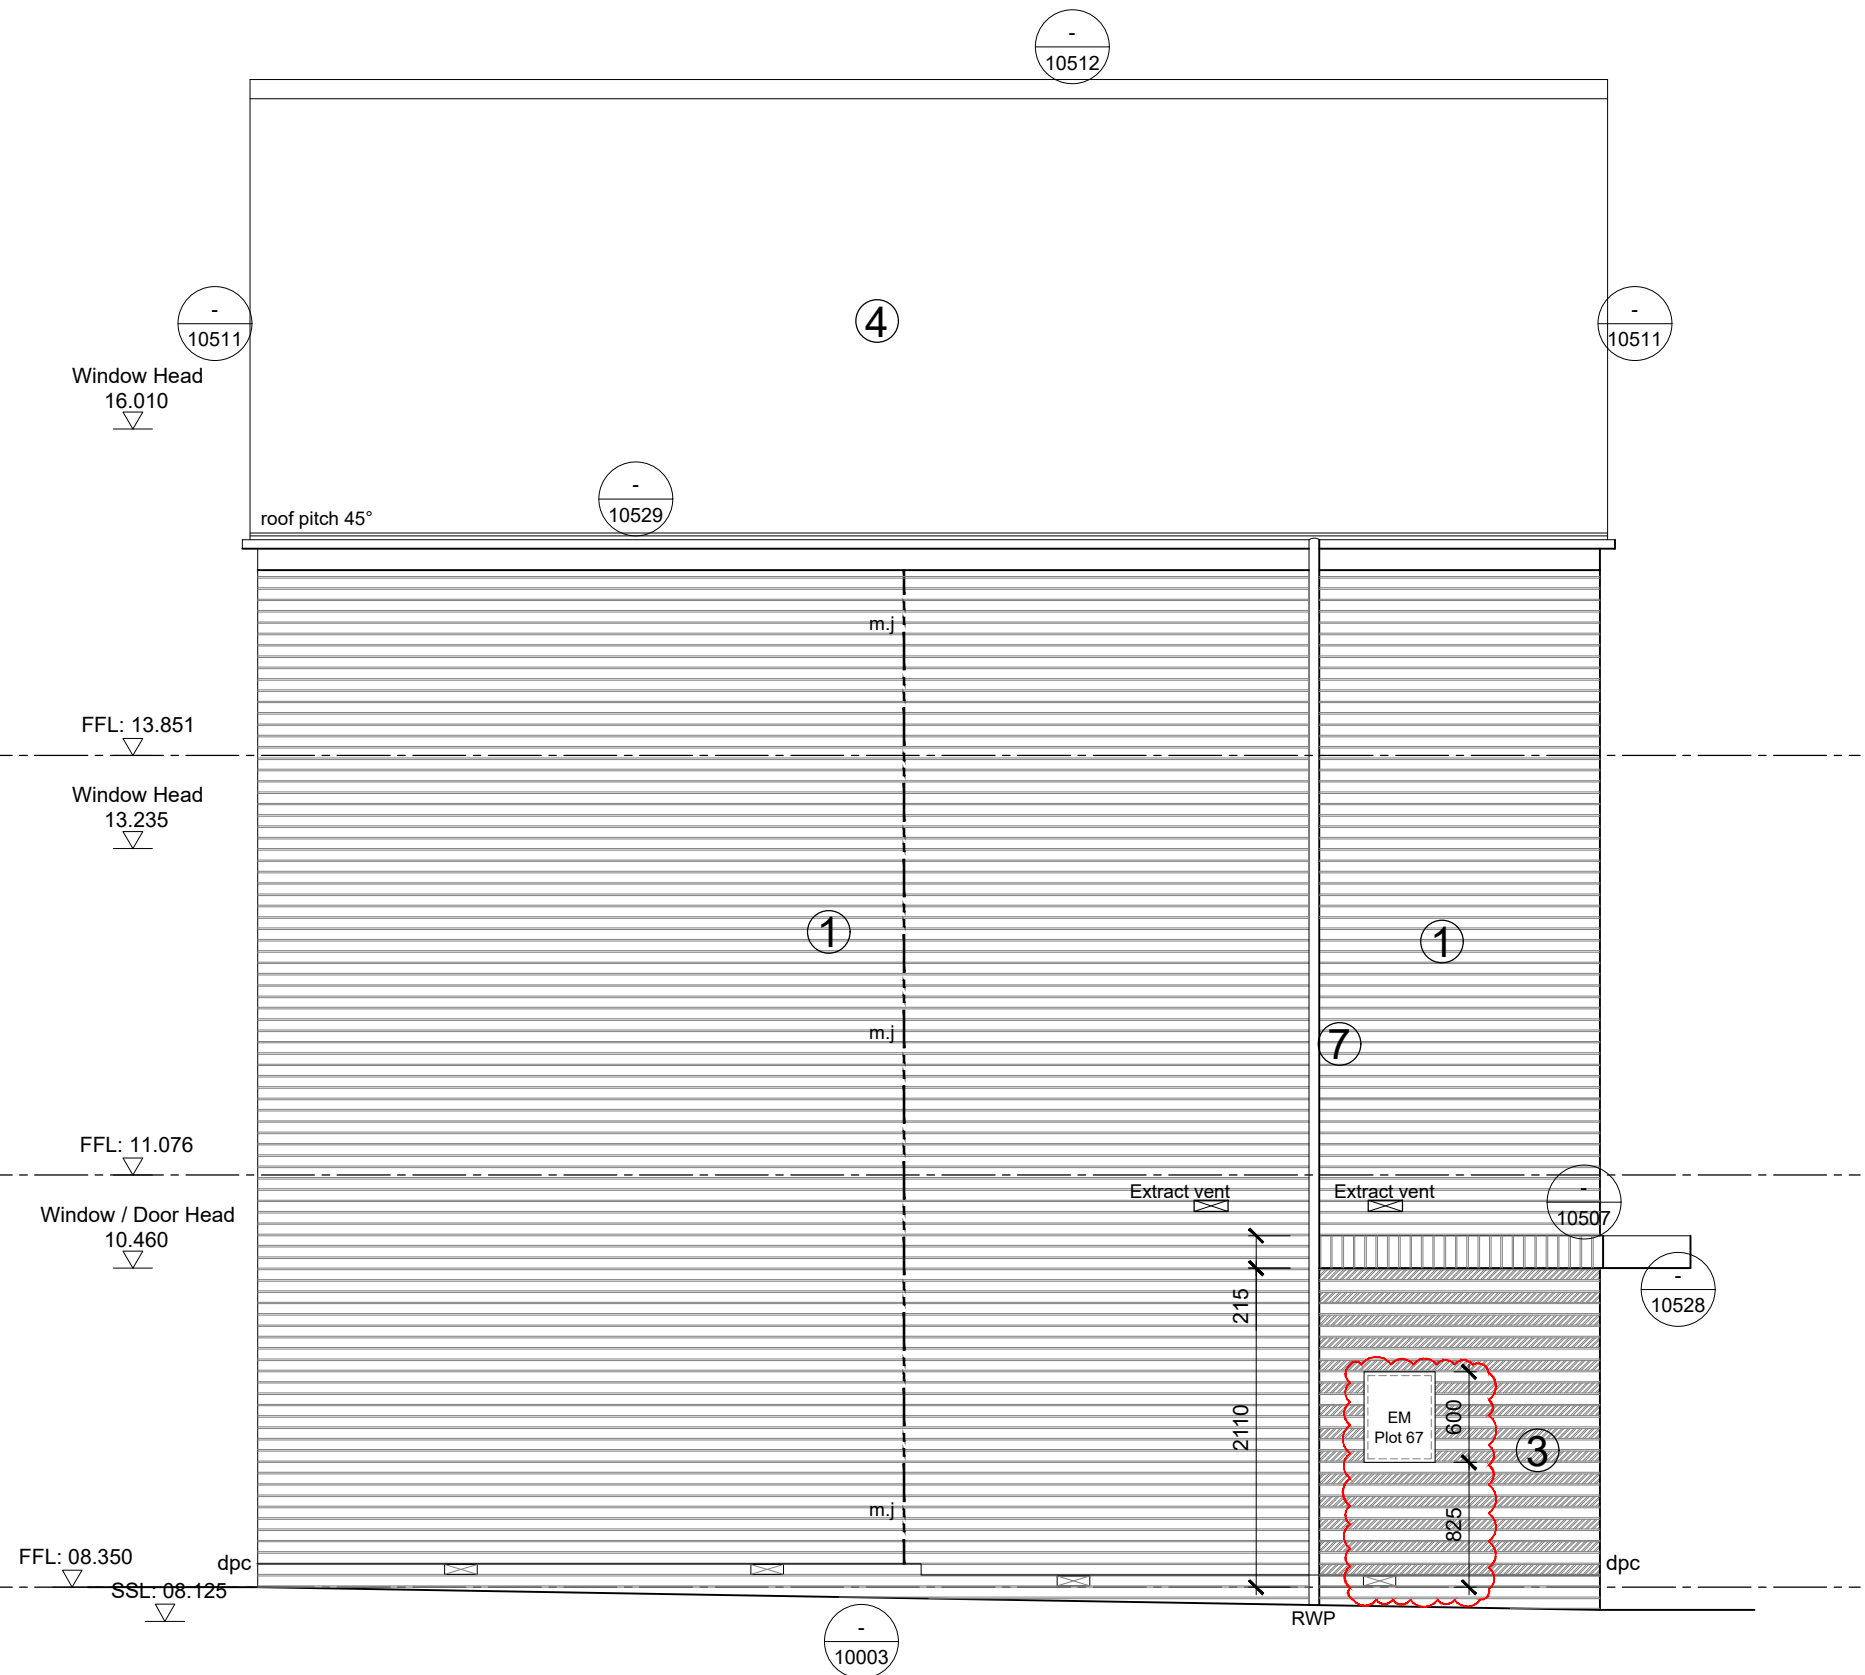

SIDE ELEVATION



REAR ELEVATION

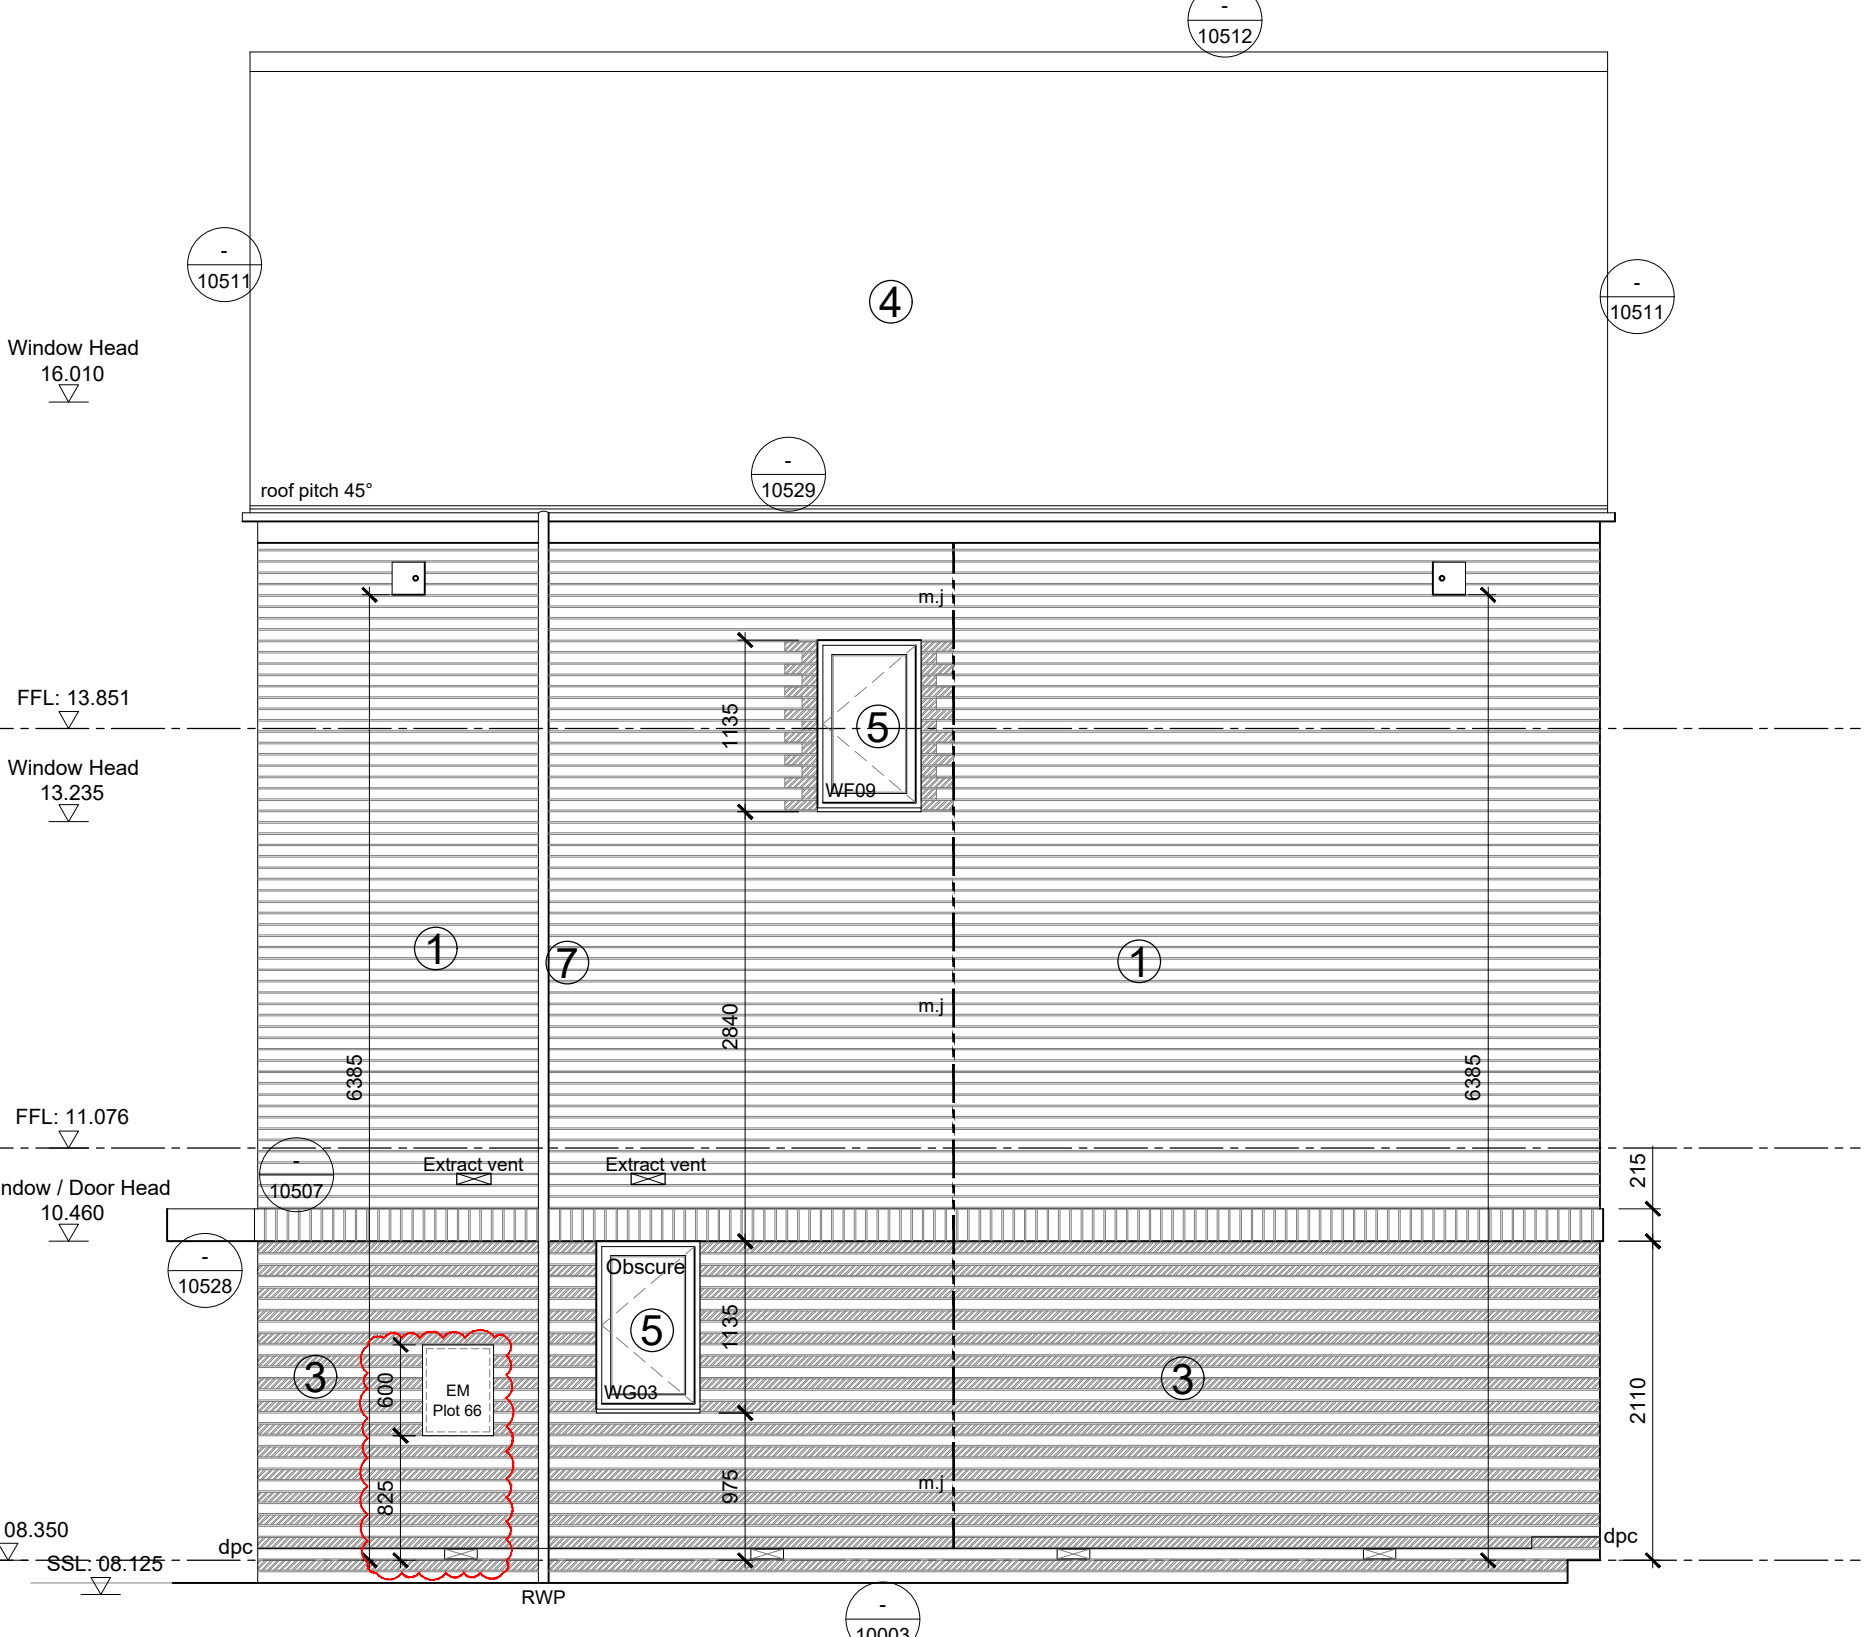

SIDE ELEVATION

KEY TO SYMBOLS ELEVATION	
	Indicates position of tile vents
	Cold water bib tap
	Movement Joint positions are shown indicatively. Structural engineer to confirm locations
	External door reference
	Window reference
	Windows marked thus to be egress windows
	Indicates location of safety glass
	Indicates obscure glazing
	Detail Drawing Number
	Swift Brick

Materials Key:

- 1 - Brick Type 1: Cream
- 2 - Brick Type 2: White
- 3 - Alternating courses of brick type 1 and 2 with Grey mortar (terminating at top in brick type 2)
- 4 - Charcoal Grey Roof Tile
- 5 - UPVC Windows and Doors - Black
- 6 - GRP Front Doors - Black
- 7 - Black Rainwater Goods

Refer to Materials Schedule for specified items

CLAGUE ARCHITECTS
www.clague.co.uk 01227 702 060 info@clague.co.uk

Client
Hill Residential

Project Title
Proposed Residential Development
Milton Place
Gravesend
Kent

Drawing Description
Plot 66 & 67
House Type - H3 (Walbury)
Elevations

Scale Date Created Checked
1:50 @ A1 September 2025 LB

Drawing Status

CONSTRUCTION

Drawing Number Revision

MPG-CLA-H3-ZZ-D-A-04800 C06

Scale 1:100

