

No.	Date	Rev. by	Description
T01	29.10.2025	HE	Coordinated with Structures & Civils
T02	11.11.2025	LP	Coordinated with latest site levels substructure detail references, window & door references added
C01	17.12.2025	LP	Superstructure Construction Issue
C02	10.03.2026	LP	Swift box added and set out.
C03	15.04.2026	LP	Updated to coordinate with truss manufacturer design to change trusses to 222mm
C04	27.04.2026	LP	Material key updated to include note for coloured mortar & patio doors updates to client markup
C05	27.05.2026	HE	External electric box shown as per client email 21/05/2026. See revision cloud.



FRONT ELEVATION


SIDE ELEVATION

KEY TO SYMBOLS ELEVATION	
	Indicates position of tile vents
	Cold water bib tap
	Movement Joint positions are shown indicatively. Structural engineer to confirm locations
	External door reference
	Window reference
	Windows marked thus to be egress windows
	Indicates location of safety glass
	Indicates obscure glazing
	Detail Drawing Number
	Swift Brick

Materials Key:

1 - Brick Type 1: Cream
2 - Brick Type 2: White
3 - Alternating courses of brick type 1 and 2 with
Grey mortar (terminating at top in brick type 2)
4 - Charcoal Grey Roof Tile
5 - UPVC Windows and Doors - Black
6 - GRP Front Doors - Black
7 - Black Rainwater Goods

Refer to Materials Schedule for specified items

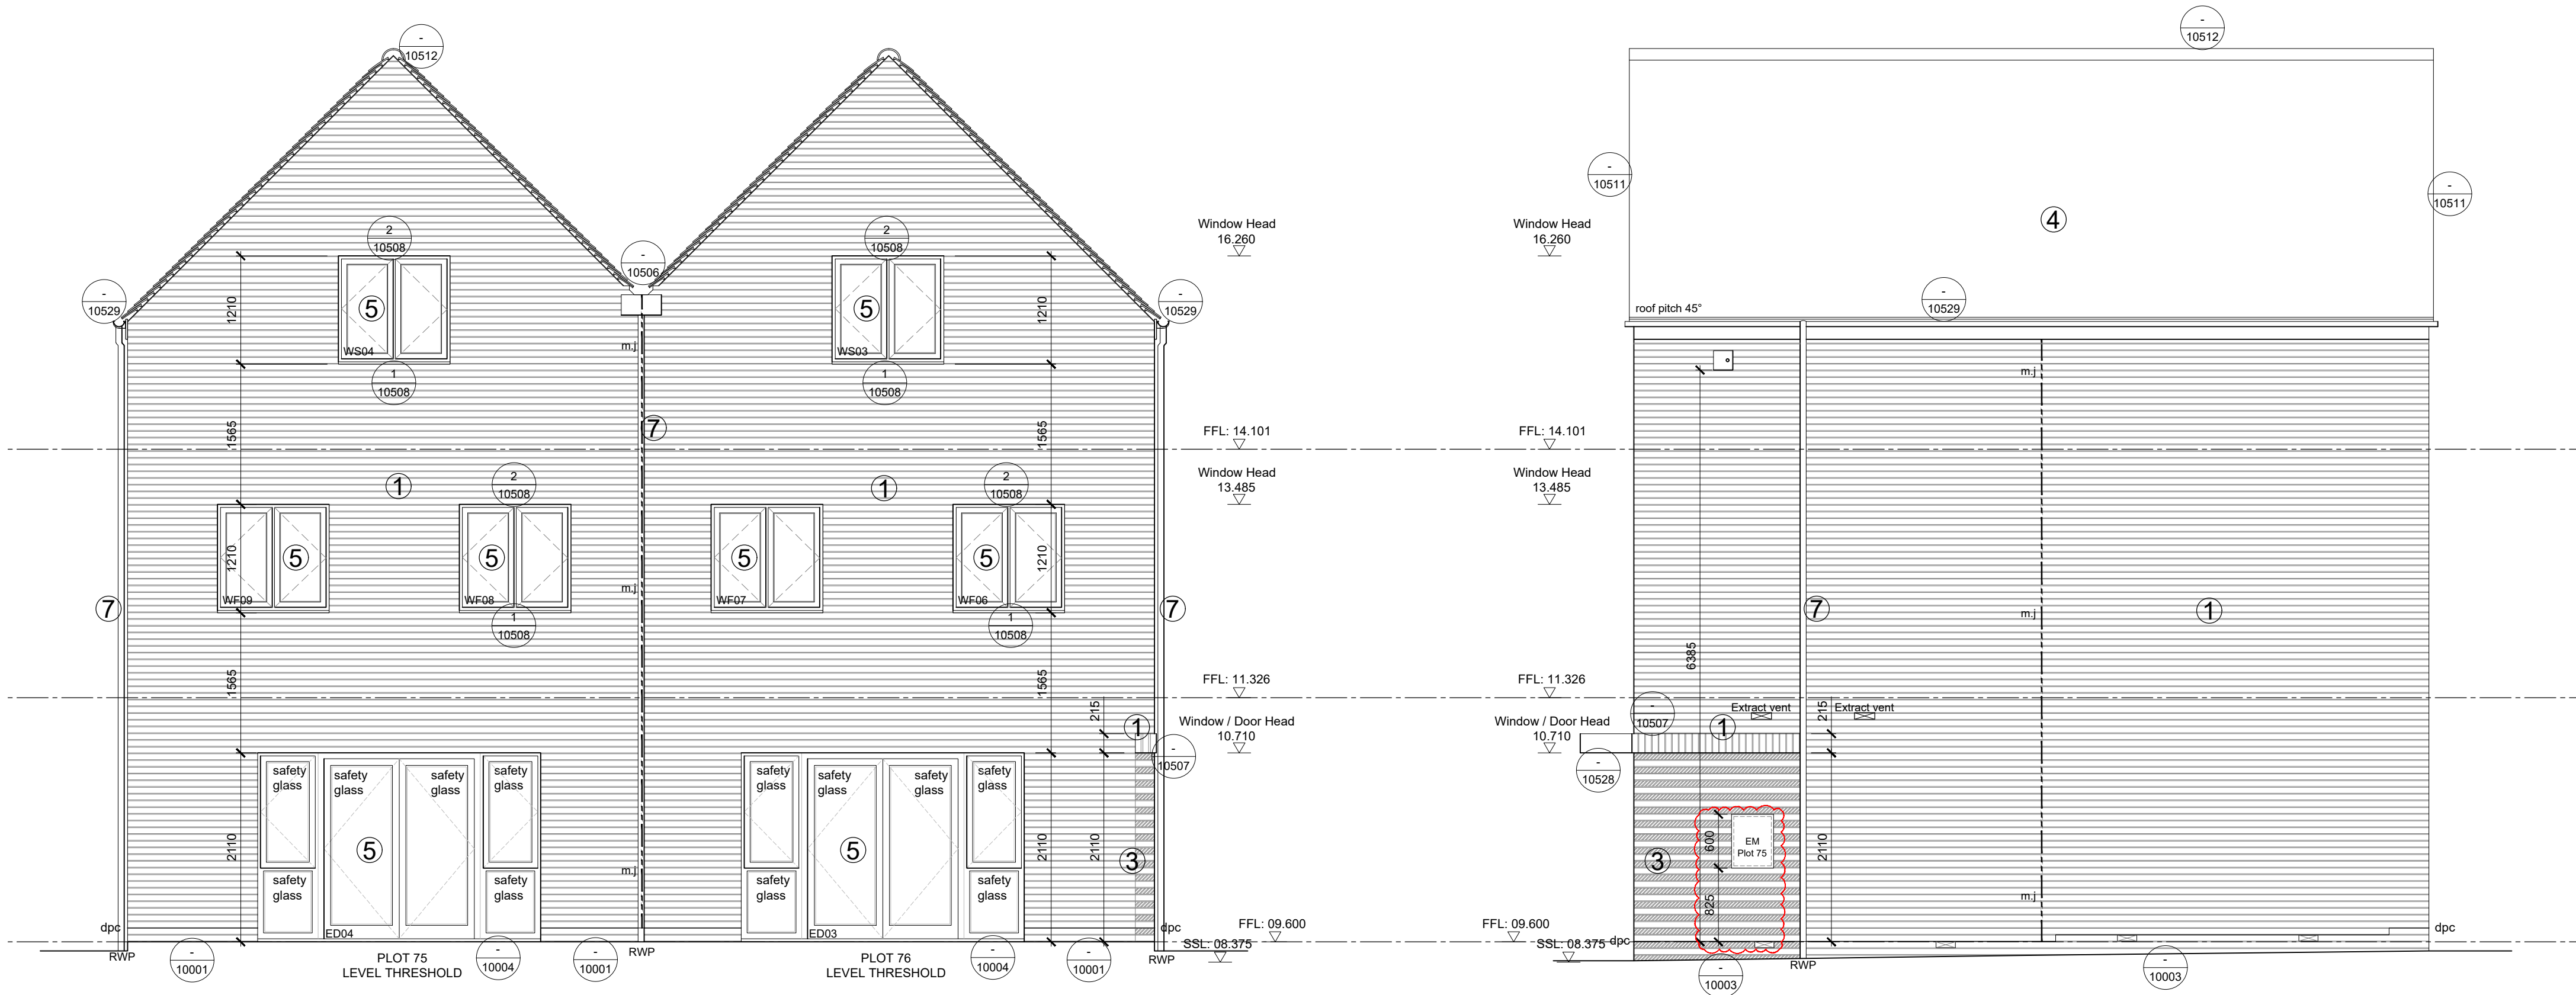

REAR ELEVATION

SIDE ELEVATION

CLAGUE ARCHITECTS

www.clague.co.uk 01227 702 060 info@clague.co.uk

Client
Hill Residential

Project Title
Proposed Residential Development
Milton Place
Gravesend
Kent

Drawing Description
Plot 75 & 76
House Type - H3 (Walbury)
Elevations

Scale Date Created Checked
1:50 @ A1 September 2025 LB

Drawing Status

CONSTRUCTION

Drawing Number Revision
MPG-CLA-H3-ZZ-D-A-09800 C05

