




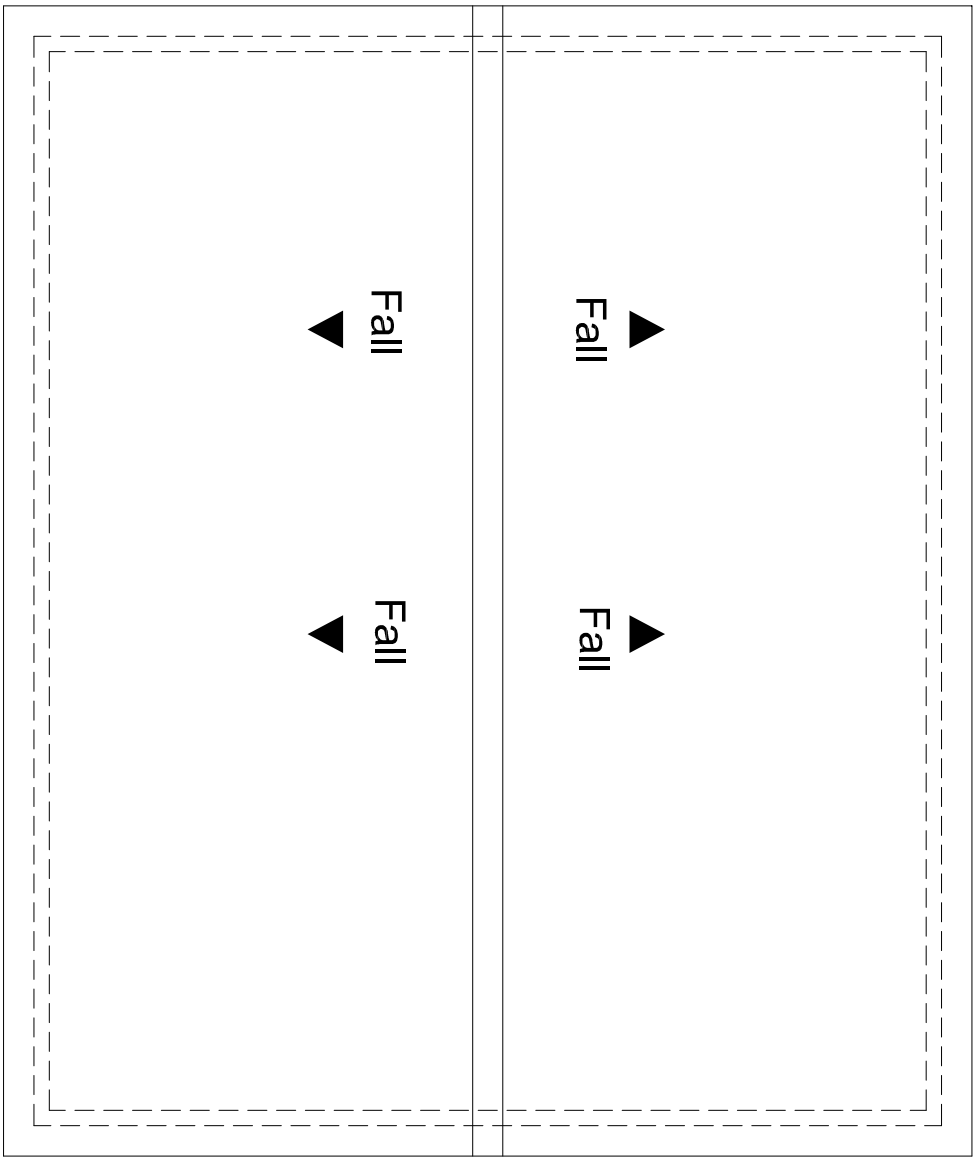


ROOF PLAN

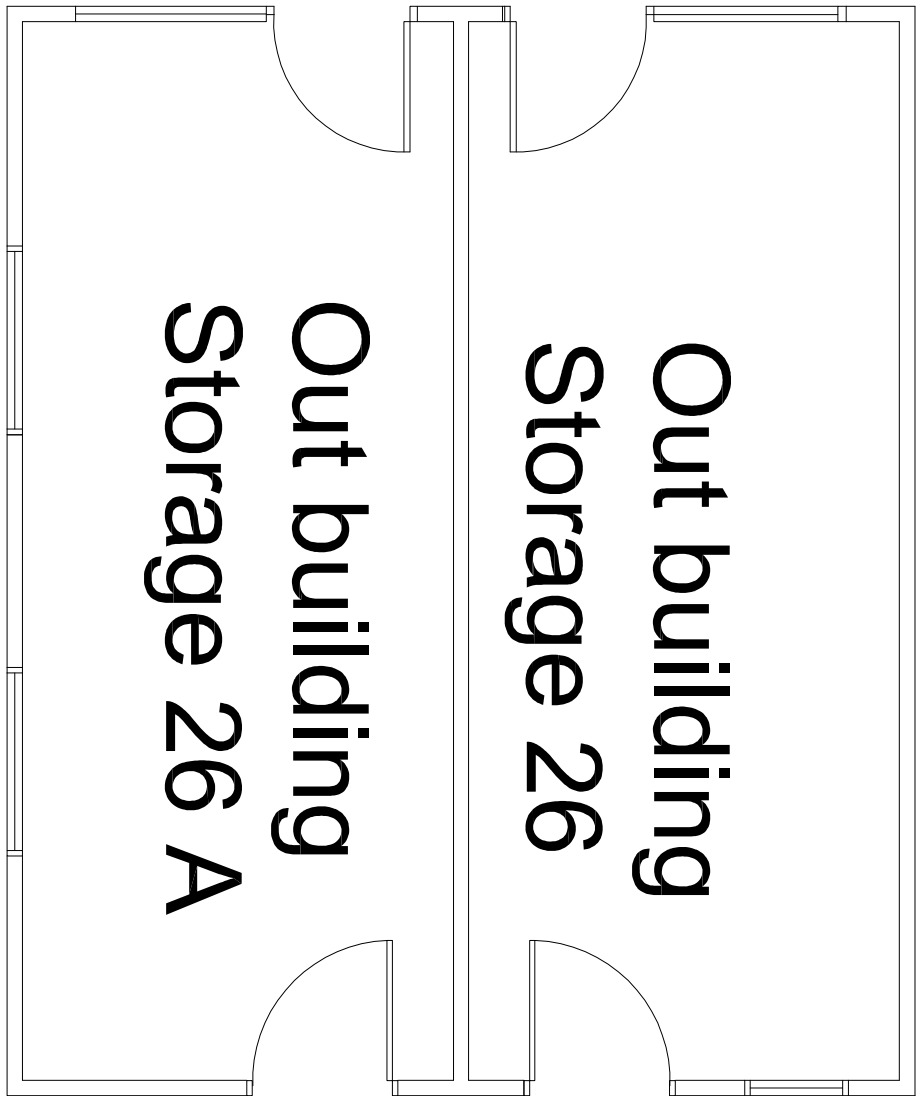


GROUND FLOOR

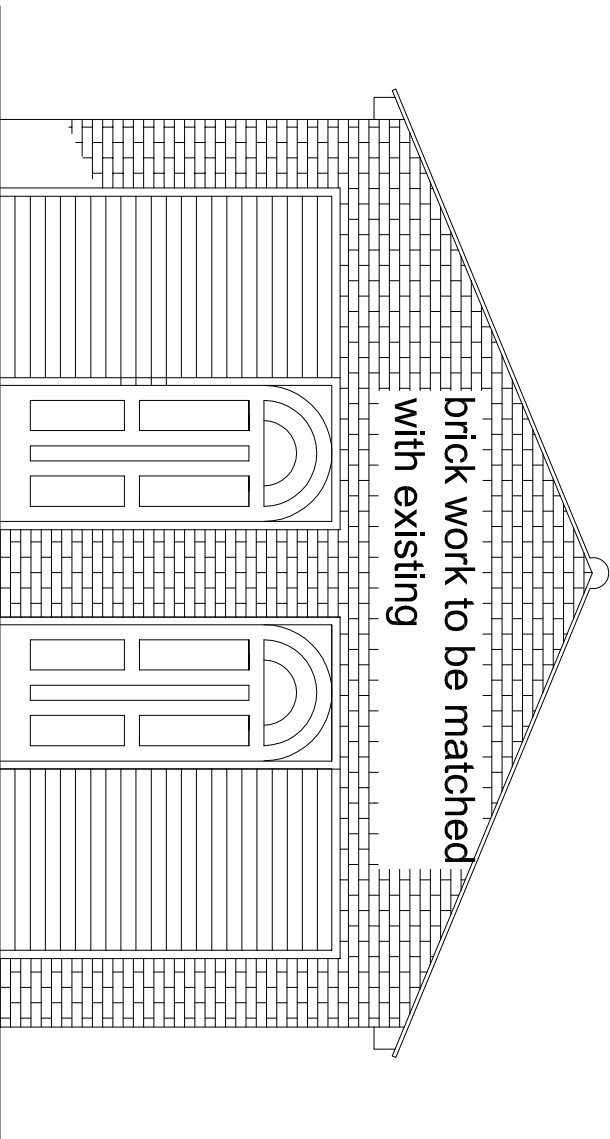


NORTH EAST
ELEVATION

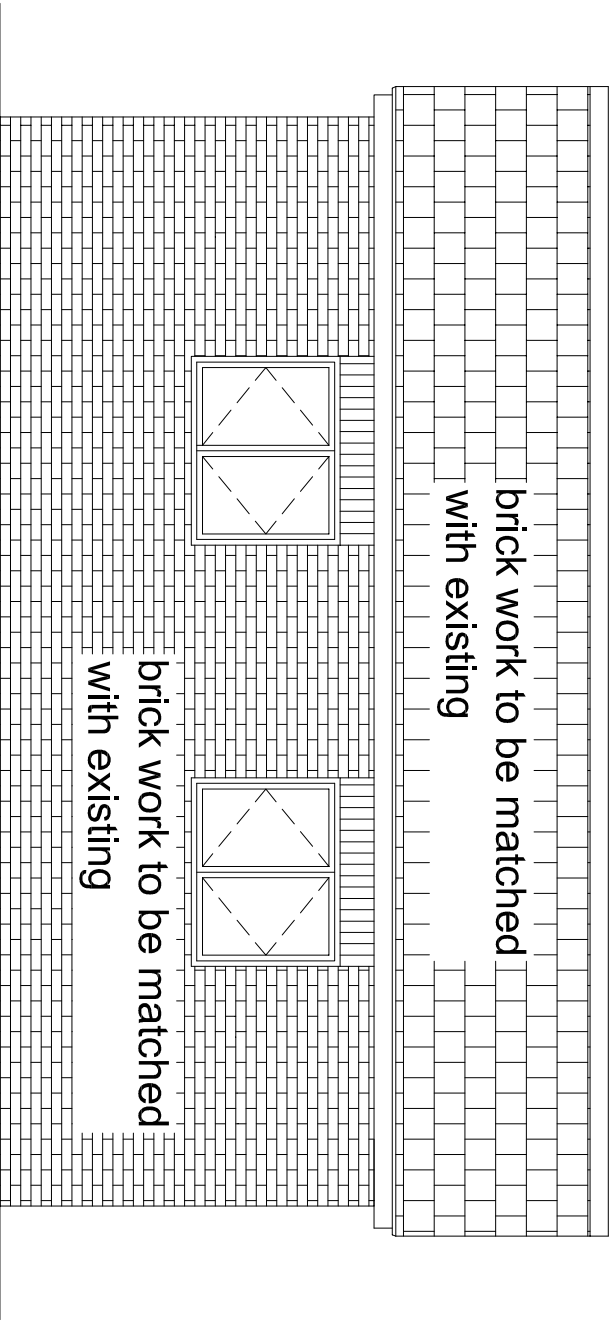


NORTH WEST
ELEVATION

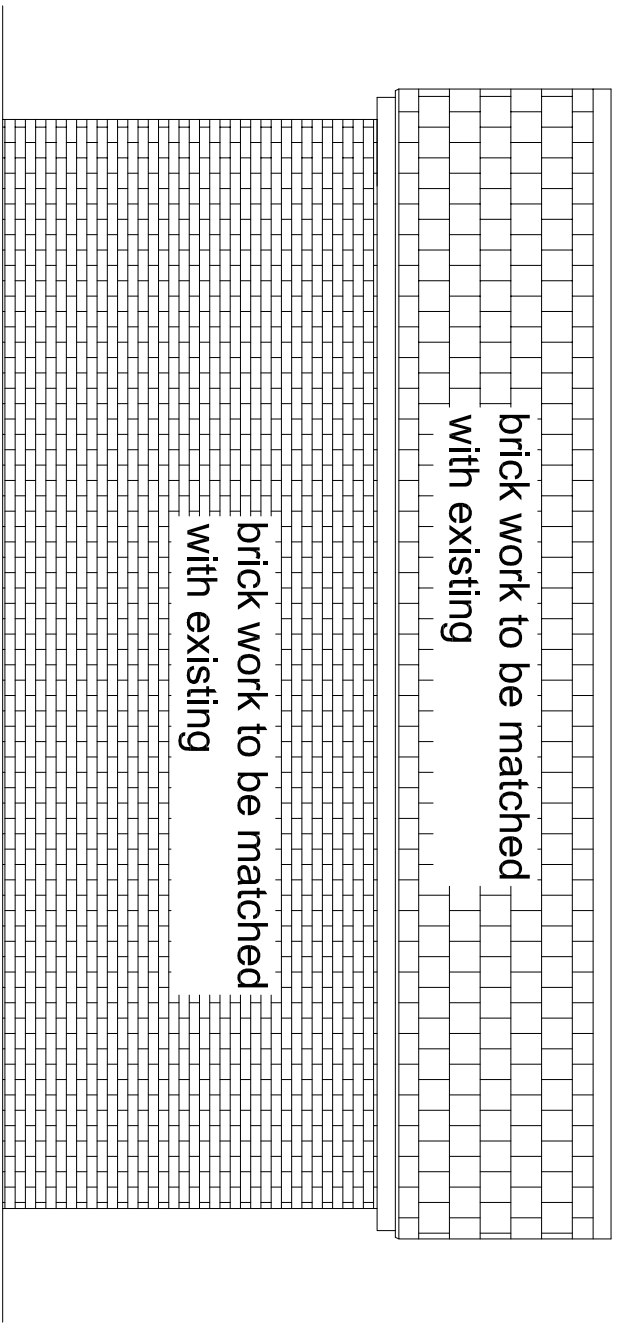

SOUTH EAST
ELEVATION

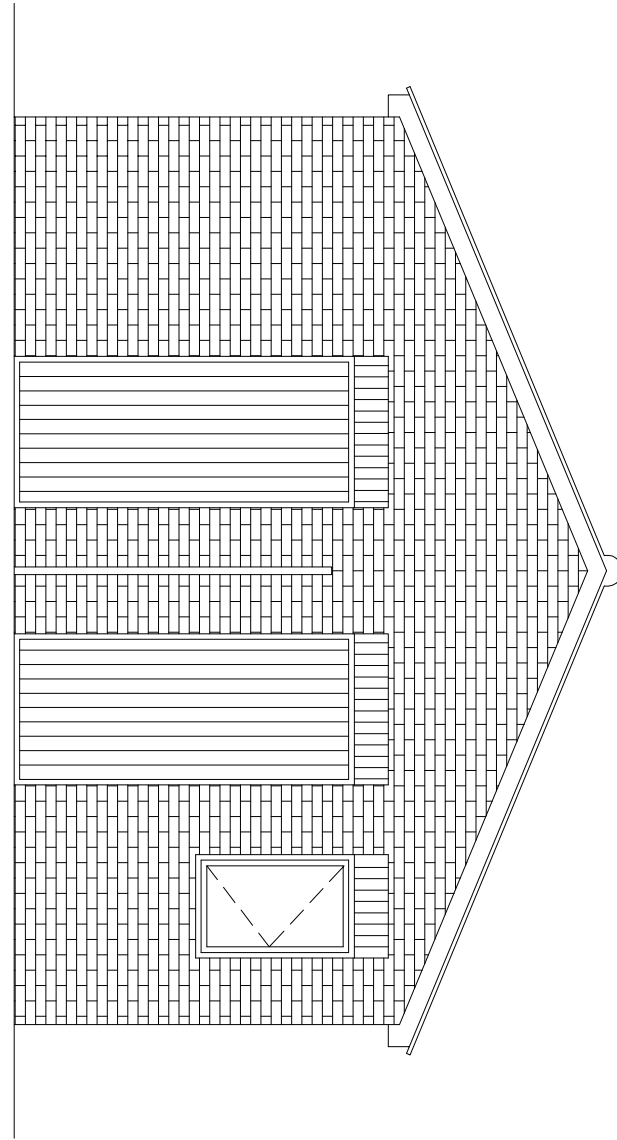

SOUTH WEST
ELEVATION

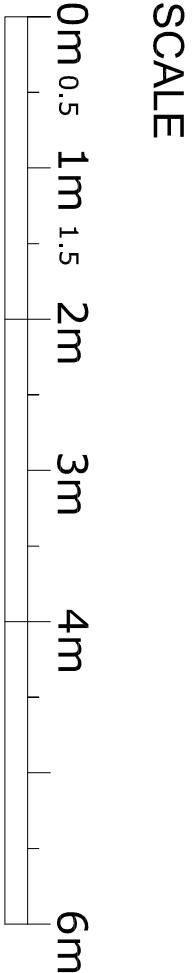

Future Vision Planning & Development consultants	
Site - 104 , 344-348 , High Road, Llord Essex, IG11OP Email: f.vision27@gmail.com	
CLIENT Mr. S. Singh	
JOB TITLE Replacement of car parking space to the front garden and use of garage as out building 26A, St Georges Crescent, Gravesend , DA12 4AR	
SITE 26 A. St Georges Crescent , Gravesend , DA12 4AR	
DRAWING TITLE Plans as Built Provision of car parking in front garden	
SCALE	DATE
1:50@A1	22-06-2023
DRAWING NO.	REVISION
FV-2023-06	