



EXISTING / AS BUILT ELEVATIONS



FRONT (WEST) ELEVATION

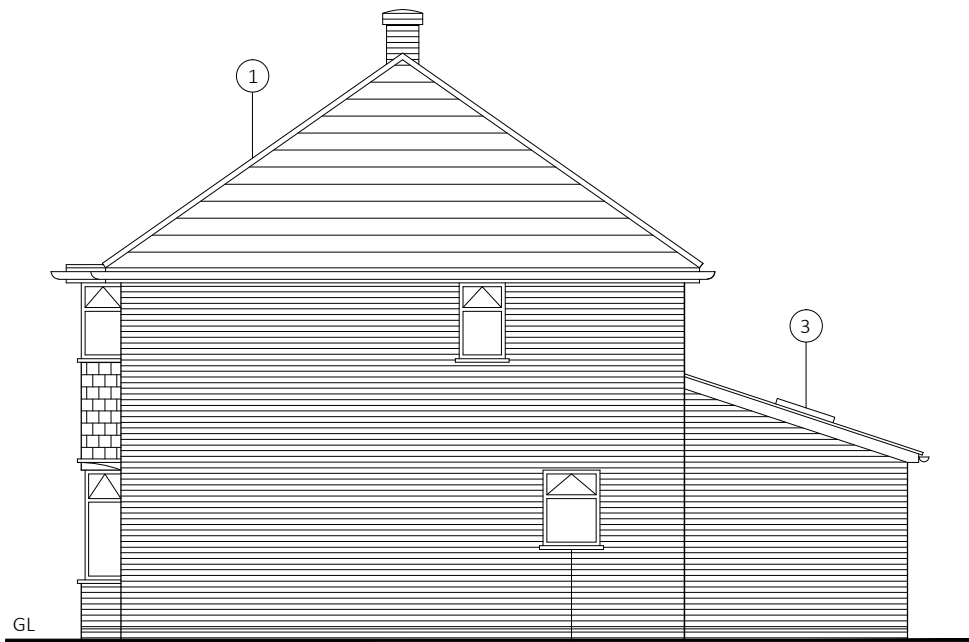

SIDE (SOUTH) ELEVATION

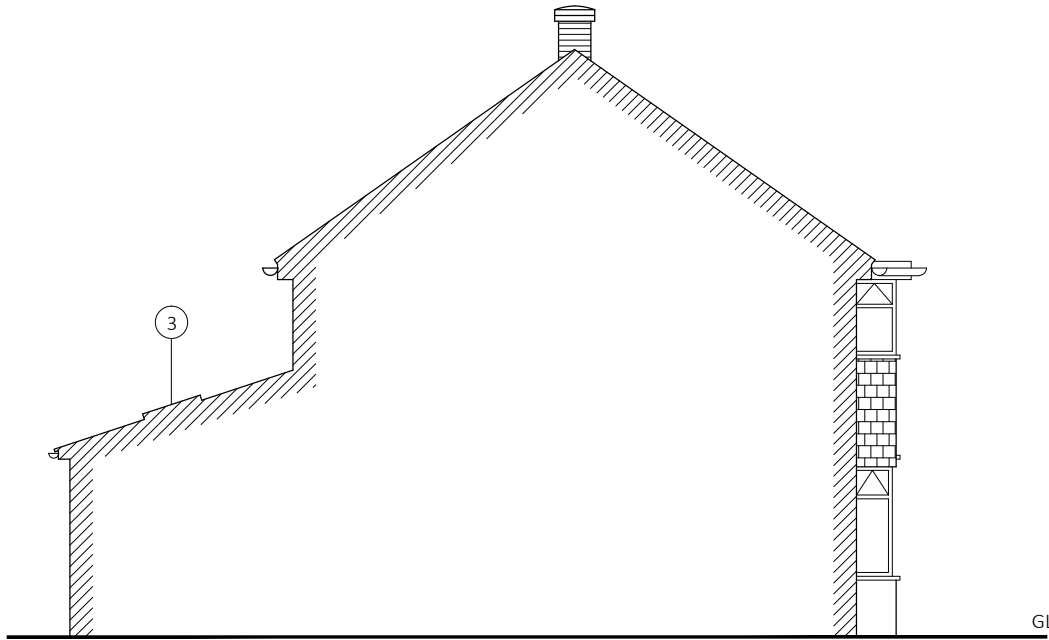


SIDE (NORTH) ELEVATION
Cross Section - As viewed from 38 Sirdar Strand

LEDGER


- 1 = 36 Sirdar Strand
2 = 38 Sirdar Strand
With asproved developments
3 = Existing rear extension - 36 Sirdar Strand
4 = Door replaced with window -
Installed during rear elevation construction 2016 / 2017

GL = Ground Level

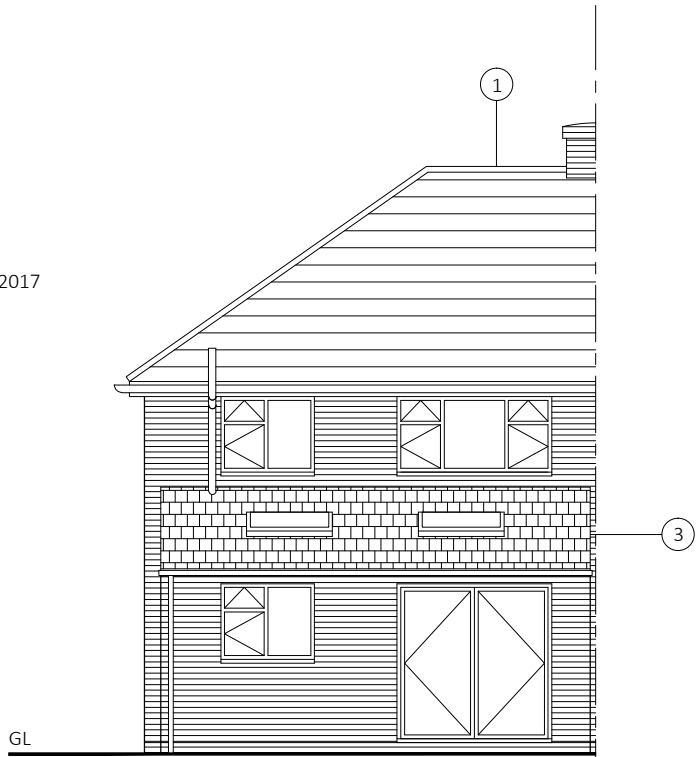

REAR (EAST) ELEVATION

Do not scale this drawing
All dimension must be checked on site before fabrication / construction
Material & workmanship to be to the best of their respective kind and in accordance with current British and European Standards & Codes of Practice, Statutory Authority & Manufacturers recommendations / specification

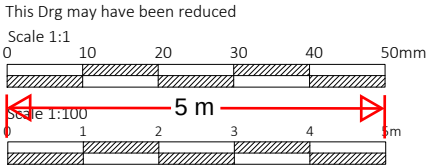

Notes / Ledger

J M D
Property Services

28 Sirdar Strand
Riverview Park
Gravesend
Kent.
DA12 4LP
t : 01474 740299
e: info@jmdd.co.uk

Client / Location
Mr & Mrs Neale
36 Sirdar Strand
Gravesend
Kent
DA12 4LP

Job Title
36 Sirdar Strand
Non-Material Admendments to
Application 20160723 - Dated15/09/16

Drawing Title
As Build Elevations
(Non - material planning application)

Scale
1:100 @ A3

Date
May - 2024

Designed by
MB

Drawn by
MB

Checked by
Client (CL)

Approved by
Client

Drawing No.
JMD-1226-B-110

Revision
P1

Status
Planning Issue

File Ref: JMD-1226-E-01Drawings-02