



Obscured glazed screen on parapet wall - total height 1.8m min off terrace level

NEW 1800mm HIGH PRIVACY SCREEN (GLASS)

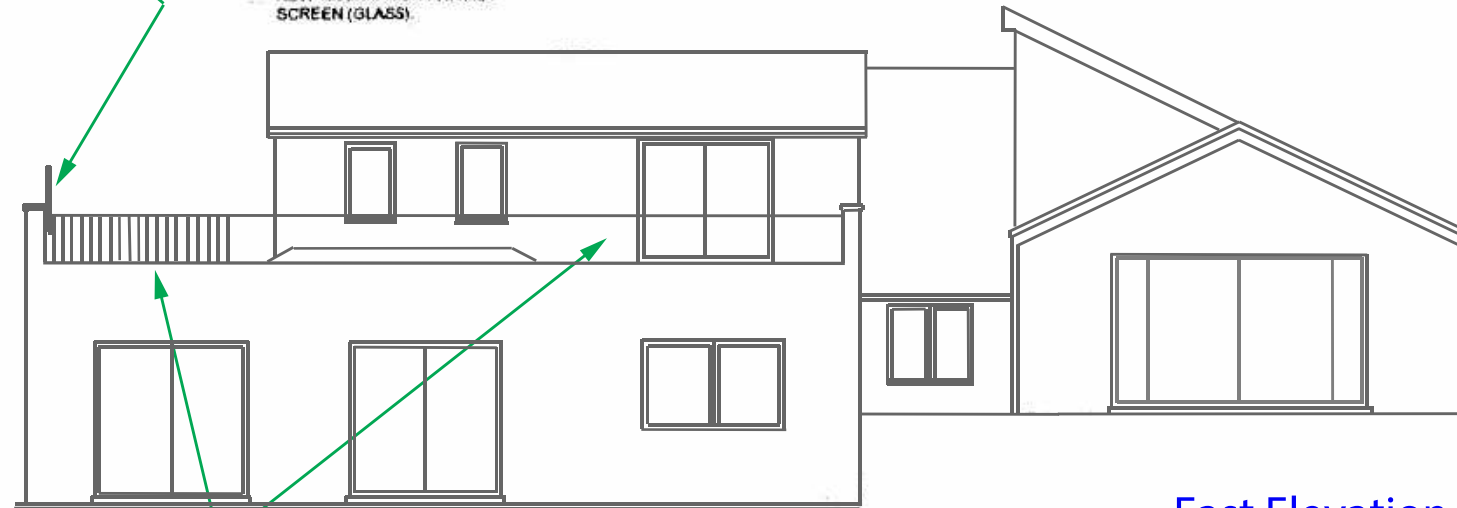

East Elevation

Railings to same height as parapet wall throughout

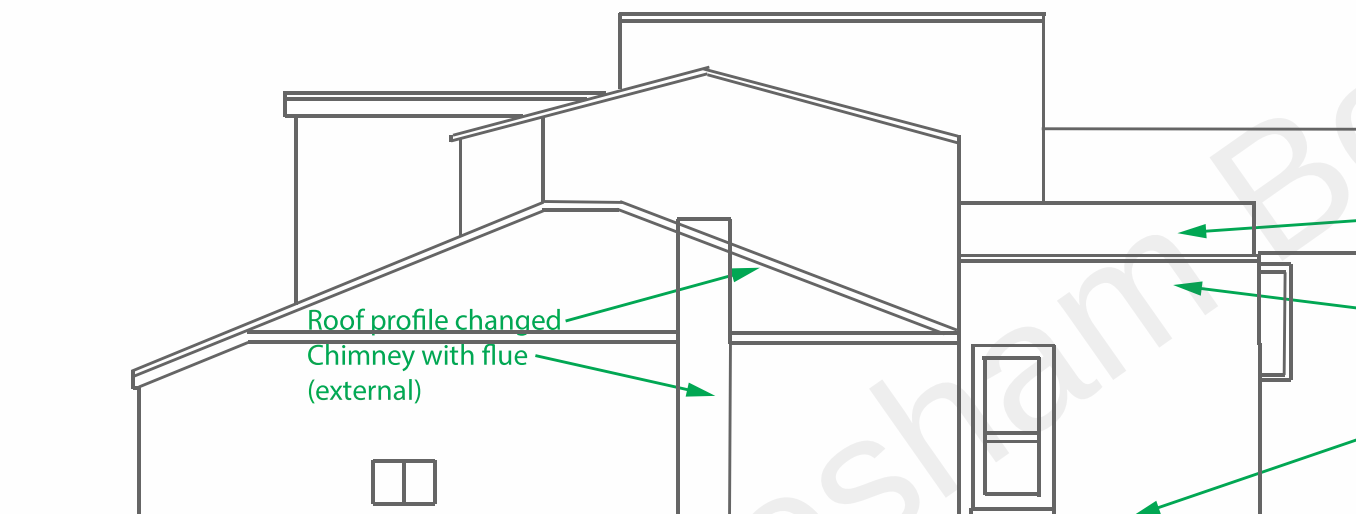

South Elevation

Obscure glazed screen as above

Parapet wall

Decking



NOTES:

Planning Drawing Only

All dimensions must be checked on site

Client

c/o Agent

Job Title

41A Forge Lane

Scale

1:100@A3L

Drawn by

MS

Date

SEP2021

Drawing Title

As Built S&E Elevations

Drg No.

0795.P.0702

Rev

H