


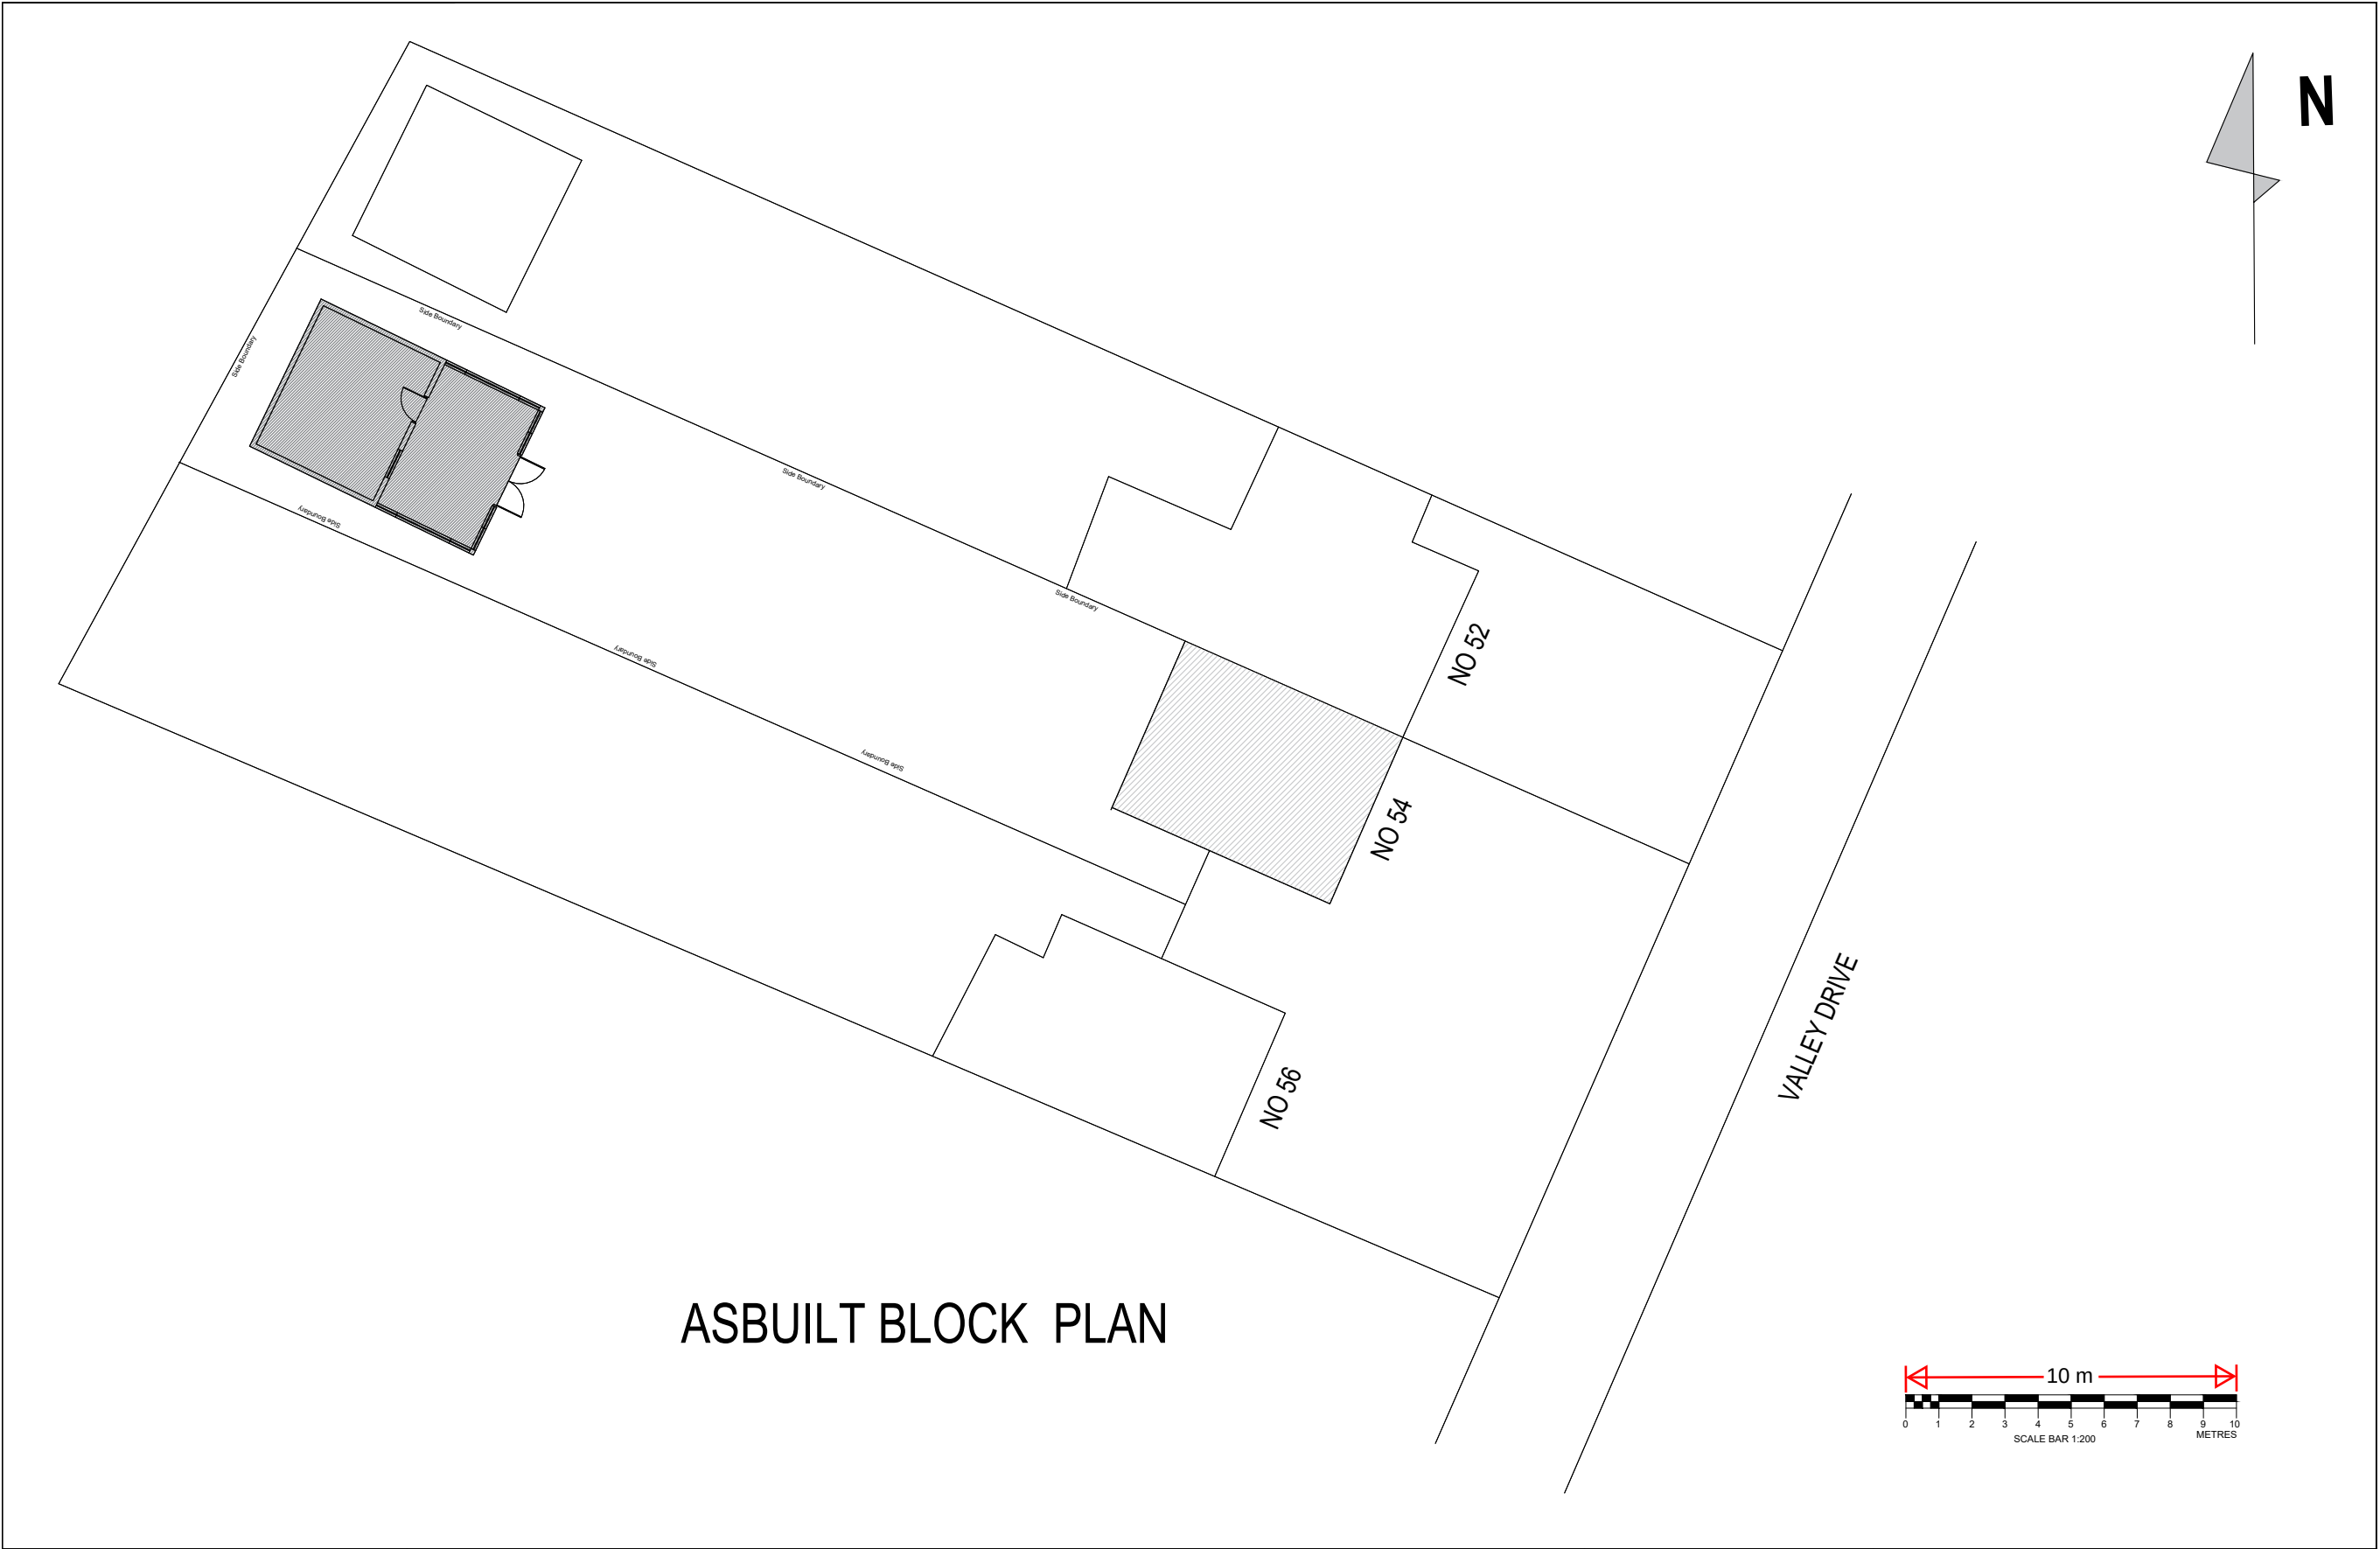

DWG NO : 54 -DA12 5RS -002 Rev 1.0	ASBUILT BLOCK PLAN	NOTE: All the Elevations are drawn above ground floor level. Sub structures are not drawn.	KOVIL CONSULTANCY	
DWG UNITS : ALL UNITS IN MILLIMETER			PROJECT : 54, VALLEY DRIVE , GRAVESEND, DA12 5RS	
SCALE : 1 : 200 @ A3			TITLE : ASBUILT BLOCK PLAN	
			DRAWN BY :Sutha (SA)	DATE : 01-04-2024