


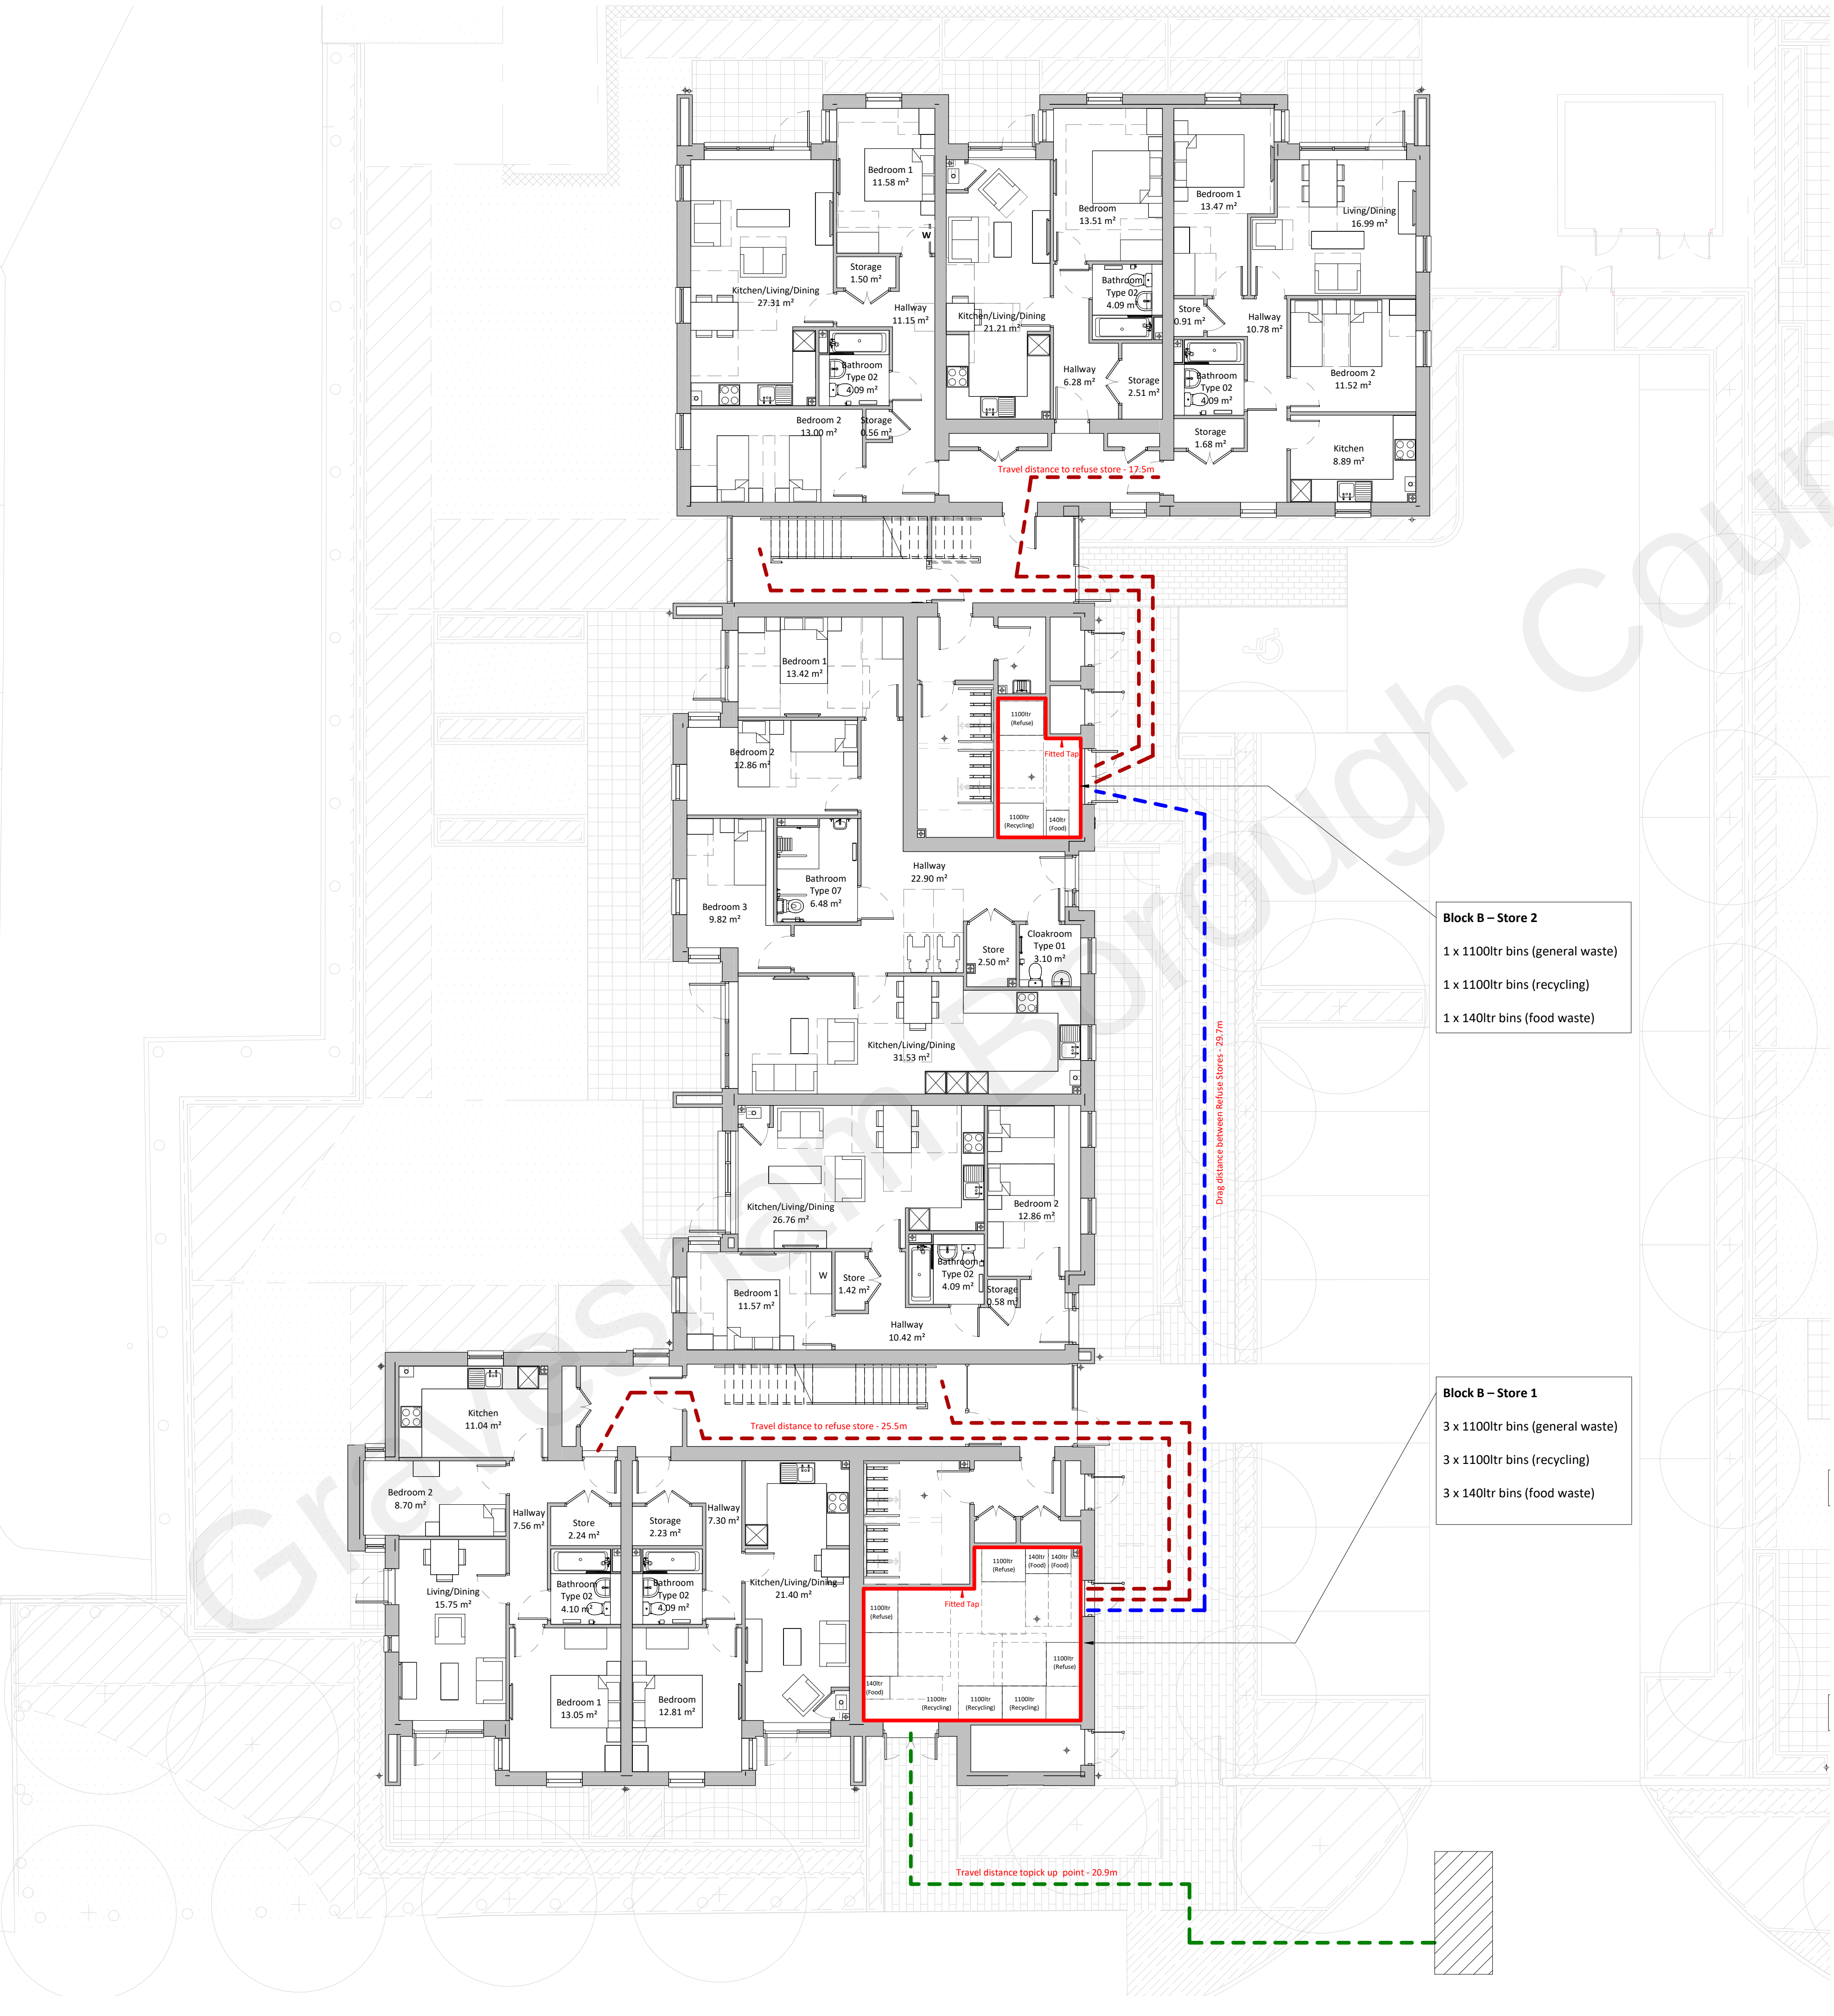

KEY	
---	Travel distance
---	Drag Distance (Management)
---	Refuse Collection (Council)
---	Communal refuse store
---	Dropped kerb - collection zone

Gravesham Borough Council provisional requirements:	
Refuse	- 1 x 1100litre bins per 6 flats
Dry Recycling	- 1 x 1100litre bins per 6 flats with special recycling lid
Food waste	- 1 x 140litre bins per 10 flats with an individual 5ltr caddy per flat
Valley Drive - Communal Refuse:	
Refuse	- 8 x 1100litre bins
Recycling	- 8 x 1100 litres bins
Food waste	- 5 x 140 litre bins
Caddy	- 48 x 5 litre bins

TO BE READ IN CONJUNCTION WITH DRAWINGS	
FOR SITE SETTING OUT AND BUILDING COORDINATES REFER TO DRAWINGS 0100 SERIES	
FOR GA FURNITURE LAYOUTS REFER TO DRAWING 1500 SERIES	
TO BE READ IN CONJUNCTION WITH WALLER GRAY STRUCTURAL DRAWINGS	
TO BE READ IN CONJUNCTION WITH M&E CONSULTANTS DRAWINGS	
TO BE READ IN CONJUNCTION WITH LANDSCAPE ARCHITECT DRAWINGS	
ALL DRAWINGS TO BE READ IN CONJUNCTION WITH FIRE REPORT	
ALL DIMENSIONS IN MILLIMETERS	
ALL DIMENSIONS TO STRUCTURE	

Notes:				
Do not scale. All dimensions are in millimetres unless otherwise stated. This drawing should be read in conjunction with all relevant project information and contract documentation. All dimensions to be checked prior to fabrication and or commencement of works. All works to comply with all relevant legal standards, building regulations and warranty provider requirements. Report any discrepancies, if in doubt ask.				

Revisions:				
Rev	Status	Date	Description	Dwn
001	S3	14.08.20	Preliminary Issue	JS
001	CR	14.03.22	As Built Issue	TL

Client Name:		Westridge	
Project Name:		Valley Drive	
Drawing Name:		Refuse Strategy Block B - Ground Floor	
Drawing Number:		Rey:	Status:
VDR-BPTW-04-00-DR-A-5902		C01	CR
Project No:	RIBA Stage:	Drawn By:	Scale:
19-251	4	JS	1:100 @ A1
AS BUILT			
40 Norman Road, Greenwich, London SE10 9GX t 020 8293 5175 bptw.co.uk			