




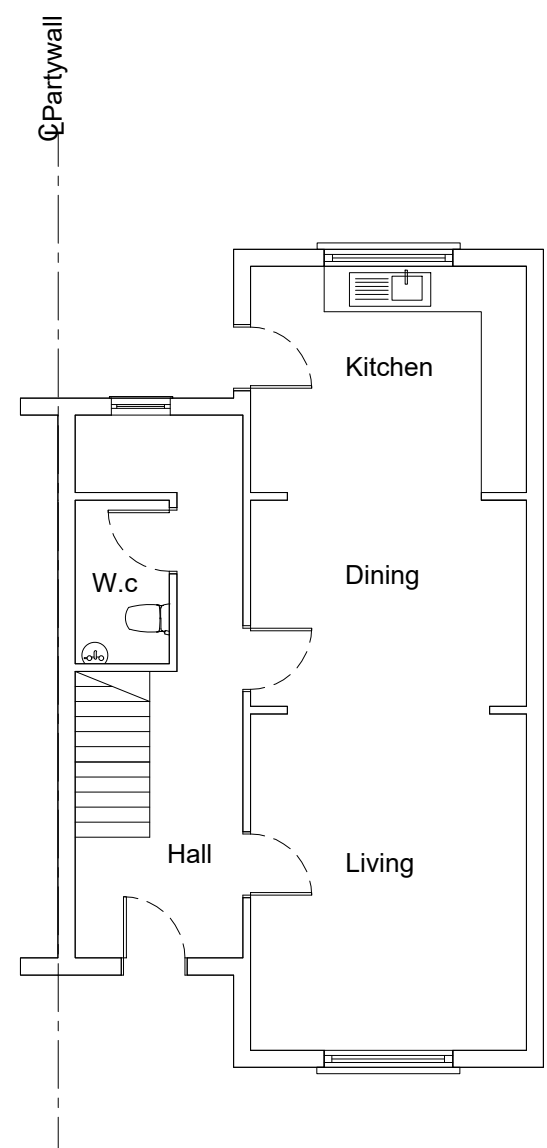


Pre-Existing Ground Floor Plan

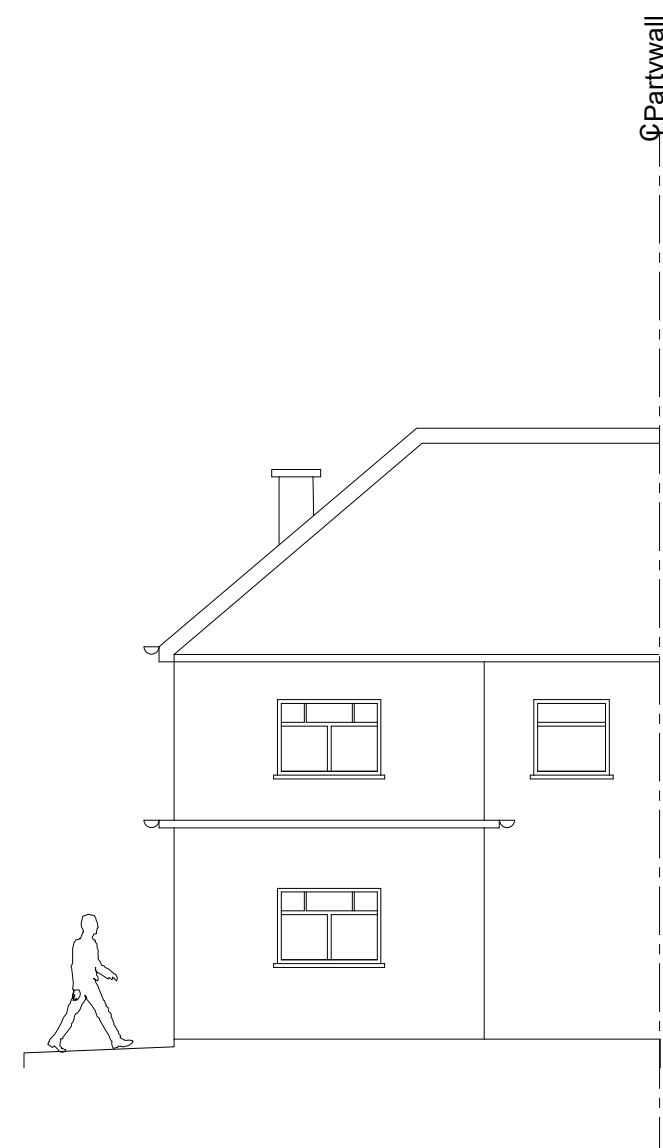


Pre-Existing Rear Elevation

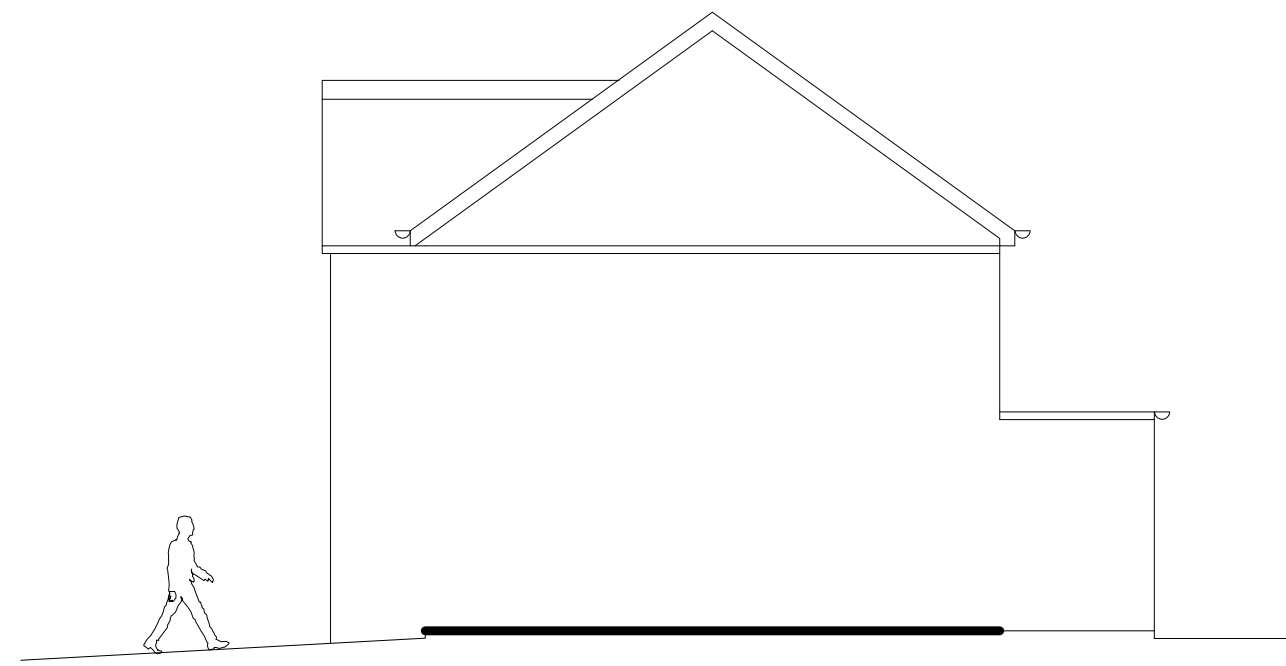

Pre-Existing Side Elevation

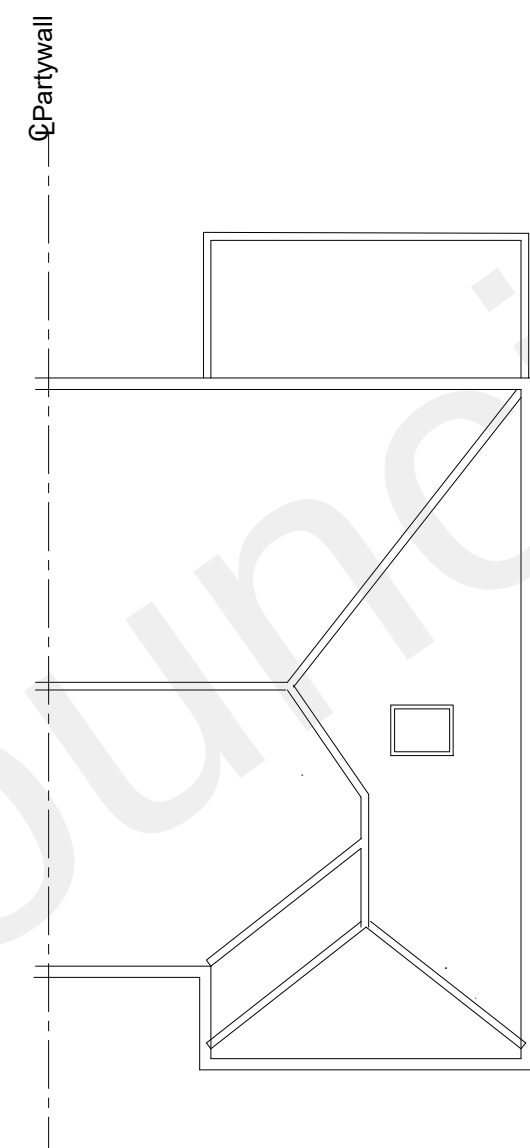


Pre-Existing Roof Plan

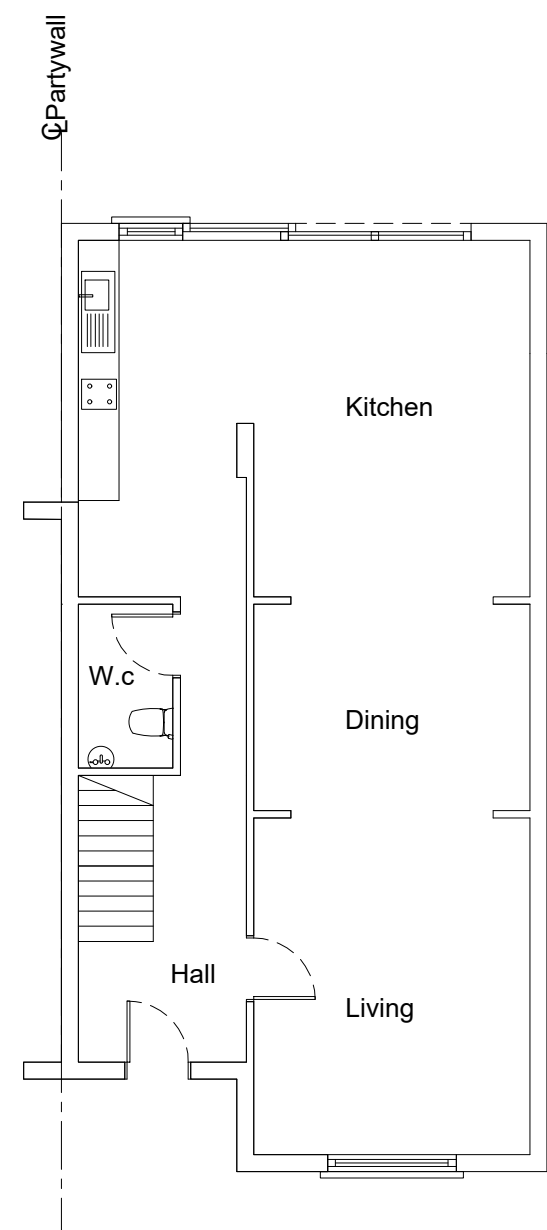


As Built Ground Floor Plan




As Built Rear Elevation

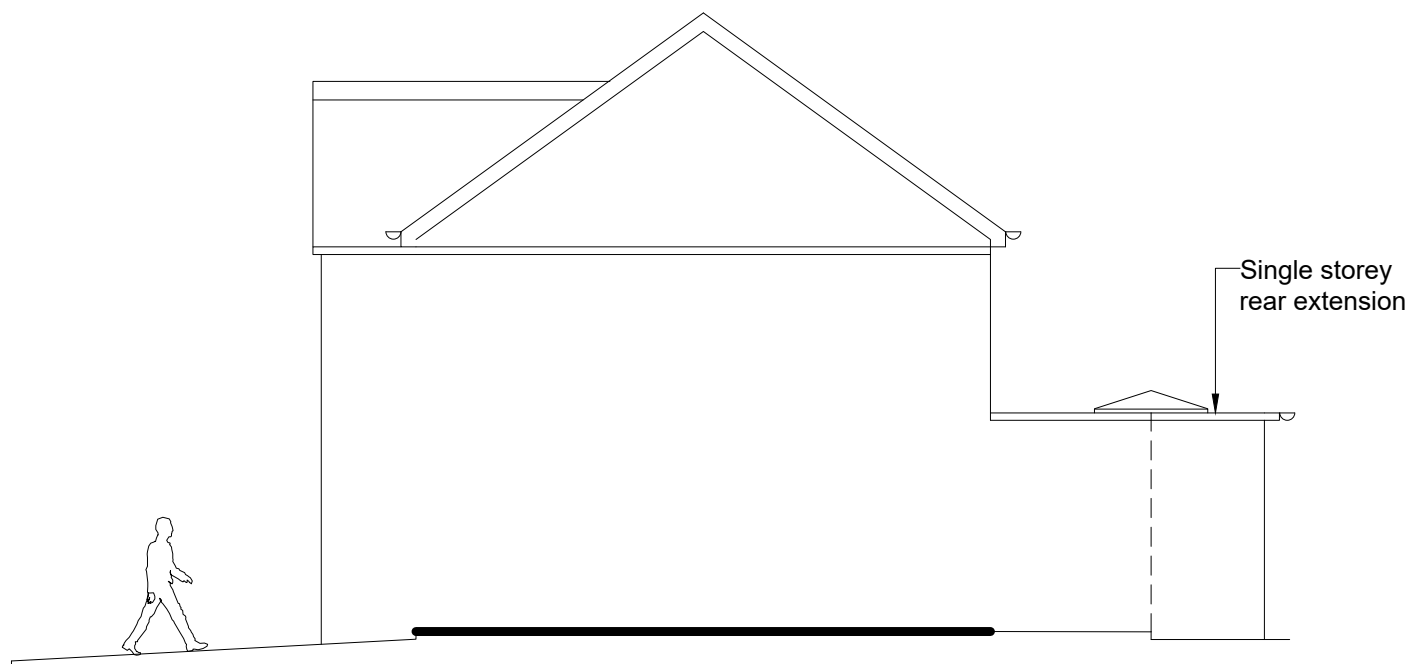

As Built Side Elevation

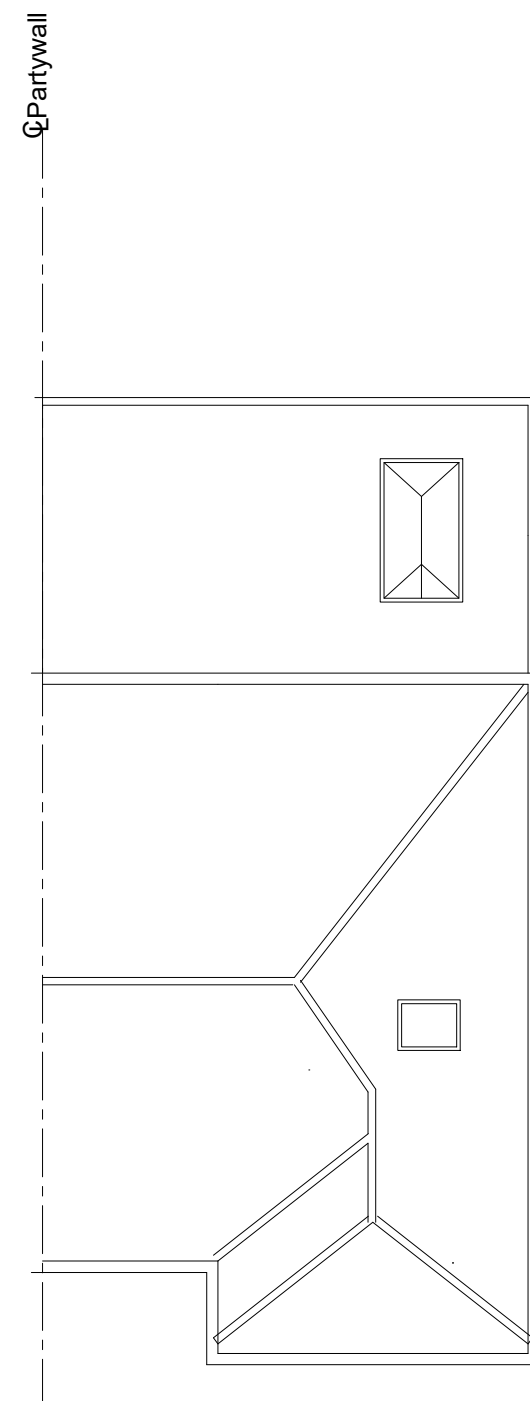

As Built Roof Plan

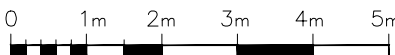

Retrospective
Application

P2	ISSUED TO GRAVESHAM		MC	
P1	ISSUED TO GRAVESHAM		MC	
Rev		Date	By	
				
www.designerplan.co.uk				
OFFICE 48, 95 WILTON ROAD, VICTORIA, LONDON, SW1V 1BZ T: 07940121222				
Job Title				
152 Lower Higham Rd, DA12 2NN				
Drawing Title				
Single Story Rear Extension				
Scale	Date	Drawn By		
1:100 @ A1	Aug ` 22	MC		
Job No.	Dwg No.	Rev		
515-1000-990	P03	P2		