
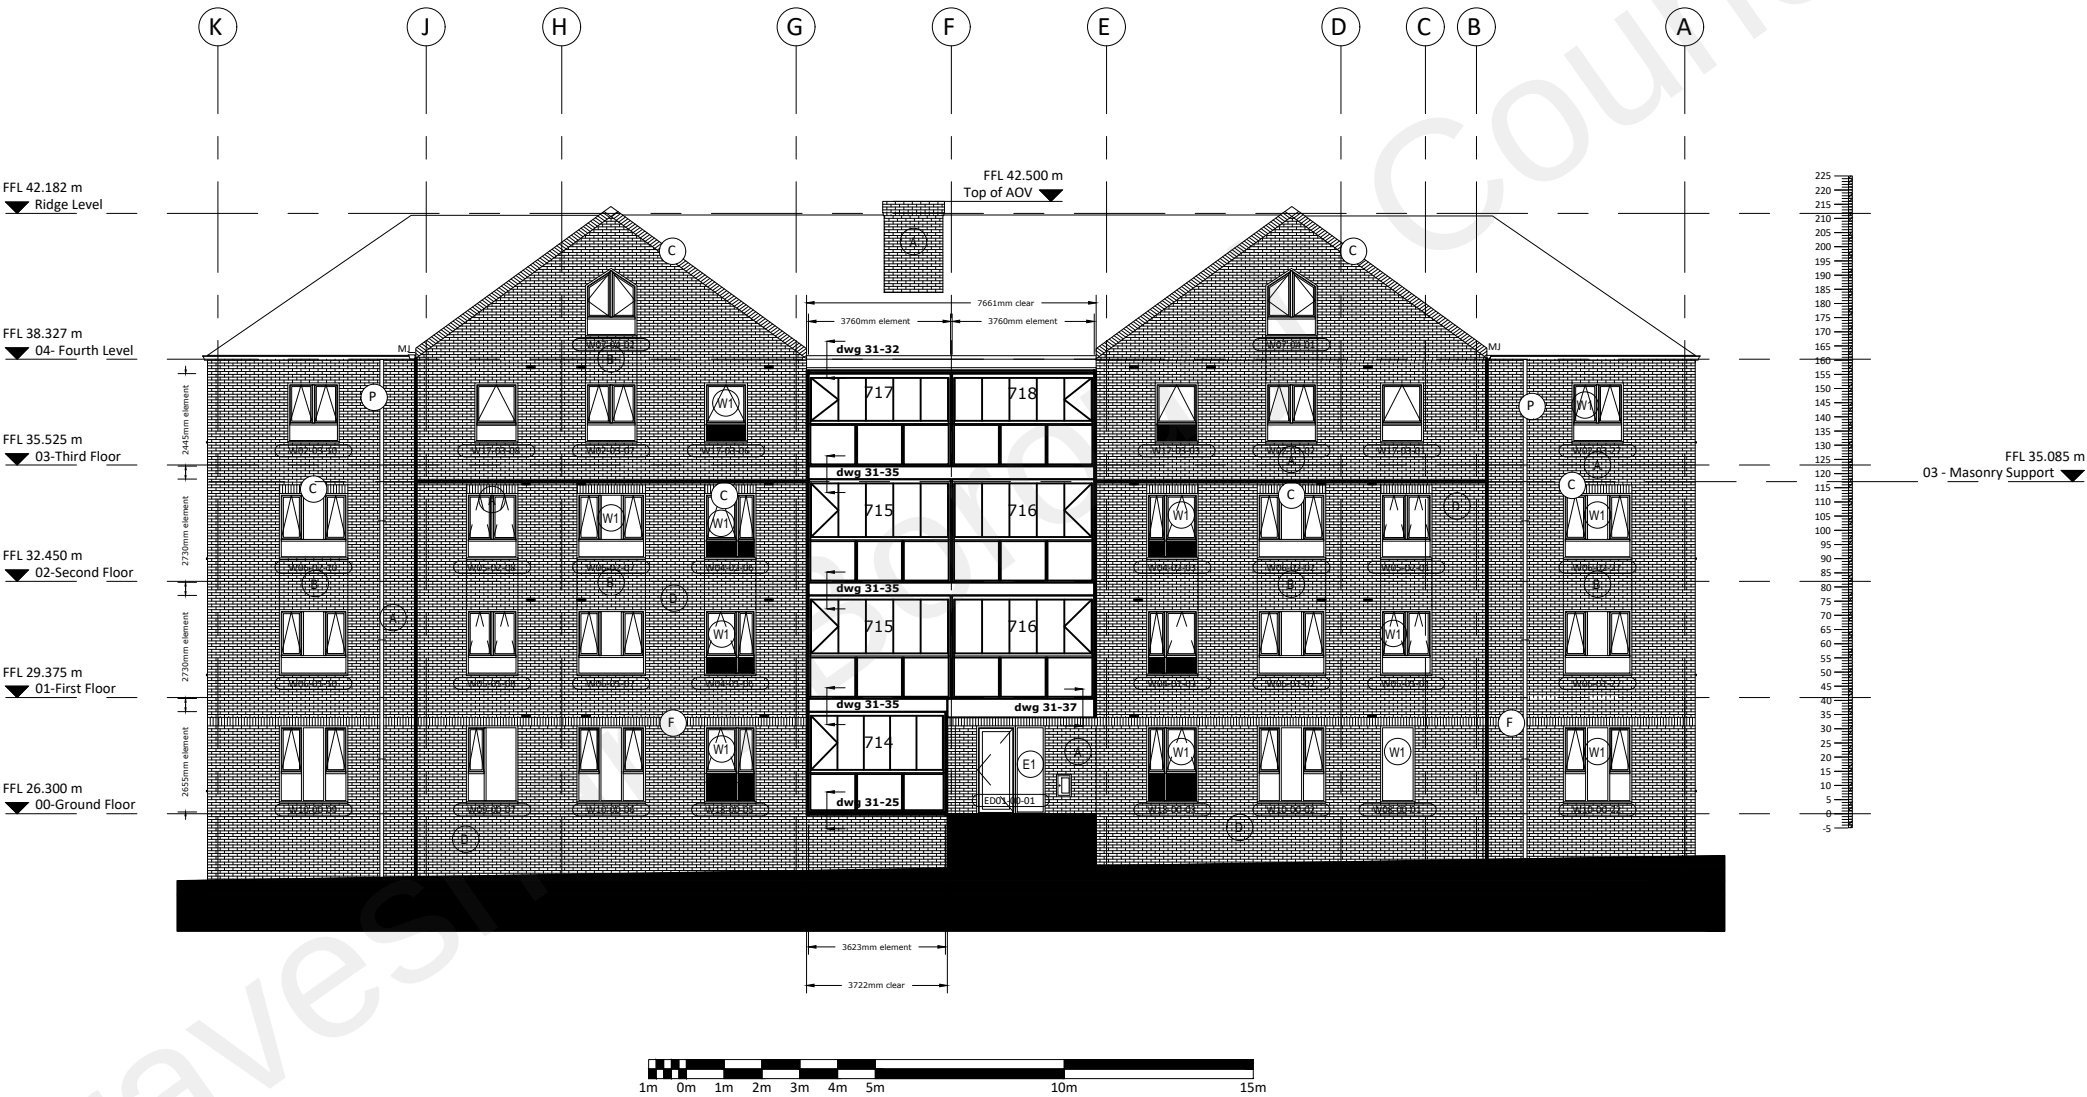


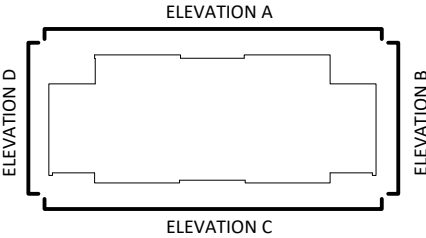


AS BUILT

Sunparadise system WD100 Light

Aluminium powder coated frame - RAL 7016 30% MATT
Balustrade section with 6.8mm clear laminated safety glass.
8mm clear toughened frameless sliding folding opening glass,
opening inwards through 90°.
1.5mm ppc aluminium pressings to the perimeter inside and
out, RAL 7016 30% MATT
Outward opening door 10mm clear toughened glass with
manifestation (to be agreed), stainless steel handle.
6mm clear laminated glass fanlight.

 Sunparadise Systems Limited 12 Newmarket Business Centre 341 Exning Road, Newmarket, SUFFOLK CB8 0AT Phone: 0870 067 88 www.sunparadise.com		Date	Init.:	Unit:	mm	Rev	Description	Date	Init.:
		Design:	Dec'20	JCB	Scale:	A	Drawing sections referenced	08/01/21	GRO
		Checked:				B	Drawing section ammended	18/01/21	GRO
Order name: St Patricks Garden Gravesend KENT Subject: Elevation A						C	System description & colour added	01/02/21	GRO
						D	Top element row reduced in height	29-04-21	GRO
						Business Opp: St Patricks Project ID: 1006-01 Drawing No.: SPG_EA			

1m 0m 1m 2m 3m 4m 5m 10m 15m

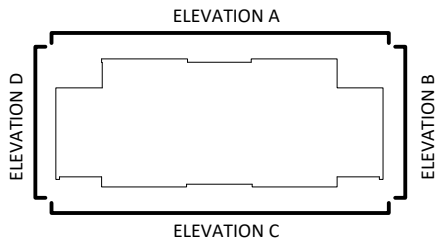

AS BUILT



Sunparadise system WD100 Light

Aluminium powder coated frame - RAL 7016 30% MATT
Balustrade section with 6.8mm clear laminated safety glass.
8mm clear toughened frameless sliding folding opening glass,
opening inwards through 90°.
1.5mm ppc aluminium pressings to the perimeter inside and
out, RAL 7016 30% MATT
Outward opening door 10mm clear toughened glass with
manifestation (to be agreed), stainless steel handle.
6mm clear laminated glass fanlight.

sunparadise

Sunparadise Systems Limited
12 Newmarket Business Centre
341 Exning Road, Newmarket,
SUFFOLK CB8 0AT
Phone: 0870 067 88
www.sunparadise.com


	Date	Init.:	Unit:	mm	Rev.	Description	Date	Init.:
Design:	Dec'20	JCB	Scale:		A	Drawing sections referenced	08/01/21	GRO
Checked:					B	System description & colour added	01/02/21	GRO
Order name:	St Patricks Garden Gravesend KENT				C	Elements 709/710 reduced in height	29-04-21	GRO
					D			
					Business Opp: St Patricks Project ID: 1006-01 Drawing No.: SPG EC			
Subject:	Elevation C							

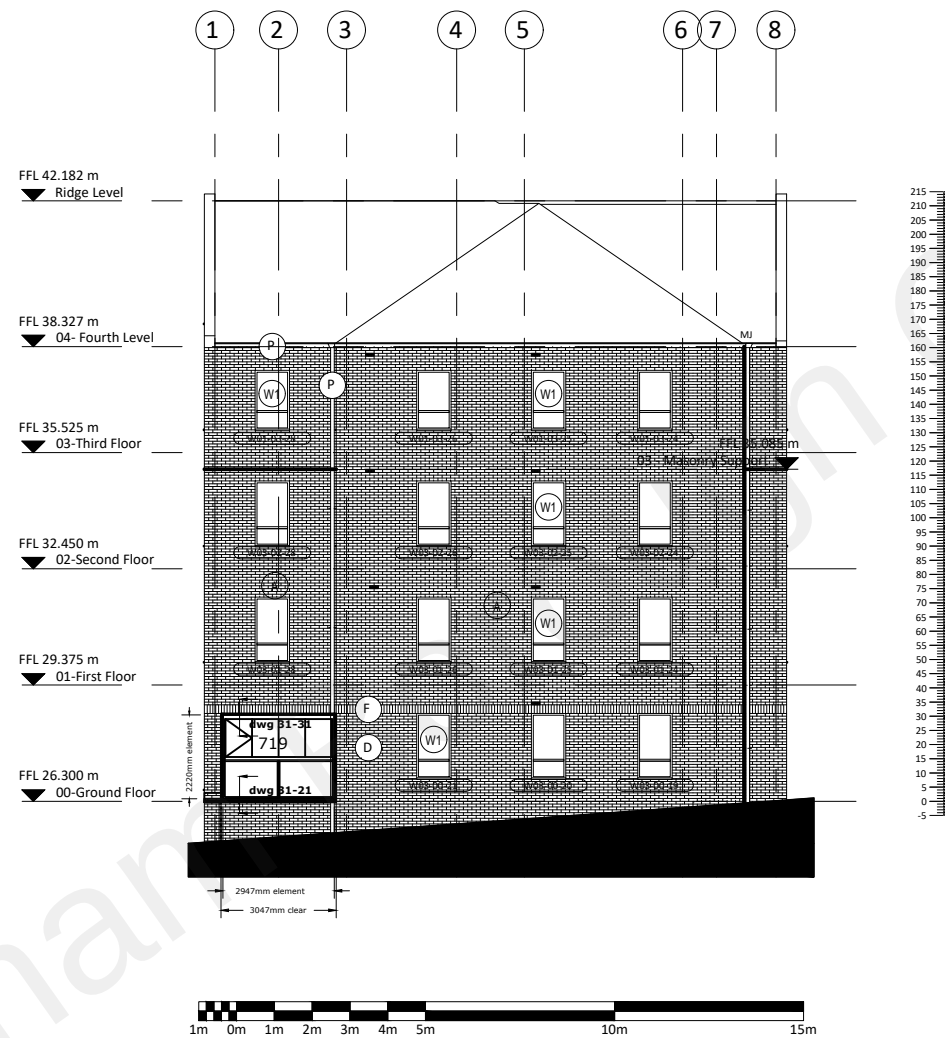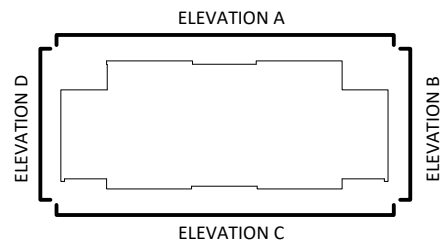

AS BUILT

Sunparadise system WD100 Light
Aluminium powder coated frame - RAL 7016 30% MATT
Balustrade section with 6.8mm clear laminated safety glass.
8mm clear toughened frameless sliding folding opening glass,
opening inwards through 90°.
1.5mm ppc aluminium pressings to the perimeter inside and
out, RAL 7016 30% MATT
Outward opening door 10mm clear toughened glass with
manifestation (to be agreed), stainless steel handle.
6mm clear laminated glass fanlight.


 Sunparadise Systems Limited 12 Newmarket Business Centre 341 Exning Road, Newmarket, SUFFOLK CB8 0AT Phone: 0870 067 88 www.sunparadise.com		Date	Init.:	Unit:	mm	Rev.	Description	Date	Init.:
	Design:	Dec'20	JCB	Scale:		A	Drawing sections referenced	08/01/21	GRO
	Checked:					B	System description & colour added	01/02/21	GR
	Order name:	St Patricks Garden Gravesend KENT				C			
						D			
Subject:	Elevation D				Business Opp: St Patricks Project ID: 1006-01 Drawing No.: SPG_ED				

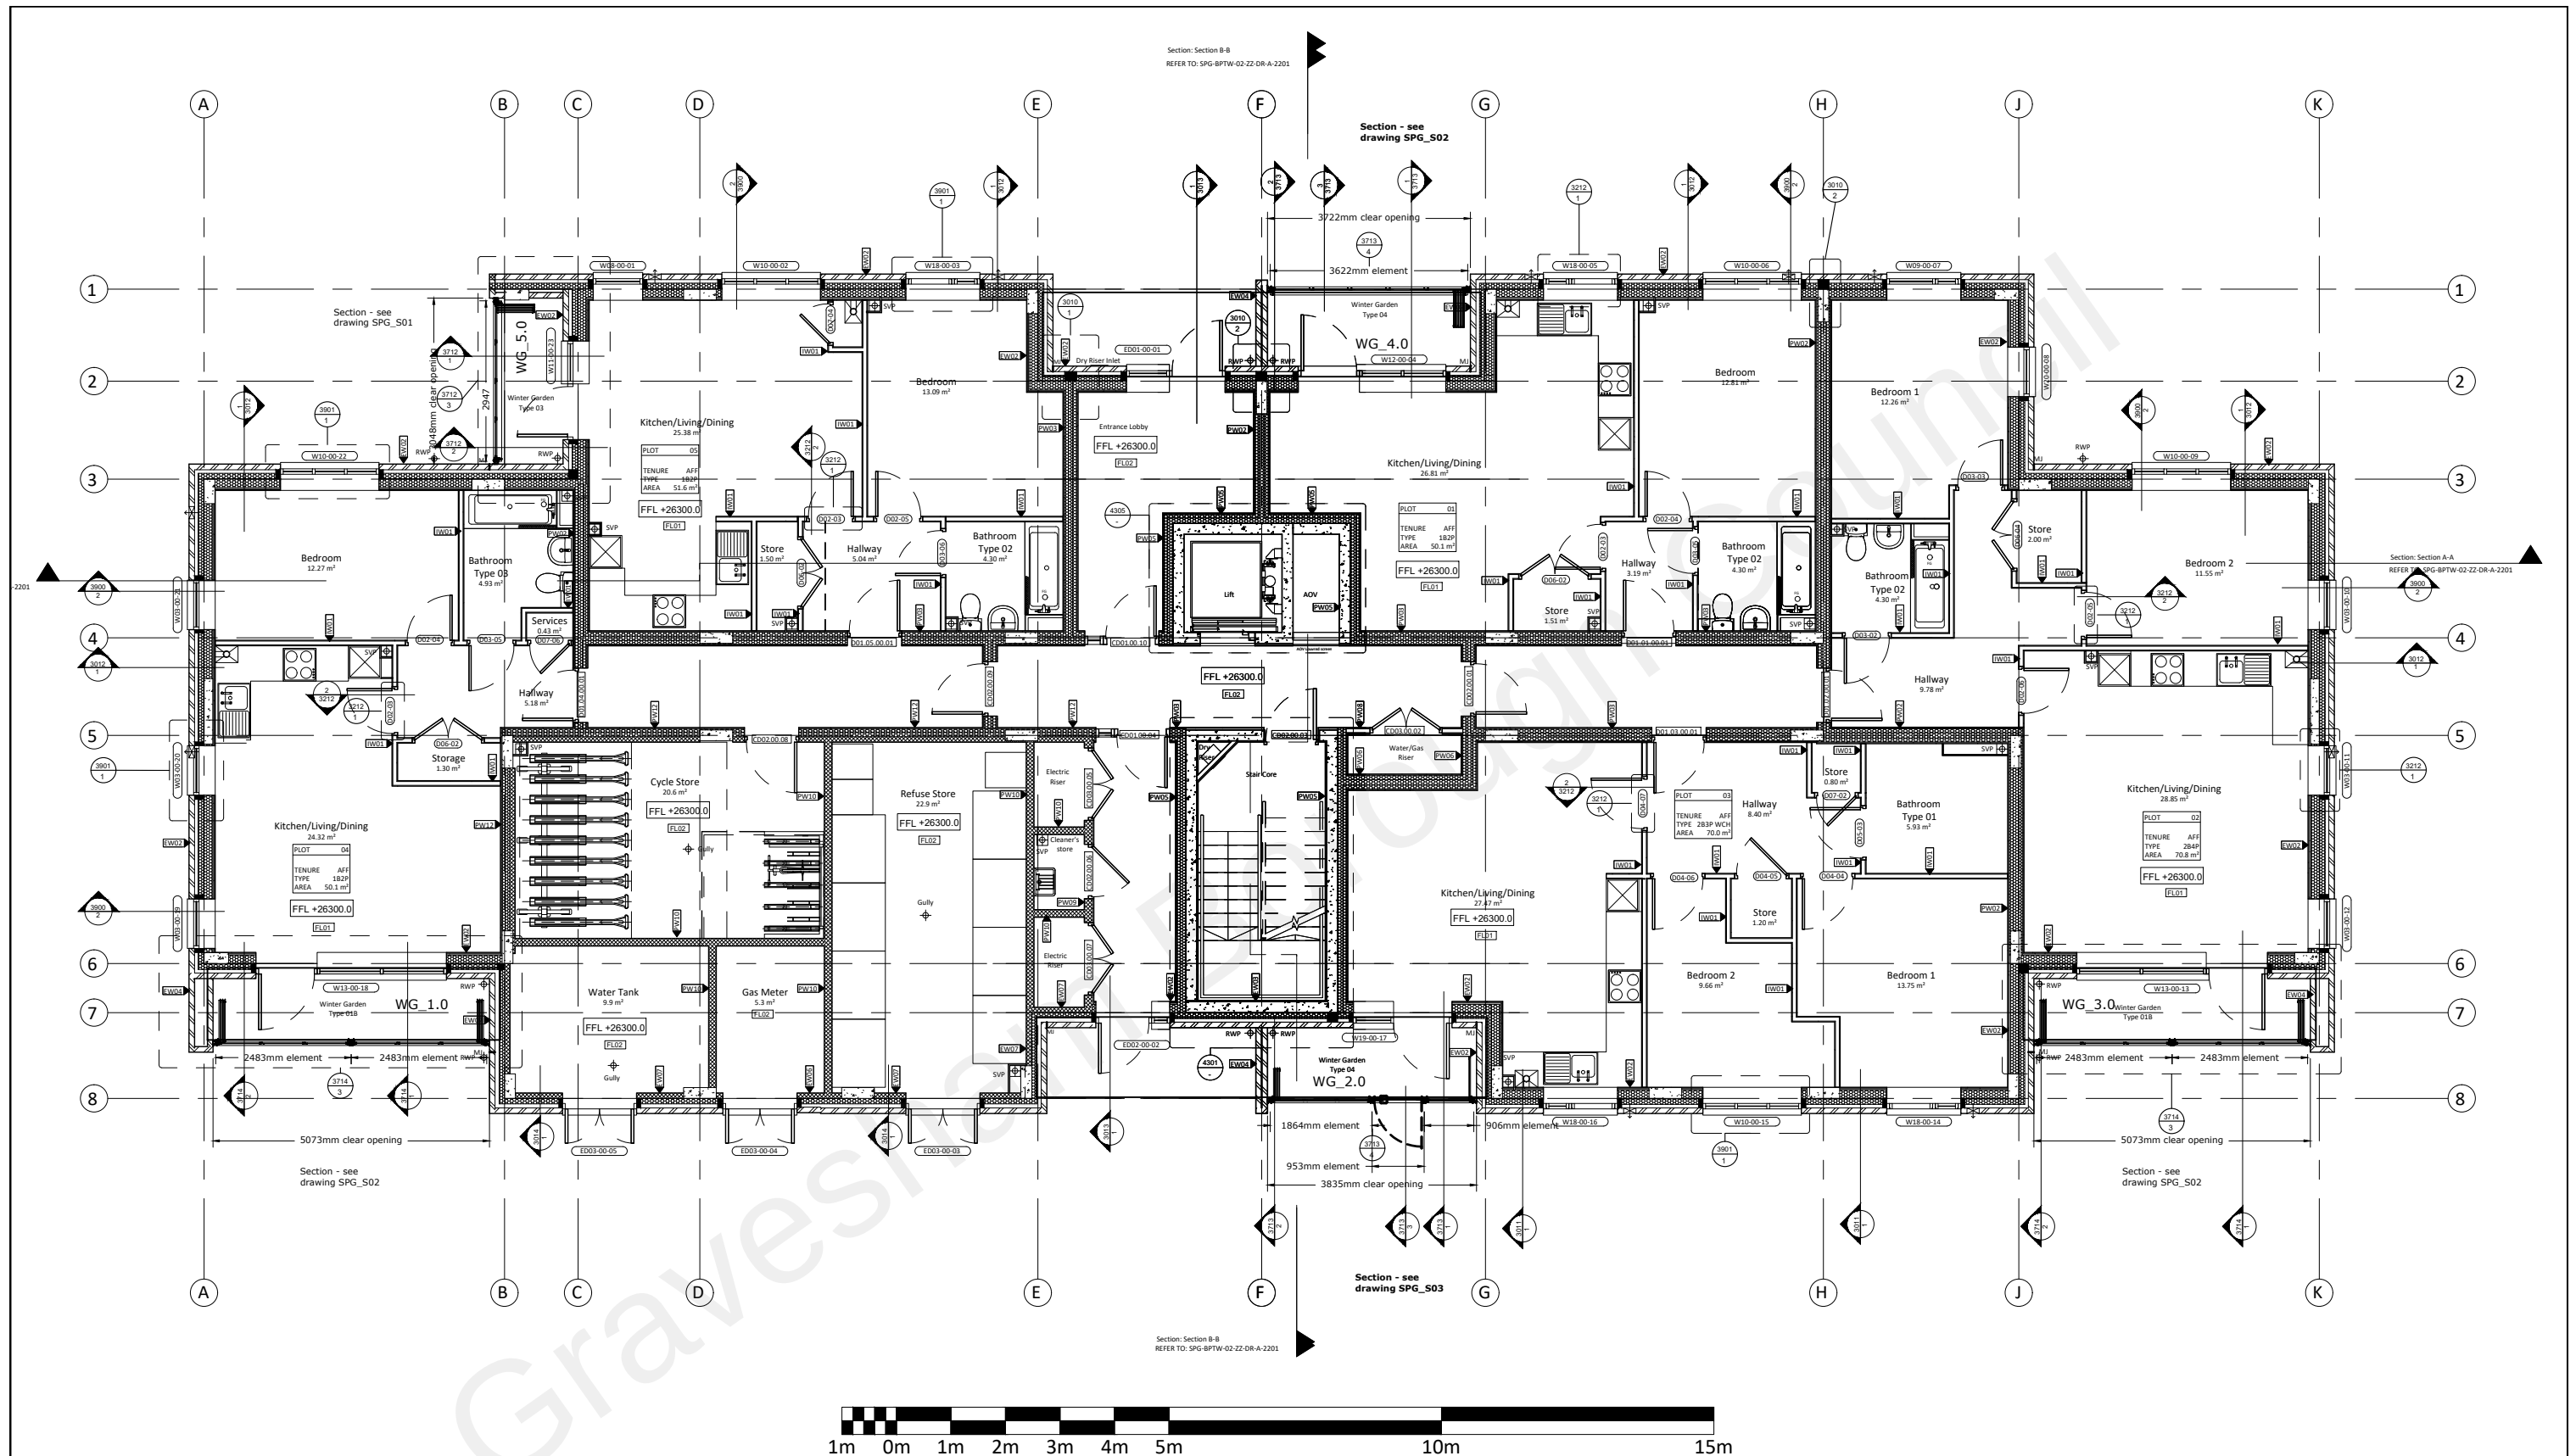

AS BUILT

Sunparadise system WD100 Light
Aluminium powder coated frame - RAL 7016 30% MATT
Balustrade section with 6.8mm clear laminated safety glass.
8mm clear toughened frameless sliding folding opening glass,
opening inwards through 90°.
1.5mm ppc aluminium pressings to the perimeter inside and
out, RAL 7016 30% MATT
Outward opening door 10mm clear toughened glass with
manifestation (to be agreed), stainless steel handle.
6mm clear laminated glass fanlight.

 Sunparadise Systems Limited 12 Newmarket Business Centre 341 Exning Road, Newmarket, SUFFOLK CB8 0AT Phone: 0870 067 88 www.sunparadise.com		Date	Init.:	Unit:	mm	Rev.	Description	Date	Init.:	
	Design:	Dec'20	JCB	Scale:		A	Specific dwg references highlighted	08/01/21	GRO	
	Checked:					B	System description & colour added	01/02/21	GRO	
	Order name:	St Patricks Garden Gravesend KENT					C			
							D			
							Business Opp: St Patricks Project ID: 1006-01 Drawing No.: SPG_P00			
	Subject:	Plan Ground floor								

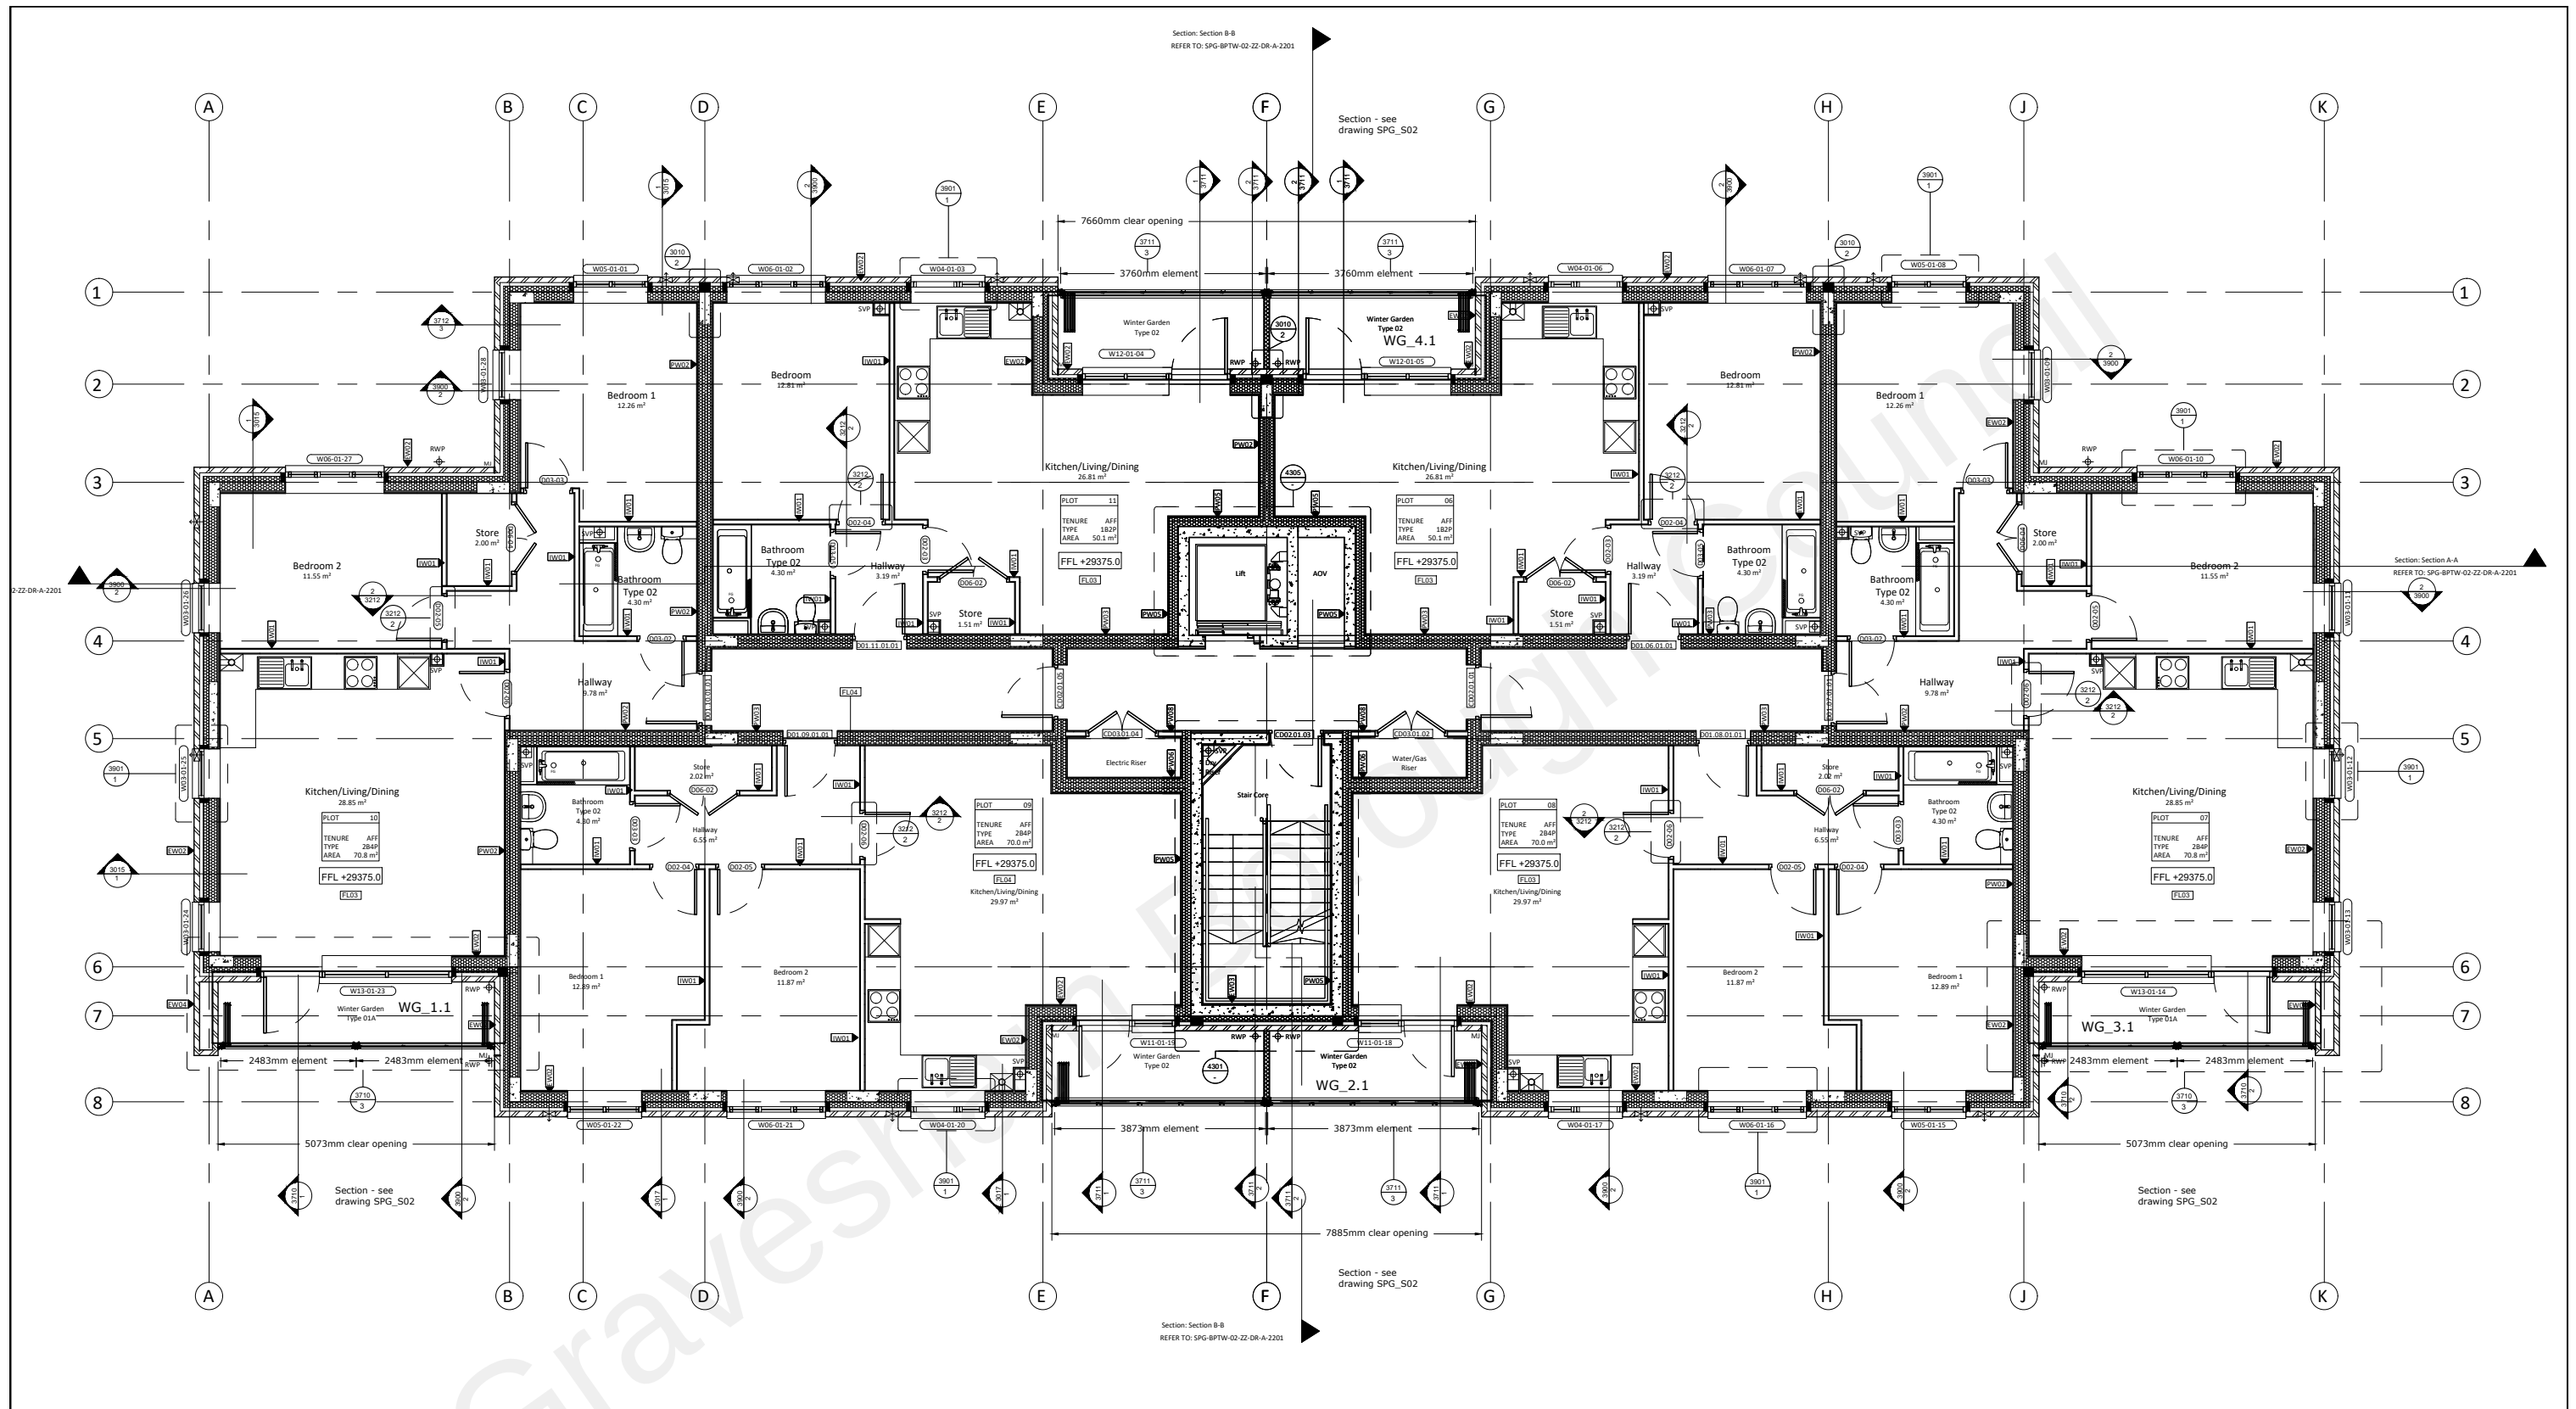

AS BUILT

Sunparadise system WD100 Light

Aluminium powder coated frame - RAL 7016 30% MATT
Balustrade section with 6.8mm clear laminated safety glass.
8mm clear toughened frameless sliding folding opening glass,
opening inwards through 90°.
1.5mm ppc aluminium pressings to the perimeter inside and
out, RAL 7016 30% MATT
Outward opening door 10mm clear toughened glass with
manifestation (to be agreed), stainless steel handle.
6mm clear laminated glass fanlight.

sunparadise

Sunparadise Systems Limited
12 Newmarket Business Centre
341 Exning Road, Newmarket,
SUFFOLK CB8 0AT
Phone: 0870 067 88
www.sunparadise.com

	Date	Init.:	Unit:	mm	Rev.	Description	Date	Init.:
Design:	Dec'20	JCB	Scale:		A	System description & colour added	01/02/21	GRO
Checked:					B			
Order name:	St Patricks Garden				C			
	Gravesend				D			
	KENT							
Subject:	Plan				Business Opp: St Patricks			
	1st floor				Project ID: 1006-01			
					Drawing No.: SPG_P01			

2325mm clear opening

2240mm element

1150

440

Finished Fall min. 1:80

GL (VARIES)

2325mm clear opening

2240mm element

440

1150

Finished Fall min. 1:80

GL (VARIES)

2325mm clear opening

2240mm element

1150

440


Finished Fall min. 1:80

GL (VARIES)





Comparadise system WD100 Light
Aluminium powder coated frame - RAL 7016 30% MATT
Balustrade section with 6.8mm clear laminated safety glass.
8mm clear toughened frameless sliding folding opening glass,
opening inwards through 90°.
1.5mm ppc aluminium pressings to the perimeter inside and
out, RAL 7016 30% MATT
Outward opening door 10mm clear toughened glass with
manifestation (to be agreed), stainless steel handle.
6mm clear laminated glass fanlight.

Sunparadise Systems Limited
12 Newmarket Business Centre
341 Exning Road, Newmarket,
SUFFOLK CB8 0AT
Phone: 0870 067 88
www.sunparadise.com


	Date	Init.:	Unit: mm	Rev.	Description	Date	Init.:
Design:	Dec'20	JCB	Scale: 1:10	A	Transom height changed	08/01/21	GRO
Checked:				B	System description & colour added	01/02/21	GRO
Order name:	St Patricks Garden Gravesend KENT			C			
				D			
				Business Opp: St Patricks			
				Project ID: 1006-01			
Subject:	Section through Wg type 03 Elev D, Element 719			Drawing No.: SPG S01			

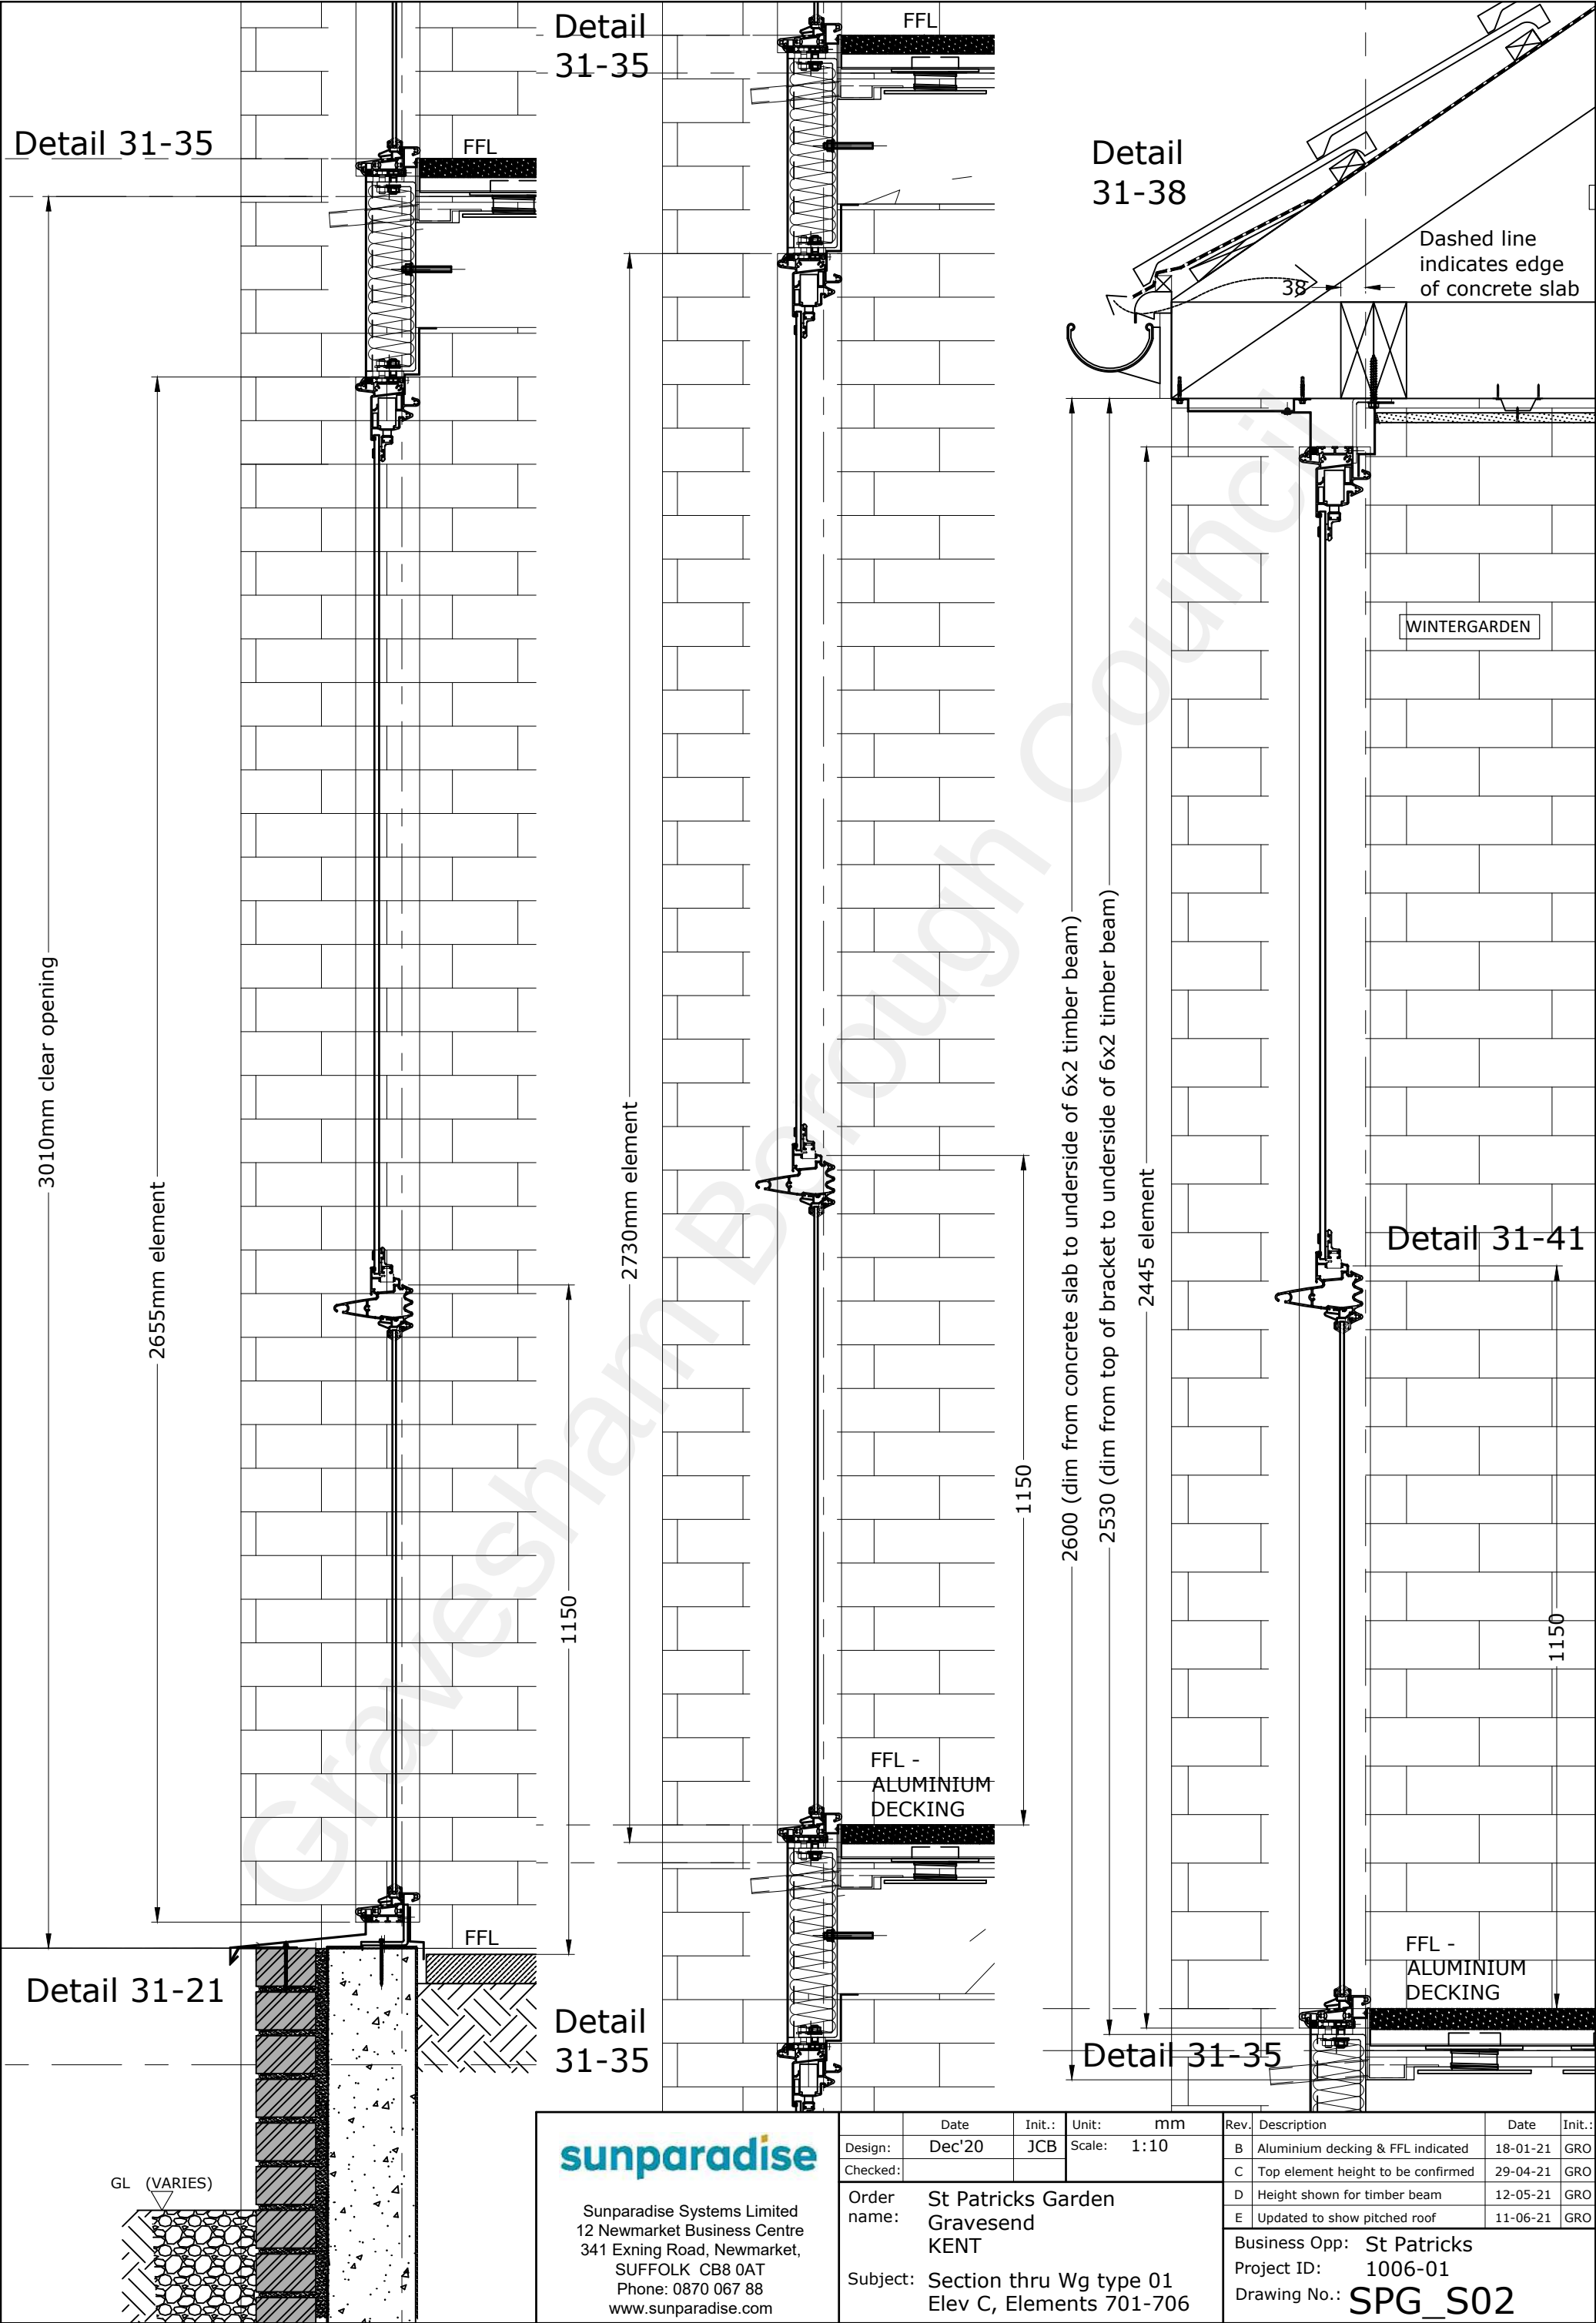

sunparadise		Date	Init.:	Unit:	mm	Rev.	Description	Date	Init.:
Design:		Dec'20	JCB	Scale:	1:10	B	Aluminium decking & FFL indicated	18-01-21	GRO
Checked:						C	Top element height to be confirmed	29-04-21	GRO
Order name:		St Patricks Garden Gravesend KENT				D	Height shown for timber beam	12-05-21	GRO
Subject:		Section thru Wg type 01 Elev C, Elements 701-706				E	Updated to show pitched roof	11-06-21	GRO
Sunparadise Systems Limited 12 Newmarket Business Centre 341 Exning Road, Newmarket, SUFFOLK CB8 0AT Phone: 0870 067 88 www.sunparadise.com		Business Opp: St Patricks Project ID: 1006-01 Drawing No.: SPG_S02							

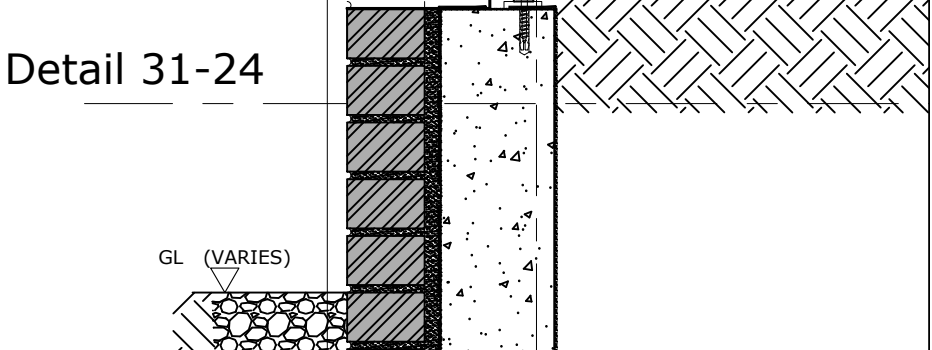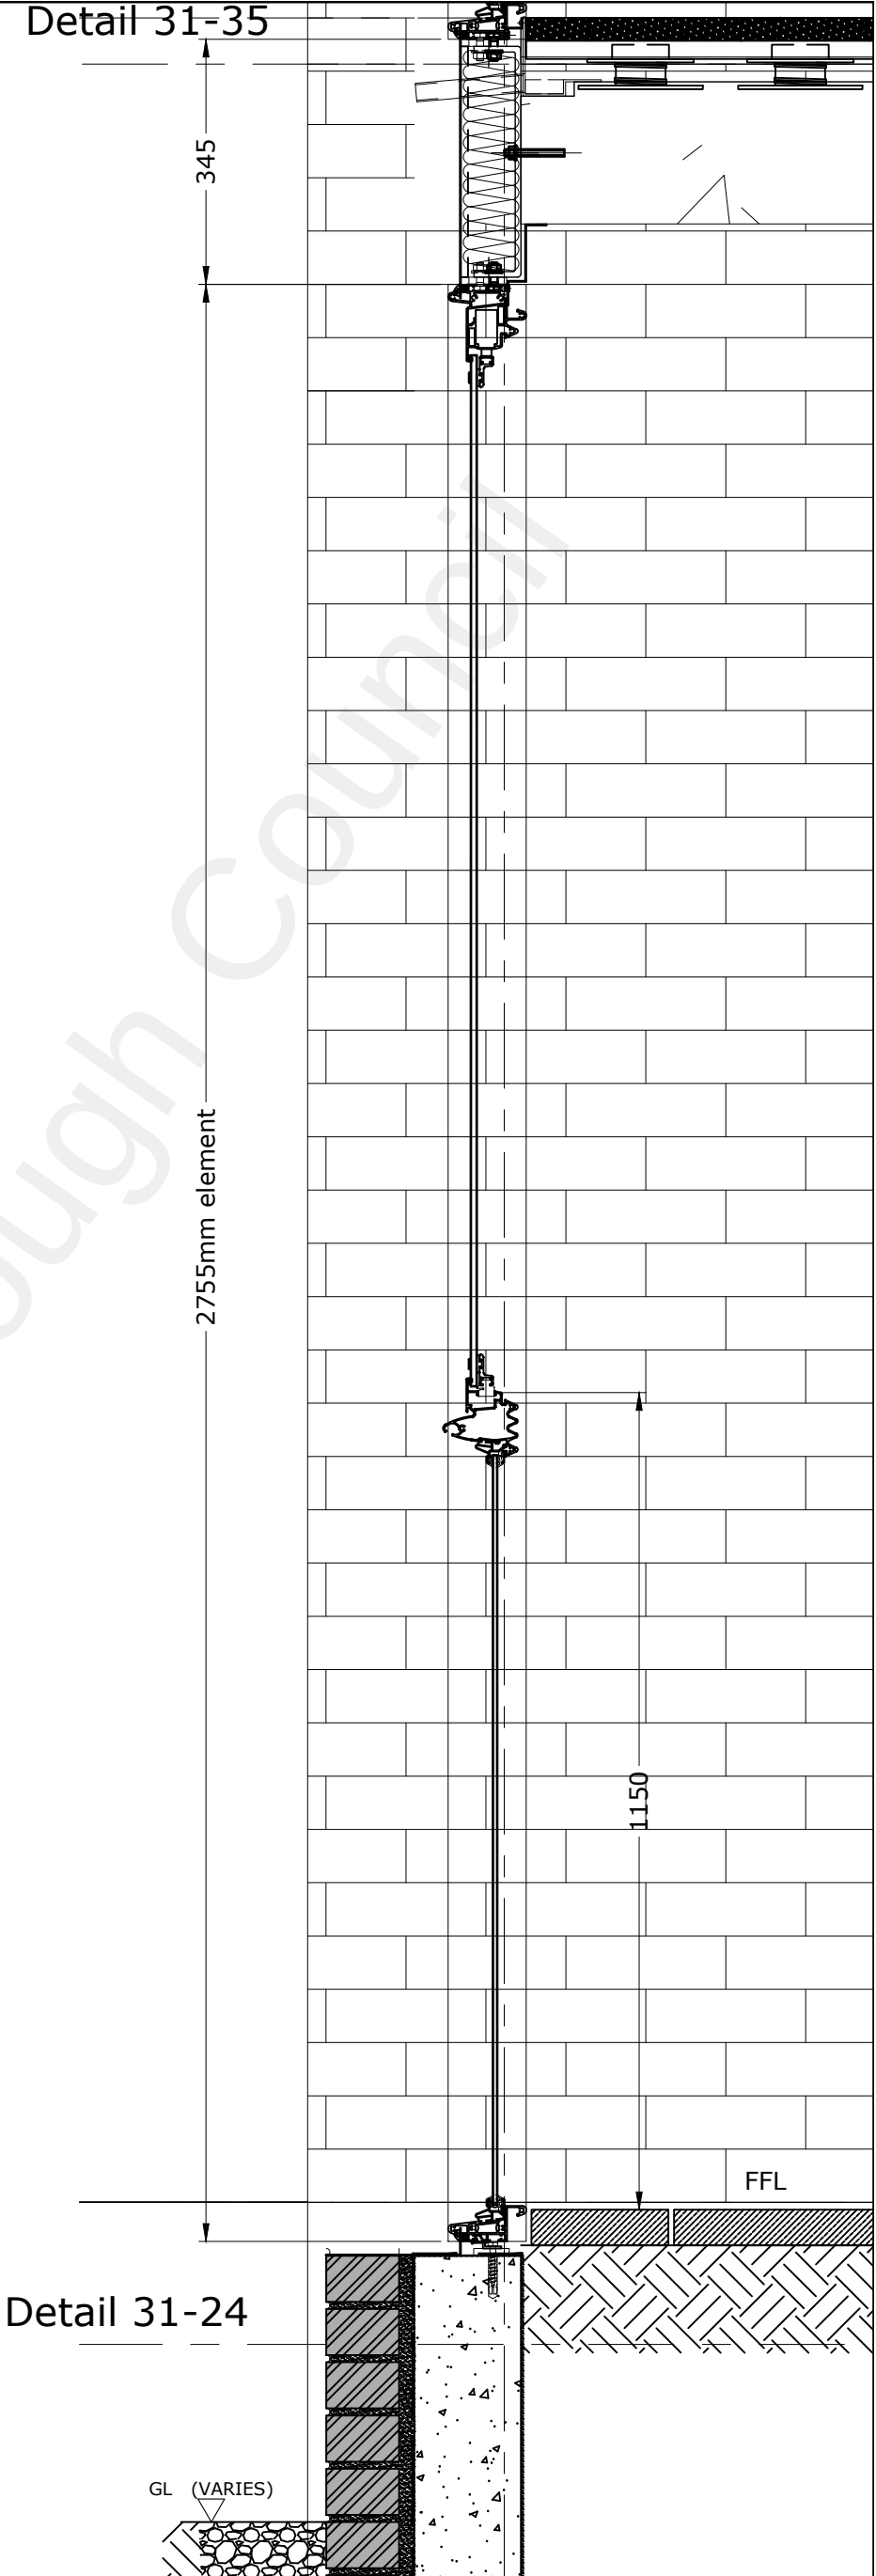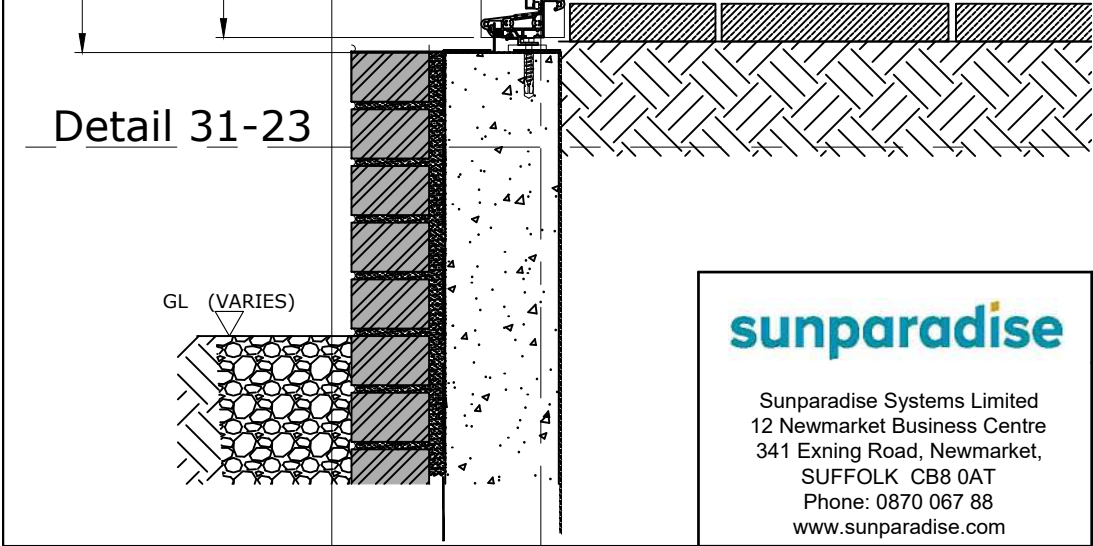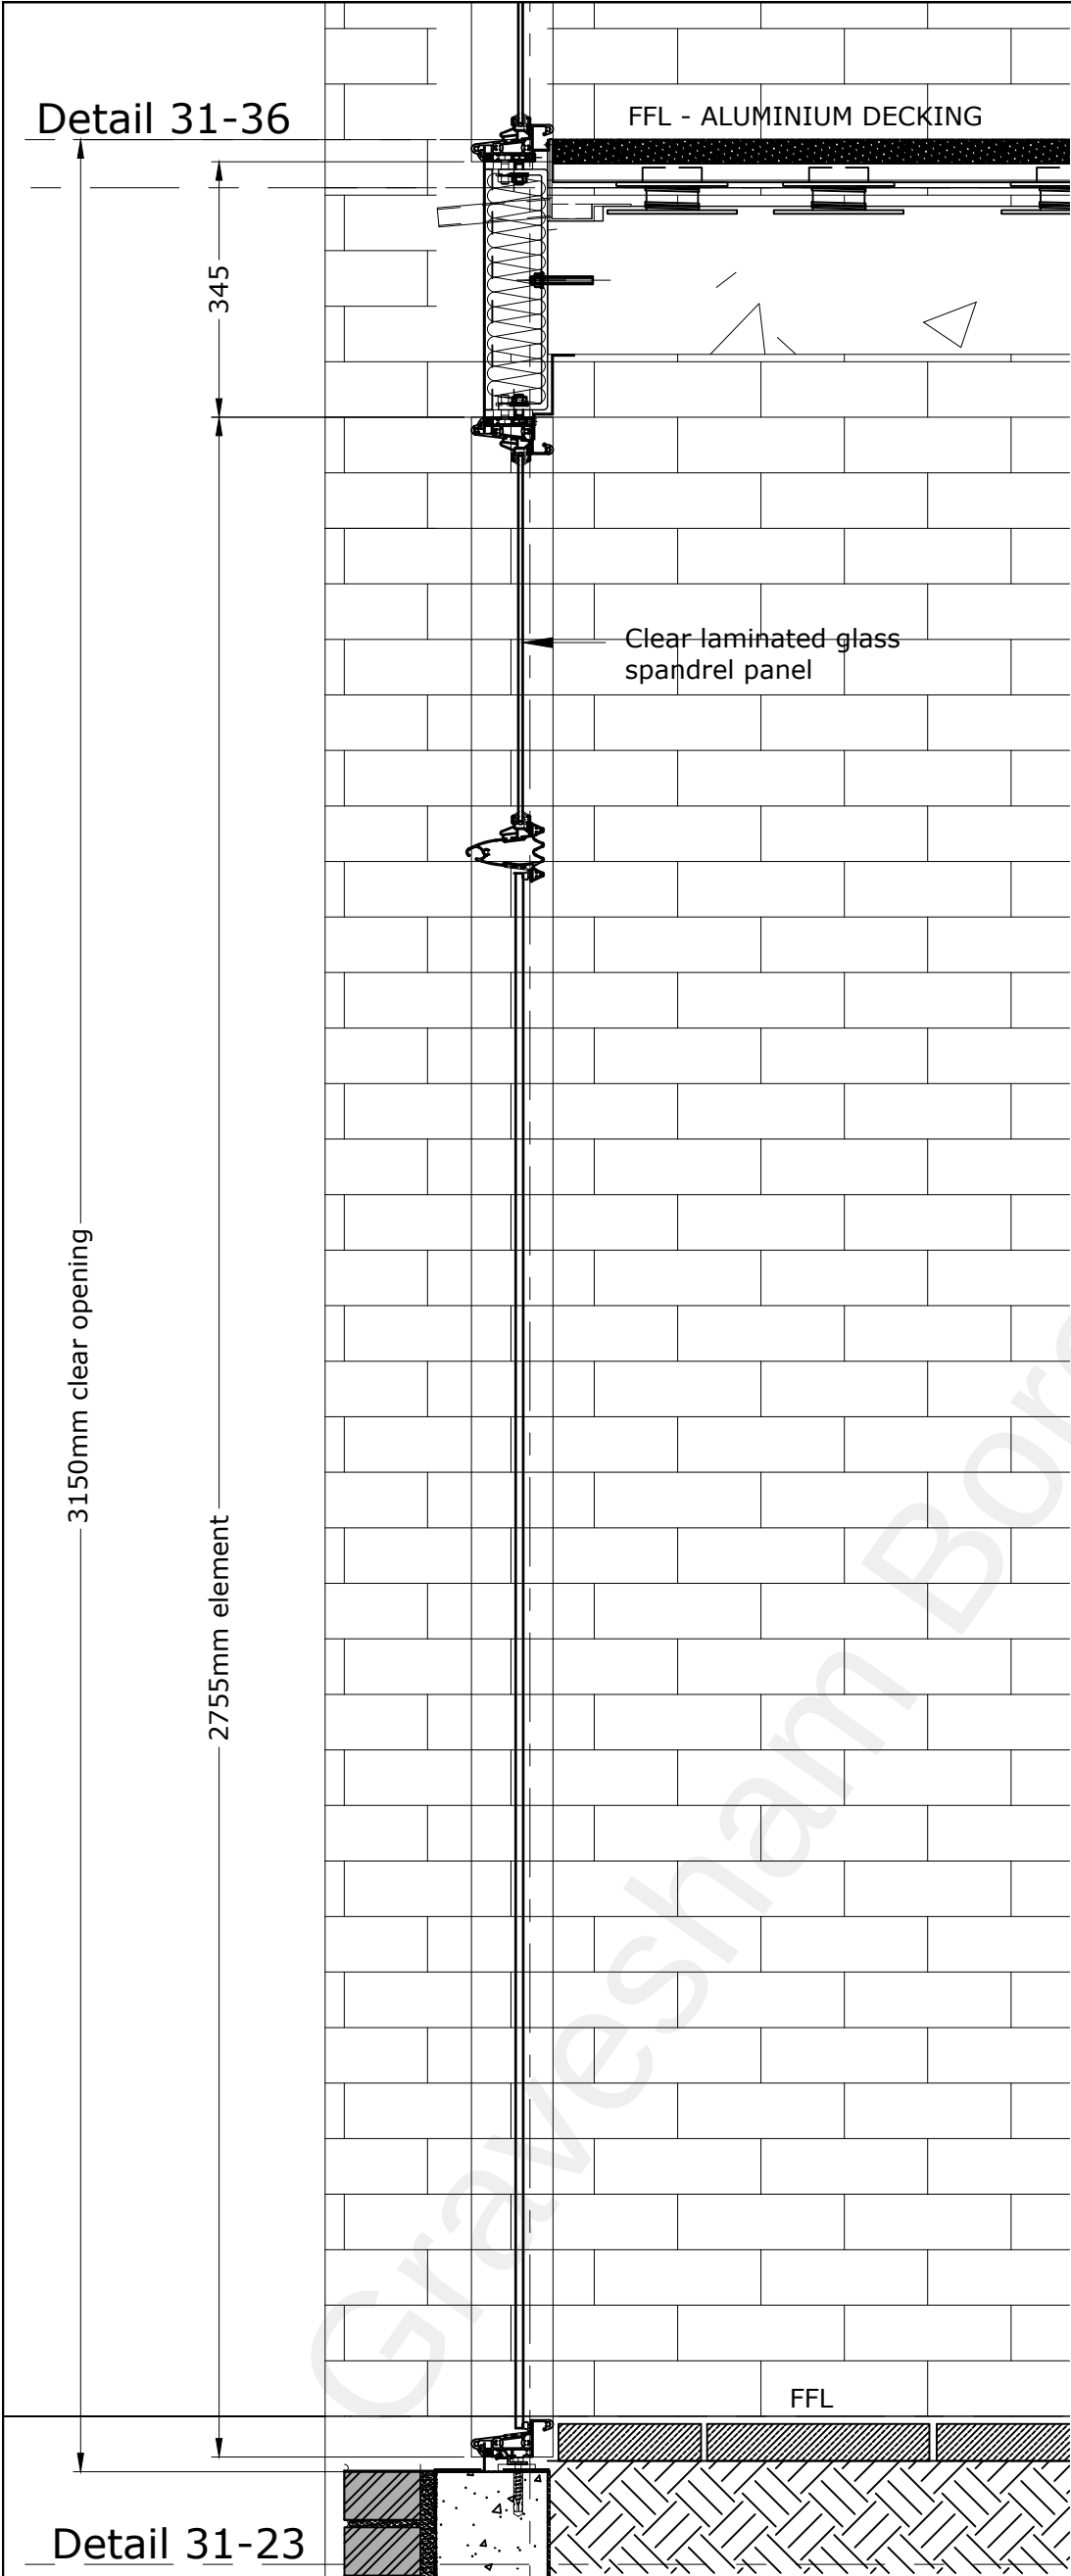

 Sunparadise Systems Limited 12 Newmarket Business Centre 341 Exning Road, Newmarket, SUFFOLK CB8 0AT Phone: 0870 067 88 www.sunparadise.com		Date	Init.:	Unit:	mm	Rev.	Description	Date	Init.:	
	Design:	Dec'20	JCB	Scale:	1:10	A	Transom height changed	08/01/21	GRO	
	Checked:					B				
	Order name:	St Patricks Garden Gravesend KENT					C			
							D			
							Business Opp: St Patricks			
							Project ID: 1006-01			
Subject:	Section through WG type 04 Elev C,Elements 711,712,713					Drawing No.: SPG_S03				

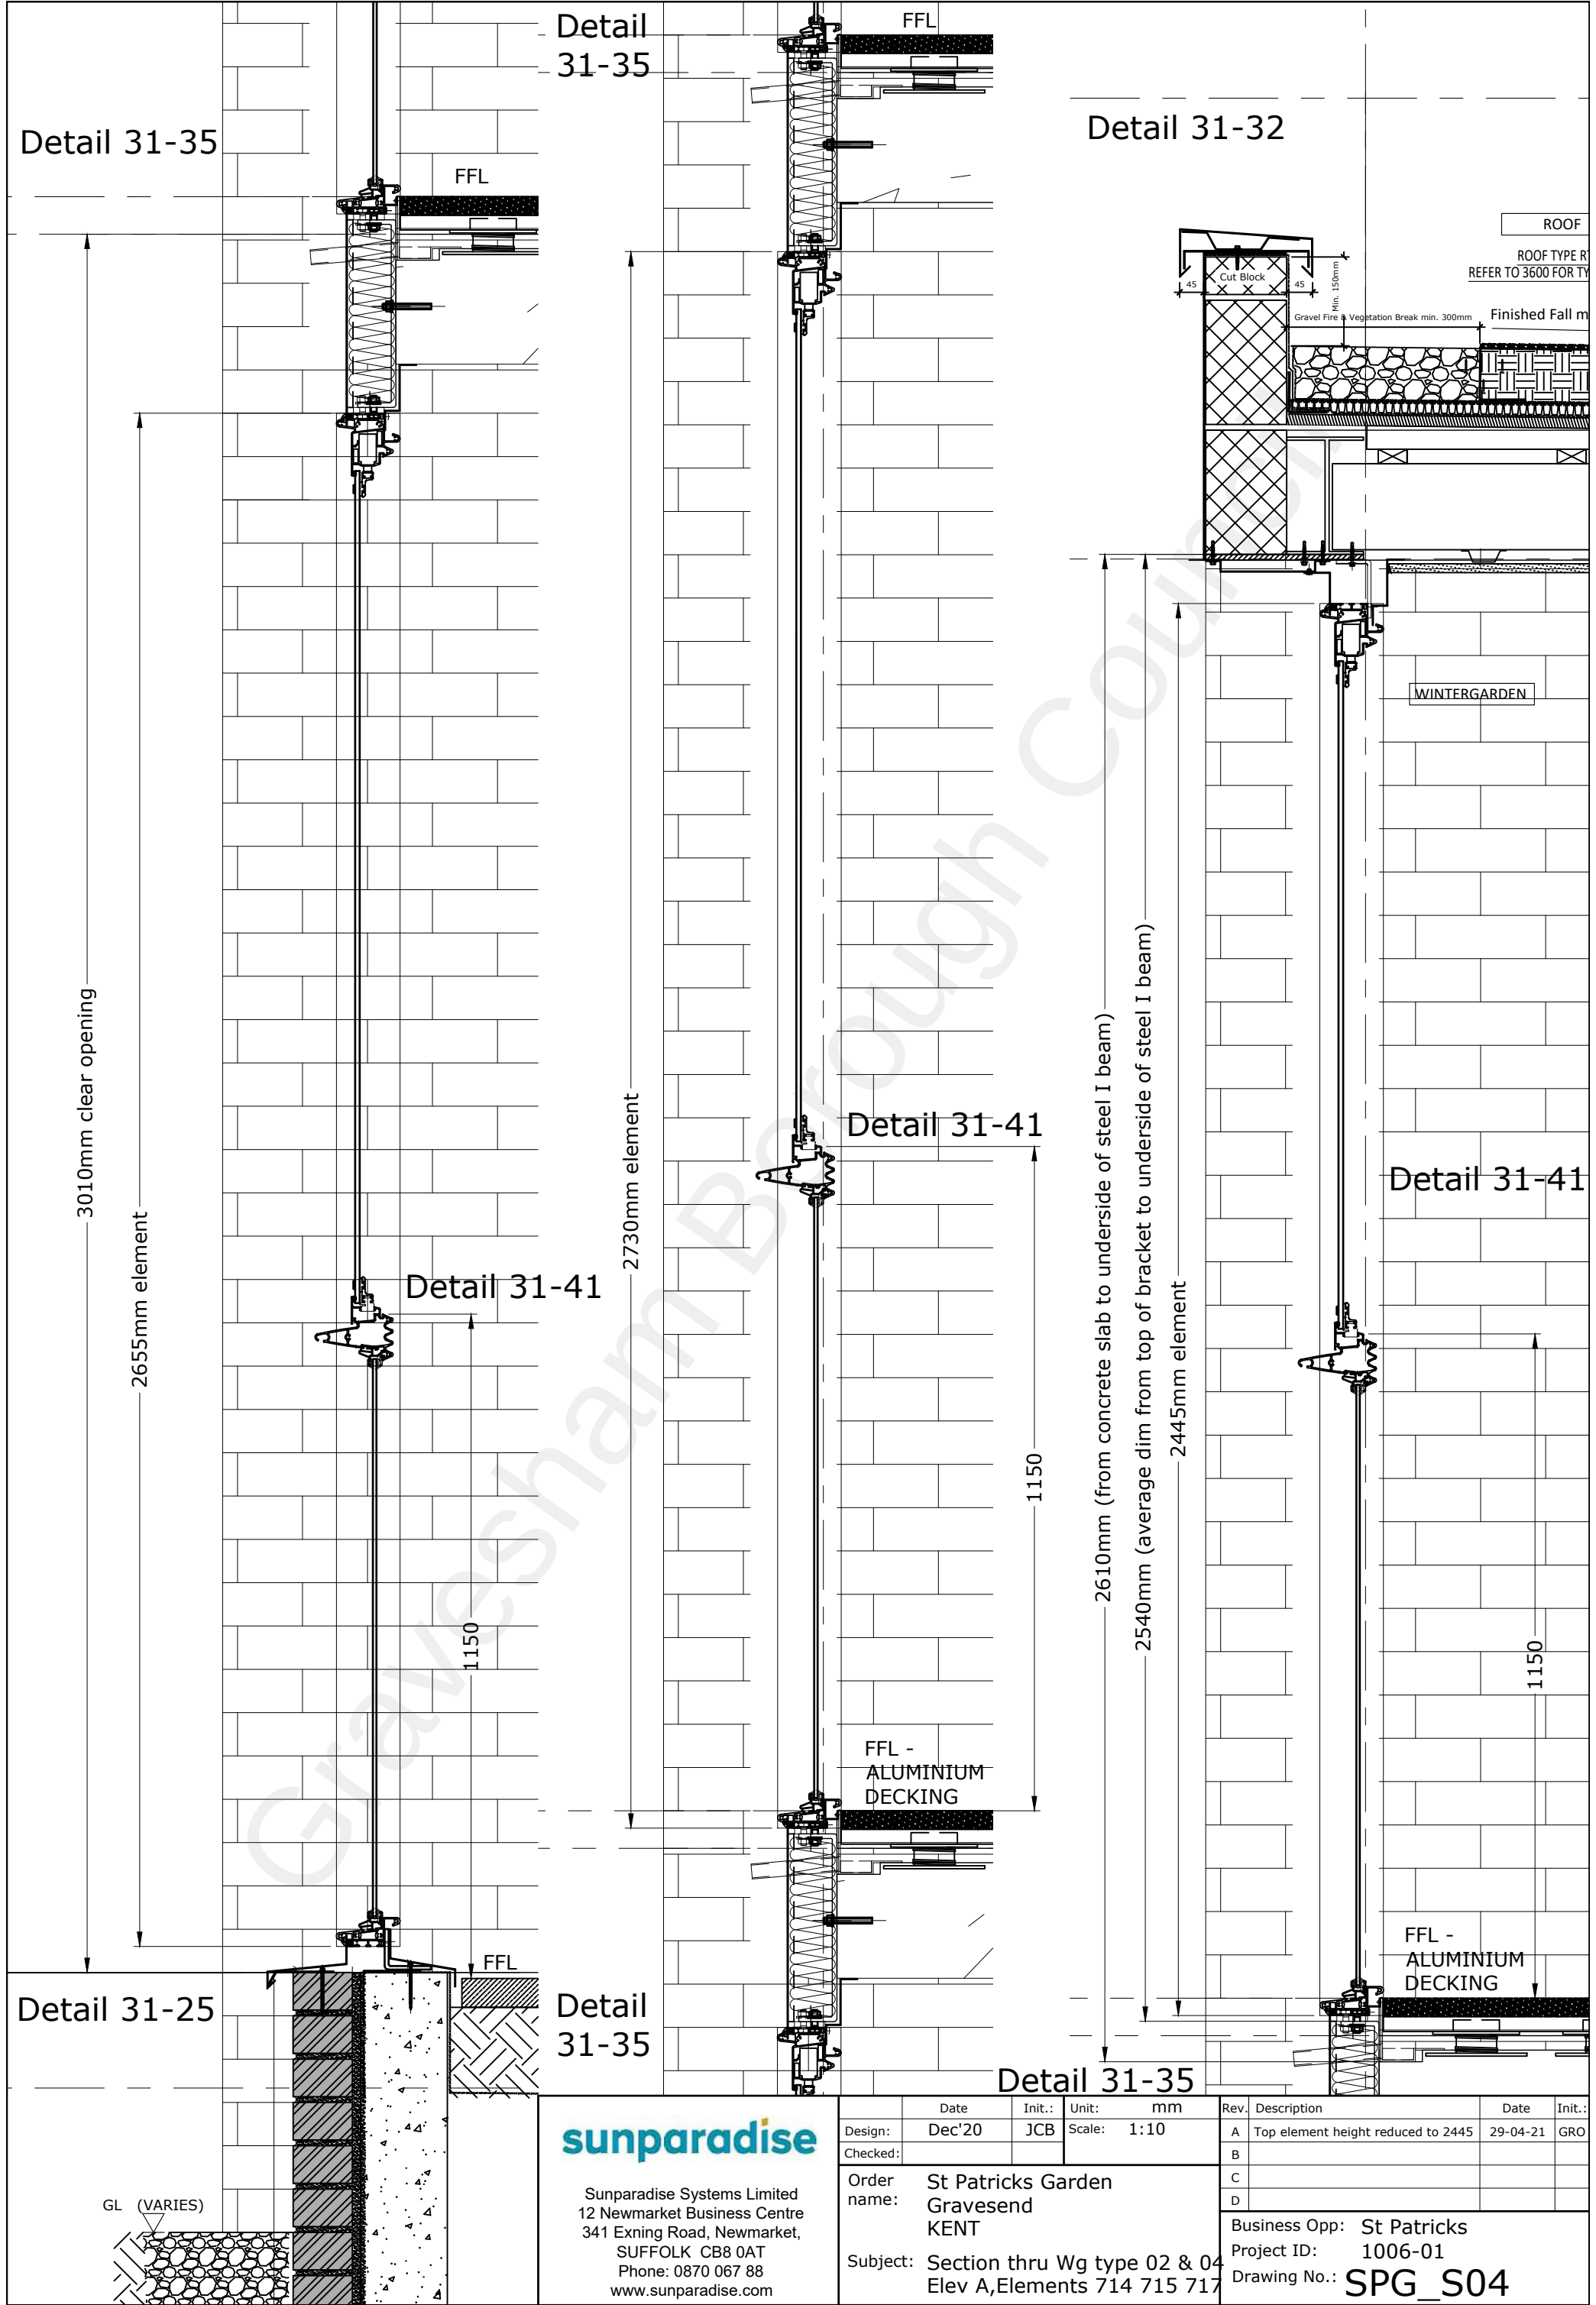

Detail 31-25

Detail 31-35

Detail 31-32

Detail 31-41

Detail 31-41


Detail 31-35

GL (VARIES)


sunparadise
Sunparadise Systems Limited
12 Newmarket Business Centre
341 Exning Road, Newmarket,
SUFFOLK CB8 0AT
Phone: 0870 067 88
www.sunparadise.com

Design:	Date	Init.:	Unit:	mm
Checked:	Dec'20	JCB	Scale:	1:10
Order name:	St Patricks Garden Gravesend KENT			
Subject:	Section thru Wg type 02 & 04 Elev A, Elements 714 715 717			

Rev.	Description	Date	Init.:
A	Top element height reduced to 2445	29-04-21	GRO
B			
C			
D			
Business Opp: St Patricks			
Project ID: 1006-01			
Drawing No.: SPG_S04			

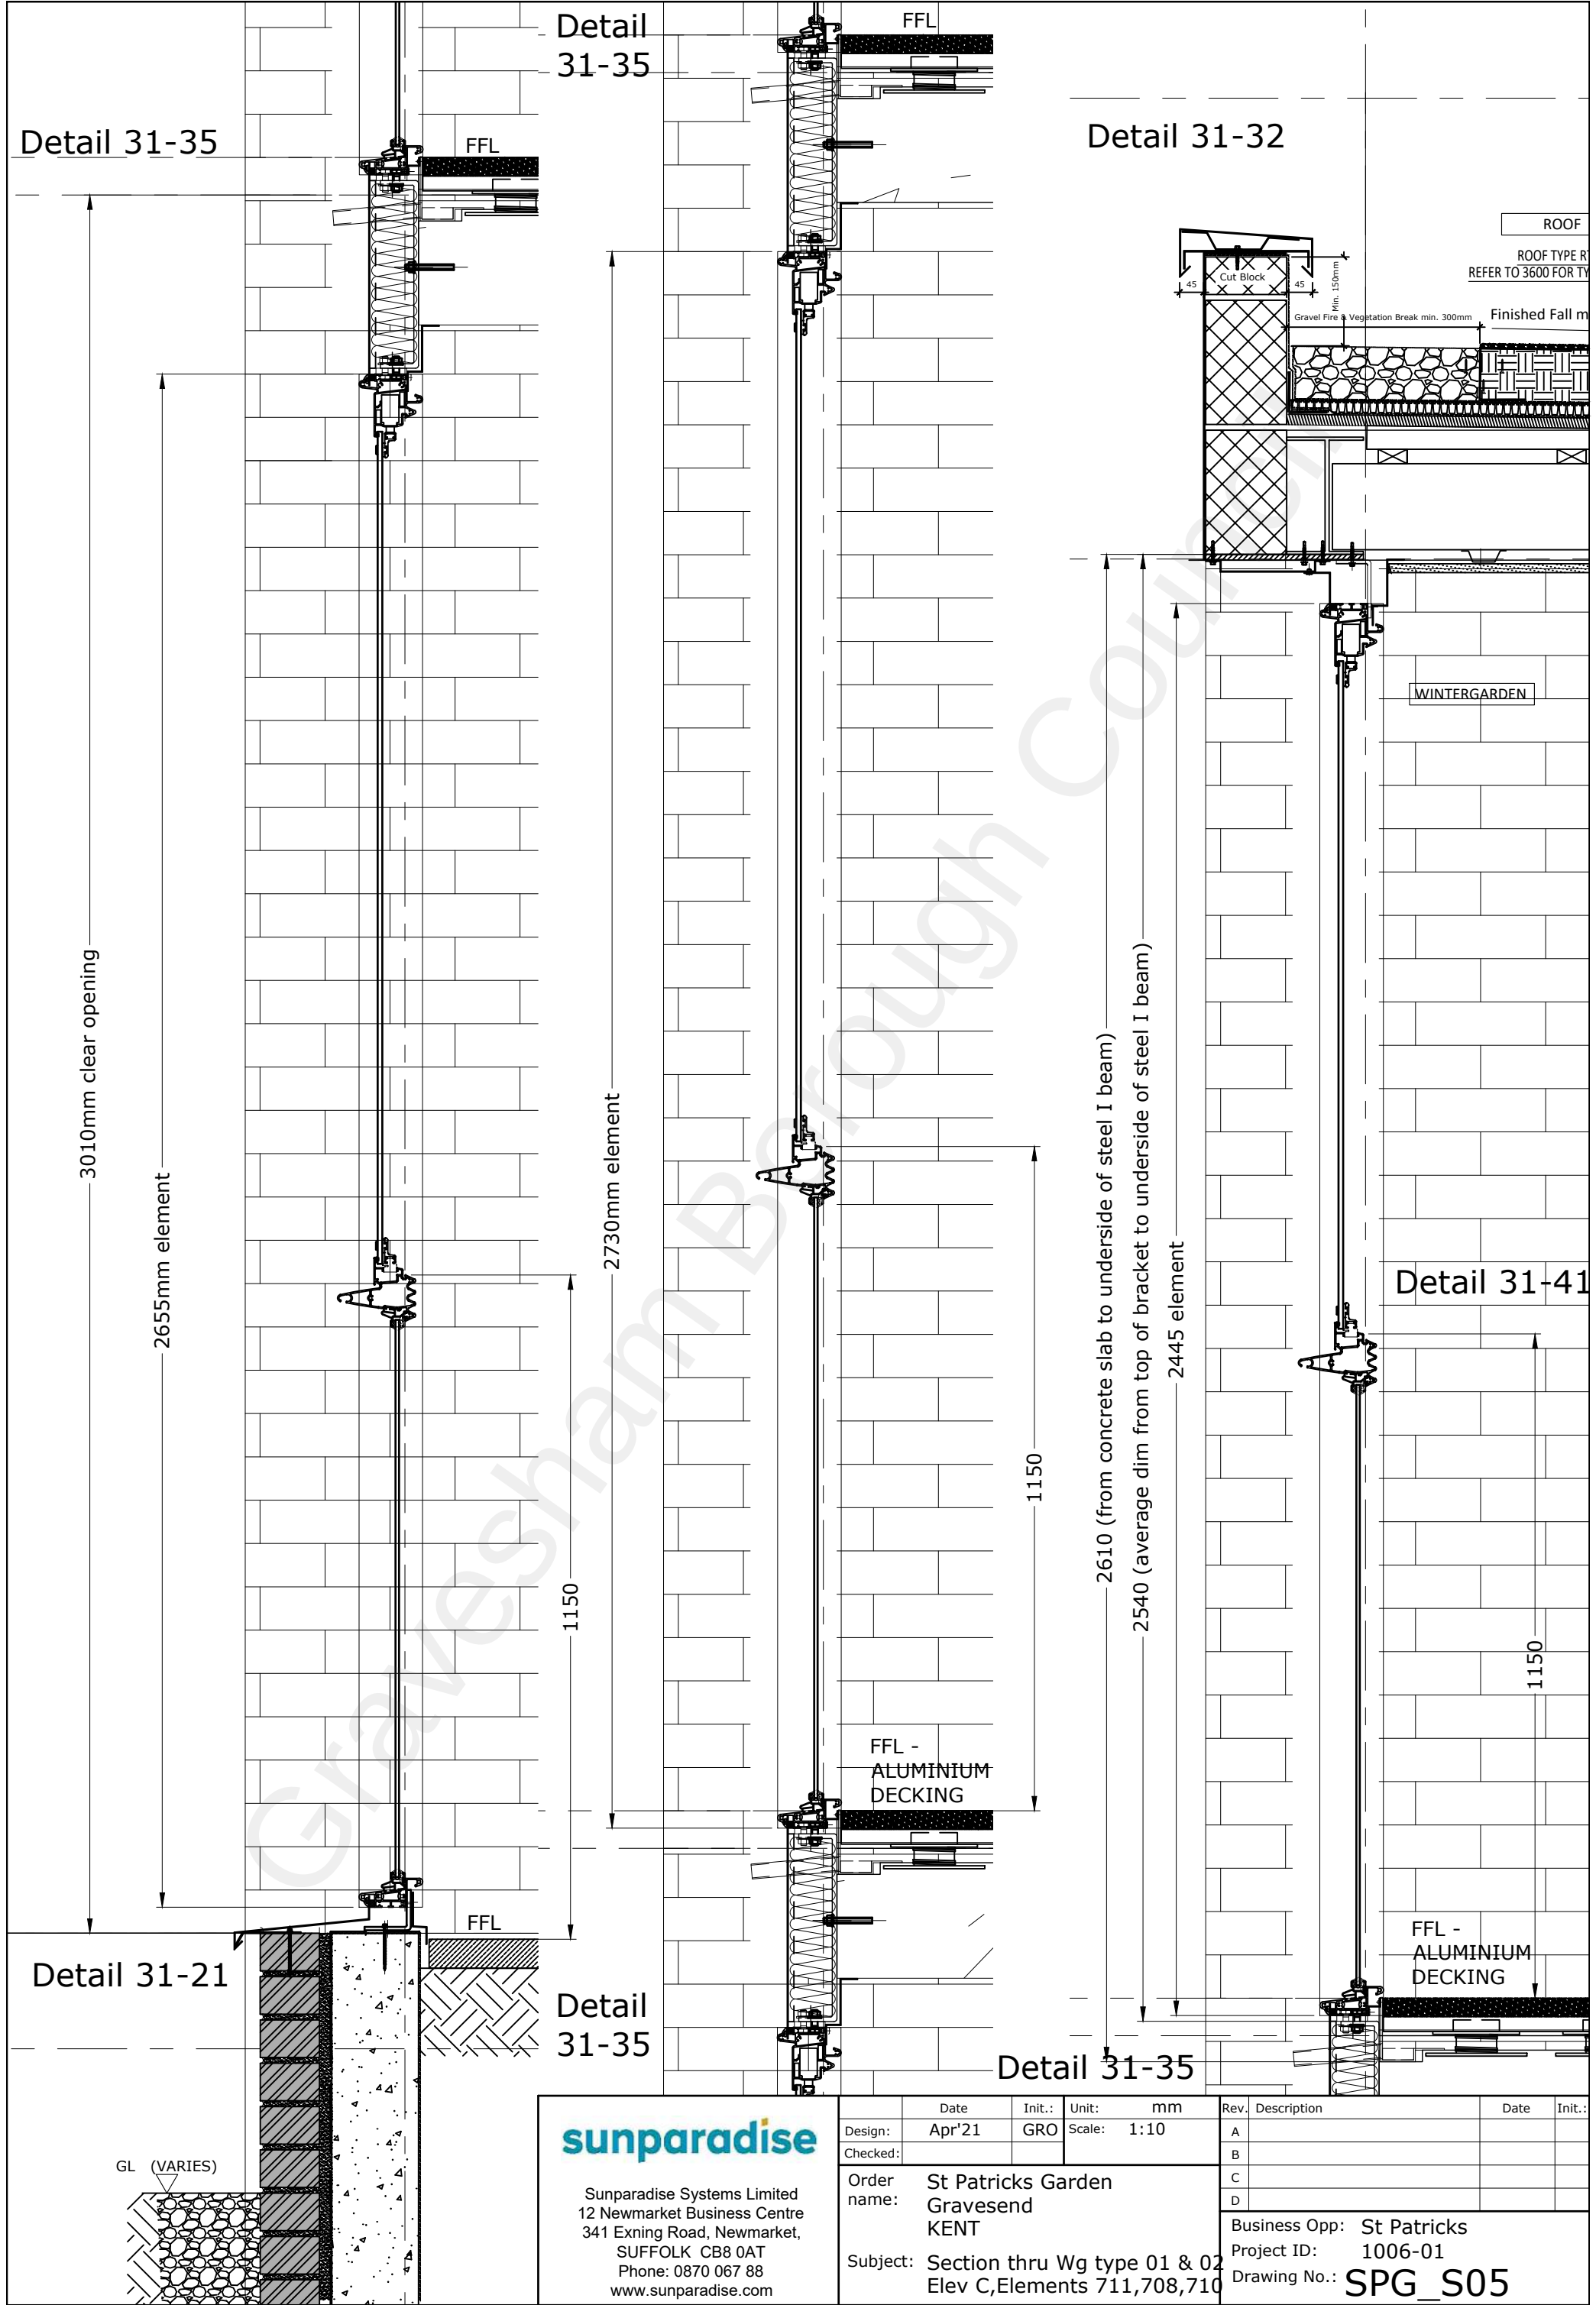

 Sunparadise Systems Limited 12 Newmarket Business Centre 341 Exning Road, Newmarket, SUFFOLK CB8 0AT Phone: 0870 067 88 www.sunparadise.com		Design:	Date: Apr'21	Init.:	GRO	Unit:	mm	Rev.	Description	Date	Init.:
		Checked:				Scale:	1:10	A			
Order name: St Patricks Garden Gravesend KENT		Subject: Section thru Wg type 01 & 02 Elev C, Elements 711,708,710		Business Opp: St Patricks		Project ID: 1006-01		C			
								D			
				Drawing No.: SPG_S05							

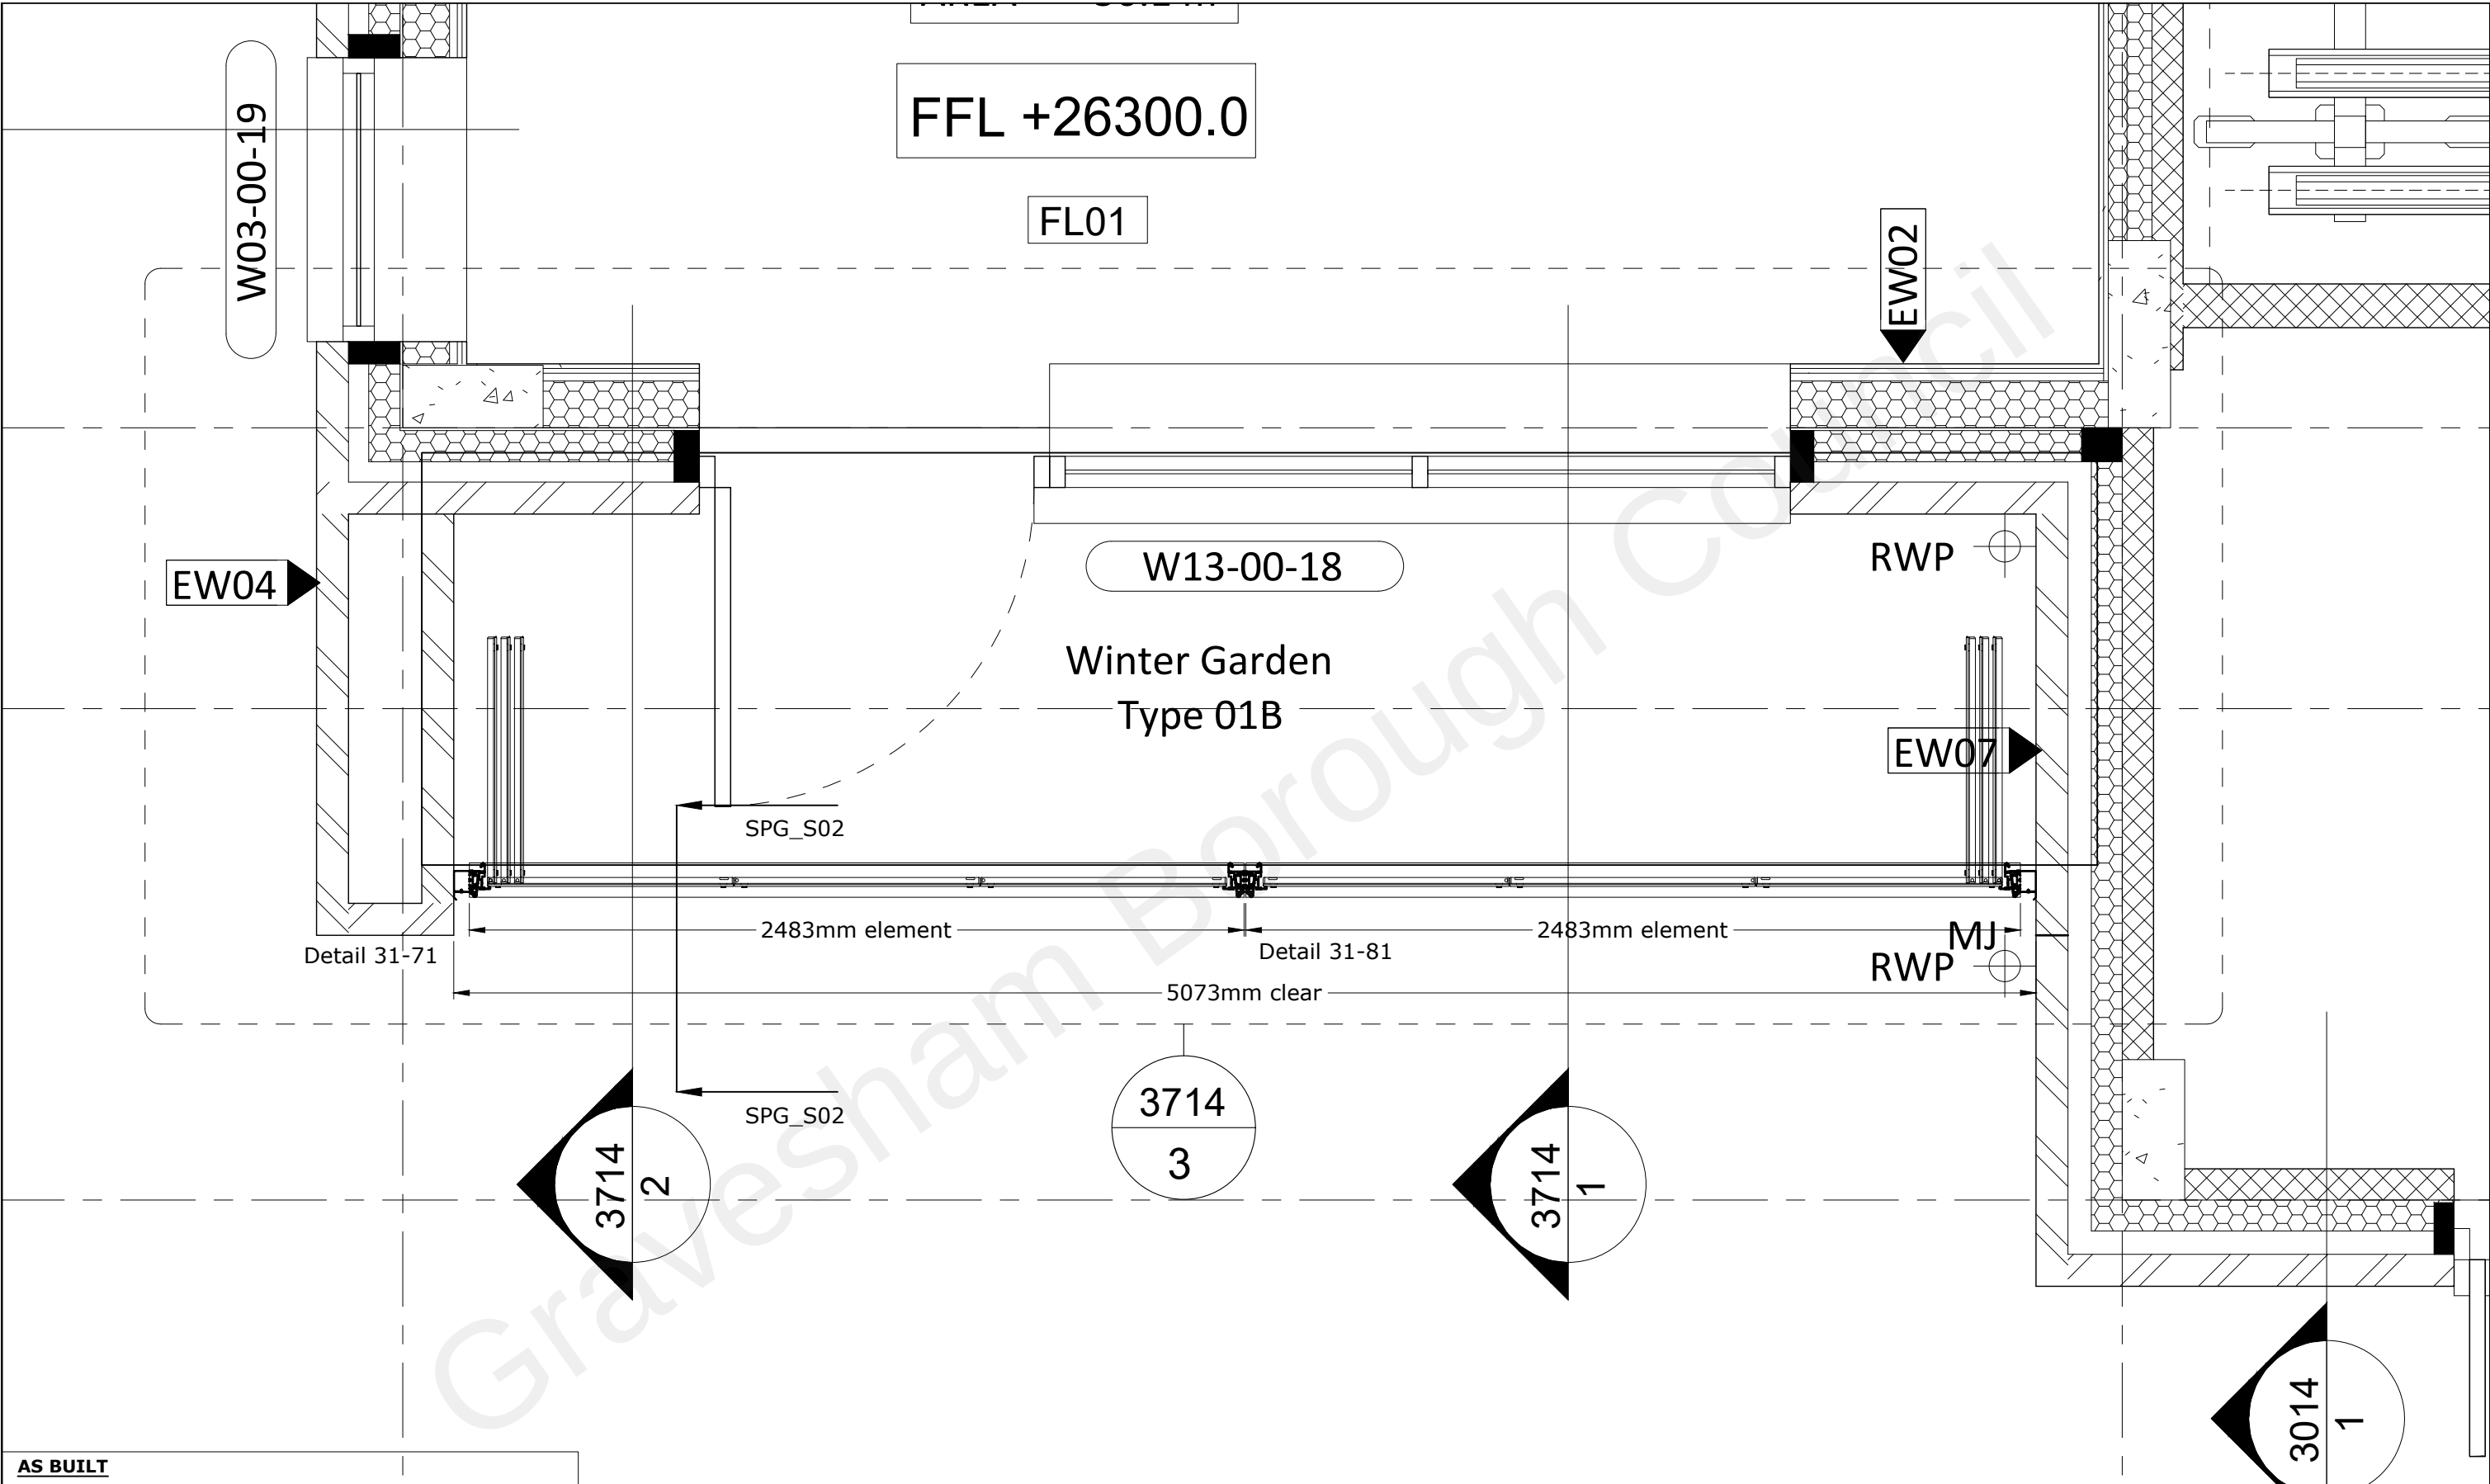

AS BUILT

Sunparadise system WD100 Light
Aluminium powder coated frame - RAL 7016 30% MATT
Balustrade section with 6.8mm clear laminated safety glass.
8mm clear toughened frameless sliding folding opening glass,
opening inwards through 90°.
1.5mm ppc aluminium pressings to the perimeter inside and
out, RAL 7016 30% MATT
Outward opening door 10mm clear toughened glass with
manifestation (to be agreed), stainless steel handle.
6mm clear laminated glass fanlight.


WG_1.0	ground floor	1 off	element 701, 702
WG_1.1	1st floor	1 off	element 703, 704
WG_1.2	2nd floor	1 off	element 703, 704
WG_1.3	3rd floor	1 off	element 705, 706



Sunparadise Systems Limited
12 Newmarket Business Centre
341 Exning Road, Newmarket,
SUFFOLK CB8 0AT
Phone: 0870 067 88
www.sunparadise.com

Date	Dec'20	Init.:	JCB	Unit:	mm	Rev.	Description	Date	Init.:
Design:	Dec'20	Init.:	JCB	Scale:	1:20	A	System description & colour added	01/02/21	GRO
Checked:						B			
Order name:	St Patricks Garden Gravesend KENT					C			
Subject:	WG_1 Ground floor					D			

Business Opp: St Patricks
Project ID: 1006-01
Drawing No.: **WG_1**

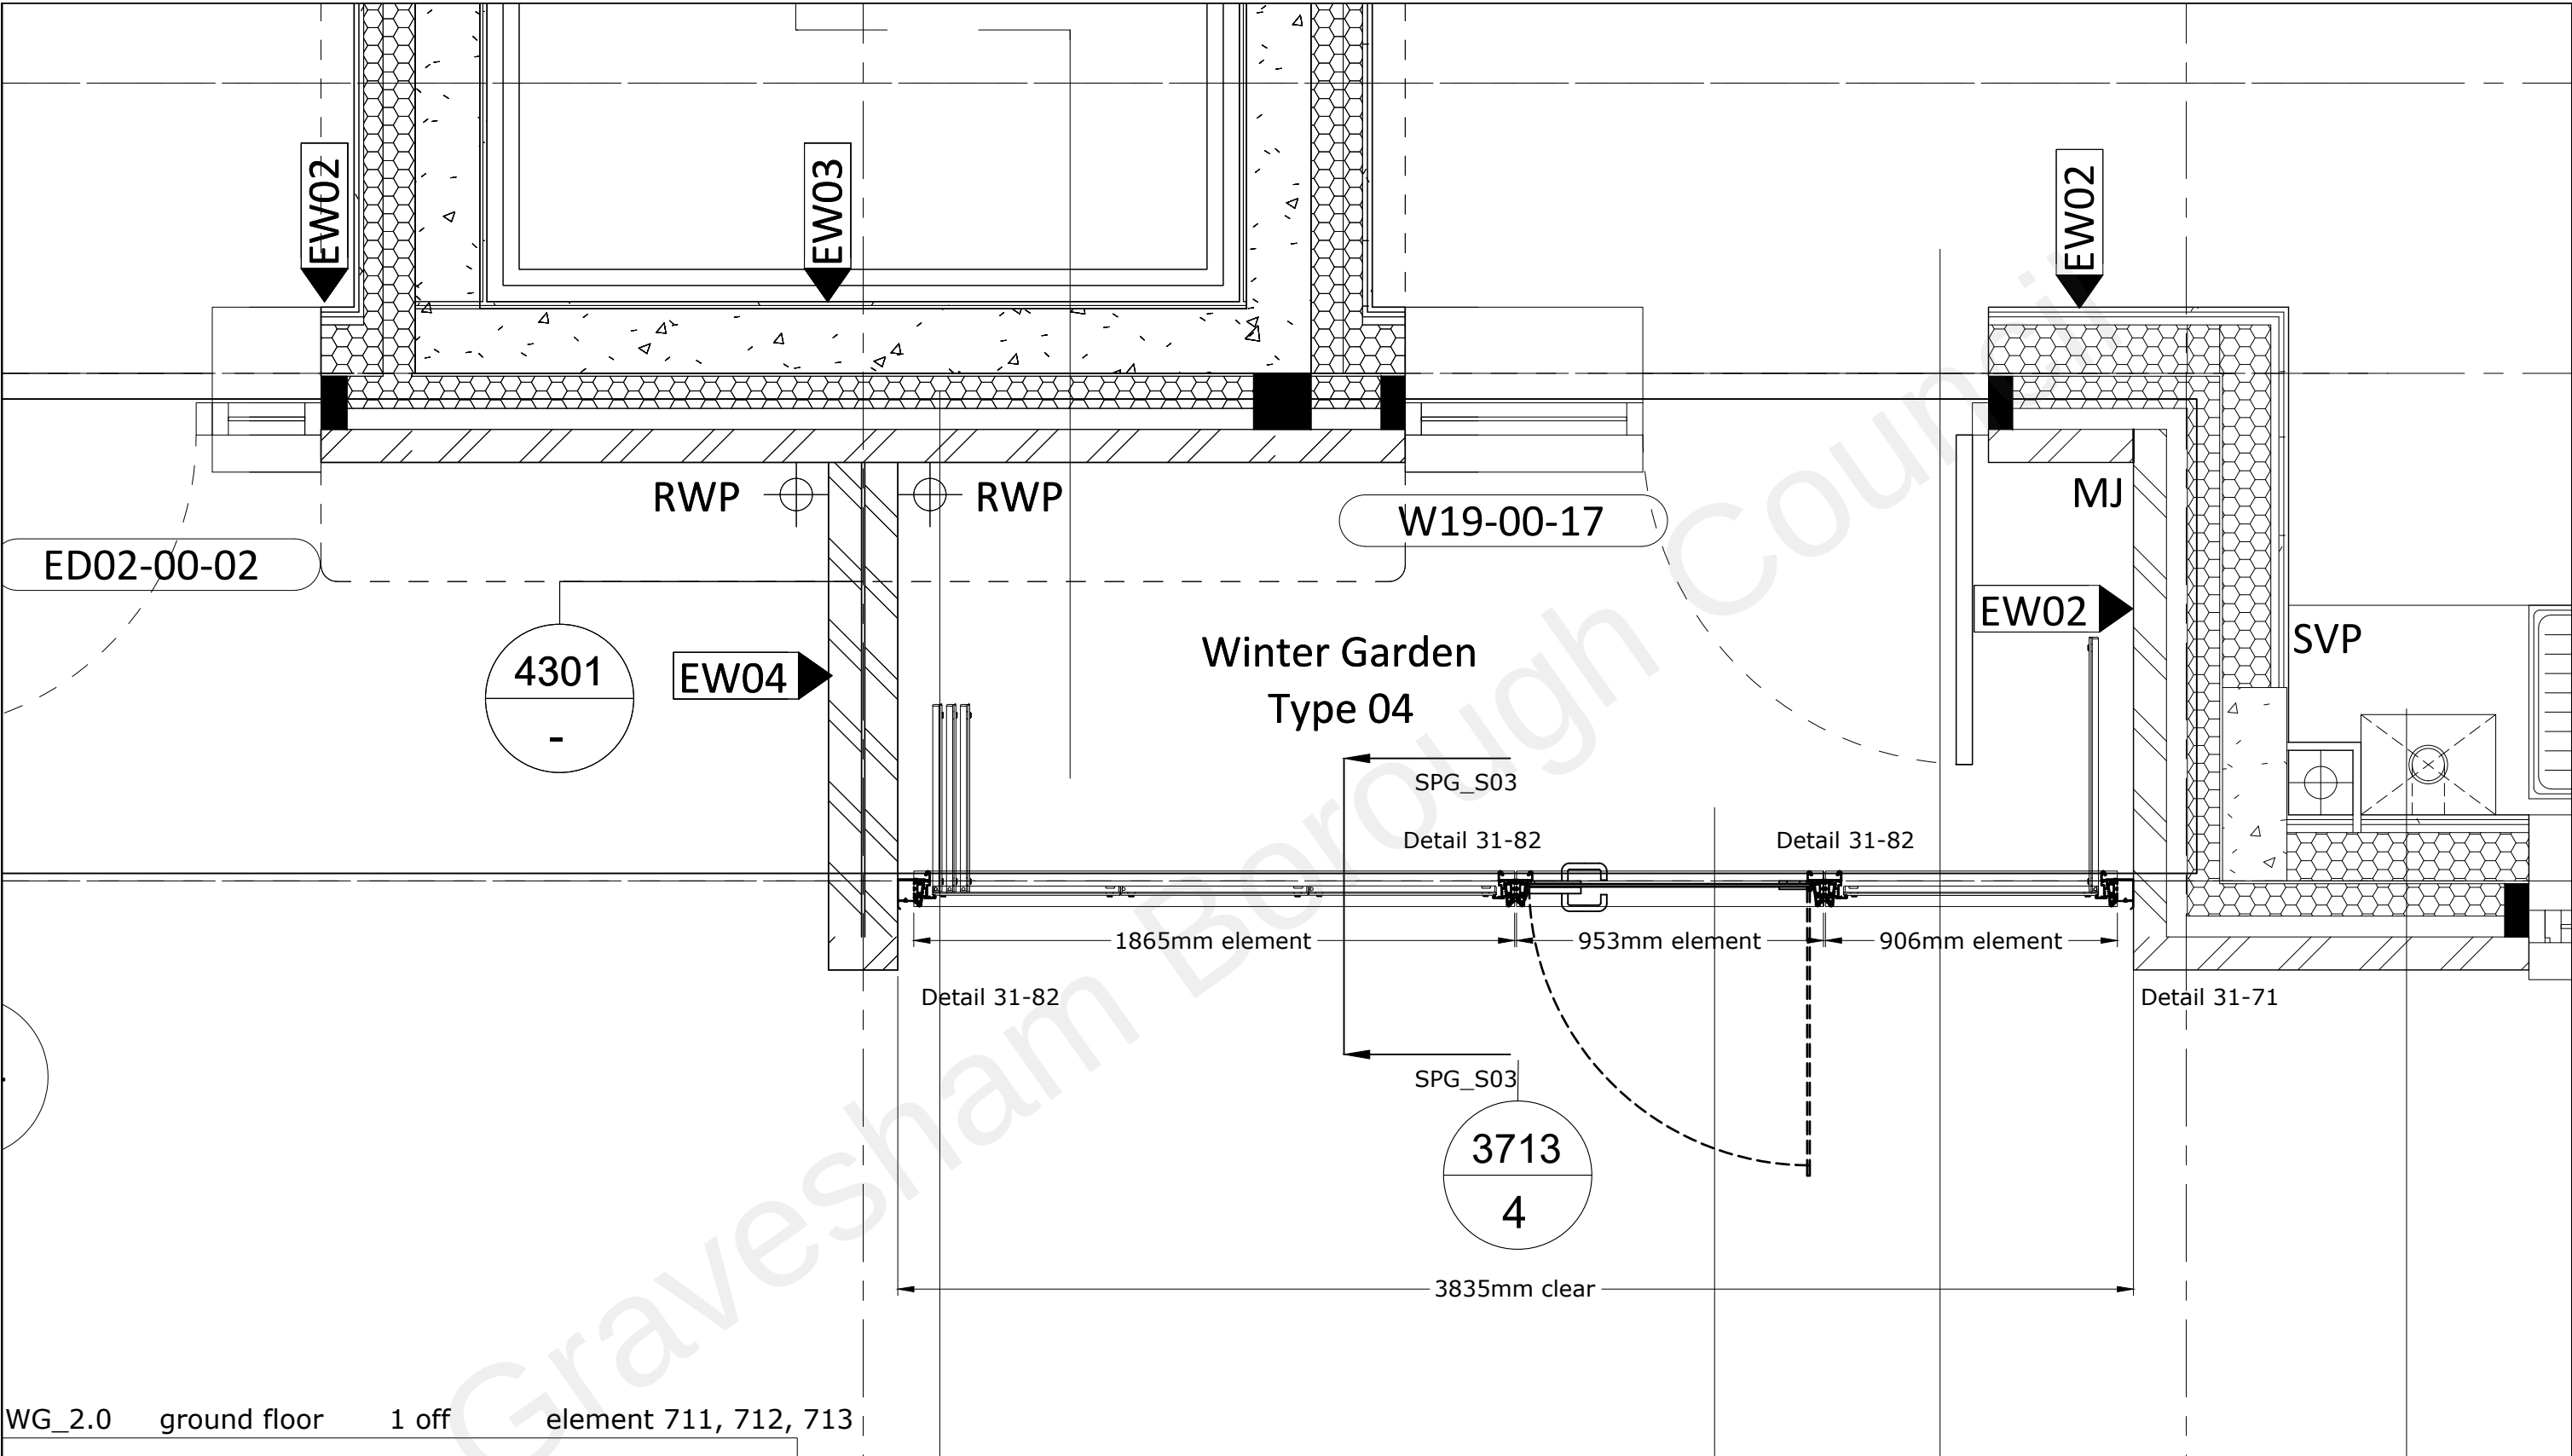


WG_2.0 ground floor 1 off element 711, 712, 713

AS BUILT

Sunparadise system WD100 Light
Aluminium powder coated frame - RAL 7016 30% MATT
Balustrade section with 6.8mm clear laminated safety glass.
8mm clear toughened frameless sliding folding opening glass,
opening inwards through 90°.
1.5mm ppc aluminium pressings to the perimeter inside and
out, RAL 7016 30% MATT
Outward opening door 10mm clear toughened glass with
manifestation (to be agreed), stainless steel handle.
6mm clear laminated glass fanlight.

 Sunparadise Systems Limited 12 Newmarket Business Centre 341 Exning Road, Newmarket, SUFFOLK CB8 0AT Phone: 0870 067 88 www.sunparadise.com		Date	Init.:	Unit:	mm	Rev.	Description	Date	Init.:	
	Design:	Dec'20	JCB	Scale:	1:20	A	System description & colour added	01/02/21	GRO	
	Checked:					B				
	Order name:	St Patricks Garden Gravesend KENT					C			
							D			
							Business Opp: St Patricks Project ID: 1006-01 Drawing No.: WG_2.0			
Subject:	WG_2.0 Ground floor									

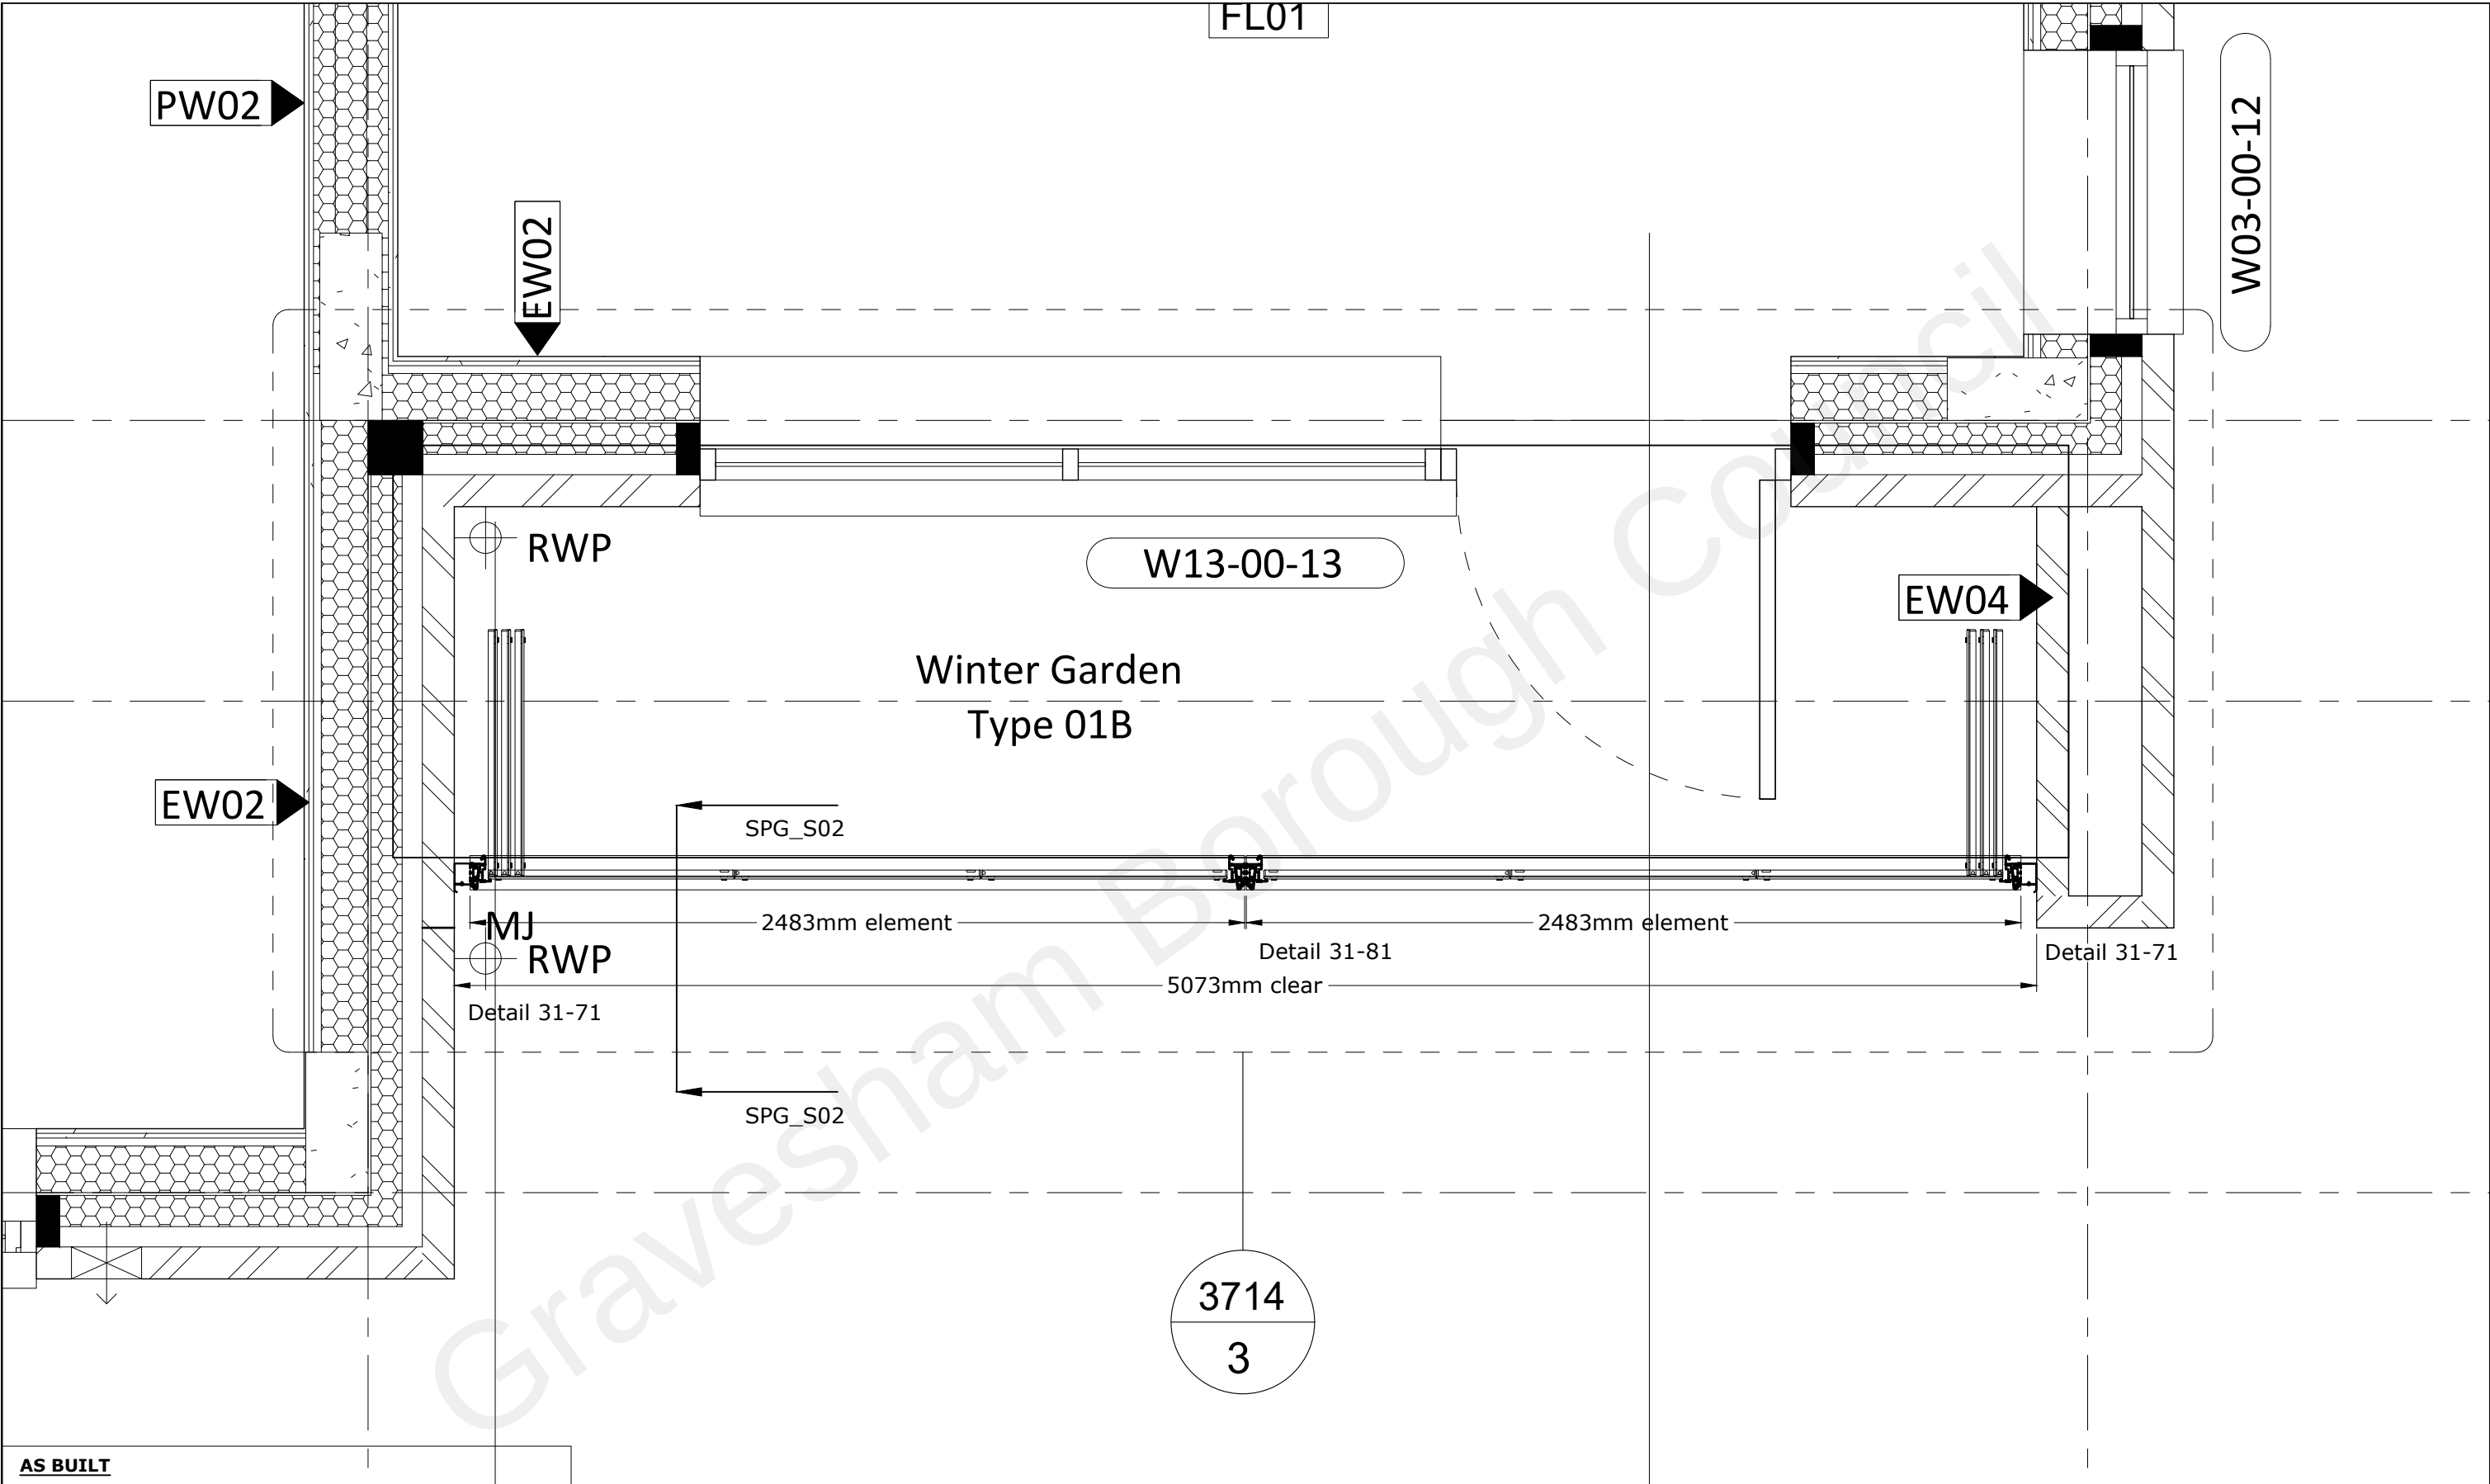

AS BUILT


Sunparadise system WD100 Light
Aluminium powder coated frame - RAL 7016 30% MATT
Balustrade section with 6.8mm clear laminated safety glass.
8mm clear toughened frameless sliding folding opening glass,
opening inwards through 90°.
1.5mm ppc aluminium pressings to the perimeter inside and
out, RAL 7016 30% MATT
Outward opening door 10mm clear toughened glass with
manifestation (to be agreed), stainless steel handle.
6mm clear laminated glass fanlight.

WG_3.0	ground floor	1 off	element 701, 702
WG_3.1	1st floor	1 off	element 703, 704
WG_3.2	2nd floor	1 off	element 703, 704
WG_3.3	3rd floor	1 off	element 705, 706



Sunparadise Systems Limited
12 Newmarket Business Centre
341 Exning Road, Newmarket,
SUFFOLK CB8 0AT
Phone: 0870 067 88
www.sunparadise.com

Design:	Date	Init.:	Unit:	mm	Rev.	Description	Date	Init.:
Checked:	Dec'20	JCB	Scale:	1:20	A	System description & colour added	01/02/21	GRO
Order name:	St Patricks Garden Gravesend KENT				B			
Subject:	WG_3 Ground floor				C			
					D			
					Business Opp: St Patricks Project ID: 1006-01 Drawing No.: WG_3			

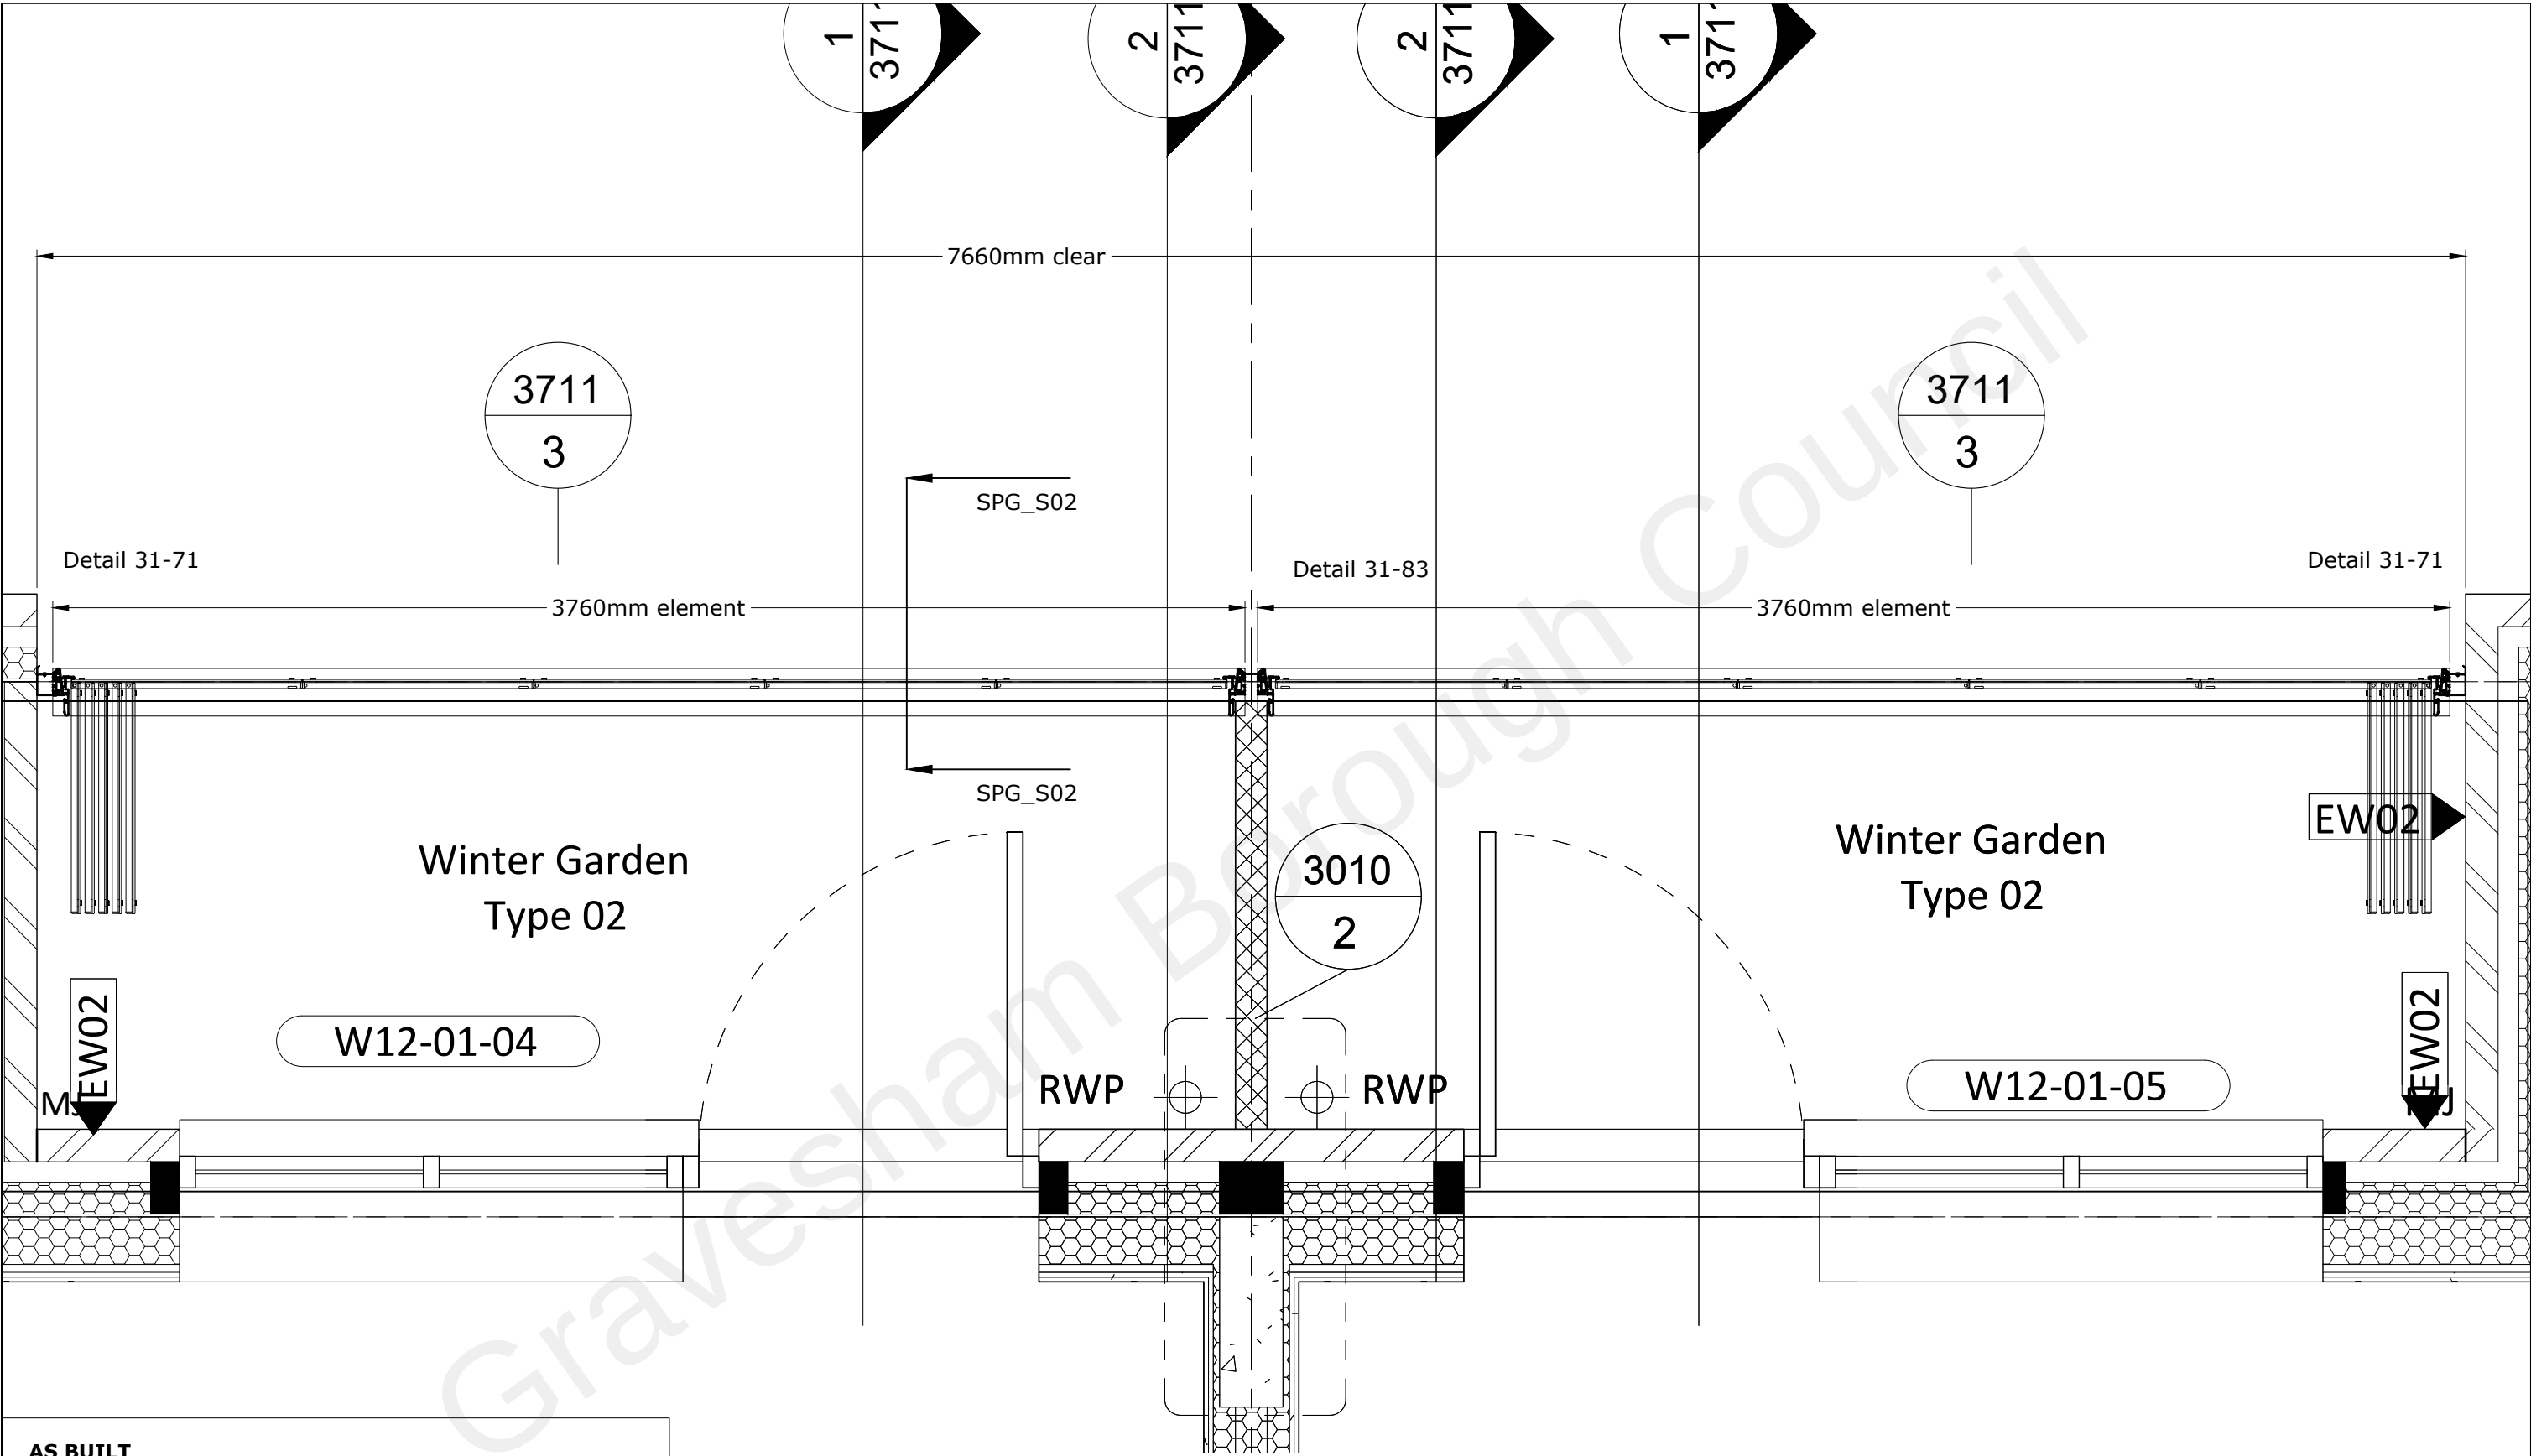

AS BUILT


Sunparadise system WD100 Light
Aluminium powder coated frame - RAL 7016 30% MATT
Balustrade section with 6.8mm clear laminated safety glass.
8mm clear toughened frameless sliding folding opening glass,
opening inwards through 90°.
1.5mm ppc aluminium pressings to the perimeter inside and
out, RAL 7016 30% MATT
Outward opening door 10mm clear toughened glass with
manifestation (to be agreed), stainless steel handle.
6mm clear laminated glass fanlight.

WG_4.1	1st floor	1 off	element 715, 716
WG_4.2	2nd floor	1 off	element 715, 716
WG_4.3	3rd floor	1 off	element 717, 718

 Sunparadise Systems Limited 12 Newmarket Business Centre 341 Exning Road, Newmarket, SUFFOLK CB8 0AT Phone: 0870 067 88 www.sunparadise.com		Date	Init.:	Unit:	mm	Rev.	Description	Date	Init.:
	Design:	Dec'20	JCB	Scale:	1:20	A	System description & colour added	01/02/21	GRO
	Checked:					B			
	Order name:	St Patricks Garden Gravesend KENT				C			
						D			
Subject:	WG_4.1 1st floor				Business Opp: St Patricks Project ID: 1006-01 Drawing No.: WG_4.1				

Clear laminated float safety glass - internally glazed

Brickwork line on corner

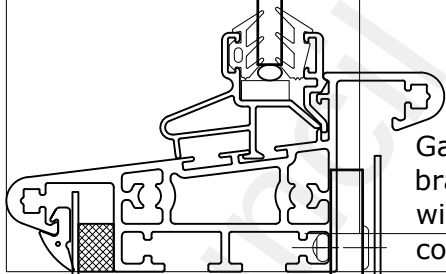

Galvanised mild steel fixing bracket @ nom. 1.0m CRS with Tapcon anchors to concrete upstand

Powder coated aluminum closure mechanically fixed to base frame

Finished floor level

65
30
45

Powder coated aluminum drip pressing & support - 45mm oversail. EDPM to element perimeter frame Cill flashing to extend to the outside corner (400mm beyond the wintergarden glazing) and be complete with a stopend.

277

Wintergarden Type 03

AS BUILT

Sunparadise system WD100 Light

Aluminium powder coated frame - RAL 7016 30% MATT
Balustrade section with 6.8mm clear laminated safety glass.
8mm clear toughened frameless sliding folding opening glass, opening inwards through 90°.
1.5mm ppc aluminium pressings to the perimeter inside and out, RAL 7016 30% MATT
Outward opening door 10mm clear toughened glass with manifestation (to be agreed), stainless steel handle.
6mm clear laminated glass fanlight.

sunparadise


Sunparadise Systems Limited
12 Newmarket Business Centre
341 Exning Road, Newmarket,
SUFFOLK CB8 0AT
Phone: 0870 067 88
www.sunparadise.com

Rev.	Description	Date	Init.:
A	Element ref added	18/01/21	GRO
B	Updated detail	27-1	JCB
C	System description & colour added	01/02/21	GRO
D			

Design:	Date	Init.:	Unit:
Checked:	Dec'20	JCB	Scale: 1:2

Order name:	St Patricks Garden Gravesend KENT
Subject:	Cill detail, Ground_1 Element 719

Business Opp:	St Patricks
Project ID:	1006-01
Drawing No.:	31-21

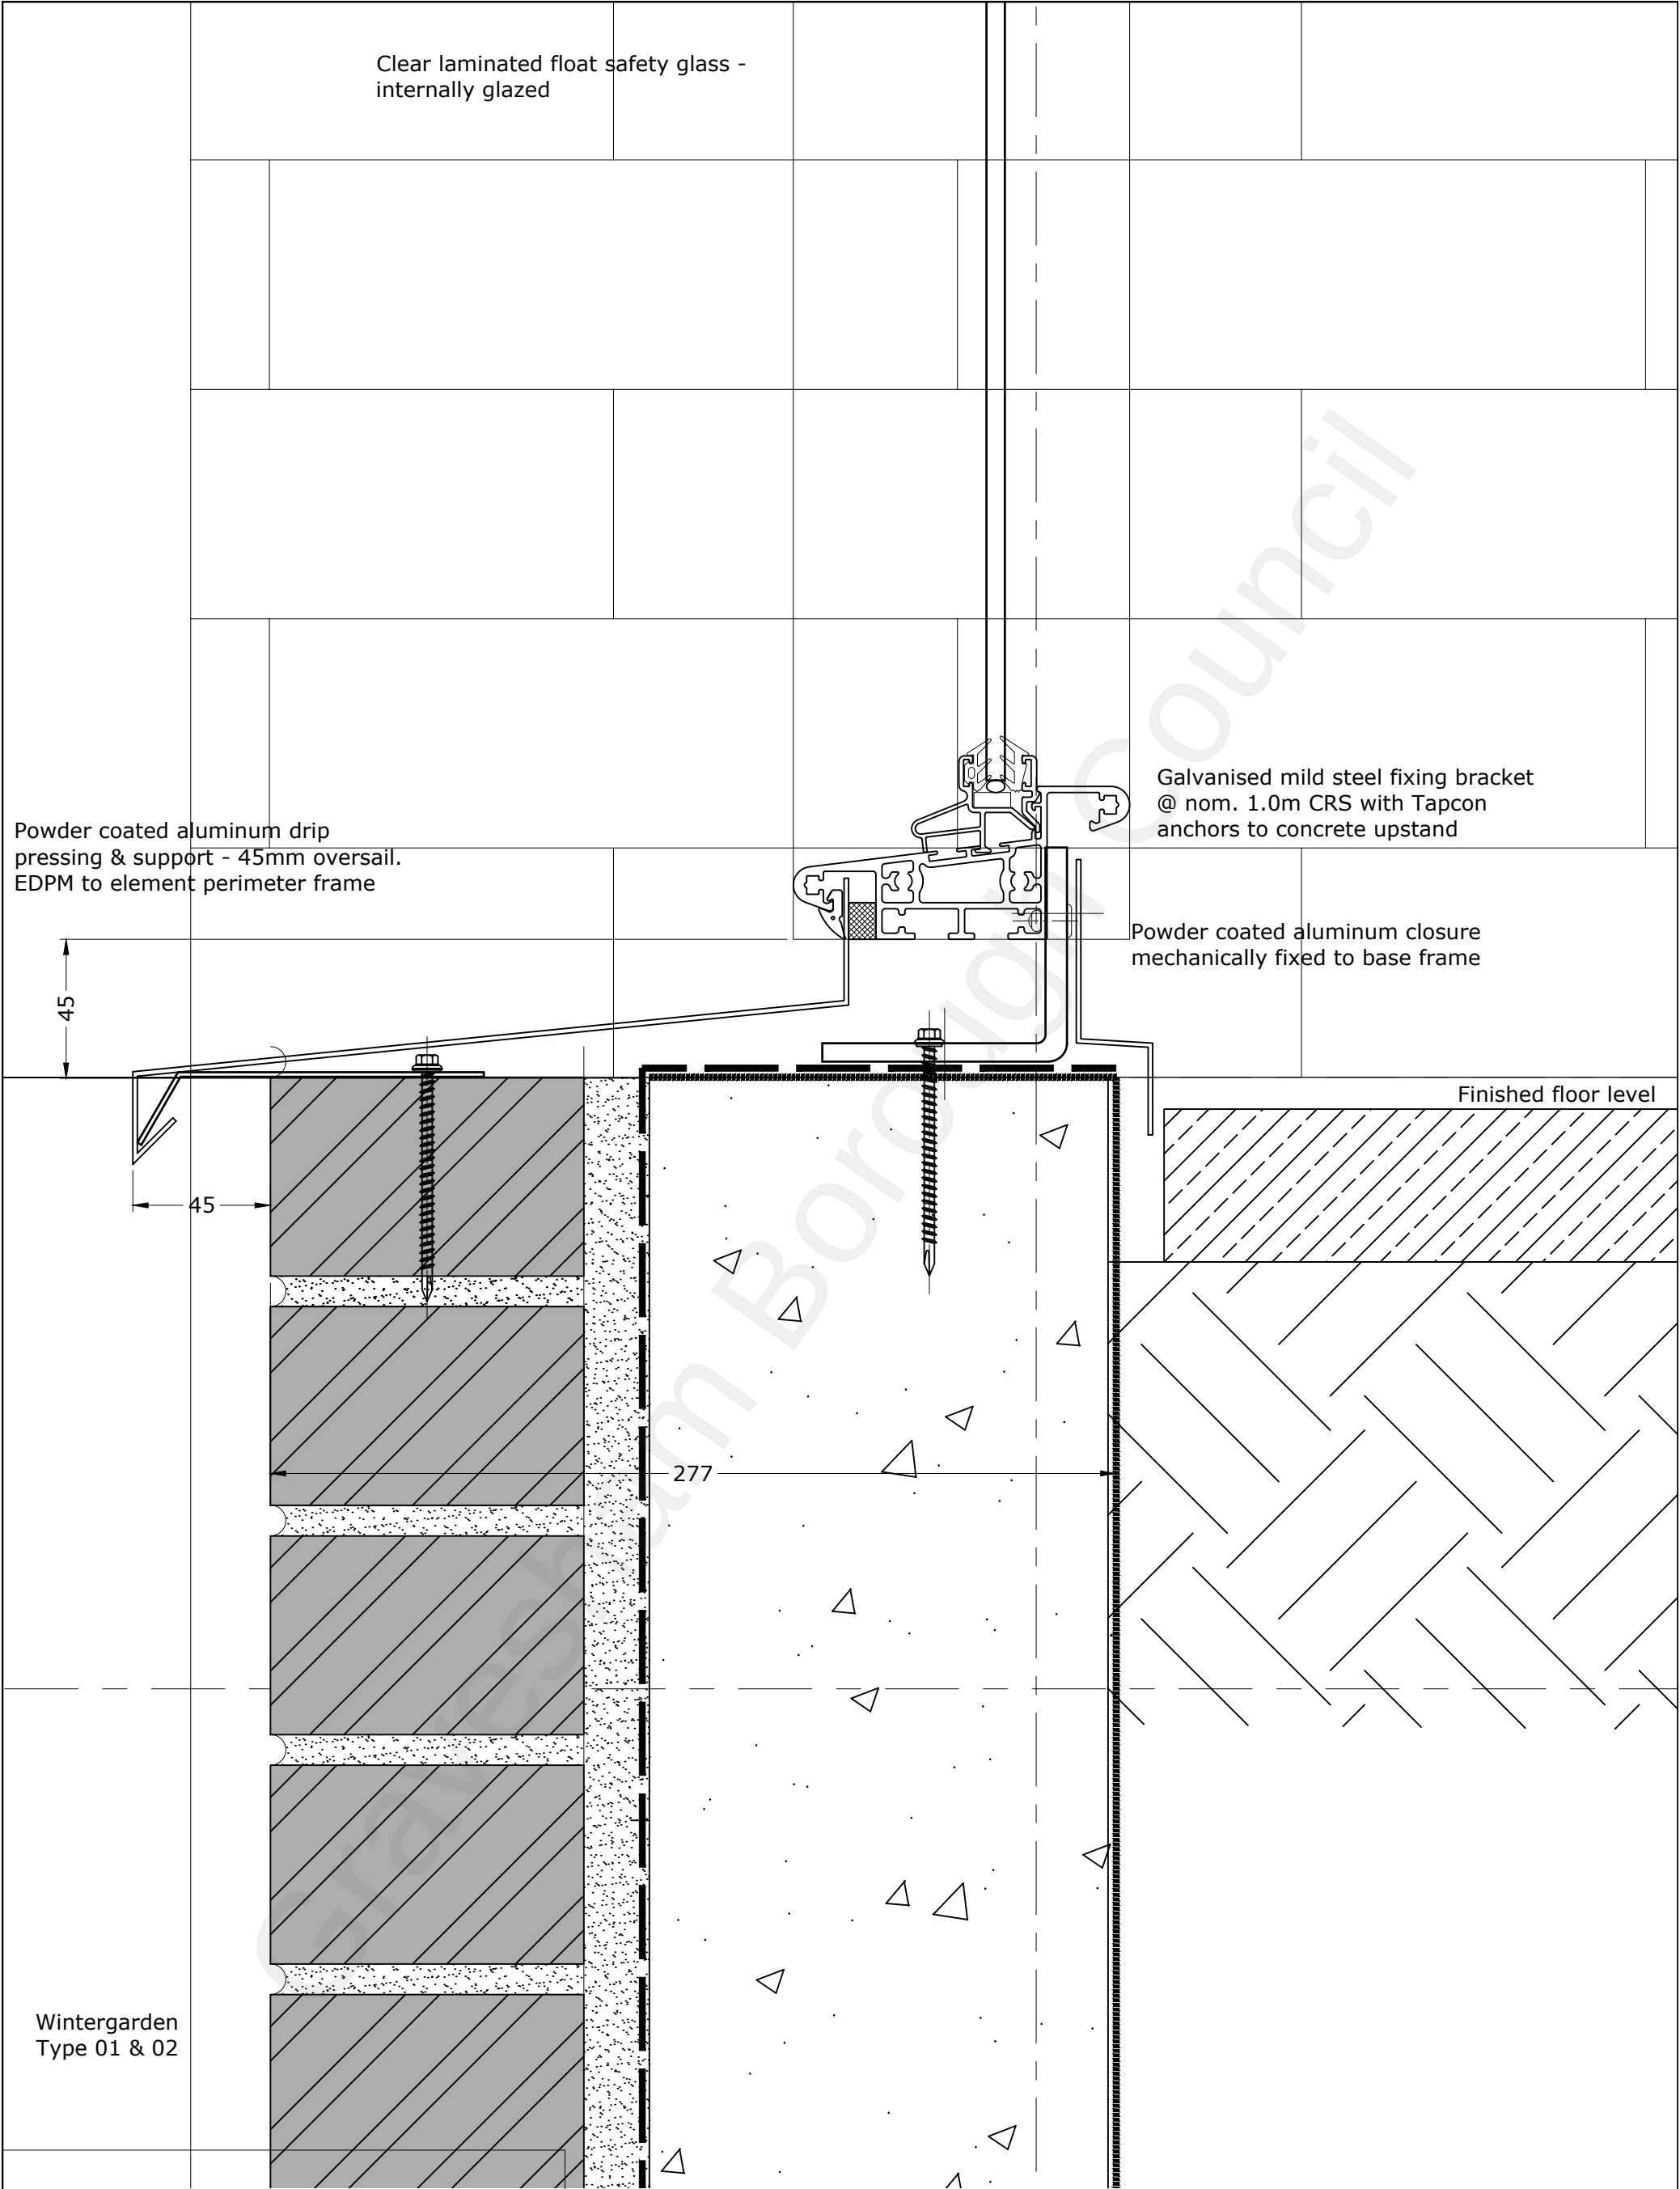


AS BUILT

Sunparadise system WD100 Light
Aluminium powder coated frame - RAL 7016 30% MATT
Balustrade section with 6.8mm clear laminated safety glass.
8mm clear toughened frameless sliding folding opening glass, opening inwards through 90°.
1.5mm ppc aluminium pressings to the perimeter inside and out, RAL 7016 30% MATT
Outward opening door 10mm clear toughened glass with manifestation (to be agreed), stainless steel handle.
6mm clear laminated glass fanlight.


sunparadise

Sunparadise Systems Limited
12 Newmarket Business Centre
341 Exning Road, Newmarket,
SUFFOLK CB8 0AT
Phone: 0870 067 88
www.sunparadise.com

	Date	Init.:	Unit:	Rev.	Description	Date	Init.:
Design:	Dec'20	JCB	Scale: 1:2	A	Elements ref added	18/01/21	A
Checked:				B	System description & colour added	01/02/21	GRO
Order name:	St Patricks Garden Gravesend KENT			C			
				D			
				Business Opp: St Patricks Project ID: 1006-01 Drawing No.: 31-22			
Subject:	Cill detail, Ground_2 Elements 701 & 702						

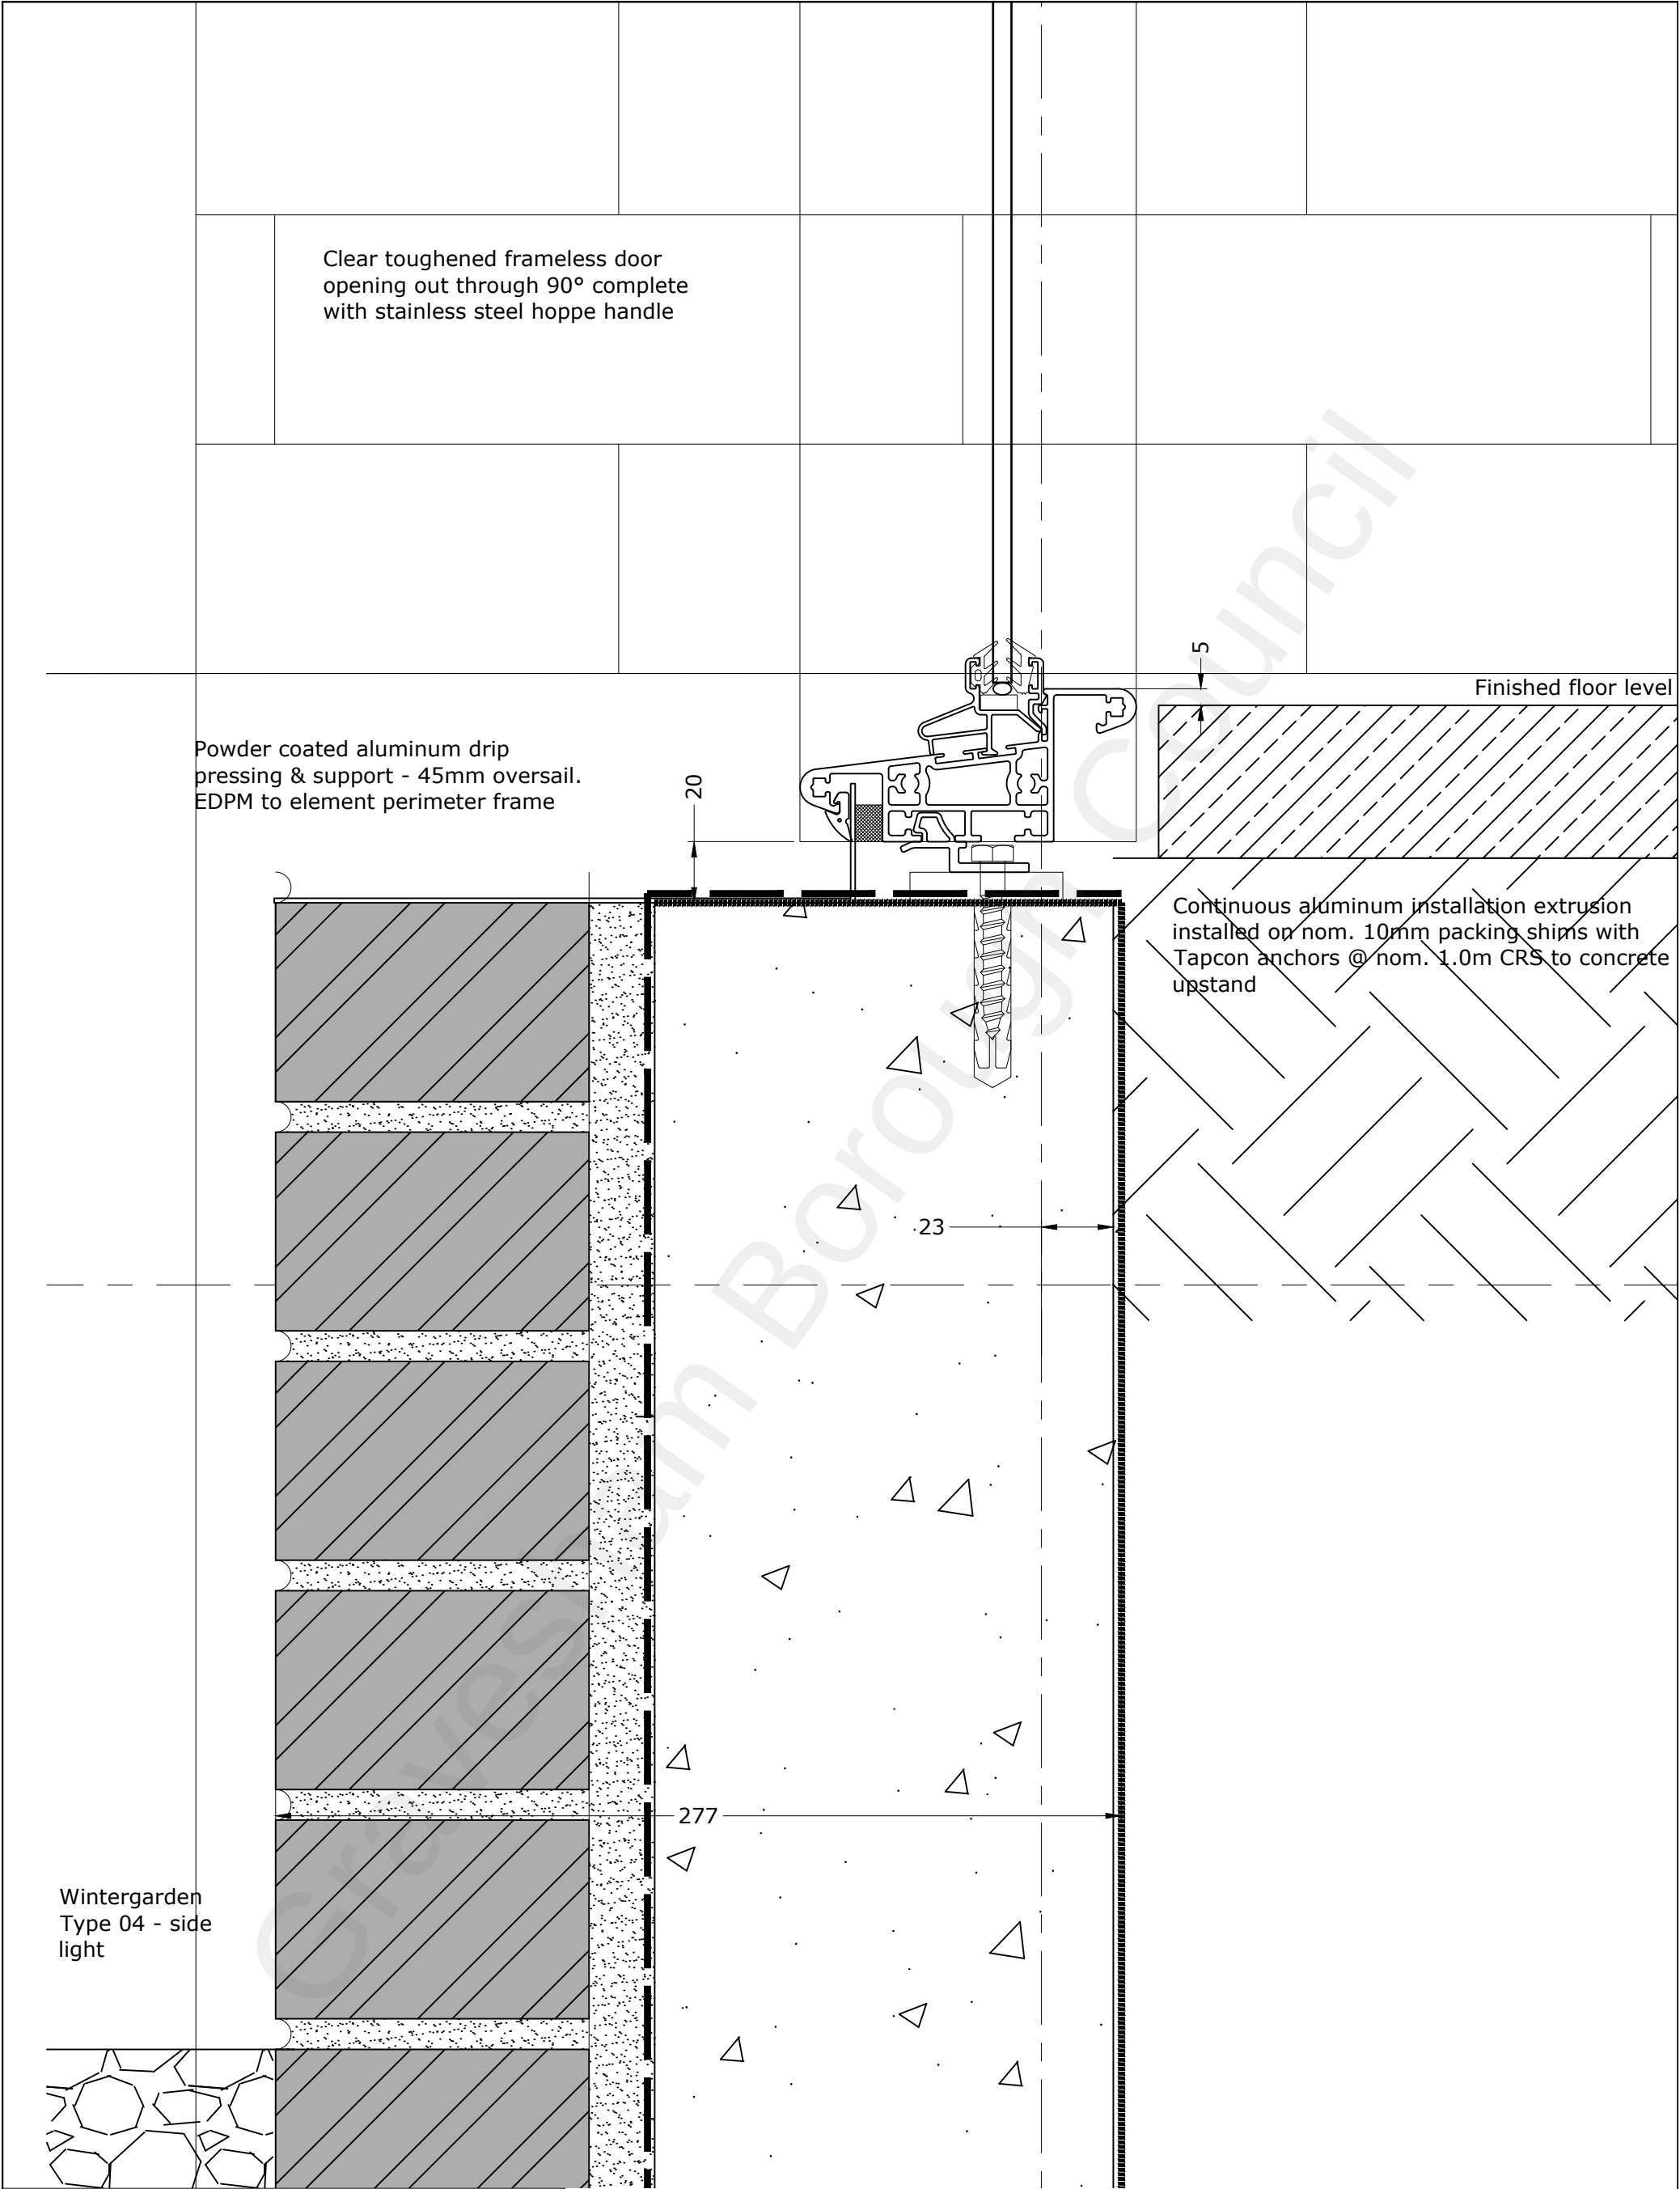


AS BUILT		sunparadise		Date: Dec'20 Init.: JCB Unit: Scale: 1:2		Rev. Description Date Init.: A Elements ref added 18/01/21 GRO B System description & colour added 01/02/21 GRO C D	
Sunparadise system WD100 Light Aluminium powder coated frame - RAL 7016 30% MATT Balustrade section with 6.8mm clear laminated safety glass. 8mm clear toughened frameless sliding folding opening glass, opening inwards through 90°. 1.5mm ppc aluminium pressings to the perimeter inside and out, RAL 7016 30% MATT Outward opening door 10mm clear toughened glass with manifestation (to be agreed), stainless steel handle. 6mm clear laminated glass fanlight.		Sunparadise Systems Limited 12 Newmarket Business Centre 341 Exning Road, Newmarket, SUFFOLK CB8 0AT Phone: 0870 067 88 www.sunparadise.com		Order name: St Patricks Garden Gravesend KENT Subject: Cill detail, Ground_3 Elements 711 & 713		Business Opp: St Patricks Project ID: 1006-01 Drawing No.: 31-23	

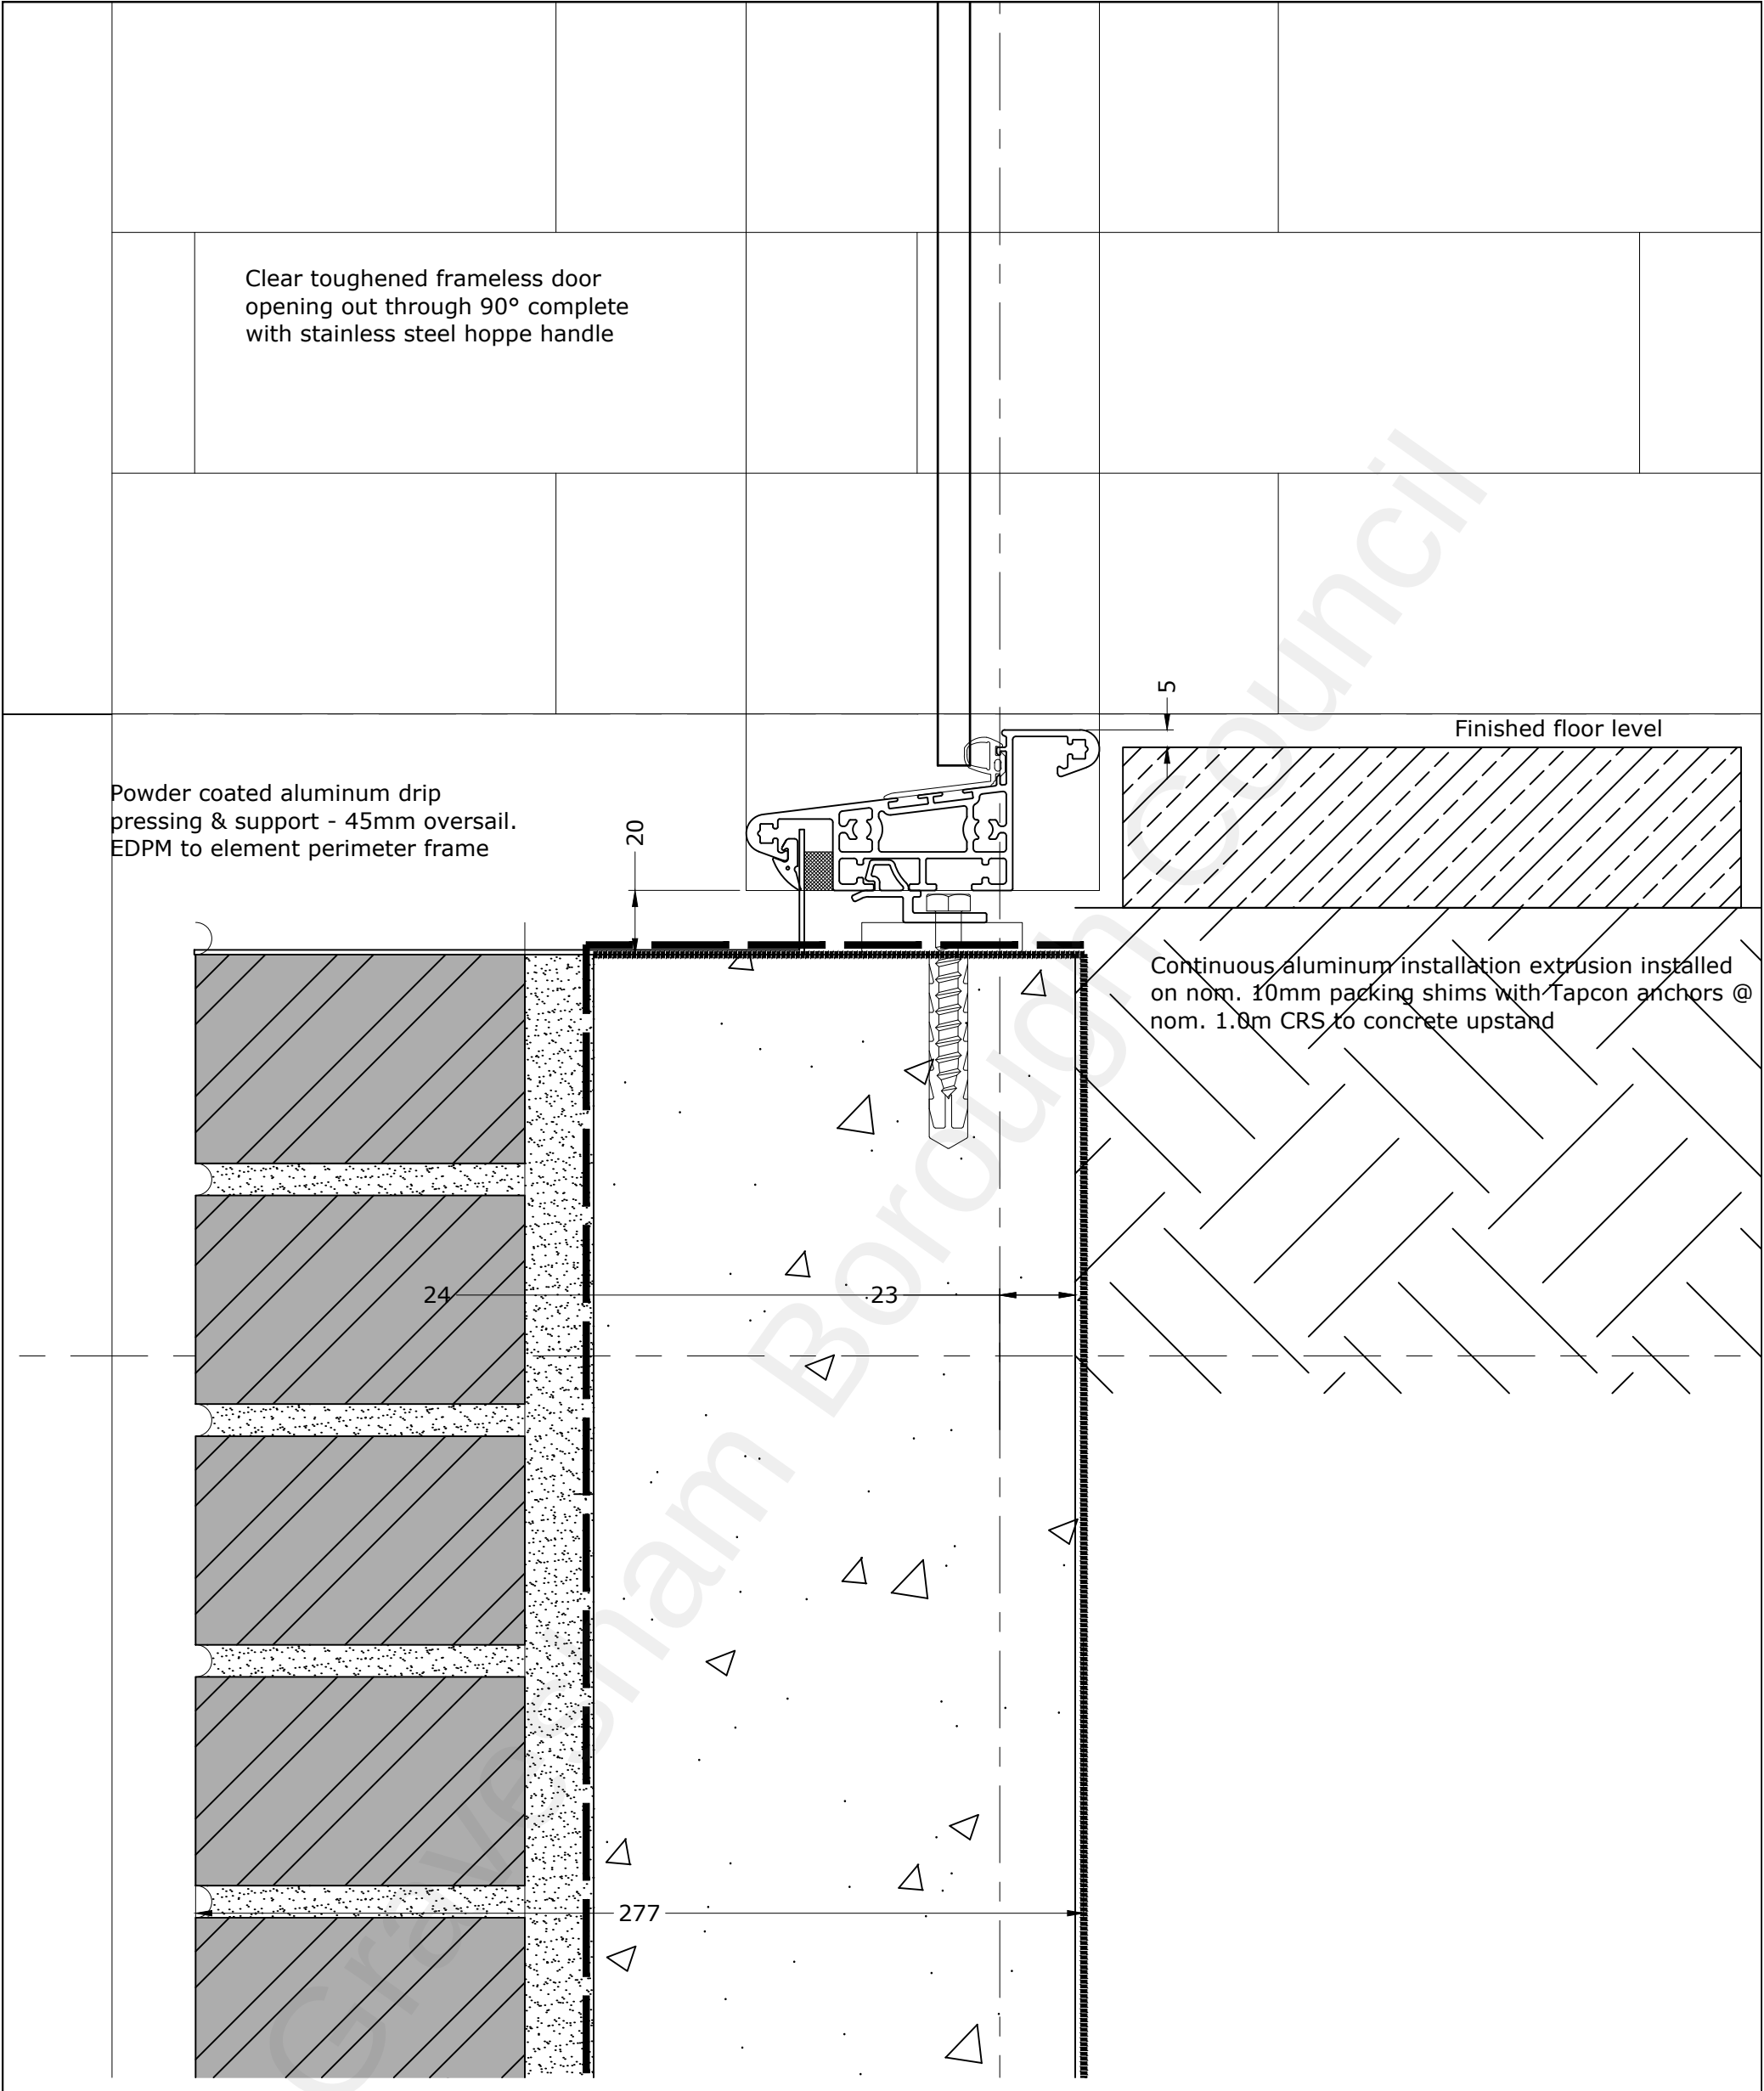


Wintergarden Type 04 - door

AS BUILT		Sunparadise system WD100 Light		Aluminium powder coated frame - RAL 7016 30% MATT		Balustrade section with 6.8mm clear laminated safety glass.		8mm clear toughened frameless sliding folding opening glass, opening inwards through 90°.		1.5mm ppc aluminium pressings to the perimeter inside and out, RAL 7016 30% MATT		Outward opening door 10mm clear toughened glass with manifestation (to be agreed), stainless steel handle.		6mm clear laminated glass fanlight.	
sunparadise		Sunparadise Systems Limited 12 Newmarket Business Centre 341 Exning Road, Newmarket, SUFFOLK CB8 0AT Phone: 0870 067 88 www.sunparadise.com		Design:	Dec'20	Init.:	JCB	Unit:	Scale: 1:2	Rev.	Description	Date	Init.:	Business Opp: St Patricks	
Checked:		Order name:		St Patricks Garden		Gravesend		KENT		A	Element ref added	18/01/21	GRO	Project ID: 1006-01	
		Subject:		Cill detail, Ground_4		Element 712				B	System description & colour added	01/02/21	GRO	Drawing No.: 31-24	
										C					
										D					

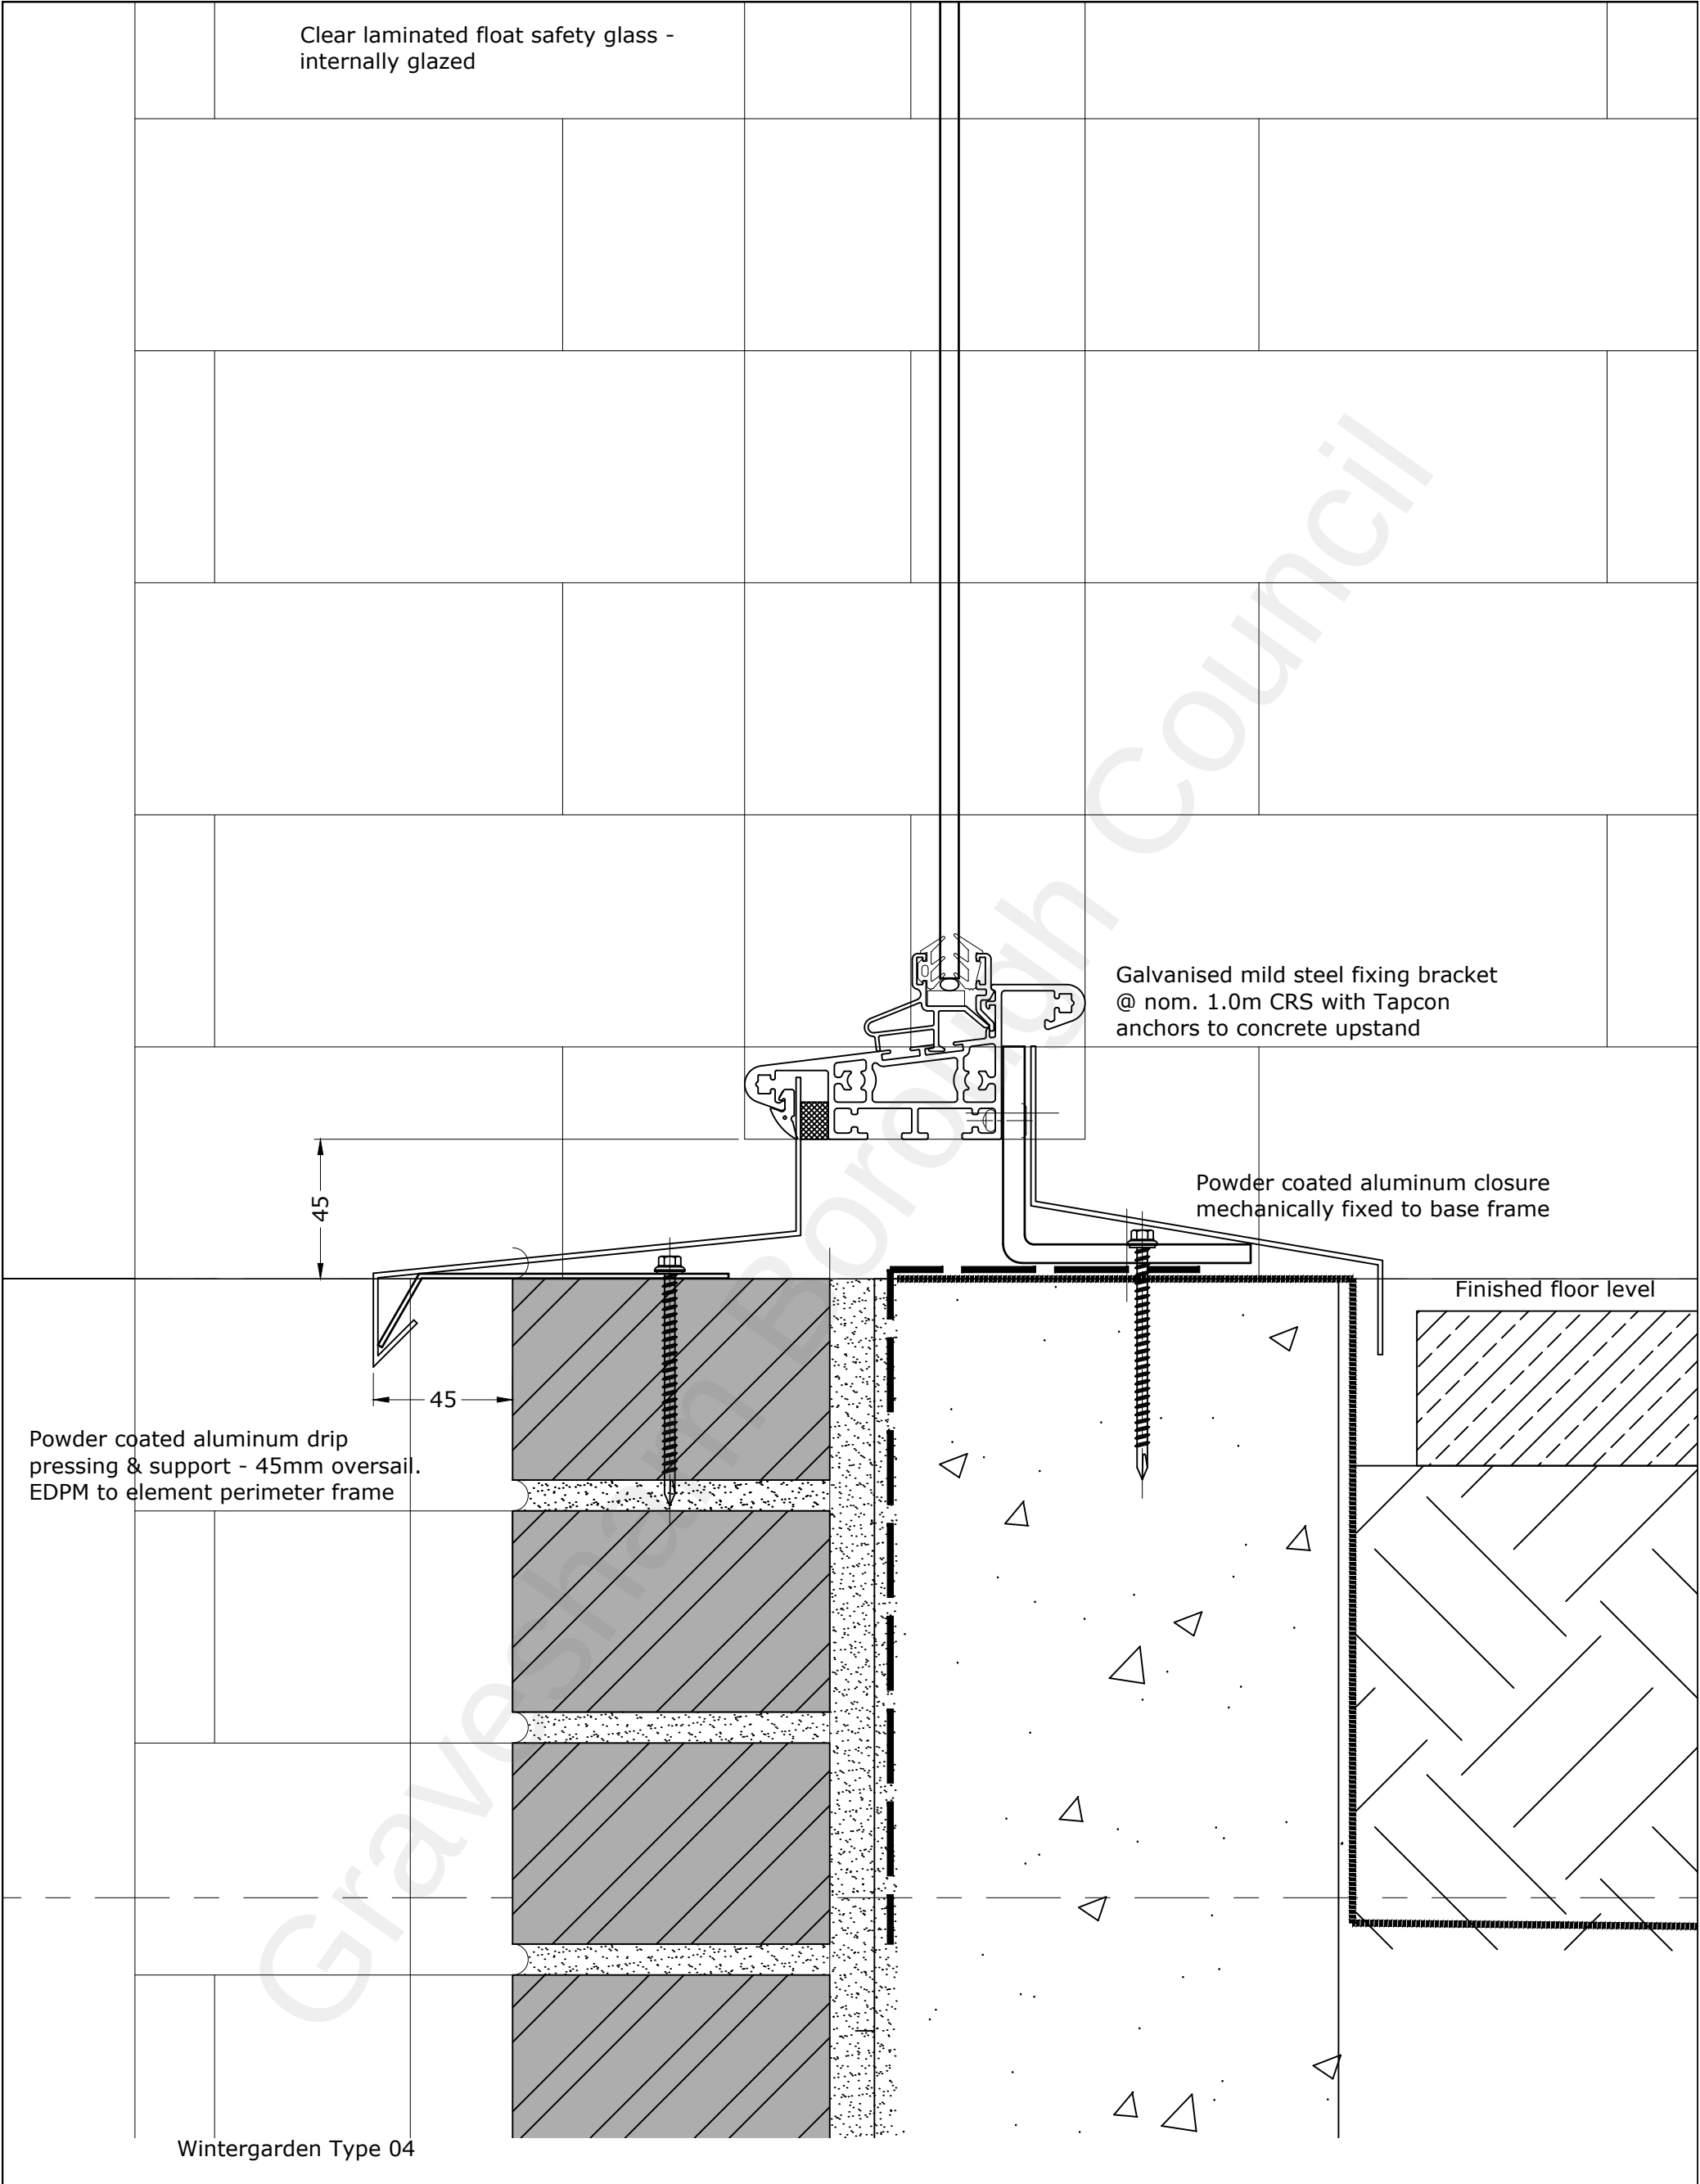

AS BUILT		Sunparadise system WD100 Light		Design: Jan'21		Init.: GR	Unit: Scale: 1:2	Rev.	Description	Date	Init.:
Aluminium powder coated frame - RAL 7016 30% MATT Balustrade section with 6.8mm clear laminated safety glass. 8mm clear toughened frameless sliding folding opening glass, opening inwards through 90°. 1.5mm ppc aluminium pressings to the perimeter inside and out, RAL 7016 30% MATT Outward opening door 10mm clear toughened glass with manifestation (to be agreed), stainless steel handle. 6mm clear laminated glass fanlight.		sunparadise Sunparadise Systems Limited 12 Newmarket Business Centre 341 Exning Road, Newmarket, SUFFOLK CB8 0AT Phone: 0870 067 88 www.sunparadise.com		Checked:		Order name: St Patricks Garden Gravesend KENT		A	Element ref added	18/01/21	GRO
				Subject: Cill detail, Ground_1 Element 714		B		B	System description & colour added	01/02/21	GRO
						C		C			
						D		D			
						Business Opp: St Patricks Project ID: 1006-01 Drawing No.: 31-25					

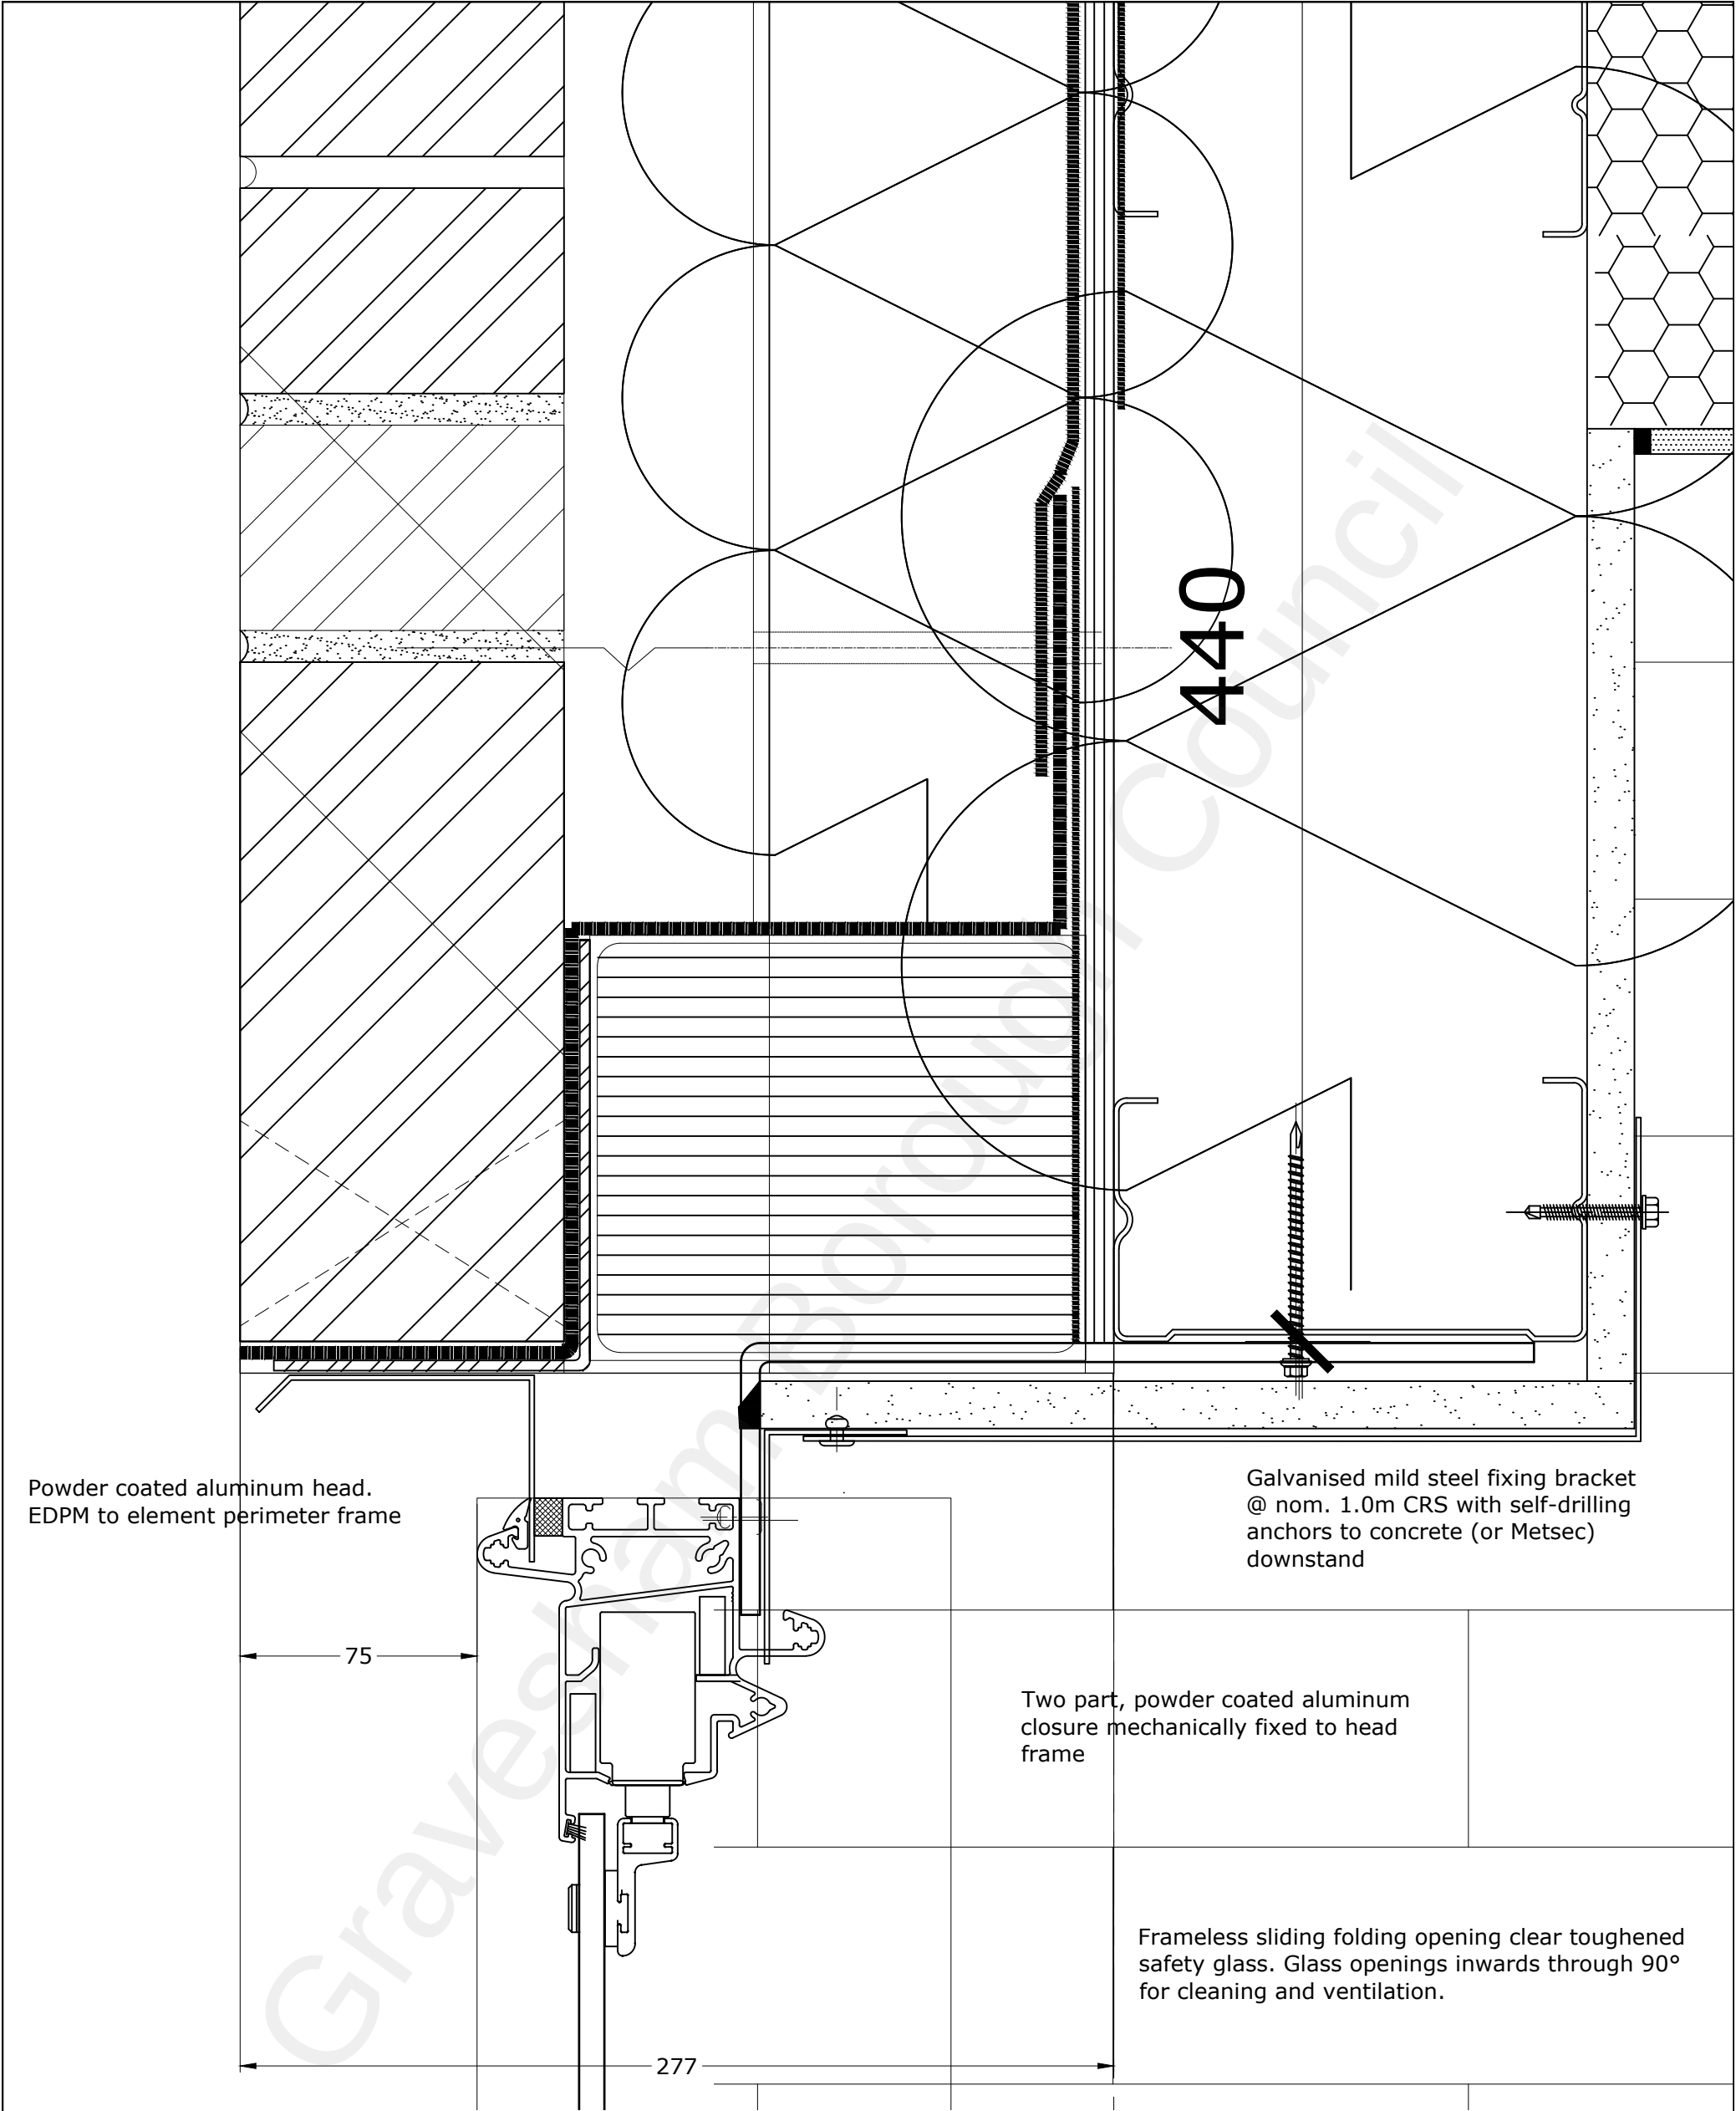

Powder coated aluminum head.
EDPM to element perimeter frame

Galvanised mild steel fixing bracket
@ nom. 1.0m CRS with self-drilling
anchors to concrete (or Metsec)
downstand

Two part, powder coated aluminum
closure mechanically fixed to head
frame

Frameless sliding folding opening clear toughened
safety glass. Glass openings inwards through 90°
for cleaning and ventilation.

Wintergarden Type 03


AS BUILT

Sunparadise system WD100 Light
Aluminium powder coated frame - RAL 7016 30% MATT
Balustrade section with 6.8mm clear laminated safety glass.
8mm clear toughened frameless sliding folding opening glass,
opening inwards through 90°.
1.5mm ppc aluminium pressings to the perimeter inside and
out, RAL 7016 30% MATT
Outward opening door 10mm clear toughened glass with
manifestation (to be agreed), stainless steel handle.
6mm clear laminated glass fanlight.

sunparadise

Sunparadise Systems Limited
12 Newmarket Business Centre
341 Exning Road, Newmarket,
SUFFOLK CB8 0AT
Phone: 0870 067 88
www.sunparadise.com

	Date	Init.:	Unit:	Rev.	Description	Date	Init.:
Design:	Dec'20	JCB	Scale: 1:2	A	Downstand changed to SFS	08/01/21	GRO
Checked:				B	Element ref added	18/01/21	GRO
Order name:	St Patricks Garden			C	System description & colour added	02/02/21	GRO
				D			
Subject:	Head detail, Head_1			Business Opp: St Patricks			
				Project ID: 1006-01			
				Drawing No.: 31-31			
	KENT						
	Element 719						

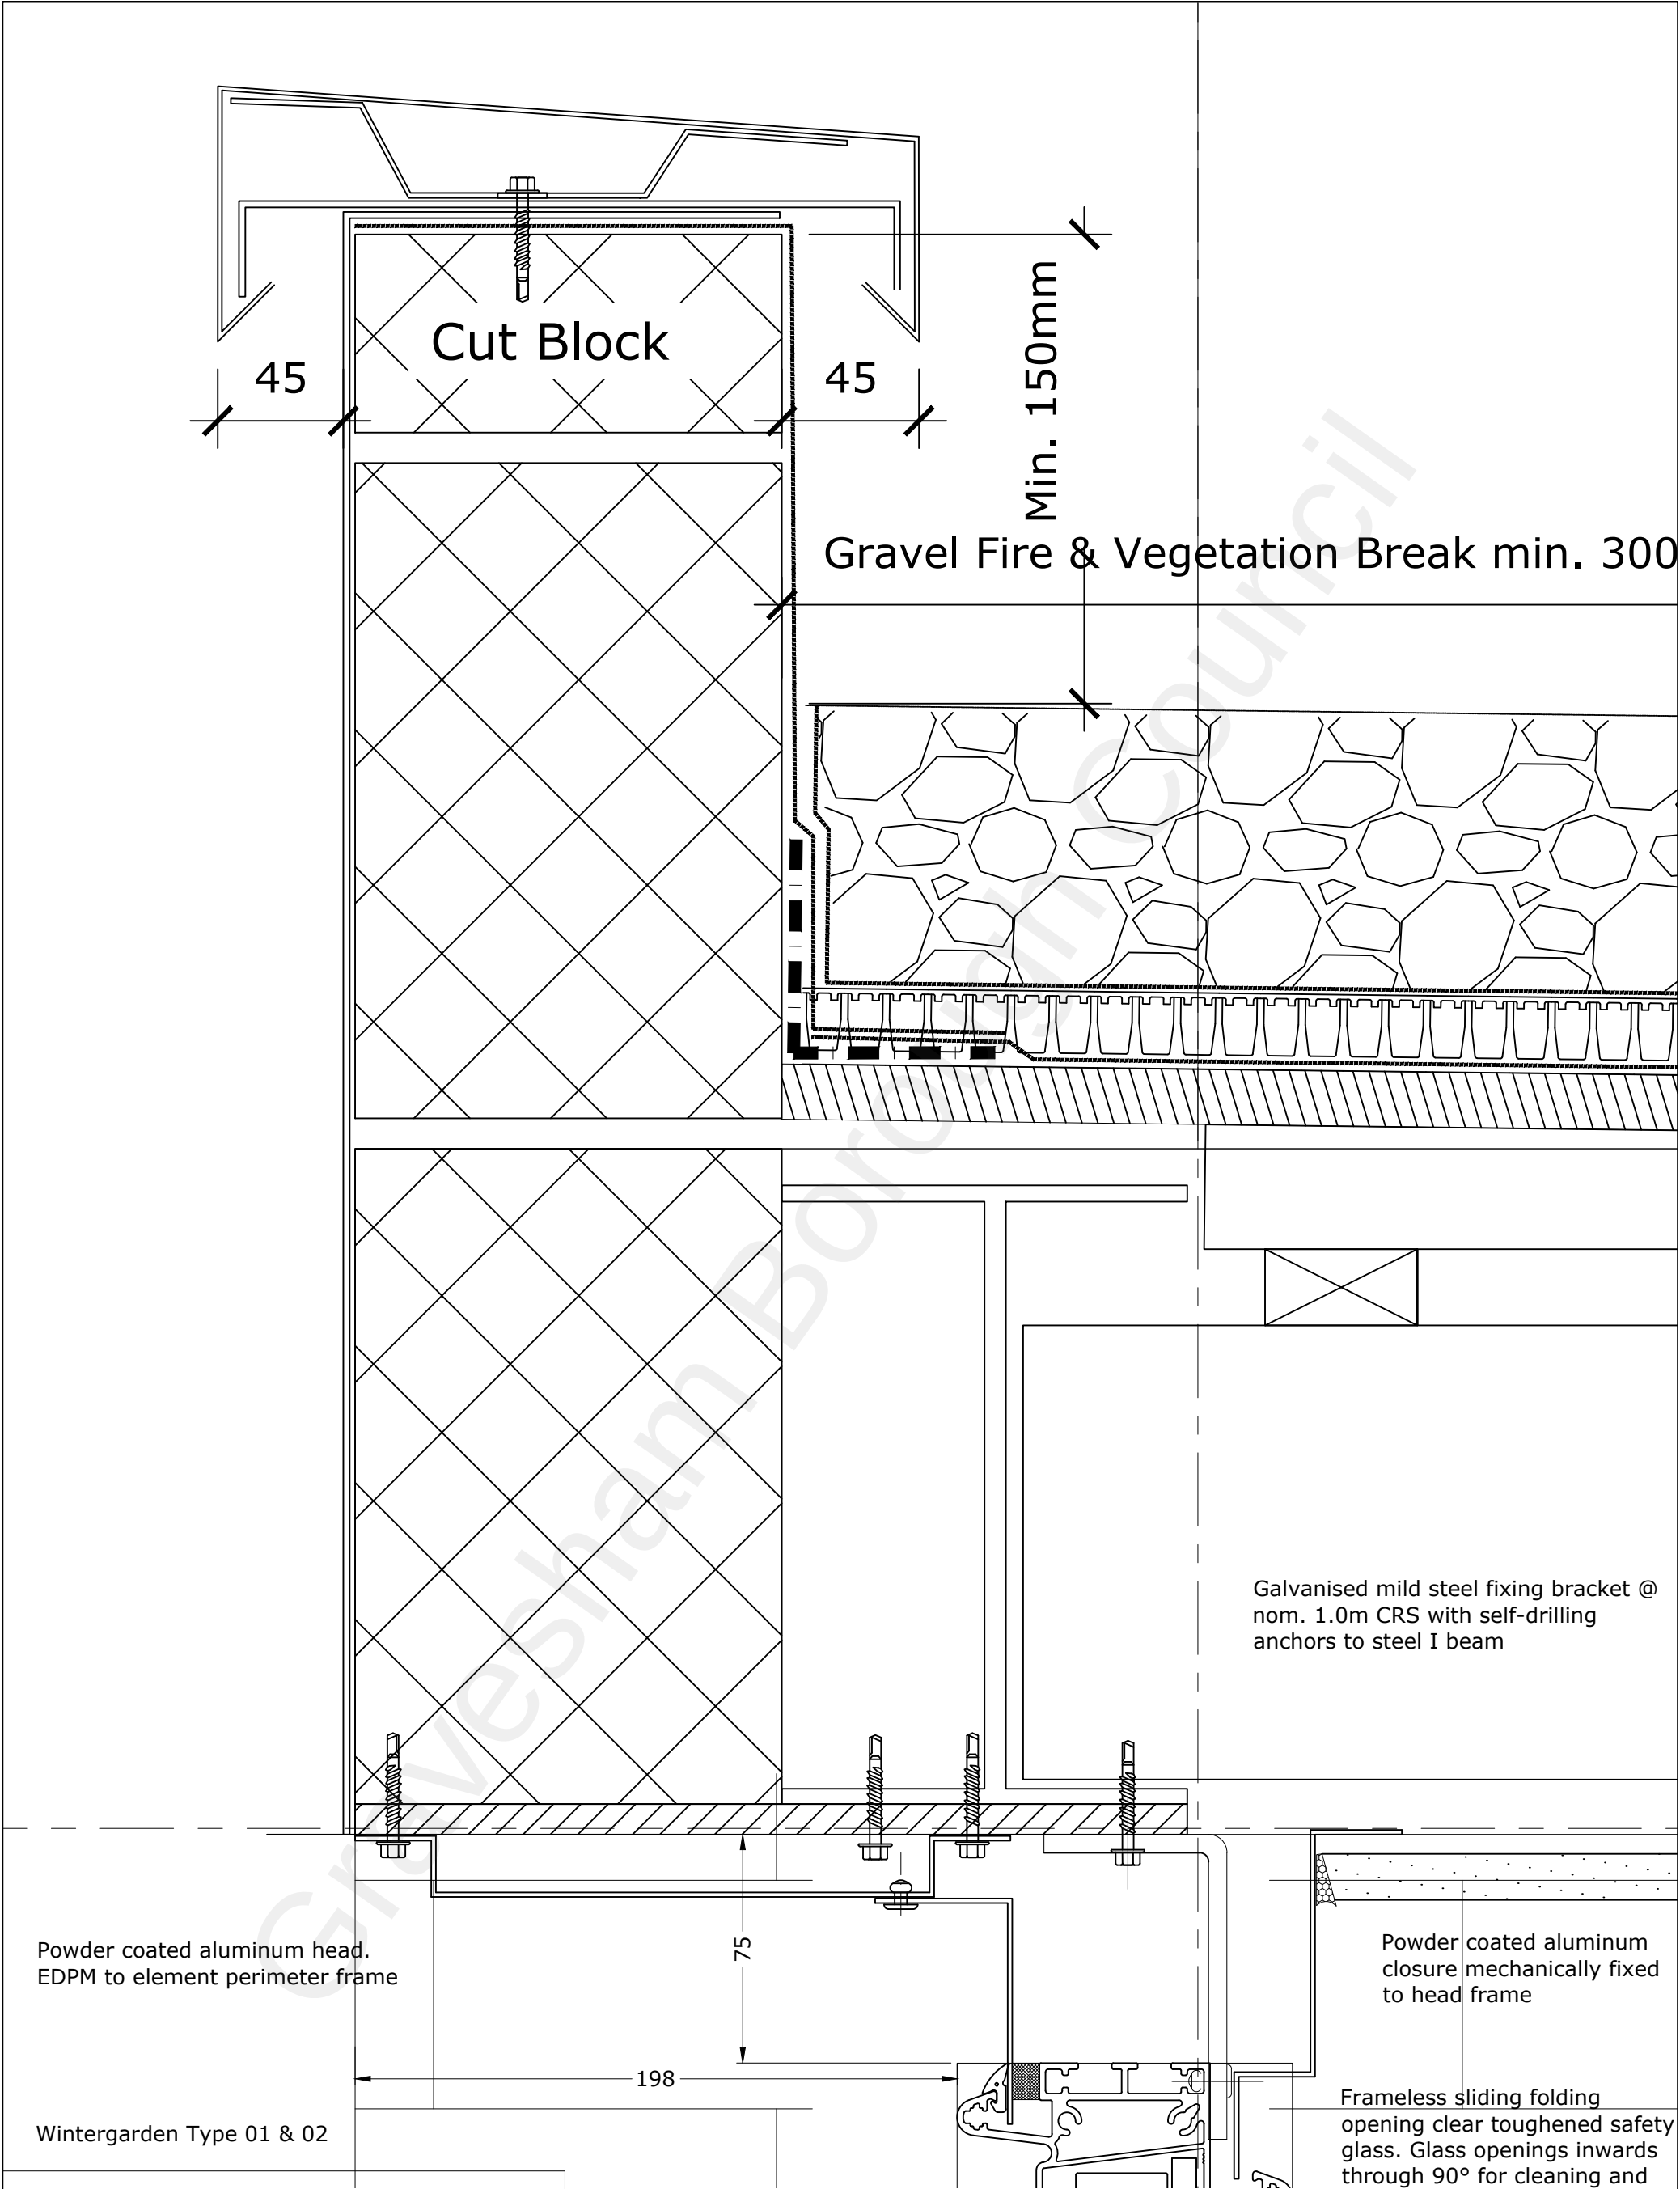


AS BUILT

Sunparadise system WD100 Light
Aluminium powder coated frame - RAL 7016 30% MATT
Balustrade section with 6.8mm clear laminated safety glass.
8mm clear toughened frameless sliding folding opening glass, opening inwards through 90°.
1.5mm ppc aluminium pressings to the perimeter inside and out, RAL 7016 30% MATT
Outward opening door 10mm clear toughened glass with manifestation (to be agreed), stainless steel handle.
6mm clear laminated glass fanlight.

		Date: Dec'20		Init.: JCB	Unit: Scale: 1:2	Rev.	Description	Date	Init.:
Design:		Dec'20		JCB	1:2	A	Elements ref added	18/01/21	GRO
Checked:						B	System description & colour added	02/02/21	GRO
Order name:		St Patricks Garden				C	Elements 705 & 706 removed	12/05/21	GRO
Subject:		Head detail, Head_2				D			
		709 710 717 718				Business Opp: St Patricks			
						Project ID: 1006-01			
						Drawing No.: 31-32			

Sunparadise Systems Limited
12 Newmarket Business Centre
341 Exning Road, Newmarket,
SUFFOLK CB8 0AT
Phone: 0870 067 88
www.sunparadise.com

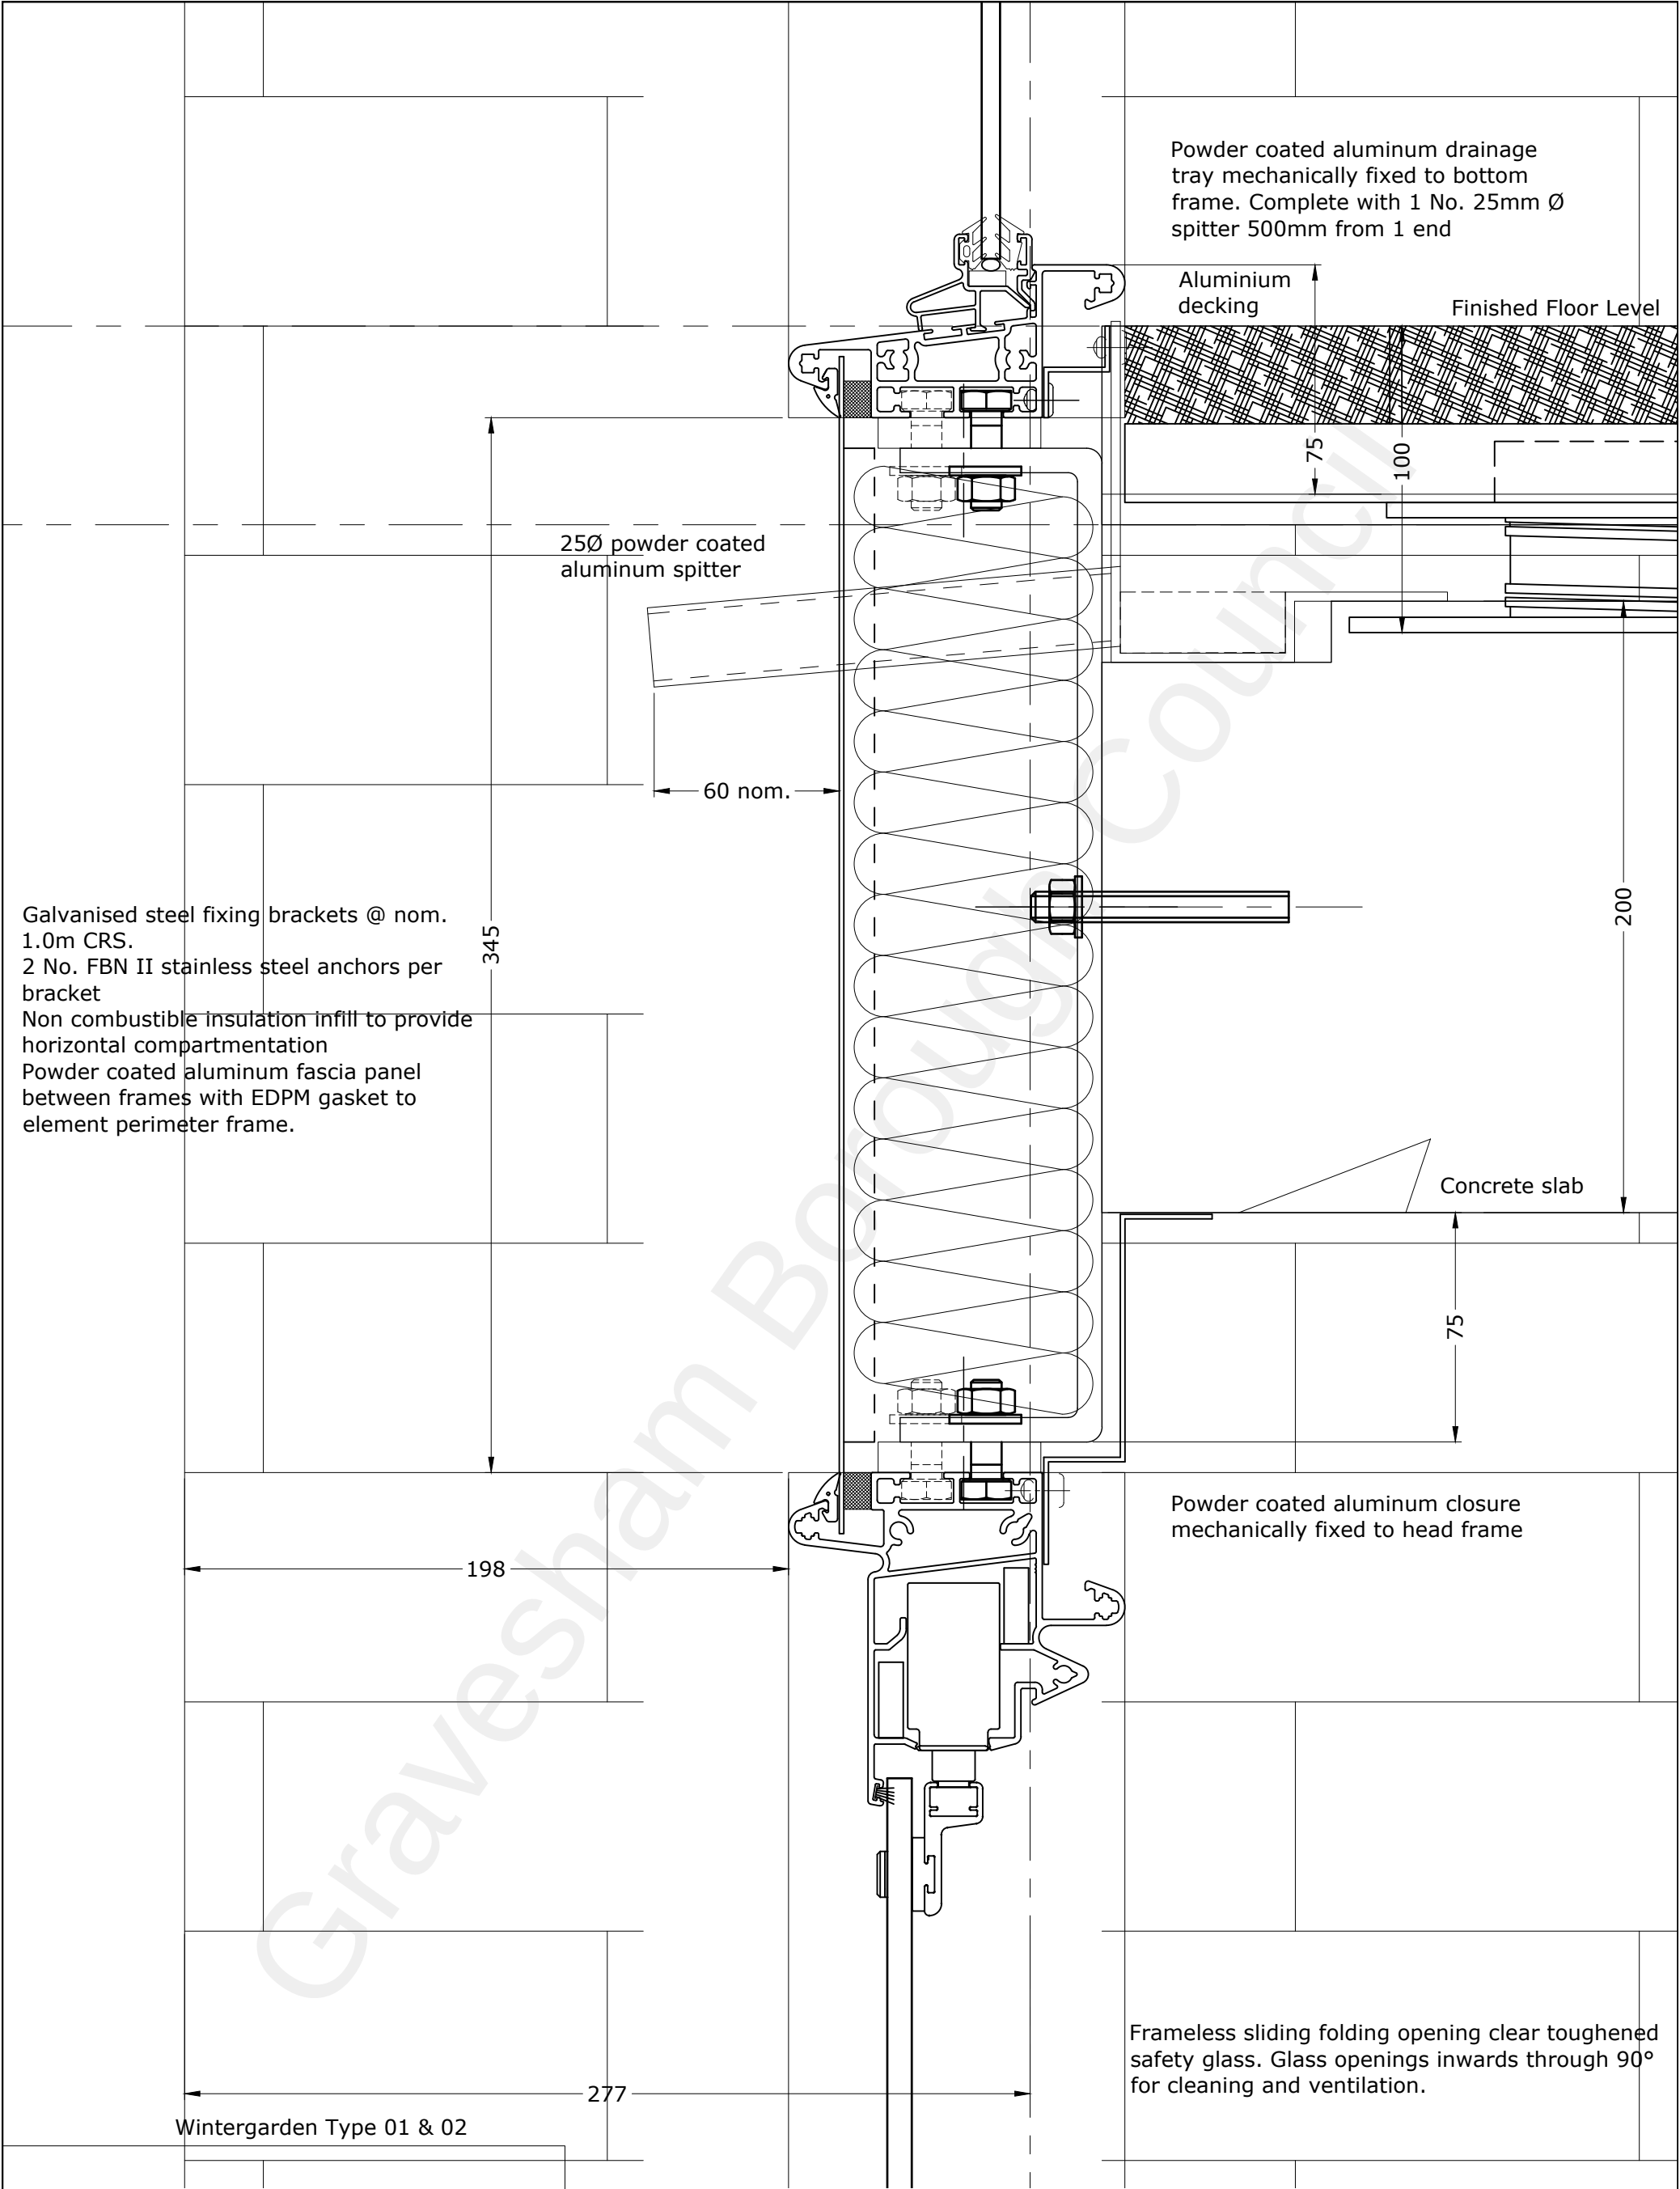

AS BUILT

Sunparadise system WD100 Light
Aluminium powder coated frame - RAL 7016 30% MATT
Balustrade section with 6.8mm clear laminated safety glass.
8mm clear toughened frameless sliding folding opening glass,
opening inwards through 90°.
1.5mm ppc aluminium pressings to the perimeter inside and
out, RAL 7016 30% MATT
Outward opening door 10mm clear toughened glass with
manifestation (to be agreed), stainless steel handle.
6mm clear laminated glass fanlight.


sunparadise

Sunparadise Systems Limited
12 Newmarket Business Centre
341 Exning Road, Newmarket,
SUFFOLK CB8 0AT
Phone: 0870 067 88
www.sunparadise.com


Rev.	Description	Date	Init.:
A	Aluminium decking shown	18/01/21	GRO
B	System description & colour added	02/02/21	GRO
C			
D			

Design:	Date:	Init.:	Unit:
Checked:	Dec'20	JCB	Scale: 1:2
Order name:	St Patricks Garden Gravesend KENT		
Subject:	Intermediate detail Cill/Head_1		

Business Opp:	St Patricks
Project ID:	1006-01
Drawing No.:	31-35

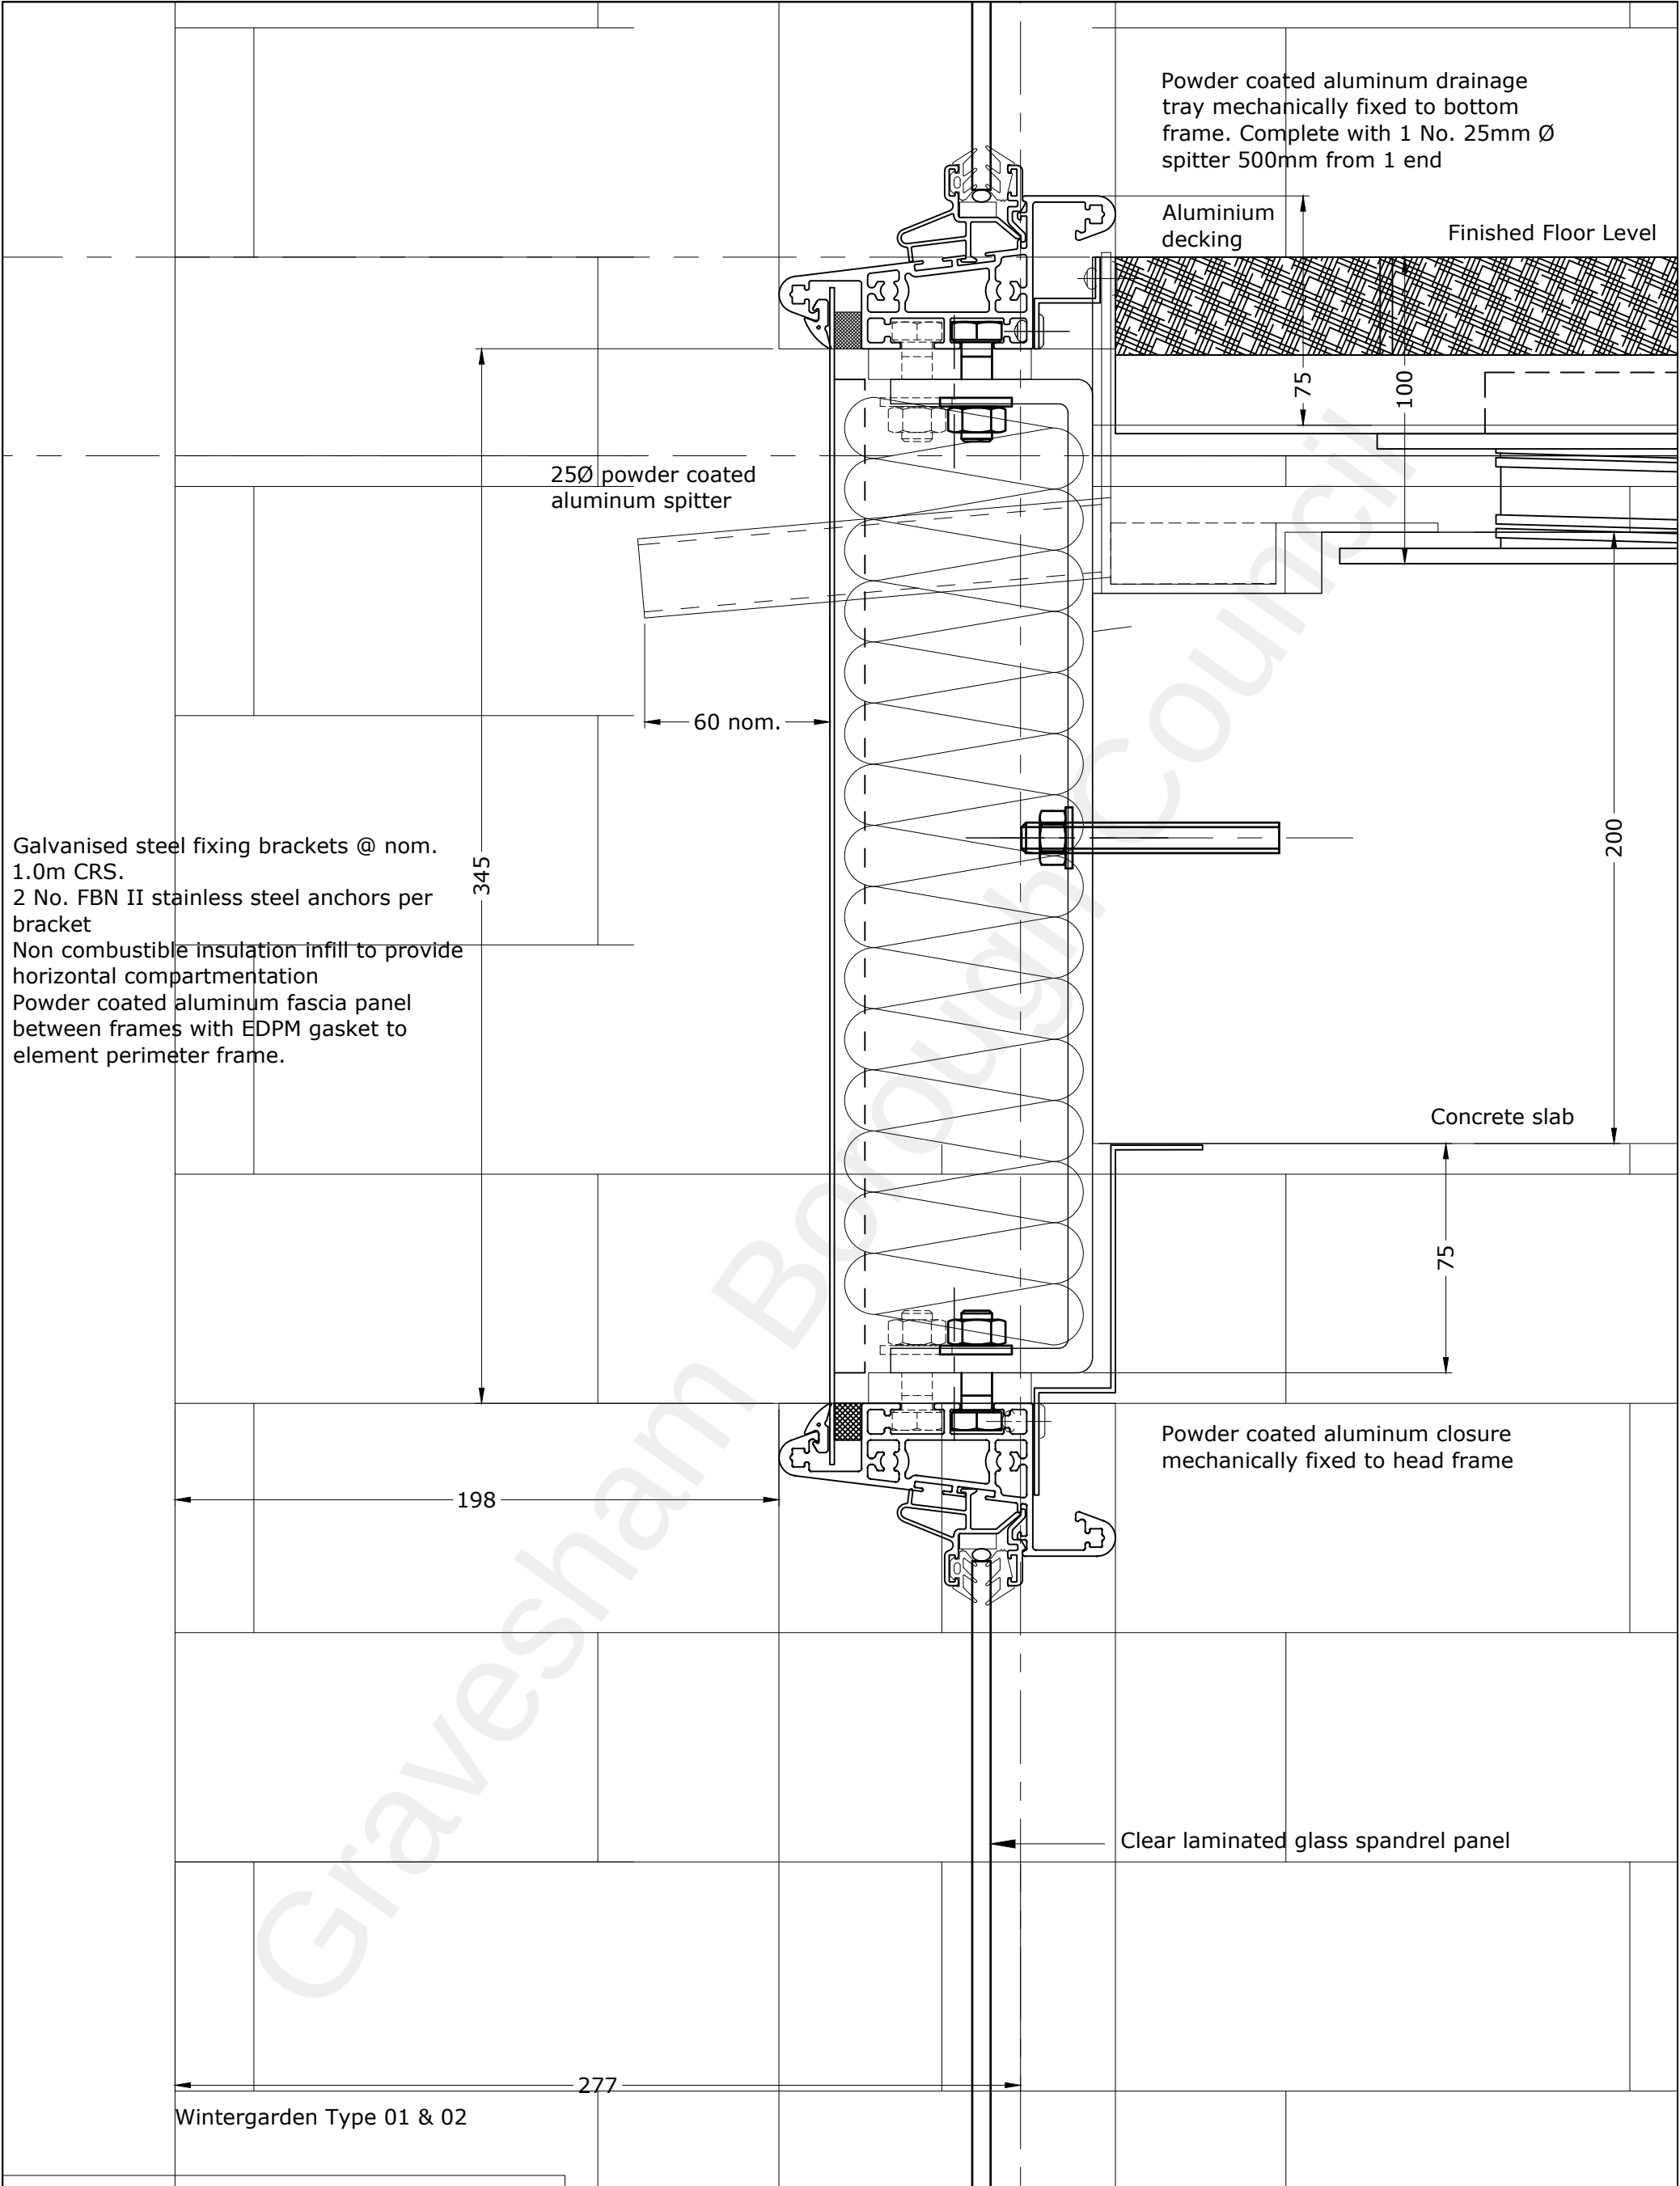

AS BUILT		sunparadise		Date: Dec'20 Init.: JCB Unit: Scale: 1:2		Rev. Description Date Init.: A Louvre panel changed to spandrel 08/01/21 GRO B Aluminium decking & FFL indicated 18/01/21 GRO C System description & colour added 02/02/21 GRO D	
Sunparadise system WD100 Light Aluminium powder coated frame - RAL 7016 30% MATT Balustrade section with 6.8mm clear laminated safety glass. 8mm clear toughened frameless sliding folding opening glass, opening inwards through 90°. 1.5mm ppc aluminium pressings to the perimeter inside and out, RAL 7016 30% MATT Outward opening door 10mm clear toughened glass with manifestation (to be agreed), stainless steel handle. 6mm clear laminated glass fanlight.		Sunparadise Systems Limited 12 Newmarket Business Centre 341 Exning Road, Newmarket, SUFFOLK CB8 0AT Phone: 0870 067 88 www.sunparadise.com		Order name: St Patricks Garden Gravesend KENT Subject: Intermediate detail Cill/Head_2		Business Opp: St Patricks Project ID: 1006-01 Drawing No.: 31-36	

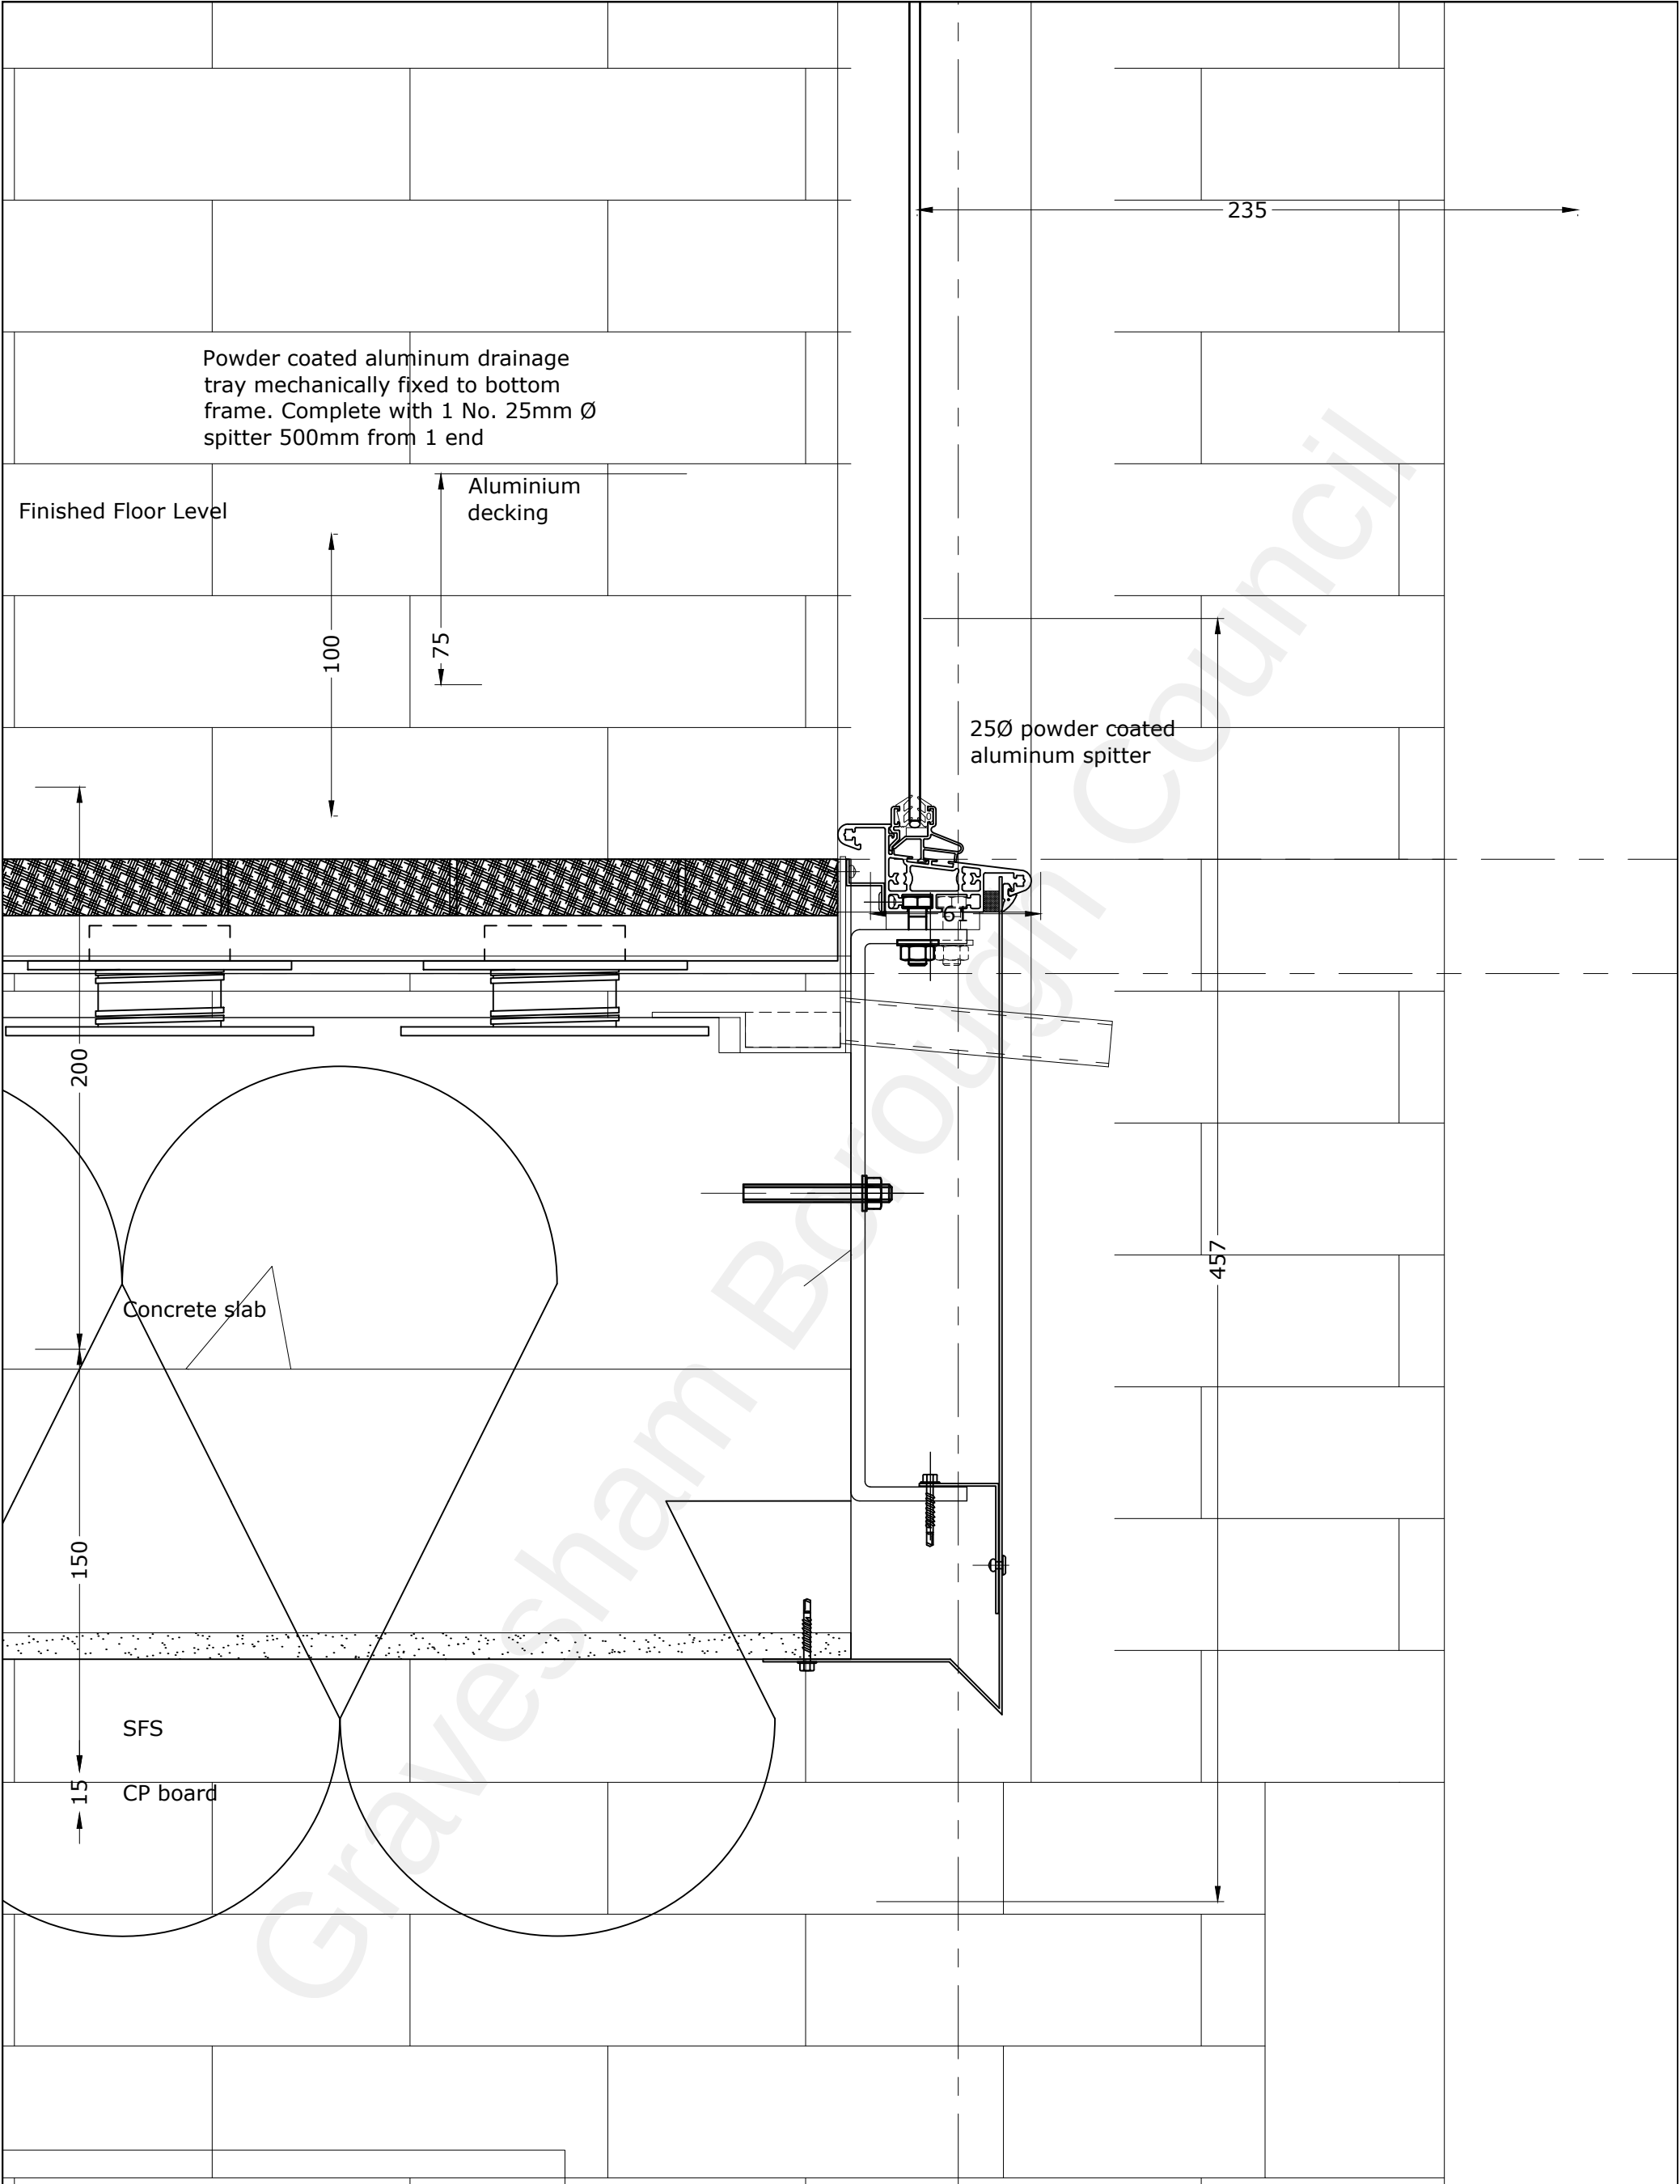


AS BUILT

Sunparadise system WD100 Light
Aluminium powder coated frame - RAL 7016 30% MATT
Balustrade section with 6.8mm clear laminated safety glass.
8mm clear toughened frameless sliding folding opening glass,
opening inwards through 90°.
1.5mm ppc aluminium pressings to the perimeter inside and
out, RAL 7016 30% MATT
Outward opening door 10mm clear toughened glass with
manifestation (to be agreed), stainless steel handle.
6mm clear laminated glass fanlight.

sunparadise

Sunparadise Systems Limited
12 Newmarket Business Centre
341 Exning Road, Newmarket,
SUFFOLK CB8 0AT
Phone: 0870 067 88
www.sunparadise.com

Design:	Date	Init.:	Unit:	Rev.	Description	Date	Init.:
Checked:	Dec'20	JCB	Scale: 1:2	A	Aluminium decking shown	18/01/21	GRO
Order name:	St Patricks Garden			B	System description & colour added	02/02/21	GRO
Subject:	Gravesend			C			
	KENT			D			
	Intermediate detail			Business Opp: St Patricks			
	Cill/Head_3			Project ID: 1006-01			
				Drawing No.: 31-37			

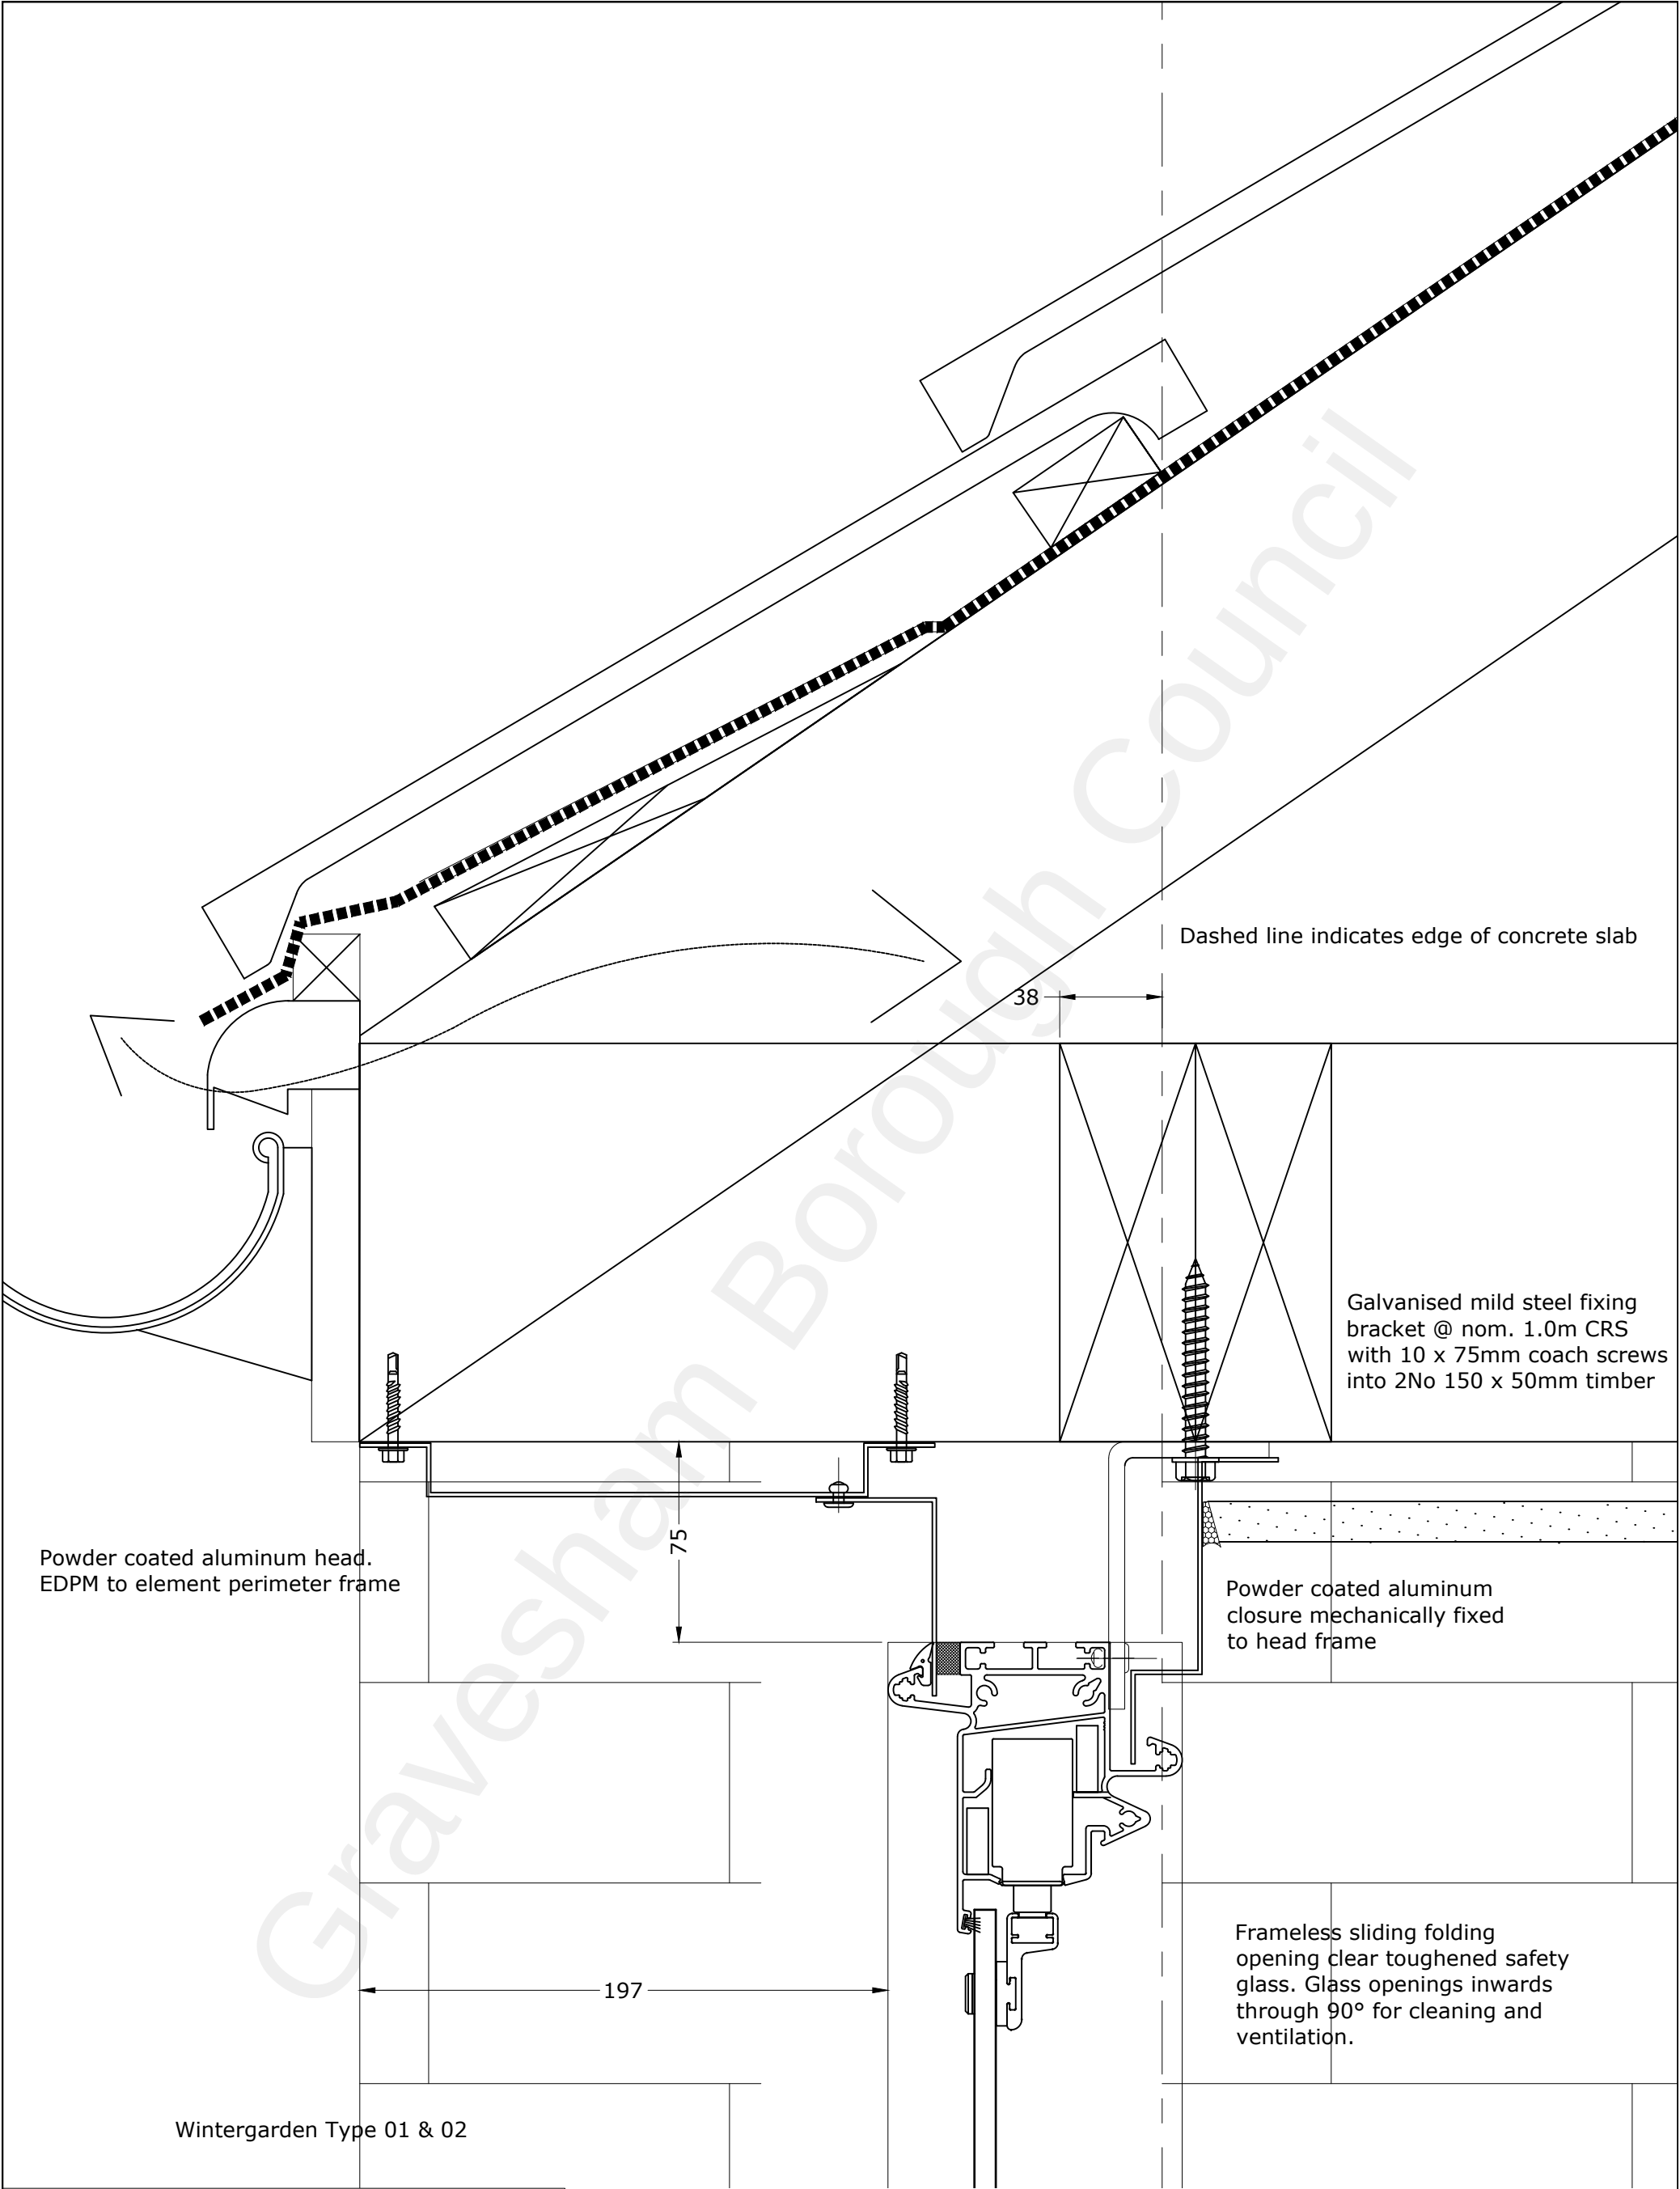

AS BUILT


Sunparadise system WD100 Light

Aluminium powder coated frame - RAL 7016 30% MATT
Balustrade section with 6.8mm clear laminated safety glass.
8mm clear toughened frameless sliding folding opening glass, opening inwards through 90°.
1.5mm ppc aluminium pressings to the perimeter inside and out, RAL 7016 30% MATT
Outward opening door 10mm clear toughened glass with manifestation (to be agreed), stainless steel handle.
6mm clear laminated glass fanlight.

sunparadise

Sunparadise Systems Limited
12 Newmarket Business Centre
341 Exning Road, Newmarket,
SUFFOLK CB8 0AT
Phone: 0870 067 88
www.sunparadise.com

Design:	Date	Init.:	Unit:	Rev.	Description	Date	Init.:
Checked:	May'21	GRO	Scale: 1:2	A	Updated to show pitched roof	11-06-21	GRO
Order name: St Patricks Garden Gravesend KENT Subject: Head detail, Head_3 705 706				B			
				C			
				D			
				Business Opp: St Patricks Project ID: 1006-01 Drawing No.: 31-38			

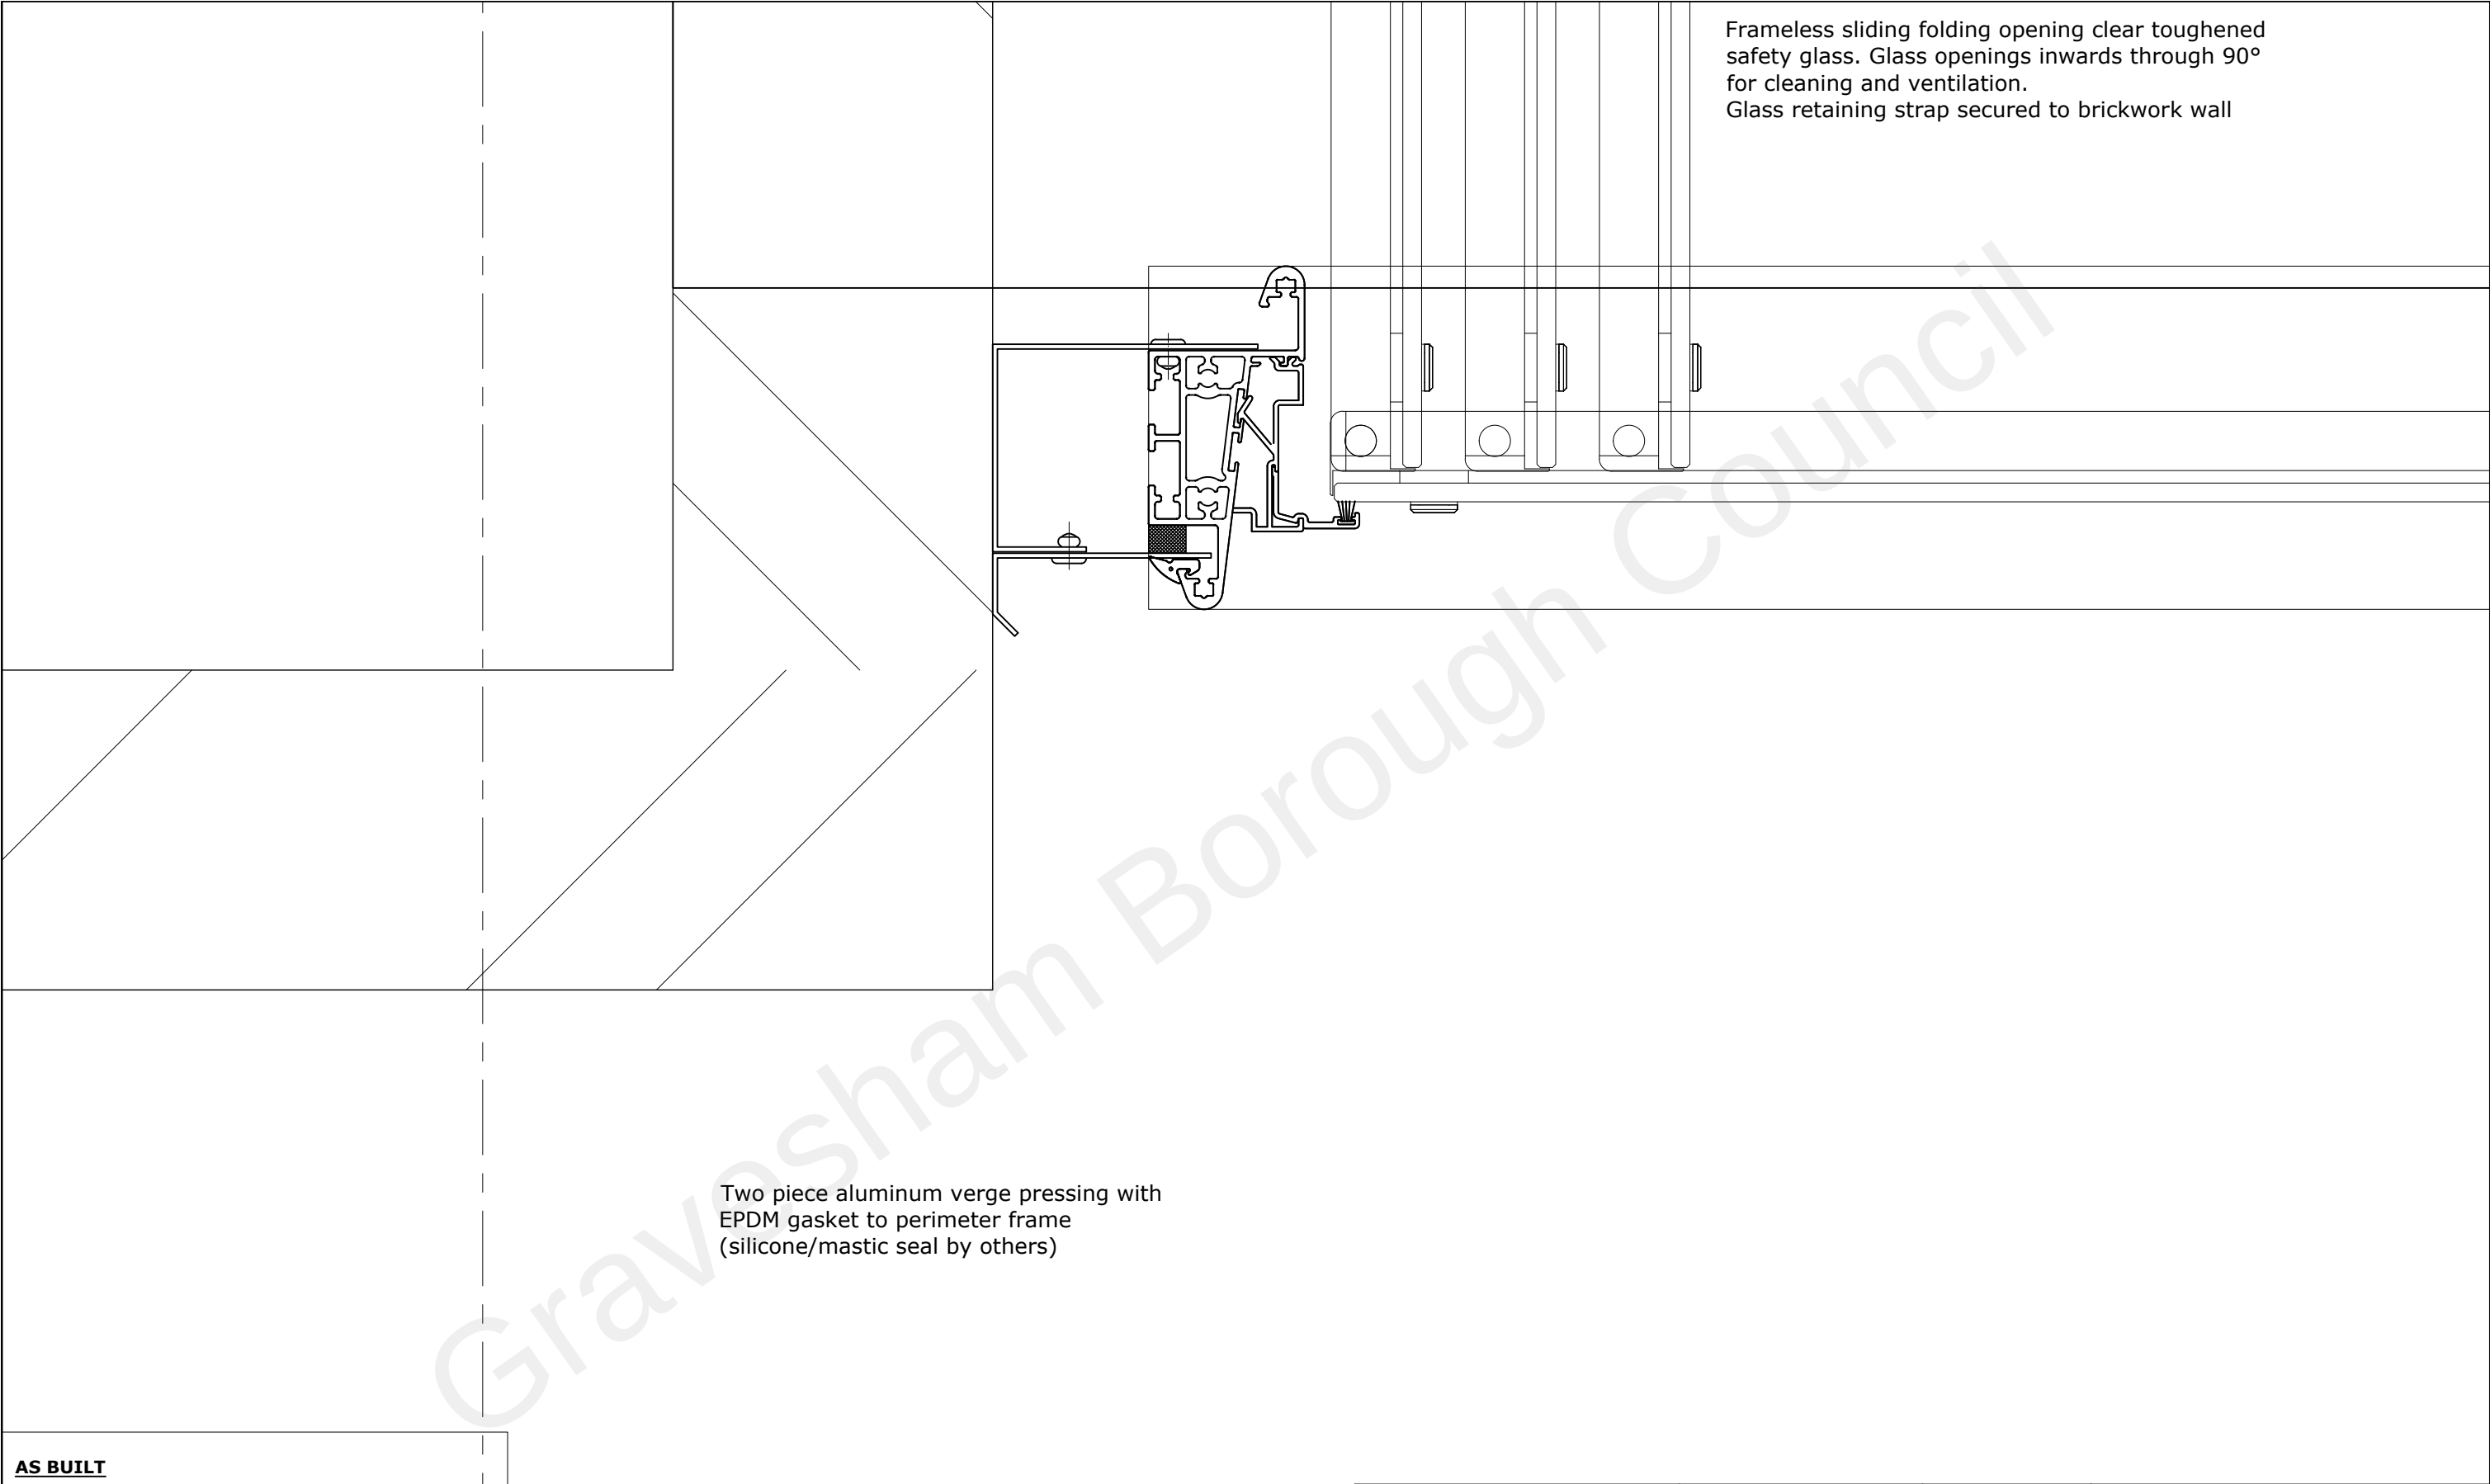

Frameless sliding folding opening clear toughened safety glass. Glass openings inwards through 90° for cleaning and ventilation.
Glass retaining strap secured to brickwork wall

Two piece aluminum verge pressing with EPDM gasket to perimeter frame (silicone/mastic seal by others)

AS BUILT

Sunparadise system WD100 Light

Aluminium powder coated frame - RAL 7016 30% MATT
Balustrade section with 6.8mm clear laminated safety glass
8mm clear toughened frameless sliding folding opening glass
opening inwards through 90°.
1.5mm ppc aluminium pressings to the perimeter inside and out, RAL 7016 30% MATT
Outward opening door 10mm clear toughened glass with manifestation (to be agreed), stainless steel handle.
6mm clear laminated glass fanlight.


sunparadise

Sunparadise Systems Limited
12 Newmarket Business Centre
341 Exning Road, Newmarket,
SUFFOLK CB8 0AT
Phone: 0870 067 88
www.sunparadise.com

	Date	Init.:	Unit: mm	Rev.	Description	Date	Init.:
Design:	Dec'20	JCB	Scale: 1:2	A	System description & colour added	02/02/21	GRO
Checked:				B			
Order name:	St Patricks Garden Gravesend KENT			C			
				D			
Subject:	Verge detail Verge 1			Business Opp: St Patricks			
				Project ID: 1006-01			
				Drawing No.: 31-71			

Frameless sliding folding opening clear toughened safety glass. Glass openings inwards through 90° for cleaning and ventilation.

EPDM gasket
between frames

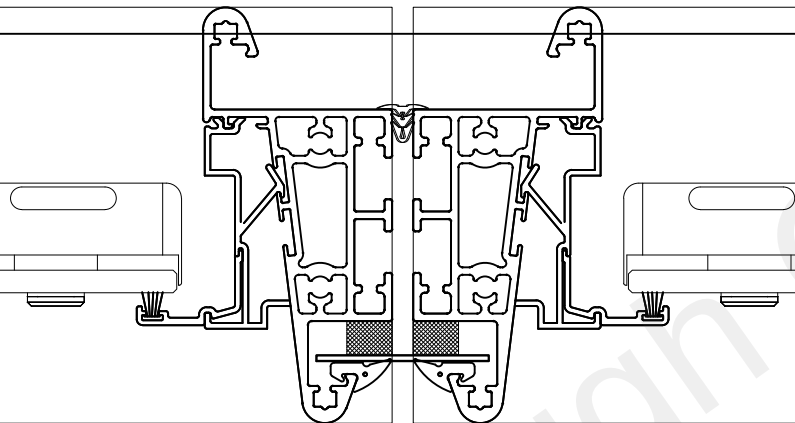


Aluminum pressing installed between aluminum frames. EPDM gasket to perimeter frame

AS BUILT

Sunparadise system WD100 Light
Aluminium powder coated frame - RAL 7016 30% MATT
Balustrade section with 6.8mm clear laminated safety glass.
8mm clear toughened frameless sliding folding opening glass, opening inwards through 90°.
1.5mm ppc aluminium pressings to the perimeter inside and out, RAL 7016 30% MATT
Outward opening door 10mm clear toughened glass with manifestation (to be agreed), stainless steel handle.
6mm clear laminated glass fanlight.

 Sunparadise Systems Limited 12 Newmarket Business Centre 341 Exning Road, Newmarket, SUFFOLK CB8 0AT Phone: 0870 067 88 www.sunparadise.com		Date	Init.:	Unit:	mm	Rev.	Description	Date	Init.:
	Design:	Dec'20	JCB	Scale:	1:2	A	System description & colour added	02/02/21	GRO
	Checked:					B			
	Order name:	St Patricks Garden Gravesend KENT				C			
						D			
Subject:	Central detail Detail 1				Business Opp: St Patricks Project ID: 1006-01 Drawing No.: 31-81				

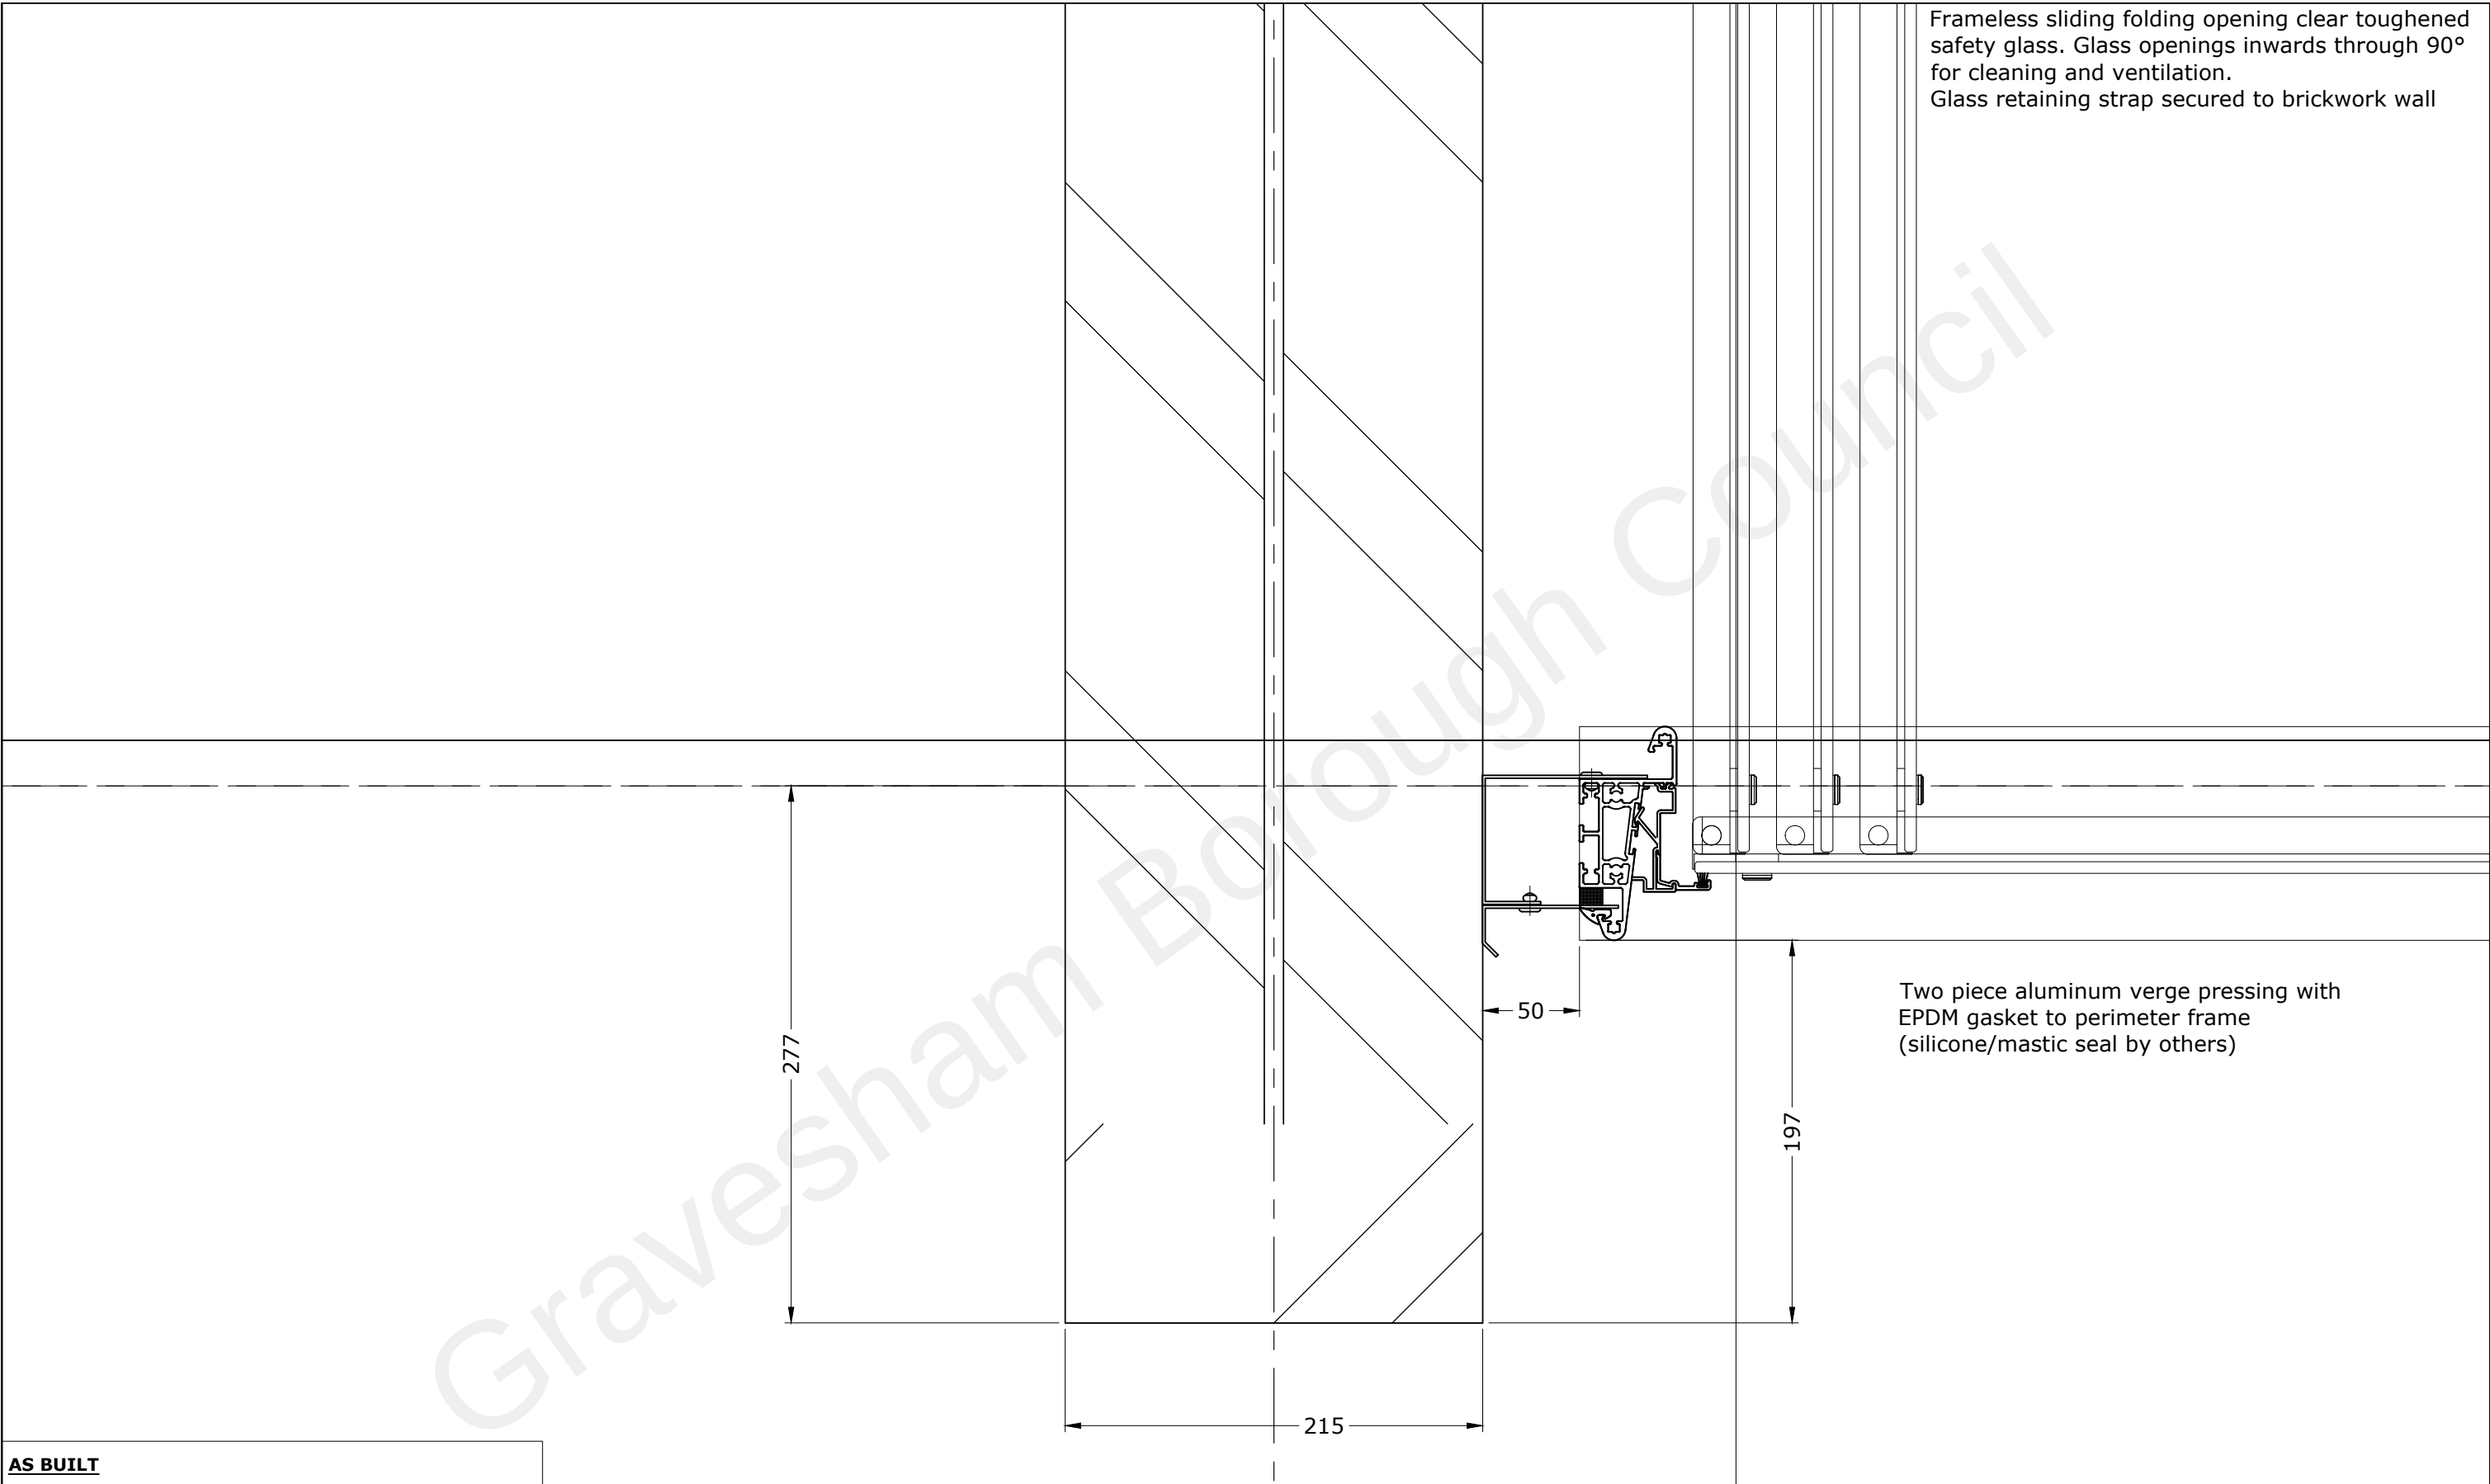

AS BUILT

Sunparadise system WD100 Light
Aluminium powder coated frame - RAL 7016 30% MATT
Balustrade section with 6.8mm clear laminated safety glass.
8mm clear toughened frameless sliding folding opening glass, opening inwards through 90°.
1.5mm ppc aluminium pressings to the perimeter inside and out, RAL 7016 30% MATT
Outward opening door 10mm clear toughened glass with manifestation (to be agreed), stainless steel handle.
6mm clear laminated glass fanlight.

sunparadise

Sunparadise Systems Limited
12 Newmarket Business Centre
341 Exning Road, Newmarket,
SUFFOLK CB8 0AT
Phone: 0870 067 88
www.sunparadise.com


Rev.	Description	Date	Init.:
A	System description & colour added	02/02/21	GRO
B			
C			
D			

Date	Init.:	Unit:	mm
Dec'20	JCB	Scale:	1:2

Design:	Dec'20	Init.:	JCB	Unit:	mm
Checked:					

Order name:	St Patricks Garden Gravesend KENT
Subject:	Central detail Detail 2

Business Opp:	St Patricks
Project ID:	1006-01
Drawing No.:	31-82

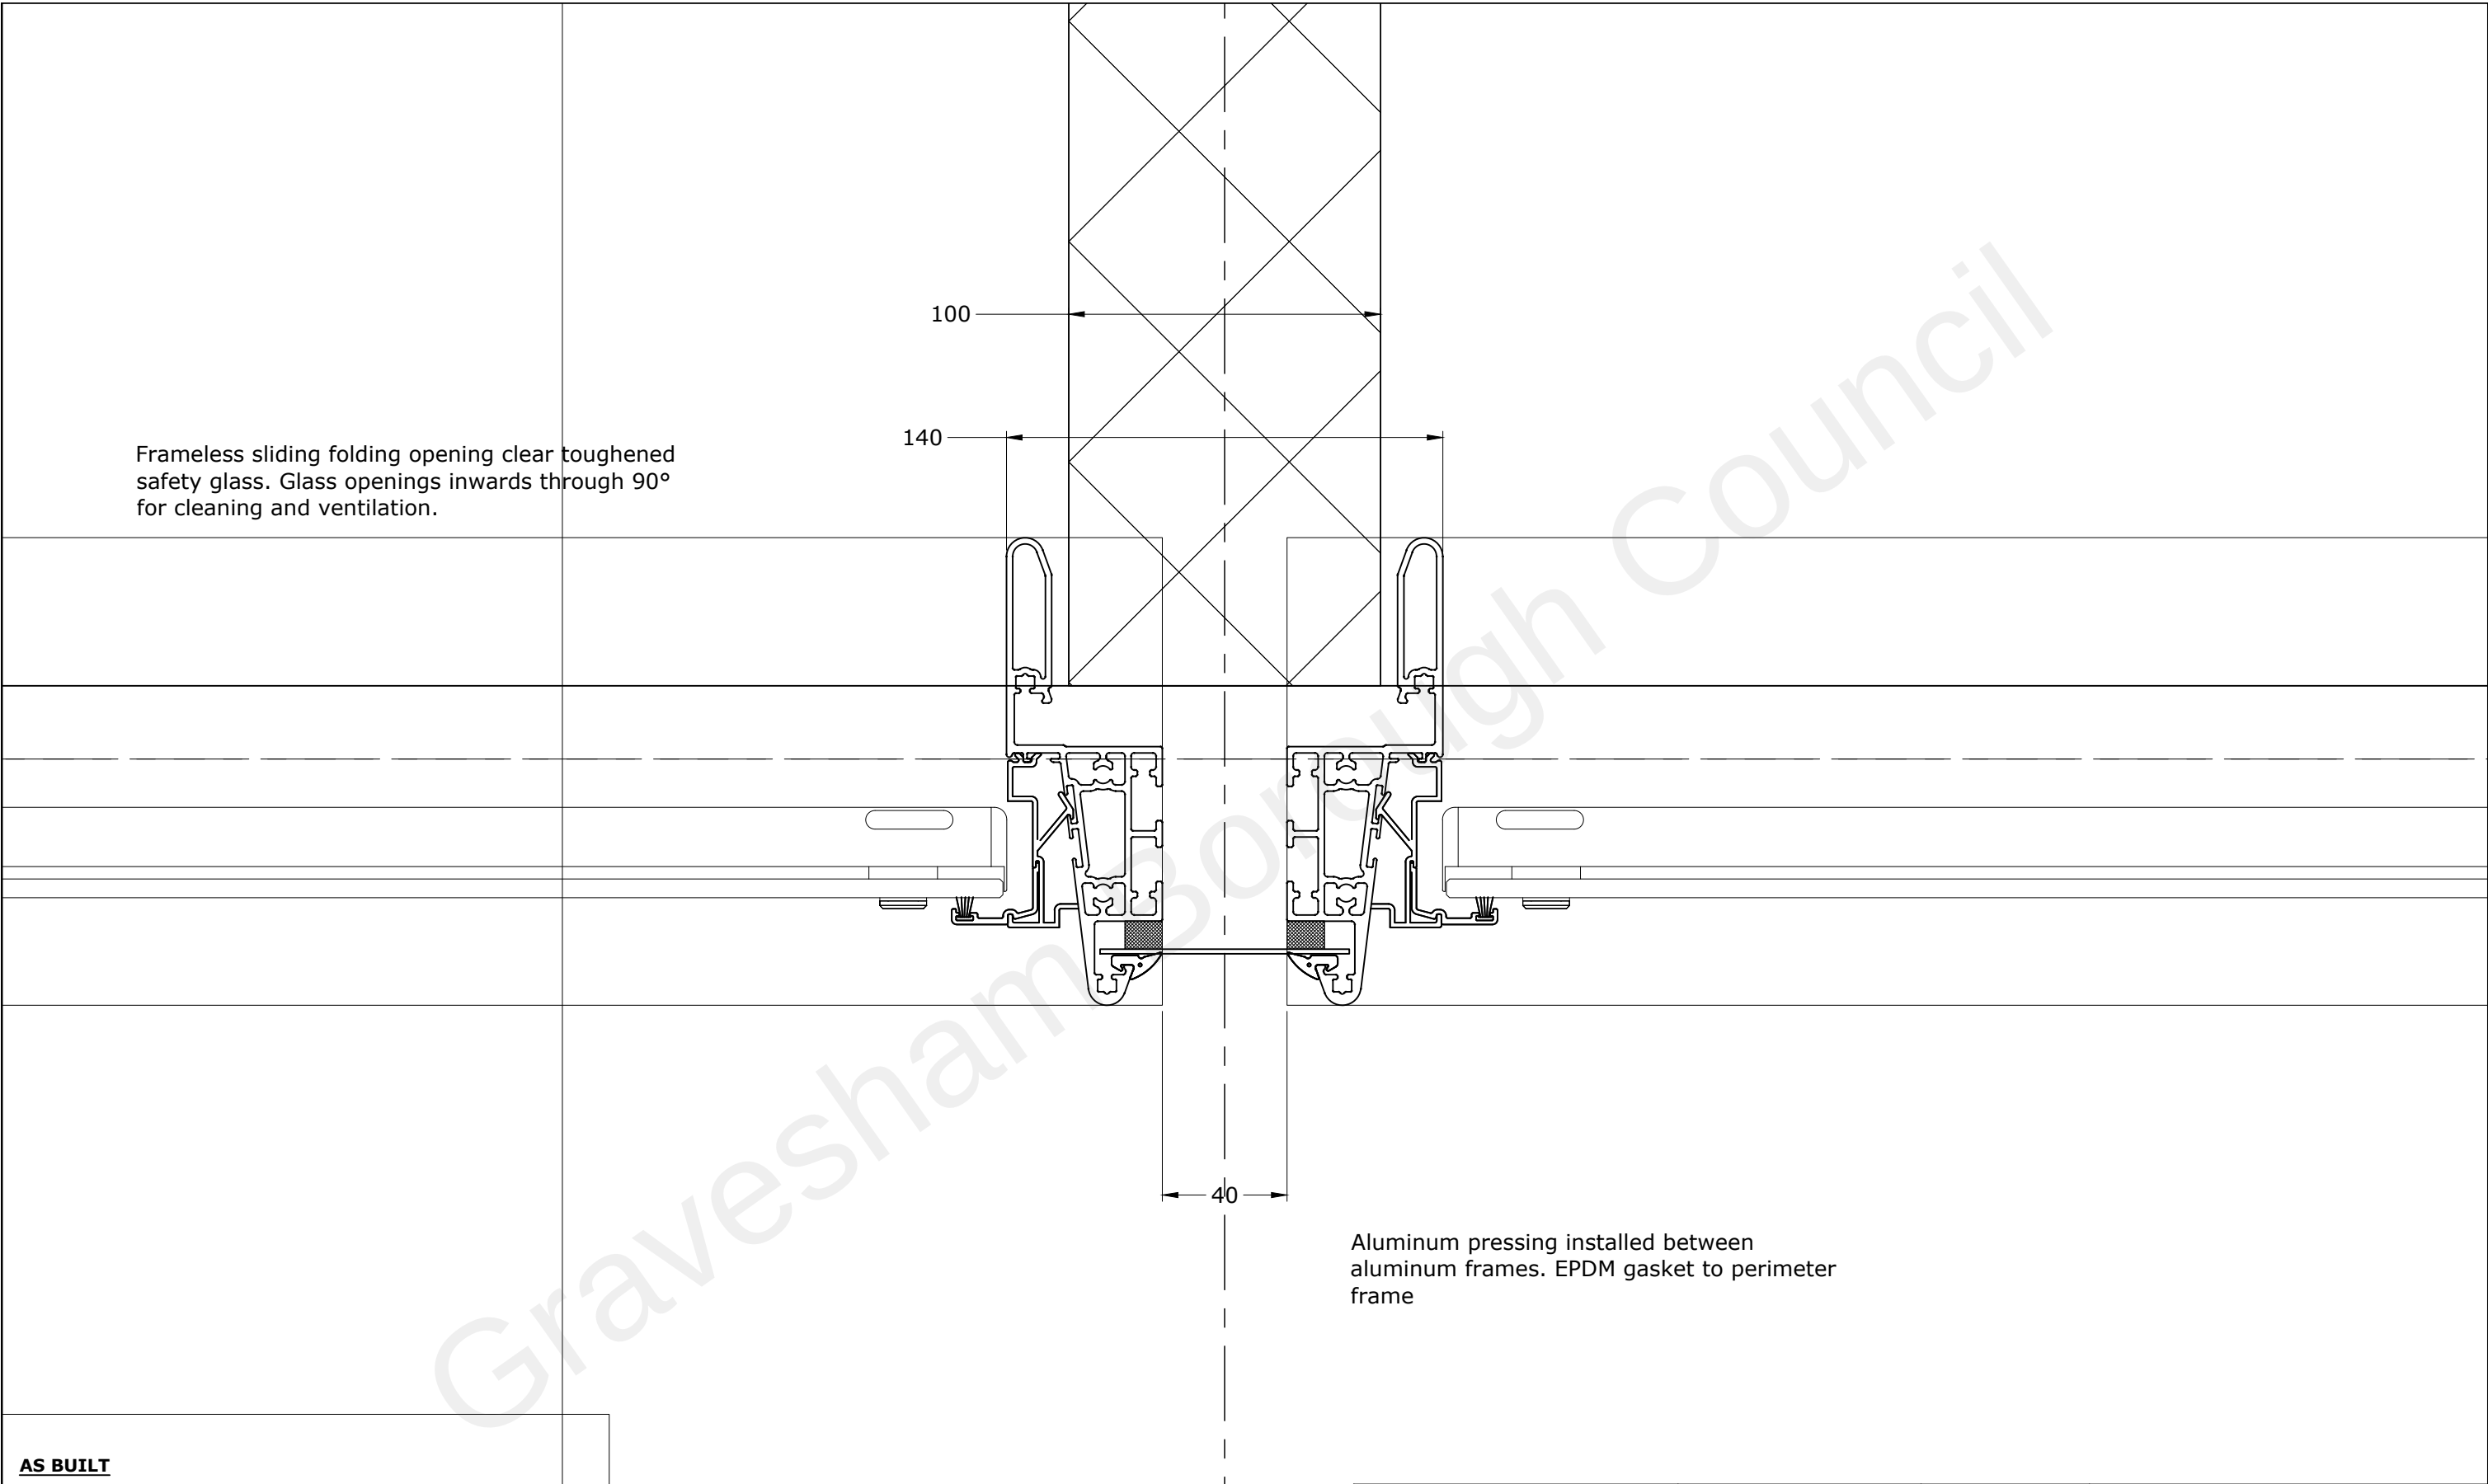

AS BUILT


Sunparadise system WD100 Light
Aluminium powder coated frame - RAL 7016 30% MATT
Balustrade section with 6.8mm clear laminated safety glass.
8mm clear toughened frameless sliding folding opening glass,
opening inwards through 90°.
1.5mm ppc aluminium pressings to the perimeter inside and
out, RAL 7016 30% MATT
Outward opening door 10mm clear toughened glass with
manifestation (to be agreed), stainless steel handle.
6mm clear laminated glass fanlight.

sunparadise

Sunparadise Systems Limited
12 Newmarket Business Centre
341 Exning Road, Newmarket,
SUFFOLK CB8 0AT
Phone: 0870 067 88
www.sunparadise.com

	Date	Init.:	Unit:	mm	Rev.	Description	Date	Init.:
Design:	Dec'20	JCB	Scale:	1:2	A	System description & colour added	02/02/21	GRO
Checked:					B			
Order name:	St Patricks Garden Gravesend KENT				C			
					D			
					Business Opp: St Patricks Project ID: 1006-01 Drawing No.: 31-84			
Subject:	Central detail Detail 4							


ppc surface
* denotes position of hanging hole

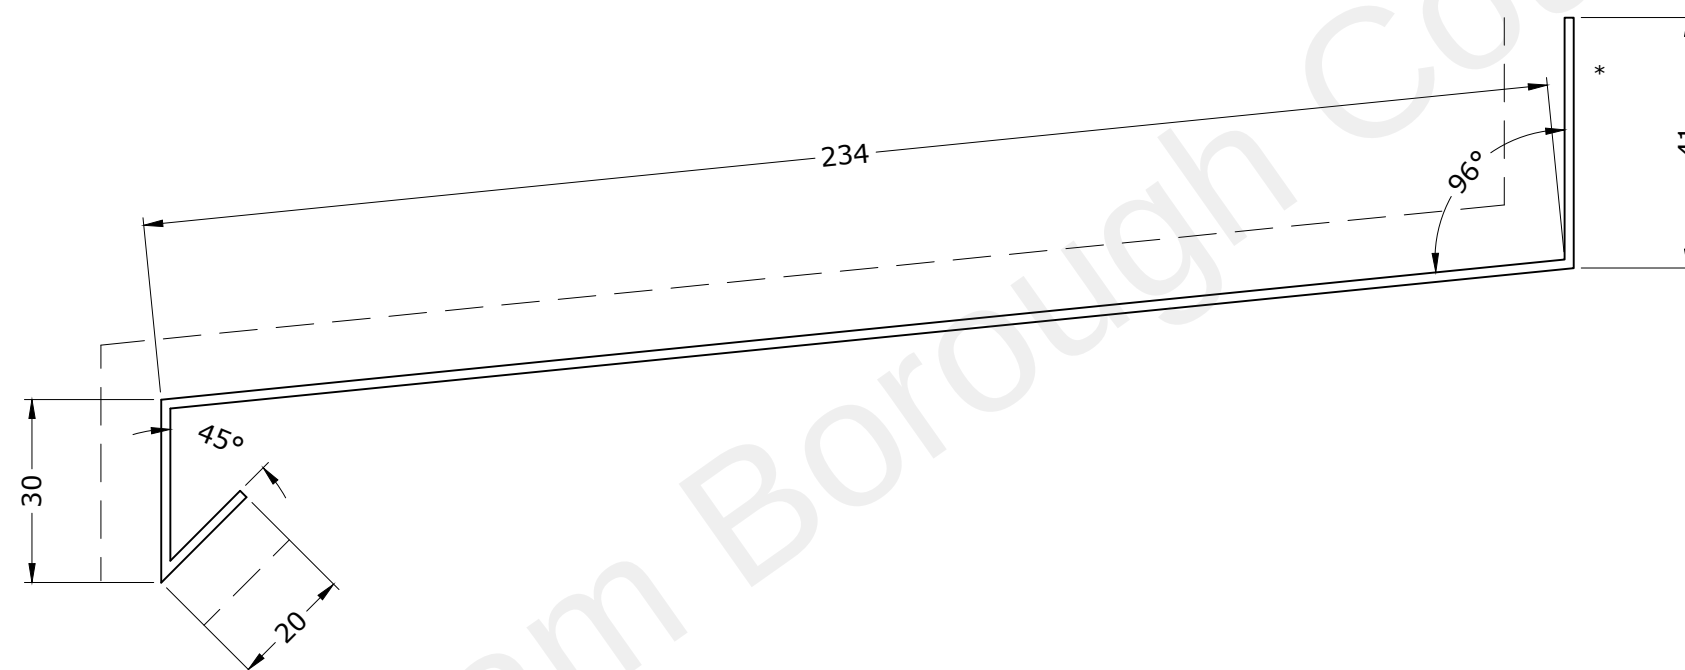

Aluminium powder coated frame - RAL 7016 30% MATT
Balustrade section with 6.8mm clear laminated safety glass.
8mm clear toughened frameless sliding folding opening glass,
opening inwards through 90°.
1.5mm ppc aluminium pressings to the perimeter inside and
out, RAL 7016 30% MATT
Outward opening door 10mm clear toughened glass with
manifestation (to be agreed), stainless steel handle.
6mm clear laminated glass fanlight.

Sunparadise Systems Limited
12 Newmarket Business Centre
341 Exning Road, Newmarket,
SUFFOLK CB8 0AT
Phone: 0870 067 88
www.sunparadise.com

	Date	Init.:	Unit:	mm	Rev.	Description	Date	Init.
Design:	Jan'21	GRO	Scale:		A	System description & colour added	02/02/21	GRO
Checked:					B			
Order name:	St Patricks Garden Gravesend KENT				C			
					D			
					Business Opp: St Patricks			
Subject:	Cill flashing - Outside 701, 702, 714				Project ID: 1006-01			
					Drawing No.: 301			

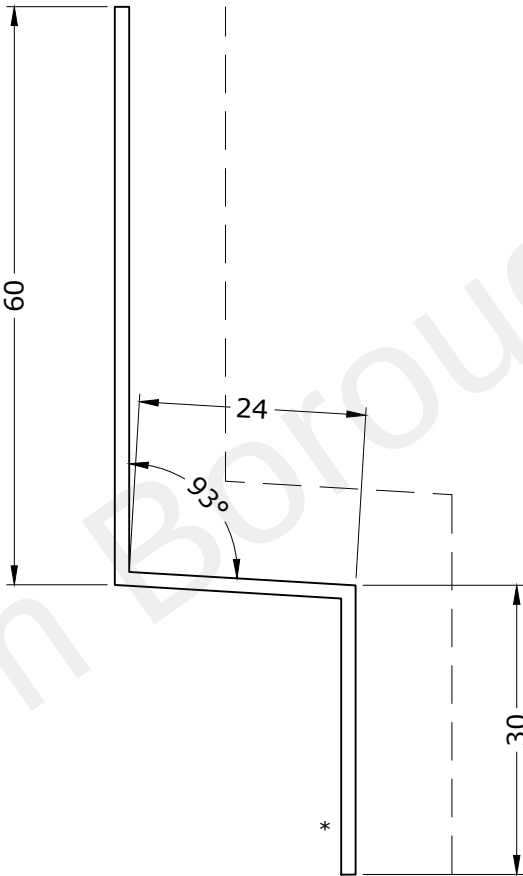


AS BUILT

Sunparadise system WD100 Light
Aluminium powder coated frame - RAL 7016 30% MATT
Balustrade section with 6.8mm clear laminated safety glass.
8mm clear toughened frameless sliding folding opening glass,
opening inwards through 90°.
1.5mm ppc aluminium pressings to the perimeter inside and
out, RAL 7016 30% MATT
Outward opening door 10mm clear toughened glass with
manifestation (to be agreed), stainless steel handle.
6mm clear laminated glass fanlight.

 Sunparadise Systems Limited 12 Newmarket Business Centre 341 Exning Road, Newmarket, SUFFOLK CB8 0AT Phone: 0870 067 88 www.sunparadise.com		Date	Init.:	Unit:	mm	Rev.	Description	Date	Init.:
	Design:	Jan'21	GRO	Scale:		A	System description & colour added	02/02/21	GRO
	Checked:					B			
	Order name:	St Patricks Garden Gravesend KENT				C			
						D			
						Business Opp: St Patricks Project ID: 1006-01 Drawing No.: 302			
Subject:	Cill flashing - Inside 701 & 702								


ppc surface
* denotes position of hanging hole

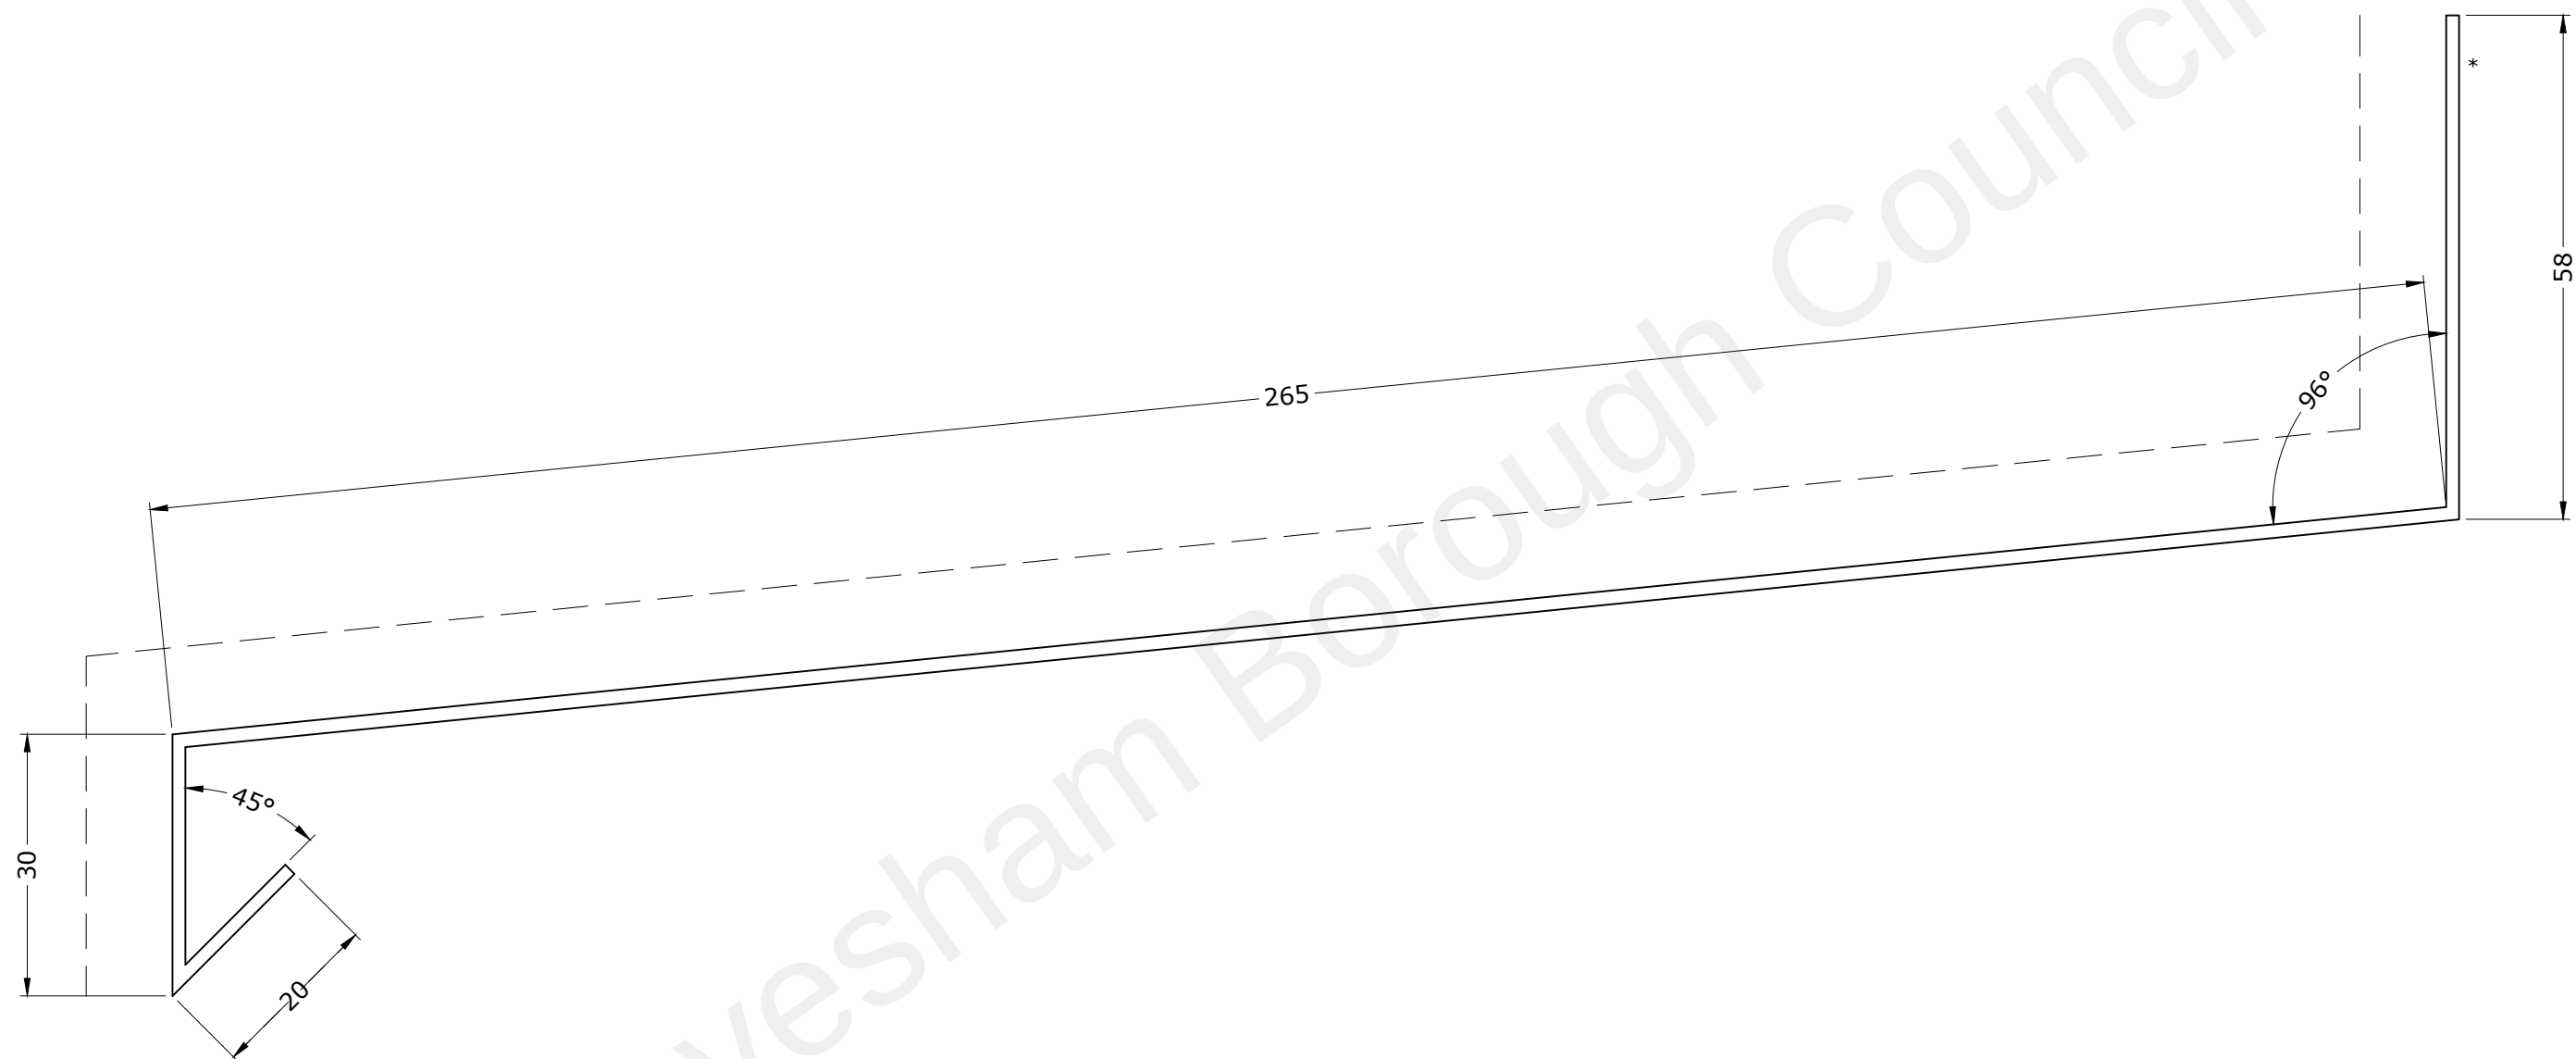

Aluminium powder coated frame - RAL 7016 30% MATT
Balustrade section with 6.8mm clear laminated safety glass.
8mm clear toughened frameless sliding folding opening glass,
opening inwards through 90°.
1.5mm ppc aluminium pressings to the perimeter inside and
out, RAL 7016 30% MATT
Outward opening door 10mm clear toughened glass with
manifestation (to be agreed), stainless steel handle.
6mm clear laminated glass fanlight.

Sunparadise Systems Limited
12 Newmarket Business Centre
341 Exning Road, Newmarket,
SUFFOLK CB8 0AT
Phone: 0870 067 88
www.sunparadise.com


	Date	Init.:	Unit: mm	Rev.	Description	Date	Init
Design:	Jan'21	GRO	Scale:	A	System description & colour added	02/02/21	GR
Checked:				B			
Order name:	St Patricks Garden Gravesend KENT			C			
				D			
				Business Opp: St Patricks Project ID: 1006-01 Drawing No.: 303			
Subject:	Cill flashing - Outside 719						

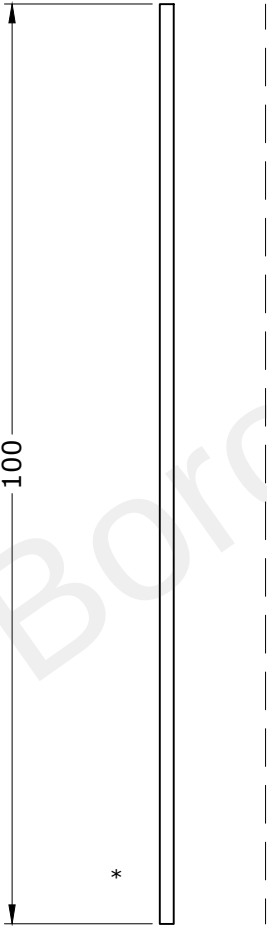

Cill Inside 719
Drainage tray extension

Sunparadise system WD100 Light
Aluminium powder coated frame - RAL 7016 30% MATT
Balustrade section with 6.8mm clear laminated safety glass.
8mm clear toughened frameless sliding folding opening glass,
opening inwards through 90°.
1.5mm ppc aluminium pressings to the perimeter inside and
out, RAL 7016 30% MATT
Outward opening door 10mm clear toughened glass with
manifestation (to be agreed), stainless steel handle.
6mm clear laminated glass fanlight.

 Sunparadise Systems Limited 12 Newmarket Business Centre 341 Exning Road, Newmarket, SUFFOLK CB8 0AT Phone: 0870 067 88 www.sunparadise.com		Date	Init.:	Unit:	mm	Rev.	Description	Date	Init.:
	Design:	Jan'21	GRO	Scale:		A	System description & colour added	02/02/21	GRO
	Checked:					B			
	Order name:	St Patricks Garden Gravesend KENT				C			
						D			
						Business Opp: St Patricks Project ID: 1006-01 Drawing No.: 304			
Subject:	Cill flashing - Inside 719								

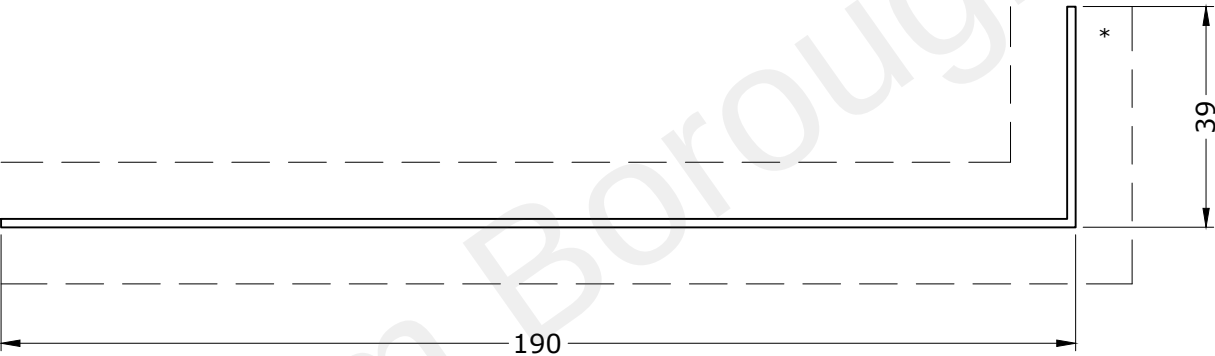


AS BUILT

Sunparadise system WD100 Light
Aluminium powder coated frame - RAL 7016 30% MATT
Balustrade section with 6.8mm clear laminated safety glass.
8mm clear toughened frameless sliding folding opening glass,
opening inwards through 90°.
1.5mm ppc aluminium pressings to the perimeter inside and
out, RAL 7016 30% MATT
Outward opening door 10mm clear toughened glass with
manifestation (to be agreed), stainless steel handle.
6mm clear laminated glass fanlight.

 Sunparadise Systems Limited 12 Newmarket Business Centre 341 Exning Road, Newmarket, SUFFOLK CB8 0AT Phone: 0870 067 88 www.sunparadise.com		Date	Init.:	Unit:	mm	Rev.	Description	Date	Init.:
	Design:	Jan'21	GRO	Scale:		A	System description & colour added	02/02/21	GRO
	Checked:					B			
	Order name:	St Patricks Garden Gravesend KENT				C			
						D			
Subject:	Cill flashing - Outside 711, 712, 713				Business Opp: St Patricks Project ID: 1006-01 Drawing No.: 305				


Material: 1.5mm aluminum, RAL 7016 30% MATT
9 No. L=3000mm

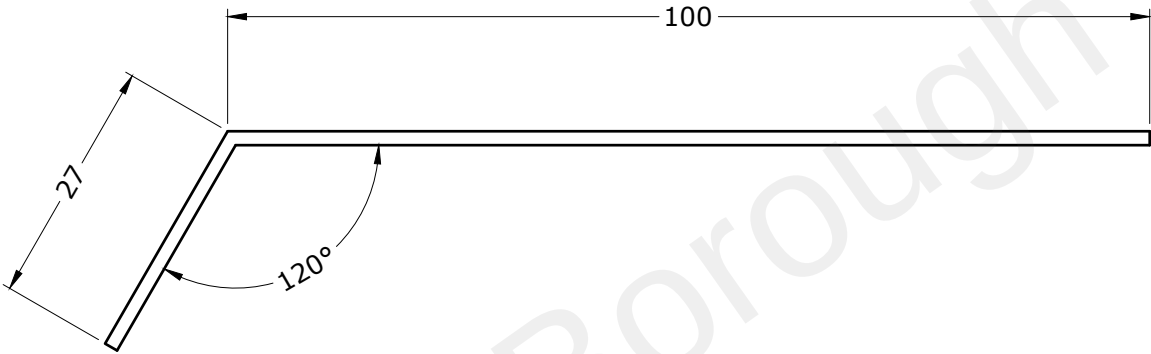

AS BUILT

Sunparadise system WD100 Light
Aluminium powder coated frame - RAL 7016 30% MATT
Balustrade section with 6.8mm clear laminated safety glass.
8mm clear toughened frameless sliding folding opening glass,
opening inwards through 90°.
1.5mm ppc aluminium pressings to the perimeter inside and
out, RAL 7016 30% MATT
Outward opening door 10mm clear toughened glass with
manifestation (to be agreed), stainless steel handle.
6mm clear laminated glass fanlight.


 Sunparadise Systems Limited 12 Newmarket Business Centre 341 Exning Road, Newmarket, SUFFOLK CB8 0AT Phone: 0870 067 88 www.sunparadise.com		Date	Init.:	Unit:	mm	Rev.	Description	Date	Init.:
	Design:	Jan'21	GRO	Scale:		A	System description & colour added	02/02/21	GRO
	Checked:					B			
	Order name:	St Patricks Garden Gravesend KENT				C			
	Subject:	Cill support - Outside 701, 702, 719				D			
							Business Opp: St Patricks Project ID: 1006-01 Drawing No.: 306		

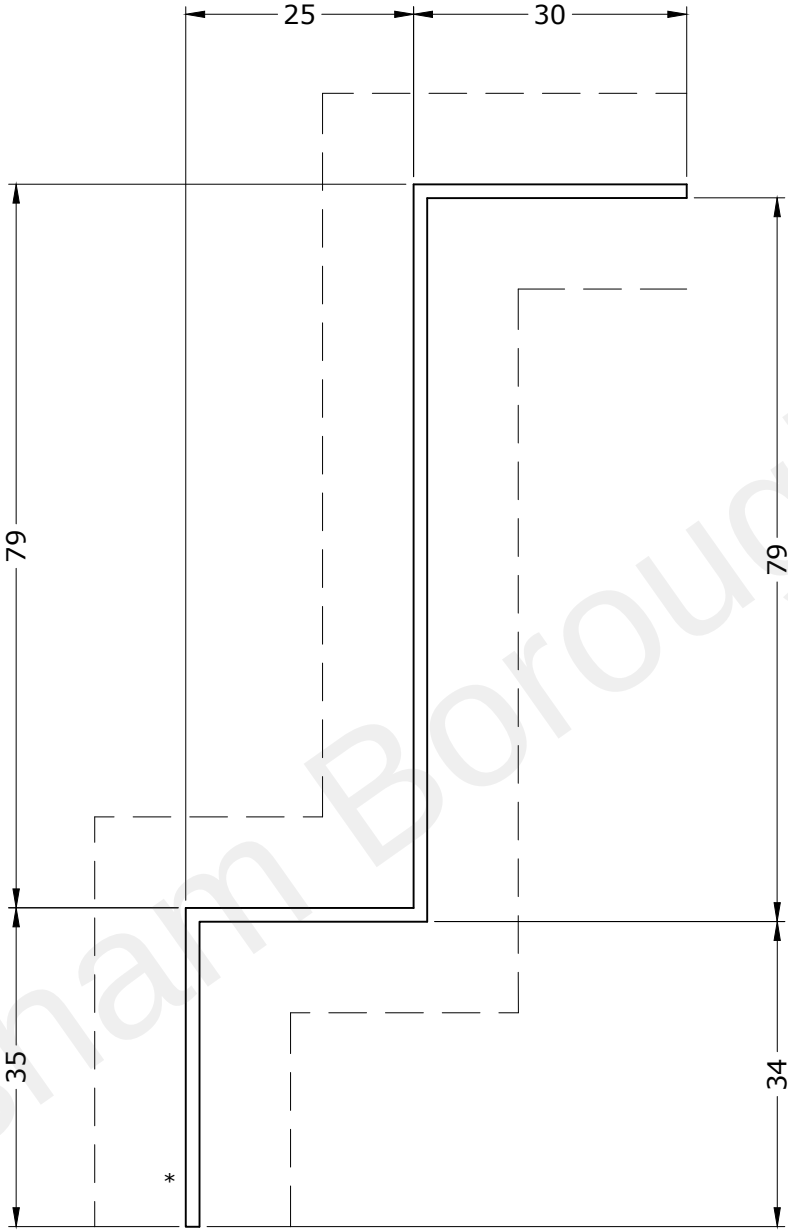

AS BUILT

Sunparadise system WD100 Light
Aluminium powder coated frame - RAL 7016 30% MATT
Balustrade section with 6.8mm clear laminated safety glass.
8mm clear toughened frameless sliding folding opening glass,
opening inwards through 90°.
1.5mm ppc aluminium pressings to the perimeter inside and
out, RAL 7016 30% MATT
Outward opening door 10mm clear toughened glass with
manifestation (to be agreed), stainless steel handle.
6mm clear laminated glass fanlight.

 Sunparadise Systems Limited 12 Newmarket Business Centre 341 Exning Road, Newmarket, SUFFOLK CB8 0AT Phone: 0870 067 88 www.sunparadise.com		Date	Init.:	Unit:	mm	Rev.	Description	Date	Init.:
	Design:	Jan'21	GRO	Scale:		A	System description & colour added	02/02/21	GRO
	Checked:					B			
	Order name:	St Patricks Garden Gravesend KENT				C			
						D			
						Business Opp: St Patricks Project ID: 1006-01 Drawing No.: 307			
Subject:	Intermediate detail Cill/Head_1 701 - 718								

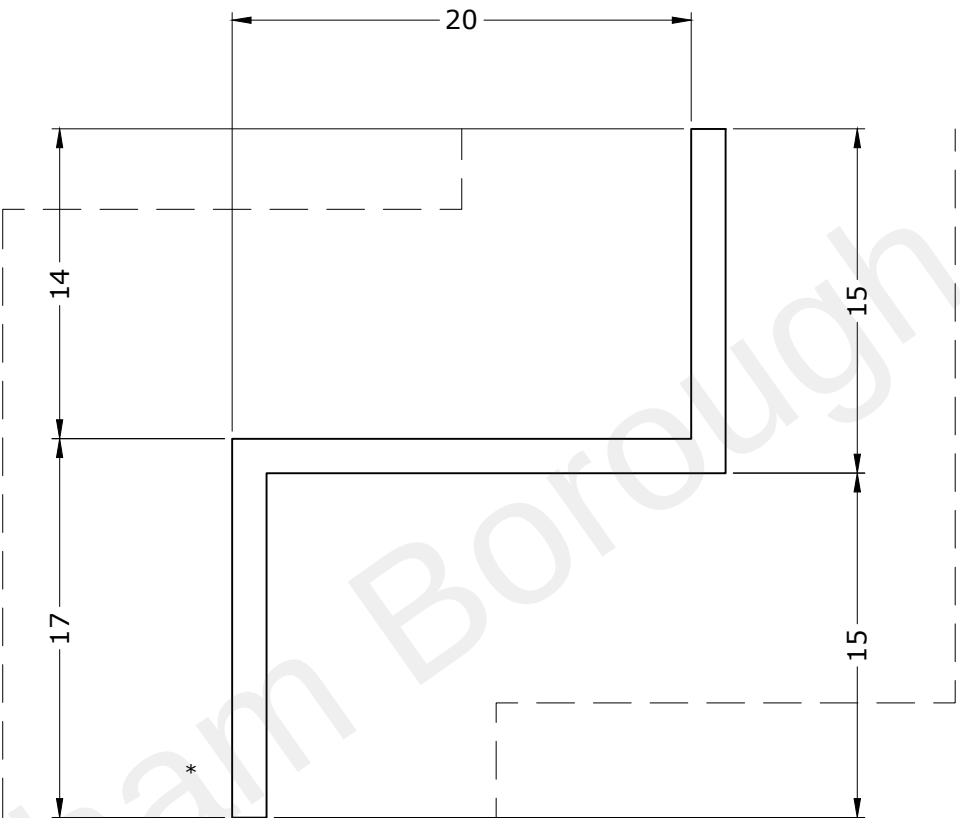

AS BUILT


Sunparadise system WD100 Light
Aluminium powder coated frame - RAL 7016 30% MATT
Balustrade section with 6.8mm clear laminated safety glass.
8mm clear toughened frameless sliding folding opening glass,
opening inwards through 90°.
1.5mm ppc aluminium pressings to the perimeter inside and
out, RAL 7016 30% MATT
Outward opening door 10mm clear toughened glass with
manifestation (to be agreed), stainless steel handle.
6mm clear laminated glass fanlight.

 Sunparadise Systems Limited 12 Newmarket Business Centre 341 Exning Road, Newmarket, SUFFOLK CB8 0AT Phone: 0870 067 88 www.sunparadise.com		Date	Init.:	Unit:	mm	Rev.	Description	Date	Init.:
	Design:	Jan'21	GRO	Scale:		A	System description & colour added	02/02/21	GRO
	Checked:					B			
	Order name:	St Patricks Garden Gravesend KENT				C			
						D			
Subject:	Drainage tray support angle Cill/Head_1/2/3 701 - 718				Business Opp: St Patricks Project ID: 1006-01 Drawing No.: 308				



Material: 3mm aluminium, RAL 7016 30% MATT
24 off L = 2483mm (see below)
See below for spigot pipe position
Welded stop ends to both ends (stop ends ppc'd both sides)

----- ppc surface
* denotes position of hanging hole


12 off Left hand

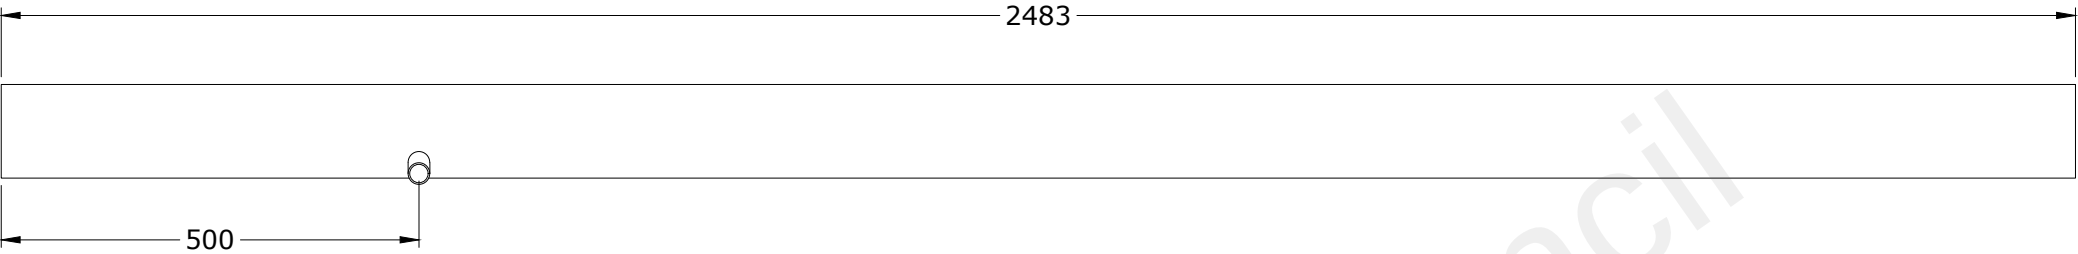

12 off Right hand

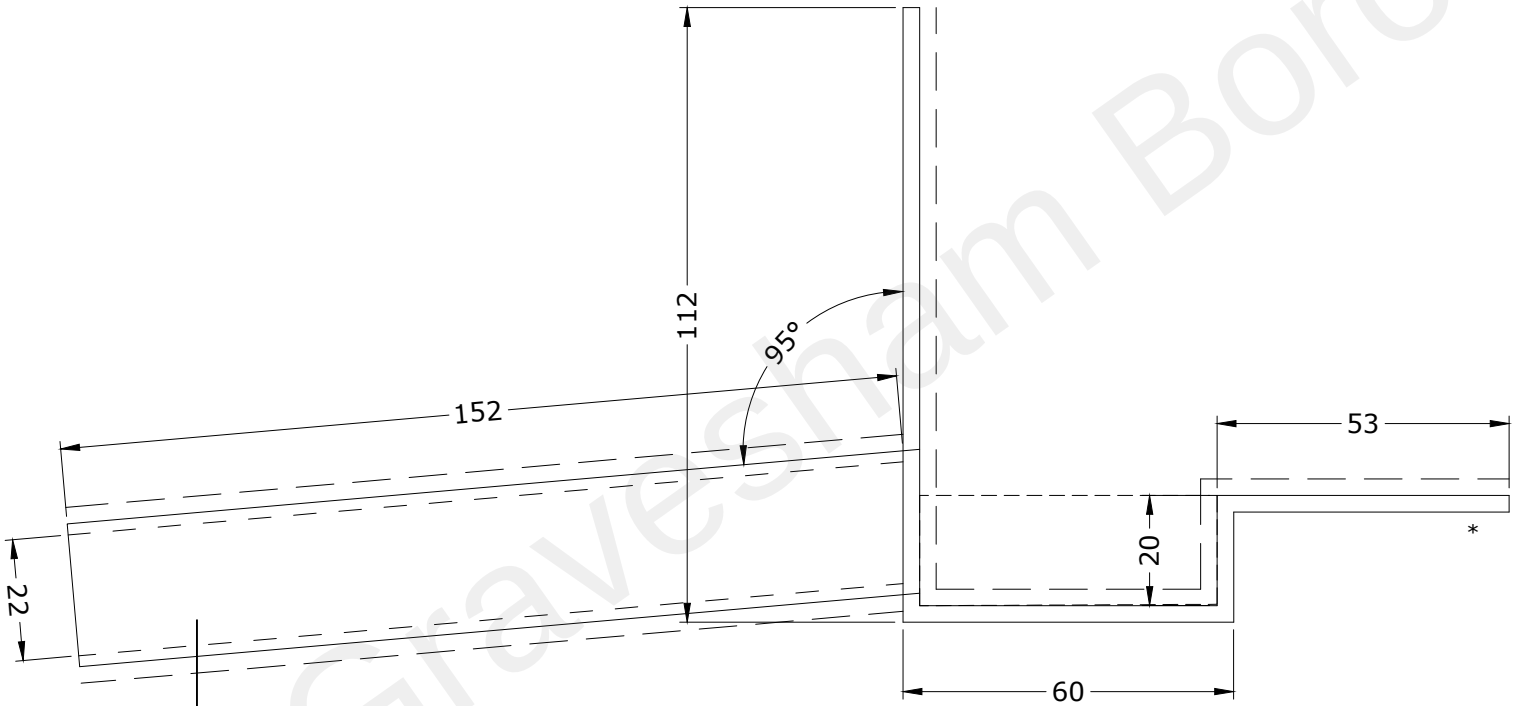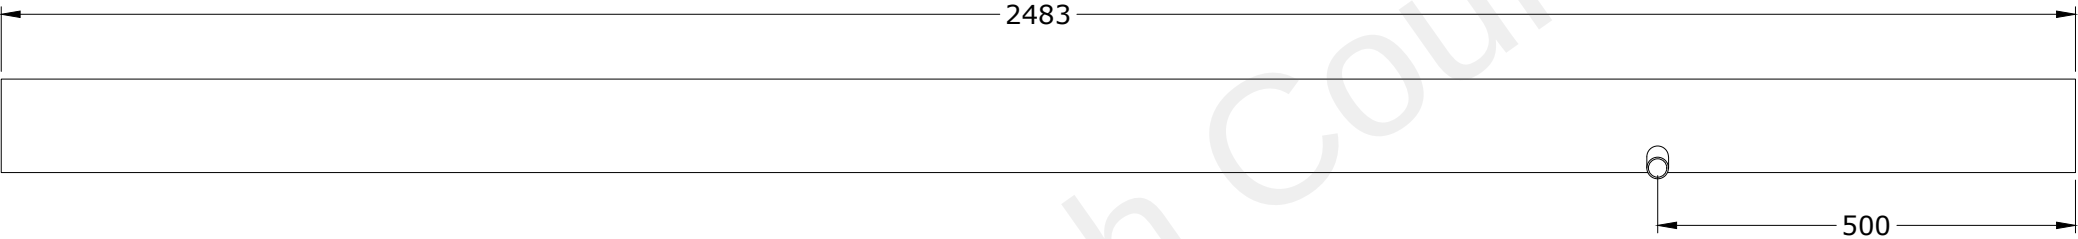


spigot pipe to have internal diameter of 22mm

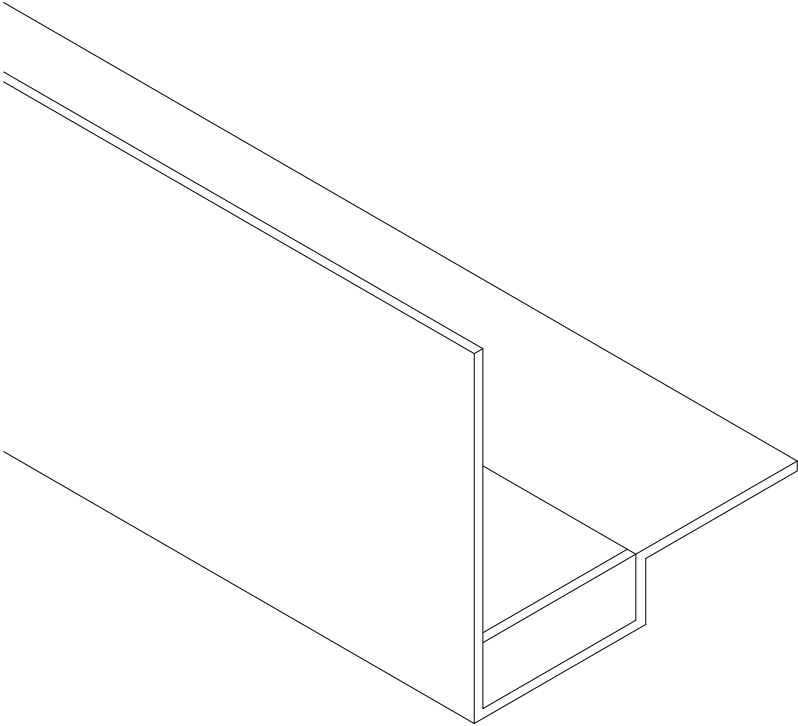

AS BUILT

Sunparadise system WD100 Light
Aluminium powder coated frame - RAL 7016 30% MATT
Balustrade section with 6.8mm clear laminated safety glass.
8mm clear toughened frameless sliding folding opening glass,
opening inwards through 90°.
1.5mm ppc aluminium pressings to the perimeter inside and
out, RAL 7016 30% MATT
Outward opening door 10mm clear toughened glass with
manifestation (to be agreed), stainless steel handle.
6mm clear laminated glass fanlight.

 Sunparadise Systems Limited 12 Newmarket Business Centre 341 Exning Road, Newmarket, SUFFOLK CB8 0AT Phone: 0870 067 88 www.sunparadise.com		Date	Init.:	Unit:	mm	Rev.	Description	Date	Init.:
	Design:	Jan'21	GRO	Scale:		A	System description & colour added	02/02/21	GRO
	Checked:					B			
	Order name:	St Patricks Garden Gravesend KENT				C			
						D			
Subject:	Drainage tray Cill/Head				Business Opp: St Patricks Project ID: 1006-01 Drawing No.: 309				

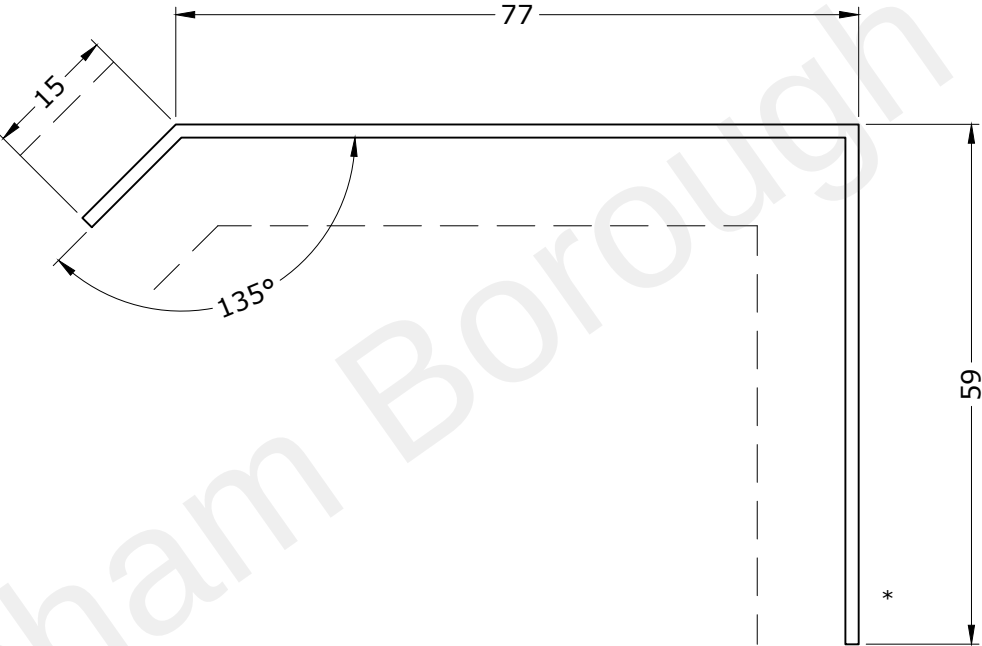


AS BUILT

Sunparadise system WD100 Light
Aluminium powder coated frame - RAL 7016 30% MATT
Balustrade section with 6.8mm clear laminated safety glass.
8mm clear toughened frameless sliding folding opening glass,
opening inwards through 90°.
1.5mm ppc aluminium pressings to the perimeter inside and
out, RAL 7016 30% MATT
Outward opening door 10mm clear toughened glass with
manifestation (to be agreed), stainless steel handle.
6mm clear laminated glass fanlight.



Sunparadise Systems Limited
12 Newmarket Business Centre
341 Exning Road, Newmarket,
SUFFOLK CB8 0AT
Phone: 0870 067 88
www.sunparadise.com

	Date	Init.:	Unit:	mm	Rev.	Description	Date	Init.:
Design:	Jan'21	GRO	Scale:		A	System description & colour added	02/02/21	GRO
Checked:				B				
Order name:	St Patricks Garden Gravesend KENT			C				
			D					
			Business Opp: St Patricks Project ID: 1006-01 Drawing No.: 310					
Subject:	Head detail 1 - Outside 719							

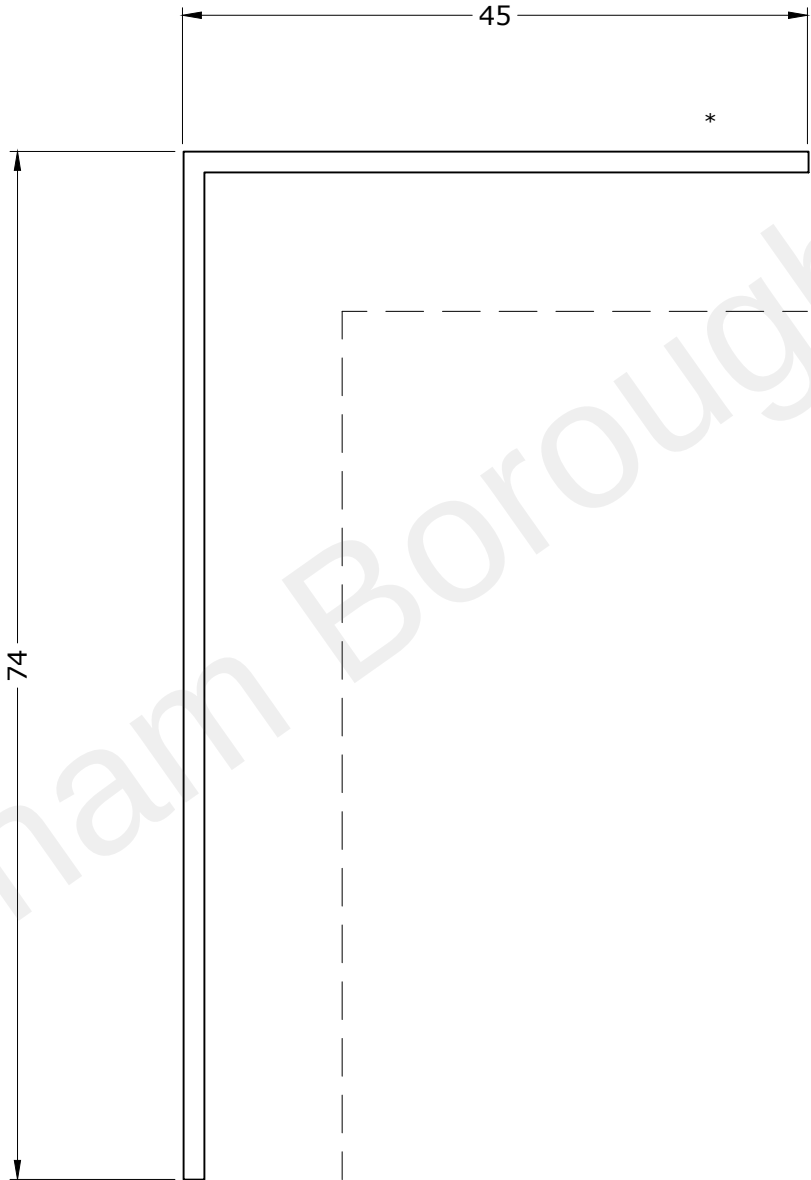


AS BUILT

Sunparadise system WD100 Light
Aluminium powder coated frame - RAL 7016 30% MATT
Balustrade section with 6.8mm clear laminated safety glass.
8mm clear toughened frameless sliding folding opening glass,
opening inwards through 90°.
1.5mm ppc aluminium pressings to the perimeter inside and
out, RAL 7016 30% MATT
Outward opening door 10mm clear toughened glass with
manifestation (to be agreed), stainless steel handle.
6mm clear laminated glass fanlight.

Head detail 1 Inside_1 719,
Head detail 2 - Outside_1 705, 706, 709, 710, 717, 718,
Cill support 707, 176

 Sunparadise Systems Limited 12 Newmarket Business Centre 341 Exning Road, Newmarket, SUFFOLK CB8 0AT Phone: 0870 067 88 www.sunparadise.com		Date	Init.:	Unit: mm	Rev.	Description	Date	Init.:
	Design:	Jan'21	GRO	Scale:	A	System description & colour added	02/02/21	GRO
	Checked:				B			
	Order name:	St Patricks Garden Gravesend KENT			C			
					D			
Subject:	Head detail 1 - Inside_1 719			Business Opp: St Patricks Project ID: 1006-01 Drawing No.: 311				


ppc surface
* denotes position of hanging hole

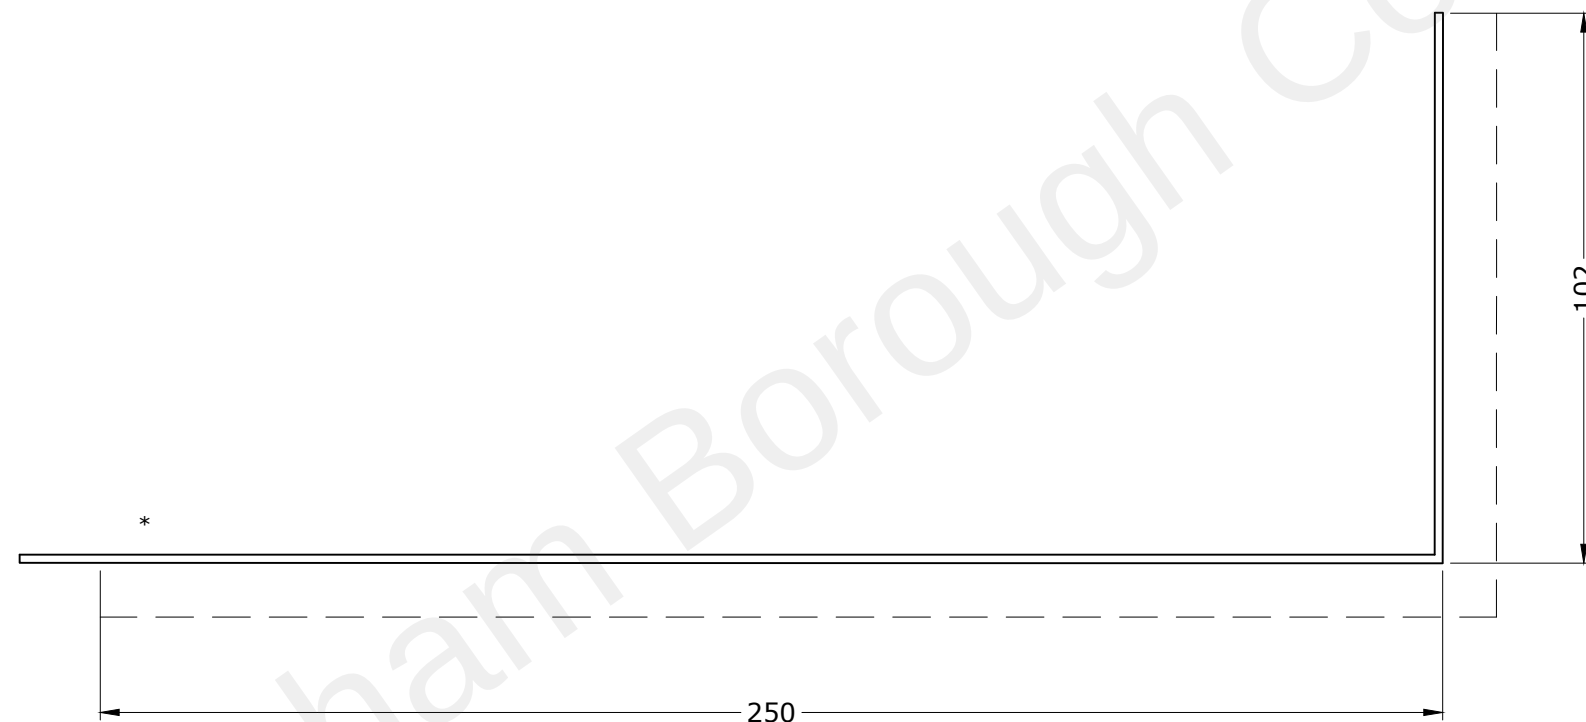

Summary of system WD100 Light
 Aluminium powder coated frame - RAL 7016 30% MATT
 Balustrade section with 6.8mm clear laminated safety glass.
 8mm clear toughened frameless sliding folding opening glass,
 opening inwards through 90°.
 1.5mm ppc aluminium pressings to the perimeter inside and
 out, RAL 7016 30% MATT
 Outward opening door 10mm clear toughened glass with
 manifestation (to be agreed), stainless steel handle.
 6mm clear laminated glass fanlight.

Sunparadise Systems Limited
12 Newmarket Business Centre
341 Exning Road, Newmarket,
SUFFOLK CB8 0AT
Phone: 0870 067 88
www.sunparadise.com

	Date	Init.:	Unit: mm	Rev.	Description	Date	Init.:
Design:	Jan'21	GRO	Scale:	A	System description & colour added	02/02/21	GRO
Checked:				B			
Order name:	St Patricks Garden Gravesend KENT			C			
				D			
				Business Opp: St Patricks Project ID: 1006-01 Drawing No.: 312			
Subject:	Head detail 1 - Inside_2 719						

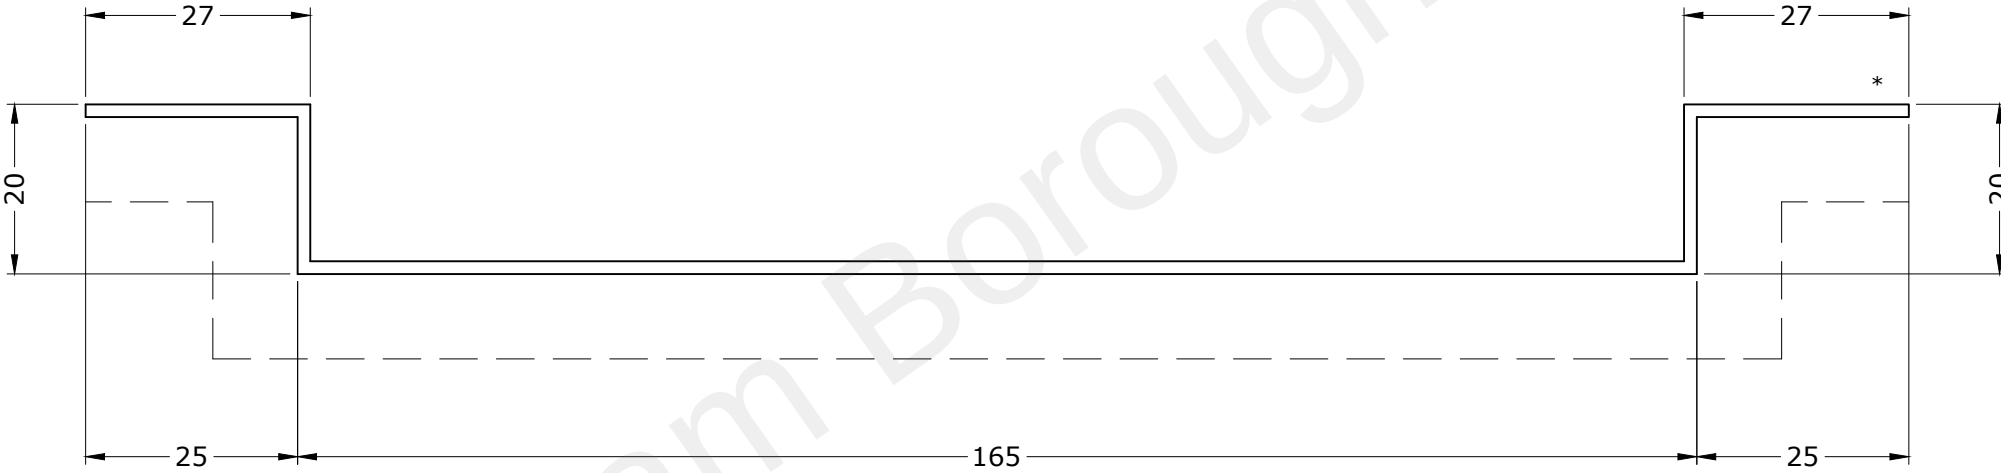


AS BUILT

Sunparadise system WD100 Light
Aluminium powder coated frame - RAL 7016 30% MATT
Balustrade section with 6.8mm clear laminated safety glass.
8mm clear toughened frameless sliding folding opening glass,
opening inwards through 90°.
1.5mm ppc aluminium pressings to the perimeter inside and
out, RAL 7016 30% MATT
Outward opening door 10mm clear toughened glass with
manifestation (to be agreed), stainless steel handle.
6mm clear laminated glass fanlight.

 Sunparadise Systems Limited 12 Newmarket Business Centre 341 Exning Road, Newmarket, SUFFOLK CB8 0AT Phone: 0870 067 88 www.sunparadise.com		Date	Init.:	Unit:	mm	Rev.	Description	Date	Init.:
	Design:	Jan'21	GRO	Scale:		A	System description & colour added	02/02/21	GRO
	Checked:					B			
	Order name:	St Patricks Garden Gravesend KENT				C			
						D			
Subject:	Head detail 2 - Outside_1 705 706 709 710 717 718				Business Opp: St Patricks Project ID: 1006-01 Drawing No.: 313				


ppc surface
* denotes position of hanging hole

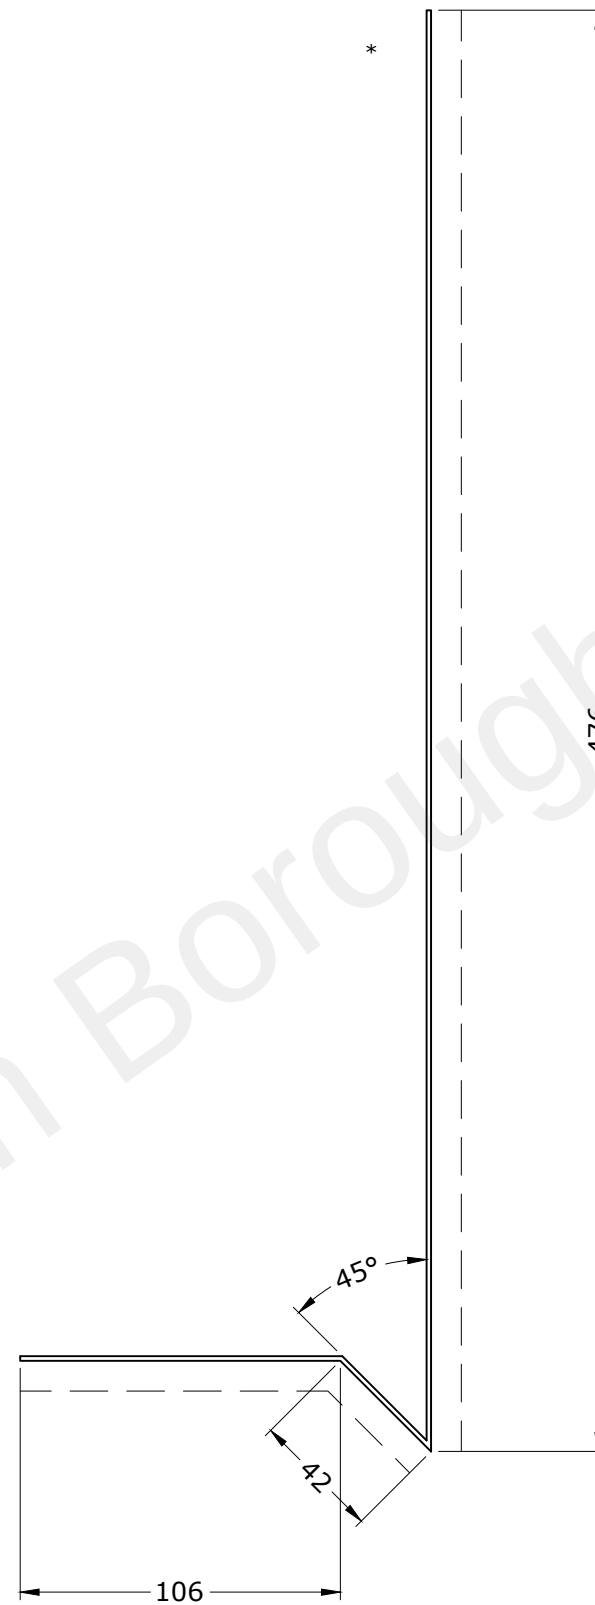

Sunparadise system WD100 Light
Aluminium powder coated frame - RAL 7016 30% MATT
Balustrade section with 6.8mm clear laminated safety glass.
8mm clear toughened frameless sliding folding opening glass,
opening inwards through 90°.
1.5mm ppc aluminium pressings to the perimeter inside and
out, RAL 7016 30% MATT
Outward opening door 10mm clear toughened glass with
manifestation (to be agreed), stainless steel handle.
6mm clear laminated glass fanlight.

Sunparadise Systems Limited
12 Newmarket Business Centre
341 Exning Road, Newmarket,
SUFFOLK CB8 0AT
Phone: 0870 067 88
www.sunparadise.com


	Date	Init.:	Unit: mm	Rev.	Description	Date	Init.:
Design:	Jan'21	GRO	Scale:	A	System description & colour added	02/02/21	GRO
Checked:				B			
Order name:	St Patricks Garden Gravesend KENT			C			
				D			
				Business Opp: St Patricks Project ID: 1006-01 Drawing No.: 315			
Subject:	Cill detail 3 - Outside 707, 716						

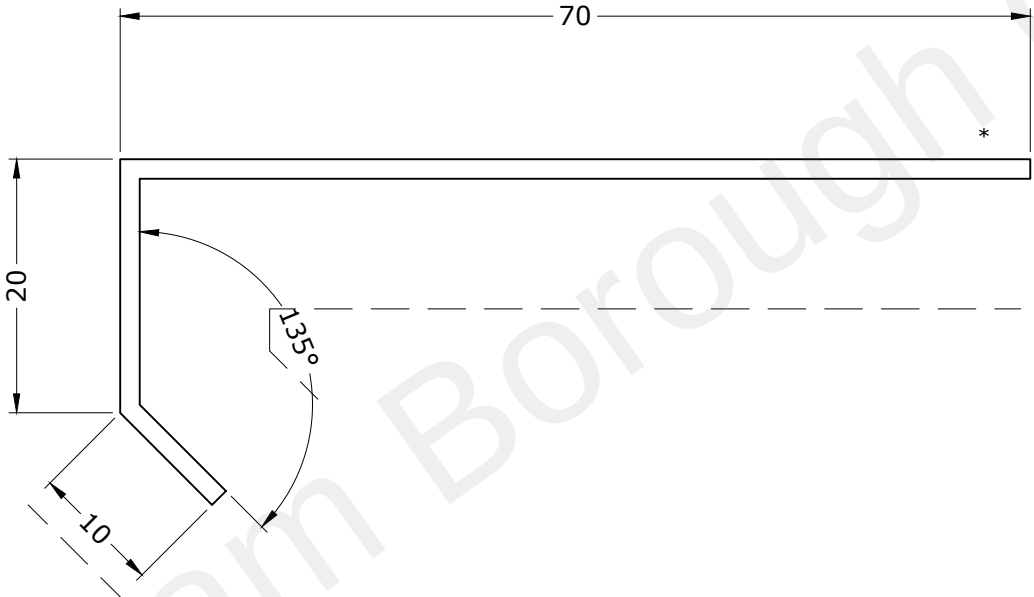

AS BUILT

Sunparadise system WD100 Light
Aluminium powder coated frame - RAL 7016 30% MATT
Balustrade section with 6.8mm clear laminated safety glass.
8mm clear toughened frameless sliding folding opening glass,
opening inwards through 90°.
1.5mm ppc aluminium pressings to the perimeter inside and
out, RAL 7016 30% MATT
Outward opening door 10mm clear toughened glass with
manifestation (to be agreed), stainless steel handle.
6mm clear laminated glass fanlight.

 Sunparadise Systems Limited 12 Newmarket Business Centre 341 Exning Road, Newmarket, SUFFOLK CB8 0AT Phone: 0870 067 88 www.sunparadise.com		Date	Init.:	Unit:	mm	Rev.	Description	Date	Init.:
	Design:	Jan'21	GRO	Scale:		A	System description & colour added	02/02/21	GRO
	Checked:					B			
	Order name:	St Patricks Garden Gravesend KENT				C			
						D			
Subject:	Verge flashing - Outside All elements				Business Opp: St Patricks Project ID: 1006-01 Drawing No.: 317				

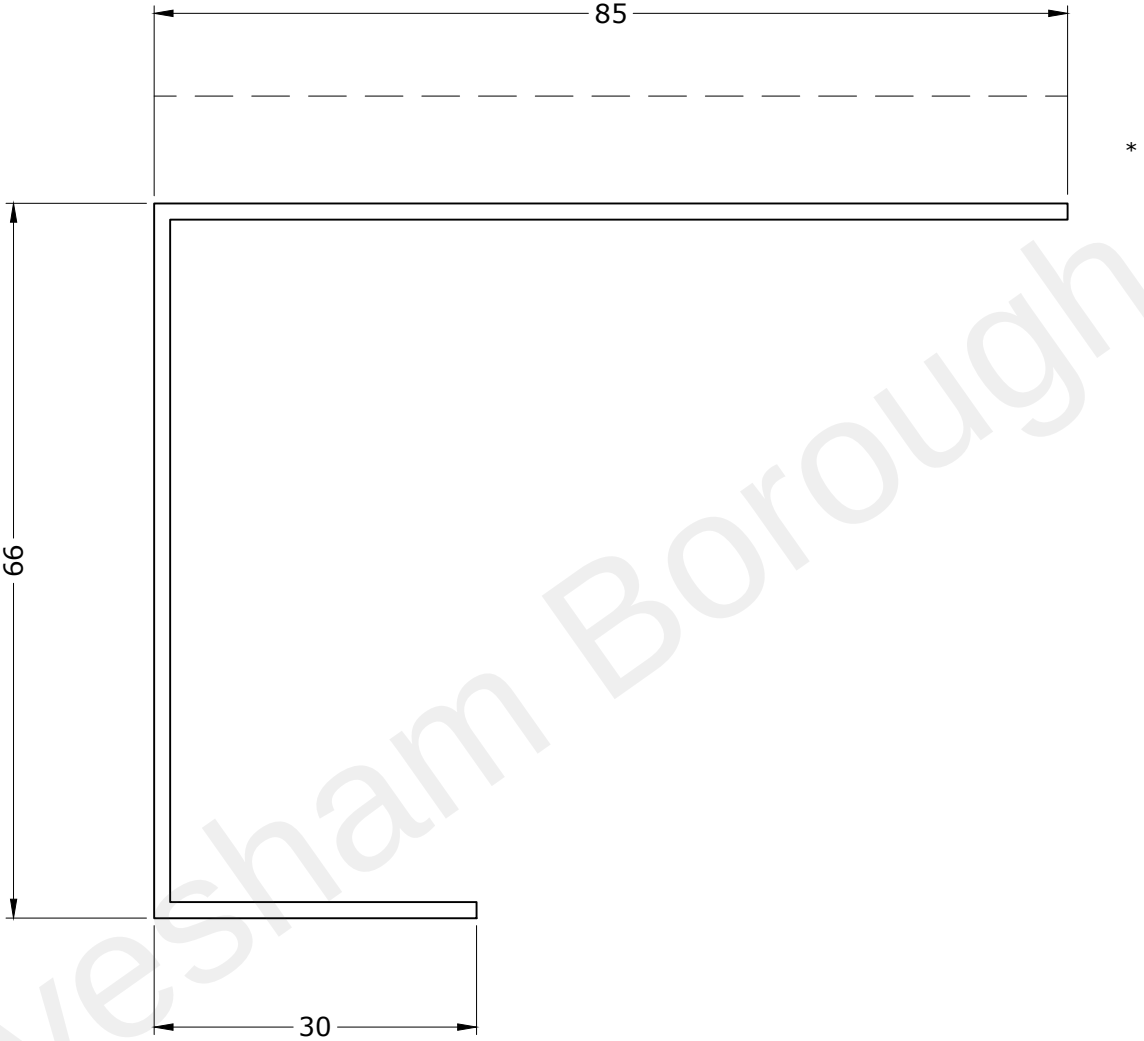


AS BUILT

Sunparadise system WD100 Light
Aluminium powder coated frame - RAL 7016 30% MATT
Balustrade section with 6.8mm clear laminated safety glass.
8mm clear toughened frameless sliding folding opening glass,
opening inwards through 90°.
1.5mm ppc aluminium pressings to the perimeter inside and
out, RAL 7016 30% MATT
Outward opening door 10mm clear toughened glass with
manifestation (to be agreed), stainless steel handle.
6mm clear laminated glass fanlight.

sunparadise

Sunparadise Systems Limited
12 Newmarket Business Centre
341 Exning Road, Newmarket,
SUFFOLK CB8 0AT
Phone: 0870 067 88
www.sunparadise.com


	Date	Init.:	Unit:	mm	Rev.	Description	Date	Init.:
Design:	Jan'21	GRO	Scale:		A	System description & colour added	02/02/21	GRO
Checked:					B			
Order name:	St Patricks Garden Gravesend KENT				C			
					D			
Subject:	Verge flashing - Inside All elements				Business Opp: St Patricks			
Project ID: 1006-01								
					Drawing No.: 318			

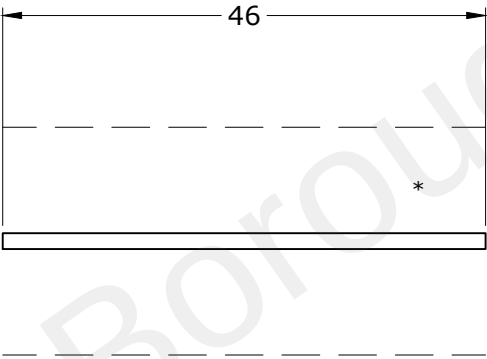

AS BUILT

Sunparadise system WD100 Light
Aluminium powder coated frame - RAL 7016 30% MATT
Balustrade section with 6.8mm clear laminated safety glass.
8mm clear toughened frameless sliding folding opening glass,
opening inwards through 90°.
1.5mm ppc aluminium pressings to the perimeter inside and
out, RAL 7016 30% MATT
Outward opening door 10mm clear toughened glass with
manifestation (to be agreed), stainless steel handle.
6mm clear laminated glass fanlight.

 Sunparadise Systems Limited 12 Newmarket Business Centre 341 Exning Road, Newmarket, SUFFOLK CB8 0AT Phone: 0870 067 88 www.sunparadise.com		Date	Init.:	Unit:	mm	Rev.	Description	Date	Init.:
	Design:	Jan'21	GRO	Scale:		A	System description & colour added	02/02/21	GRO
	Checked:					B			
	Order name:	St Patricks Garden Gravesend KENT				C			
						D			
						Business Opp: St Patricks Project ID: 1006-01 Drawing No.: 319			
Subject:	Connecting flashing - 46mm 701-706, 711-713								

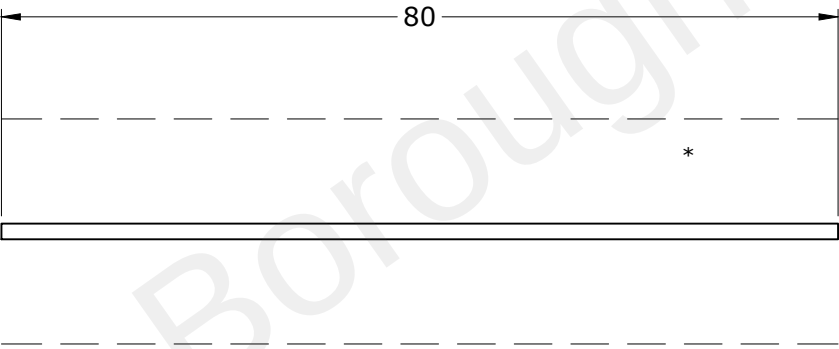


AS BUILT

Sunparadise system WD100 Light
Aluminium powder coated frame - RAL 7016 30% MATT
Balustrade section with 6.8mm clear laminated safety glass.
8mm clear toughened frameless sliding folding opening glass,
opening inwards through 90°.
1.5mm ppc aluminium pressings to the perimeter inside and
out, RAL 7016 30% MATT
Outward opening door 10mm clear toughened glass with
manifestation (to be agreed), stainless steel handle.
6mm clear laminated glass fanlight.

 Sunparadise Systems Limited 12 Newmarket Business Centre 341 Exning Road, Newmarket, SUFFOLK CB8 0AT Phone: 0870 067 88 www.sunparadise.com		Date	Init.:	Unit: mm	Rev.	Description	Date	Init.:
	Design:	Jan'21	GRO	Scale:	A	System description & colour added	02/02/21	GRO
	Checked:				B			
	Order name:	St Patricks Garden Gravesend KENT			C			
					D			
					Business Opp: St Patricks Project ID: 1006-01 Drawing No.: 320			
Subject:	Connecting flashing - 80mm 707-710, 715-718							

12 No. L=2520mm

* denotes position of hanging hole

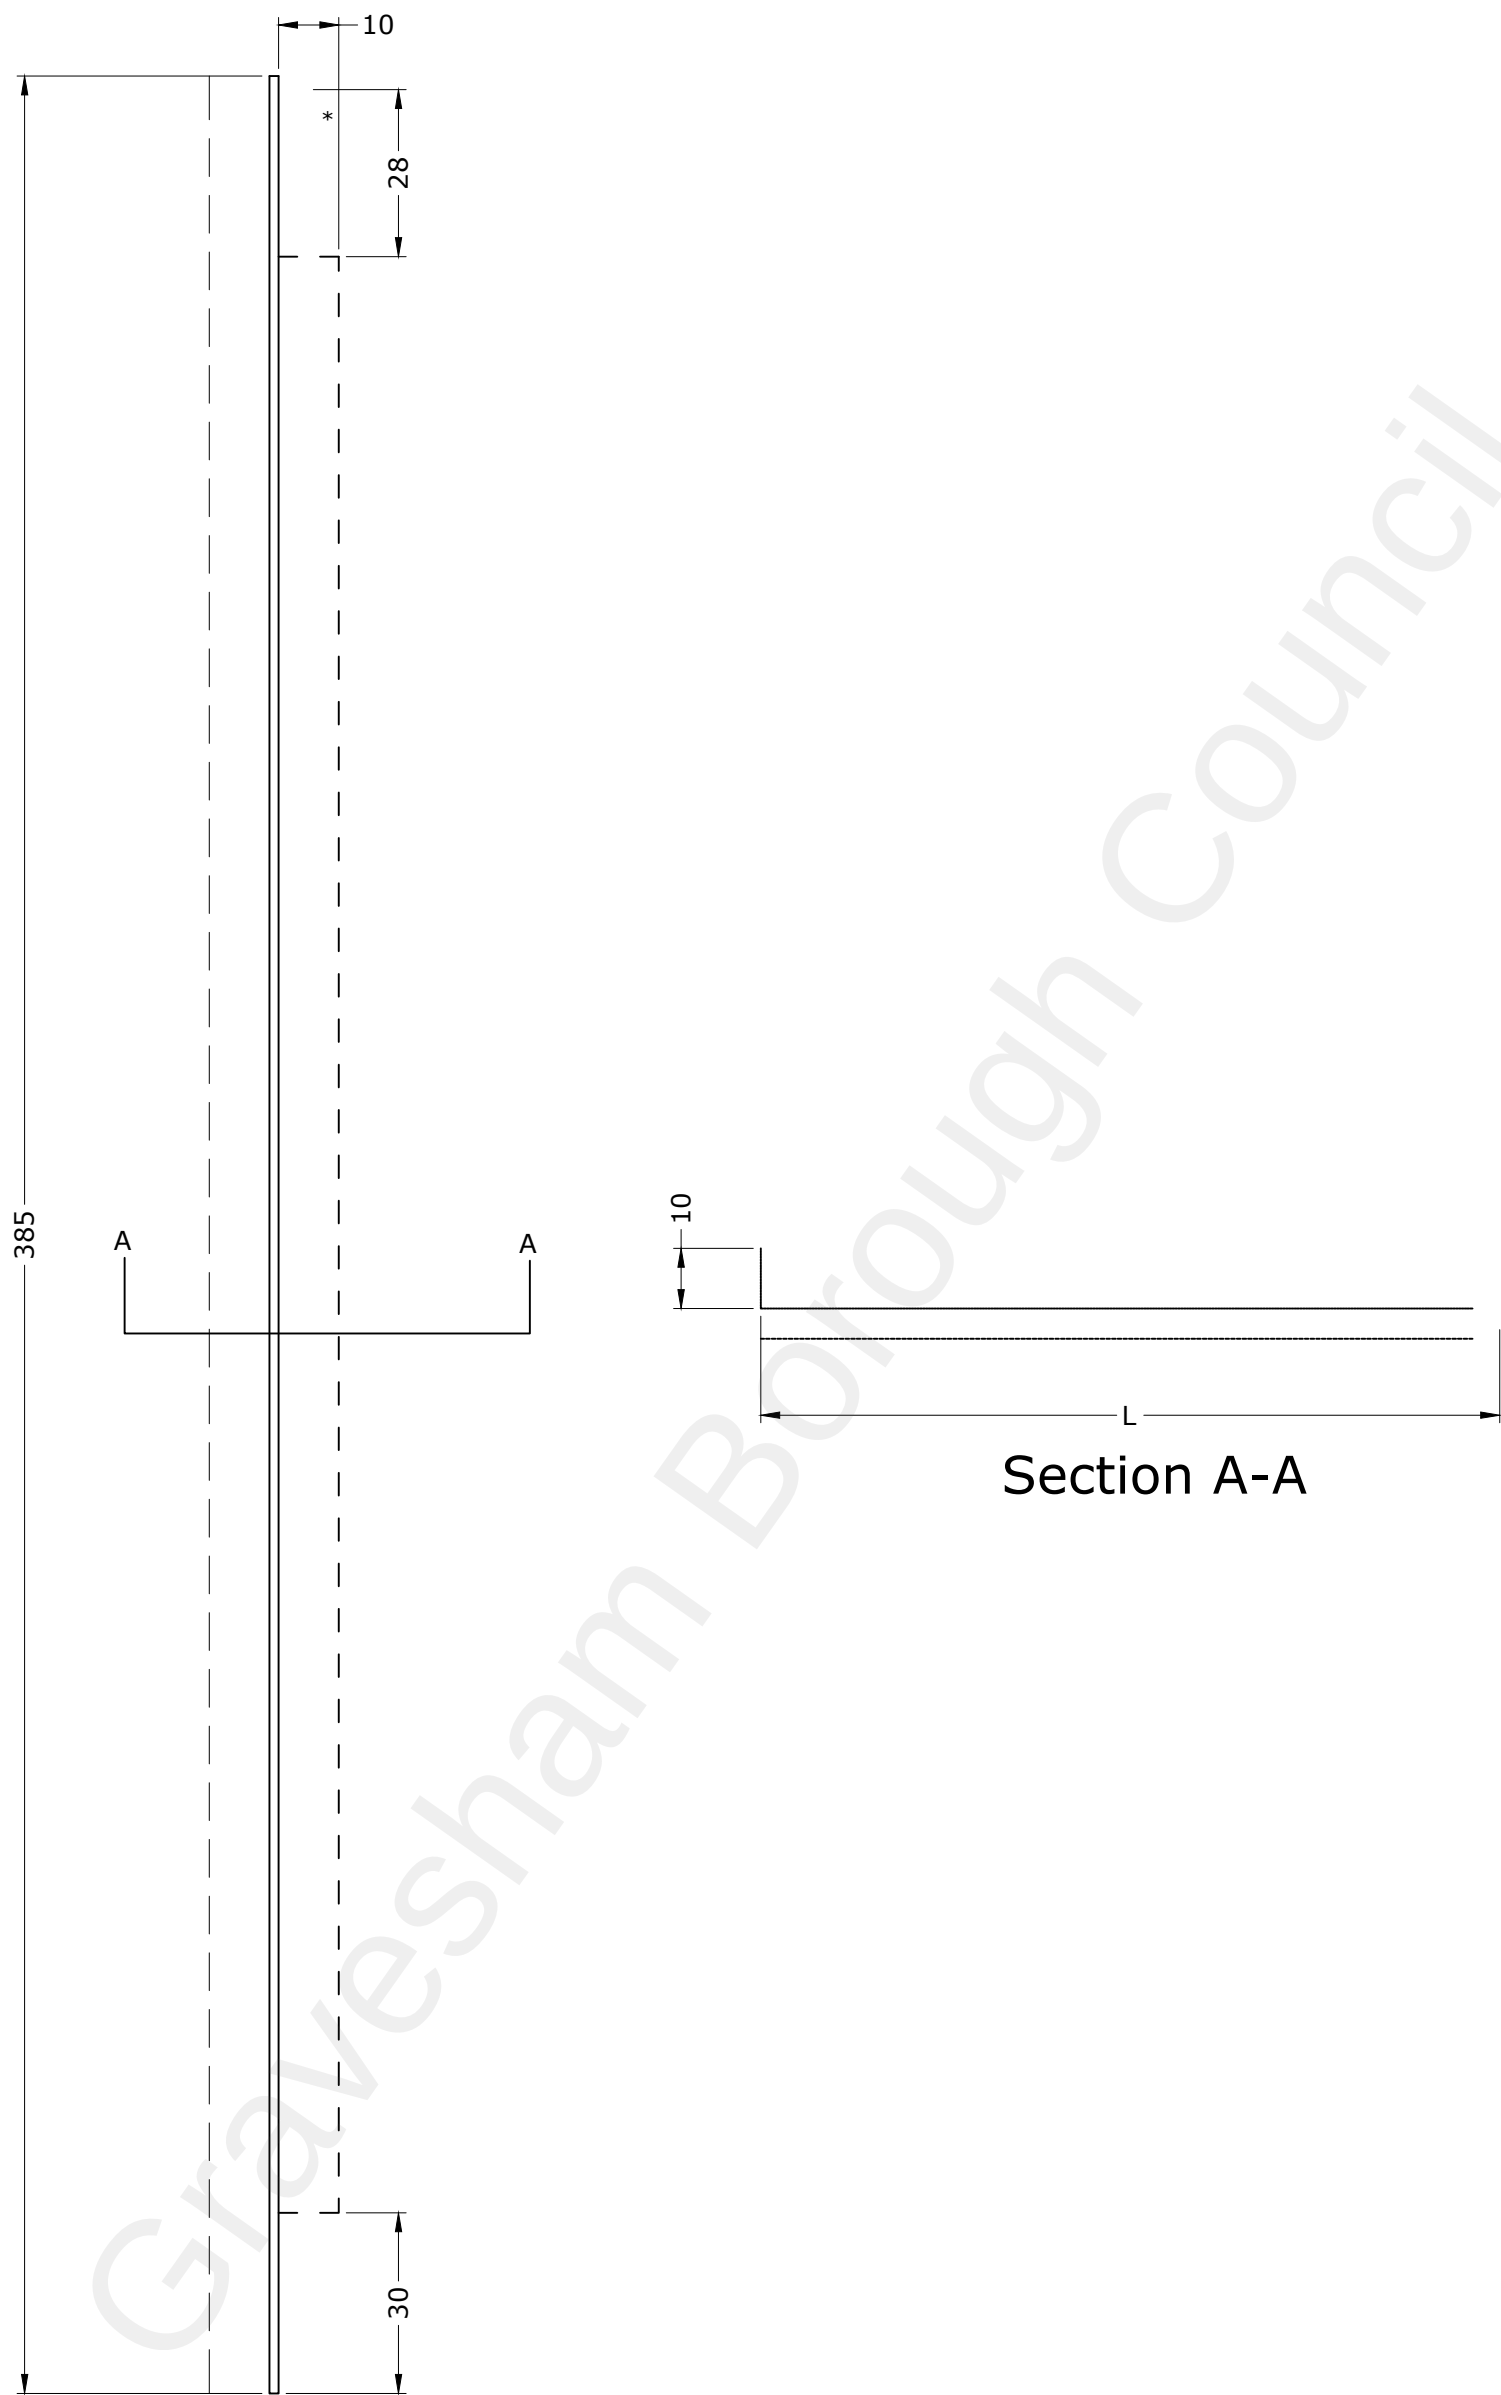

Section A-A

AS BUILT

Sunparadise system WD100 Light
Aluminium powder coated frame - RAL 7016 30% MATT
Balustrade section with 6.8mm clear laminated safety glass.
8mm clear toughened frameless sliding folding opening glass,
opening inwards through 90°.
1.5mm ppc aluminium pressings to the perimeter inside and
out, RAL 7016 30% MATT
Outward opening door 10mm clear toughened glass with


sunparadise

Sunparadise Systems Limited
12 Newmarket Business Centre
341 Exning Road, Newmarket,
SUFFOLK CB8 0AT

	Date	Init.:	Unit:	mm	Rev.	Description	Date	Init.:
Design:	Jan'21	GRO	Scale:		A	System description & colour added	02/02/21	GRO
Checked:					B			
Order name:	St Patricks Garden Gravesend Kent				C			
					D			
Subject:	External horizontal flashing				Business Opp: St Patricks Project ID: 1006-01			

7 No. L=2670mm

* denotes position of hanging hole

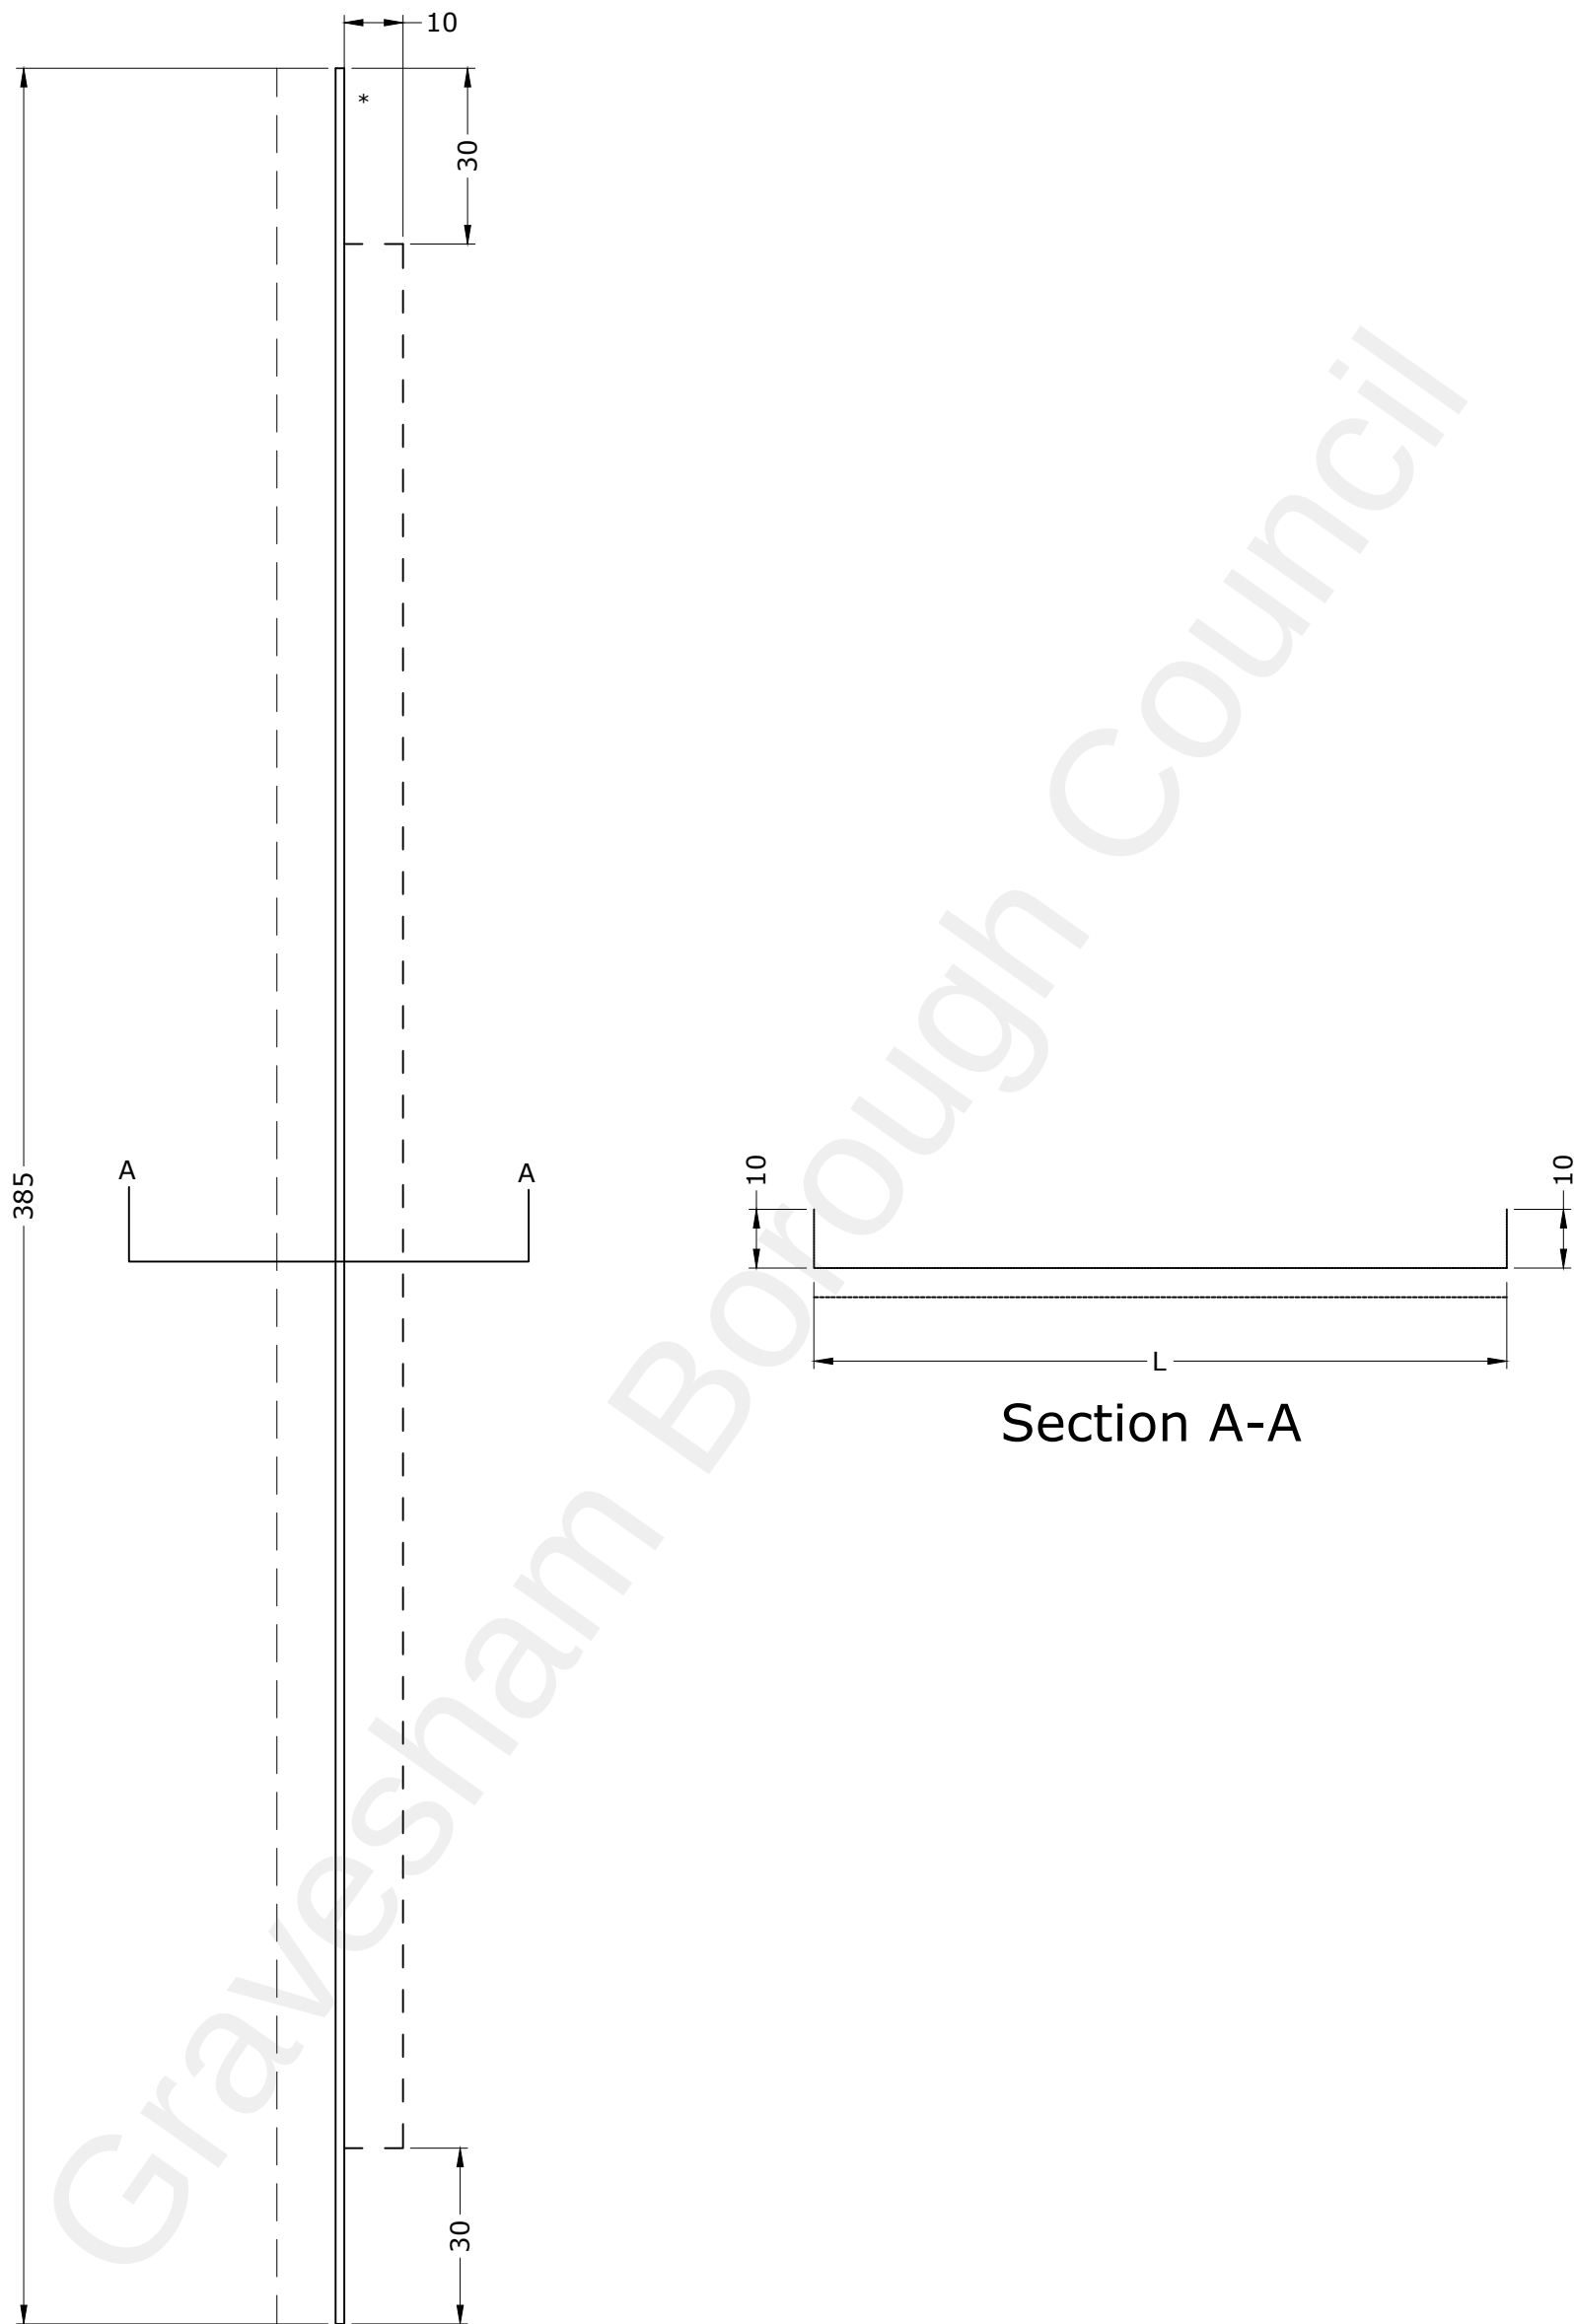

AS BUILT

Sunparadise system WD100 Light
Aluminium powder coated frame - RAL 7016 30% MATT
Balustrade section with 6.8mm clear laminated safety glass.
8mm clear toughened frameless sliding folding opening glass,
opening inwards through 90°.
1.5mm ppc aluminium pressings to the perimeter inside and
out, RAL 7016 30% MATT
Outward opening door 10mm clear toughened glass with


sunparadise

Sunparadise Systems Limited
12 Newmarket Business Centre
341 Exning Road, Newmarket,
SUFFOLK CB8 0AT

	Date	Init.:	Unit:	mm	Rev.	Description	Date	Init.:
Design:	Jan'21	GRO	Scale:		A	System description & colour added	02/02/21	GRO
Checked:					B			
Order name:	St Patricks Garden Gravesend Kent				C			
					D			
Subject:	External horizontal flashing				Business Opp: St Patricks Project ID: 1006-01			

6 No. L=2600mm

* denotes position of hanging hole

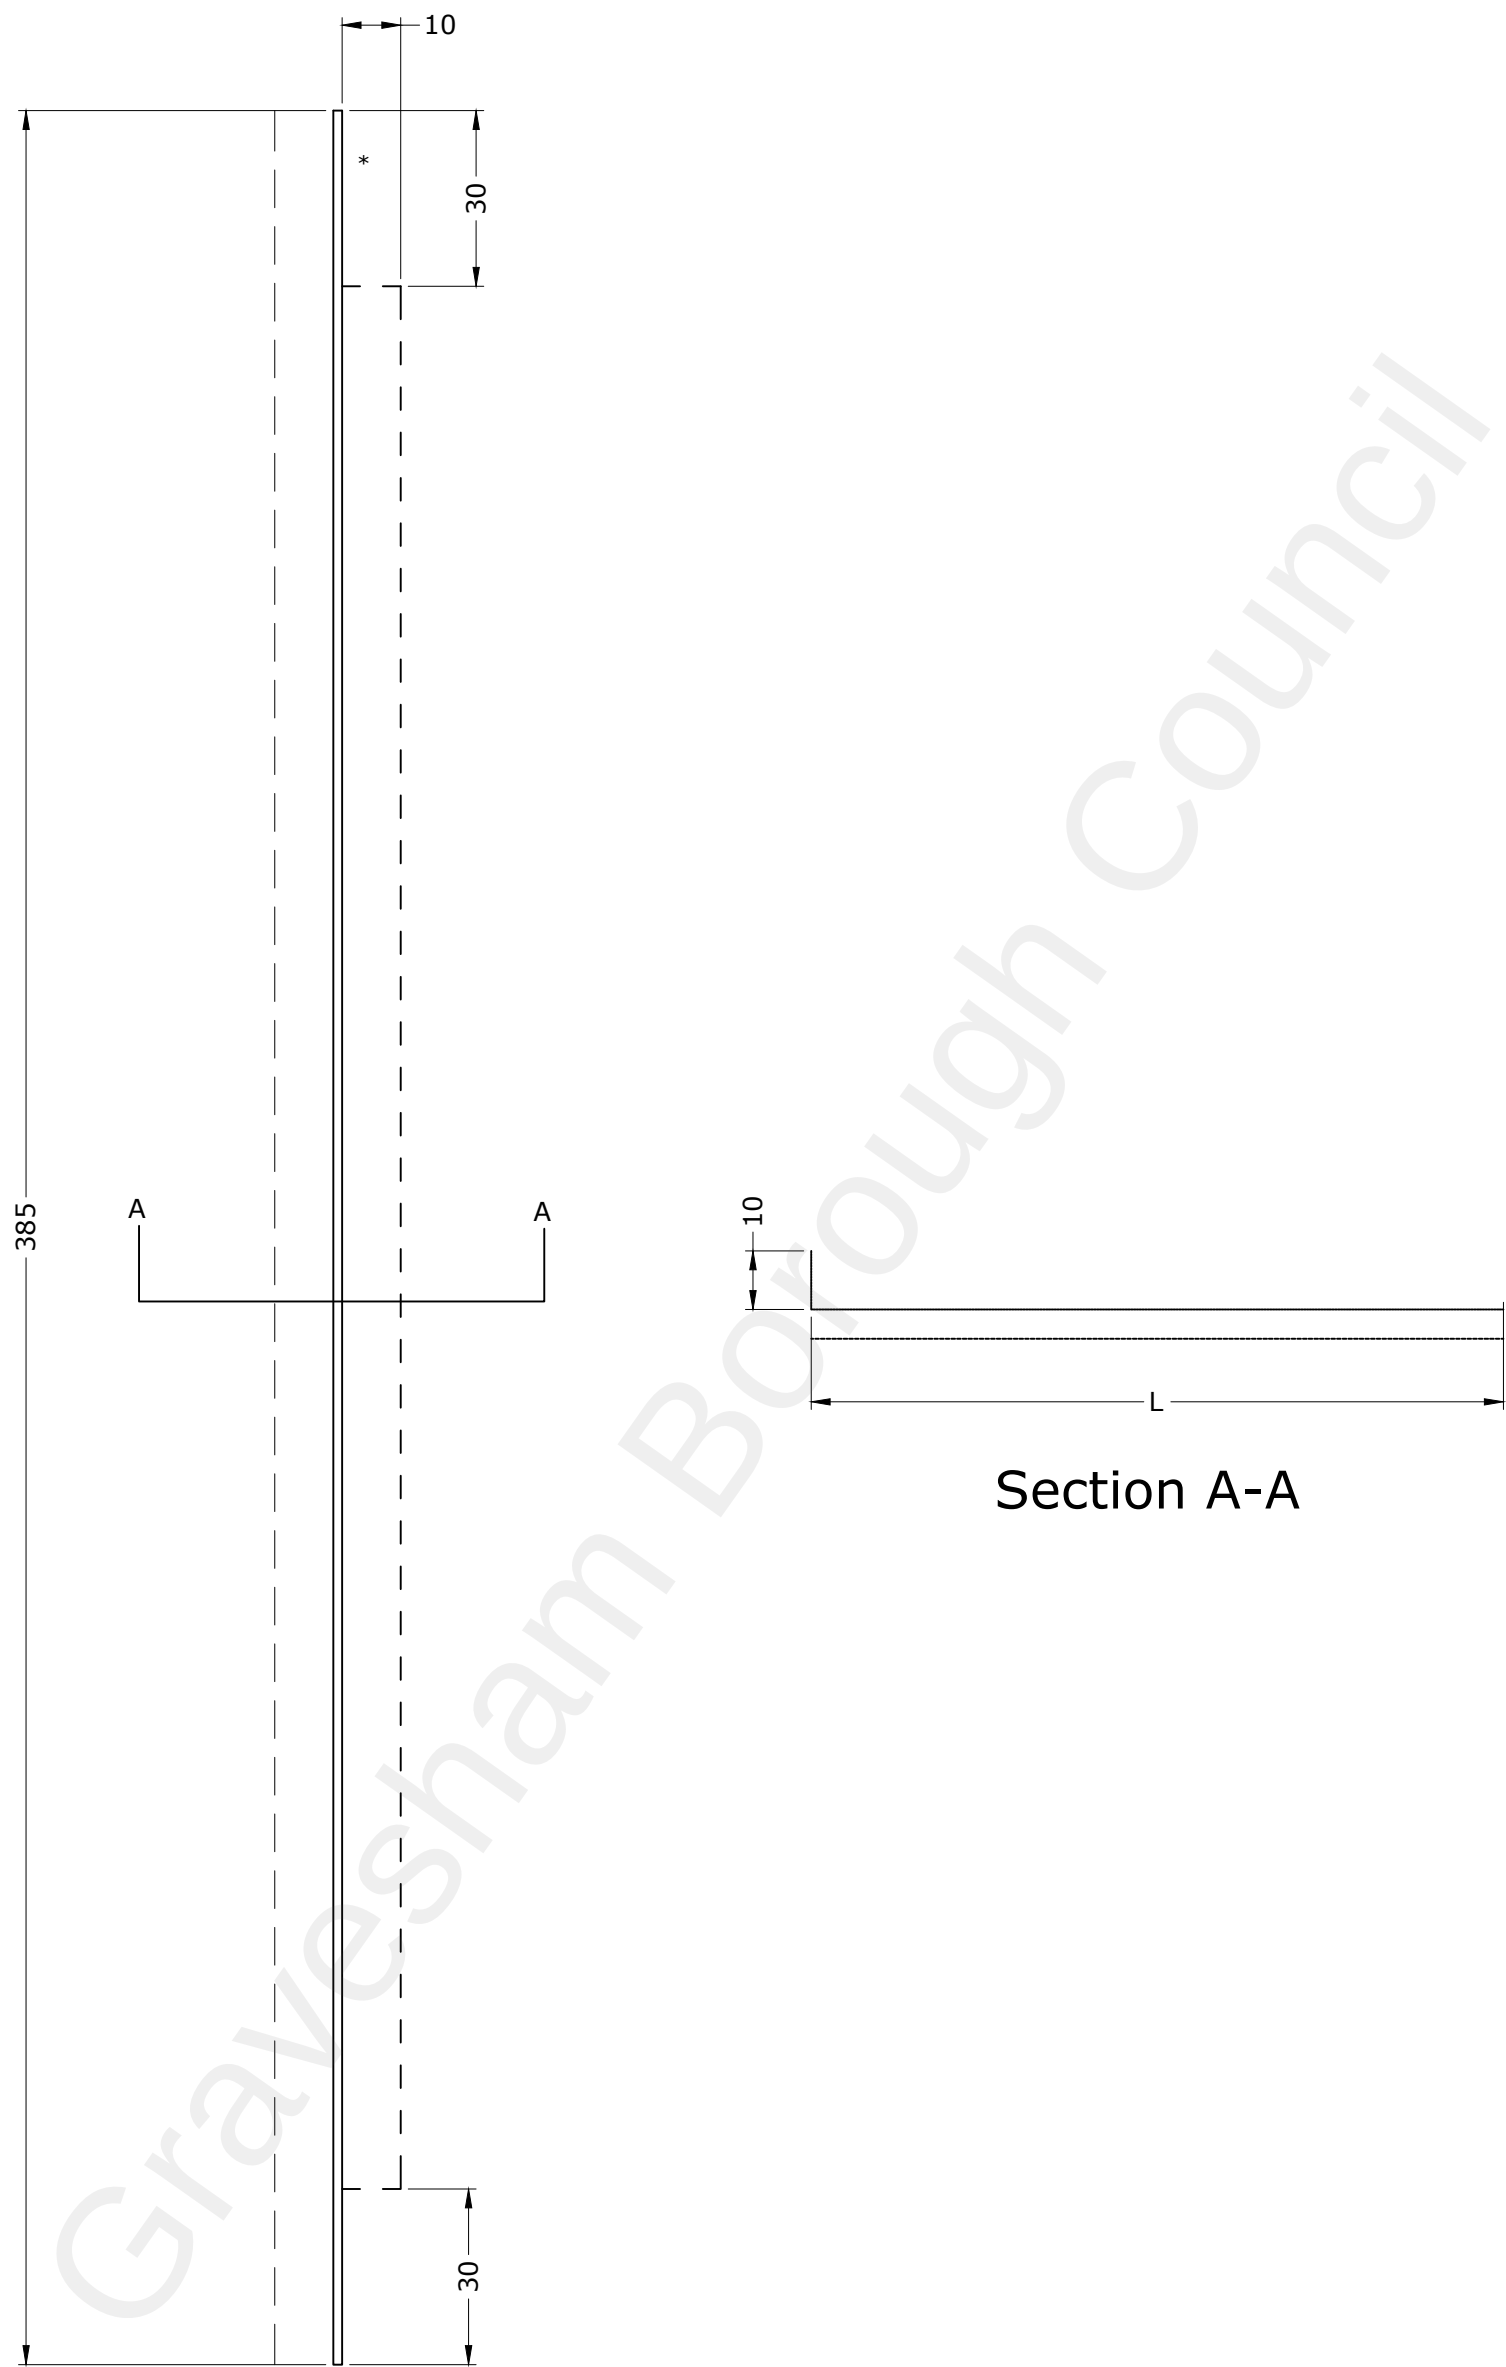

AS BUILT

Sunparadise system WD100 Light

Aluminium powder coated frame - RAL 7016 30% MATT
Balustrade section with 6.8mm clear laminated safety glass.
8mm clear toughened frameless sliding folding opening glass,
opening inwards through 90°.
1.5mm ppc aluminium pressings to the perimeter inside and
out, RAL 7016 30% MATT
Outward opening door 10mm clear toughened glass with

Date

Init.:

Unit:

mm

Design:

Jan'21

GRO

Scale:

Checked:

Order name:

St Patricks Garden
Gravesend
Kent

Subject:

External horizontal flashing

Date

Init.:

Unit:

mm

Design:

Jan'21

GRO

Scale:

Checked:

Order name:

St Patricks Garden
Gravesend
Kent

Subject:

External horizontal flashing

Date

Init.:

Unit:

mm

Design:

Jan'21

GRO

Scale:


Checked:

Order name:

St Patricks Garden
Graves

5 No. L=3000mm

* denotes position of hanging hole

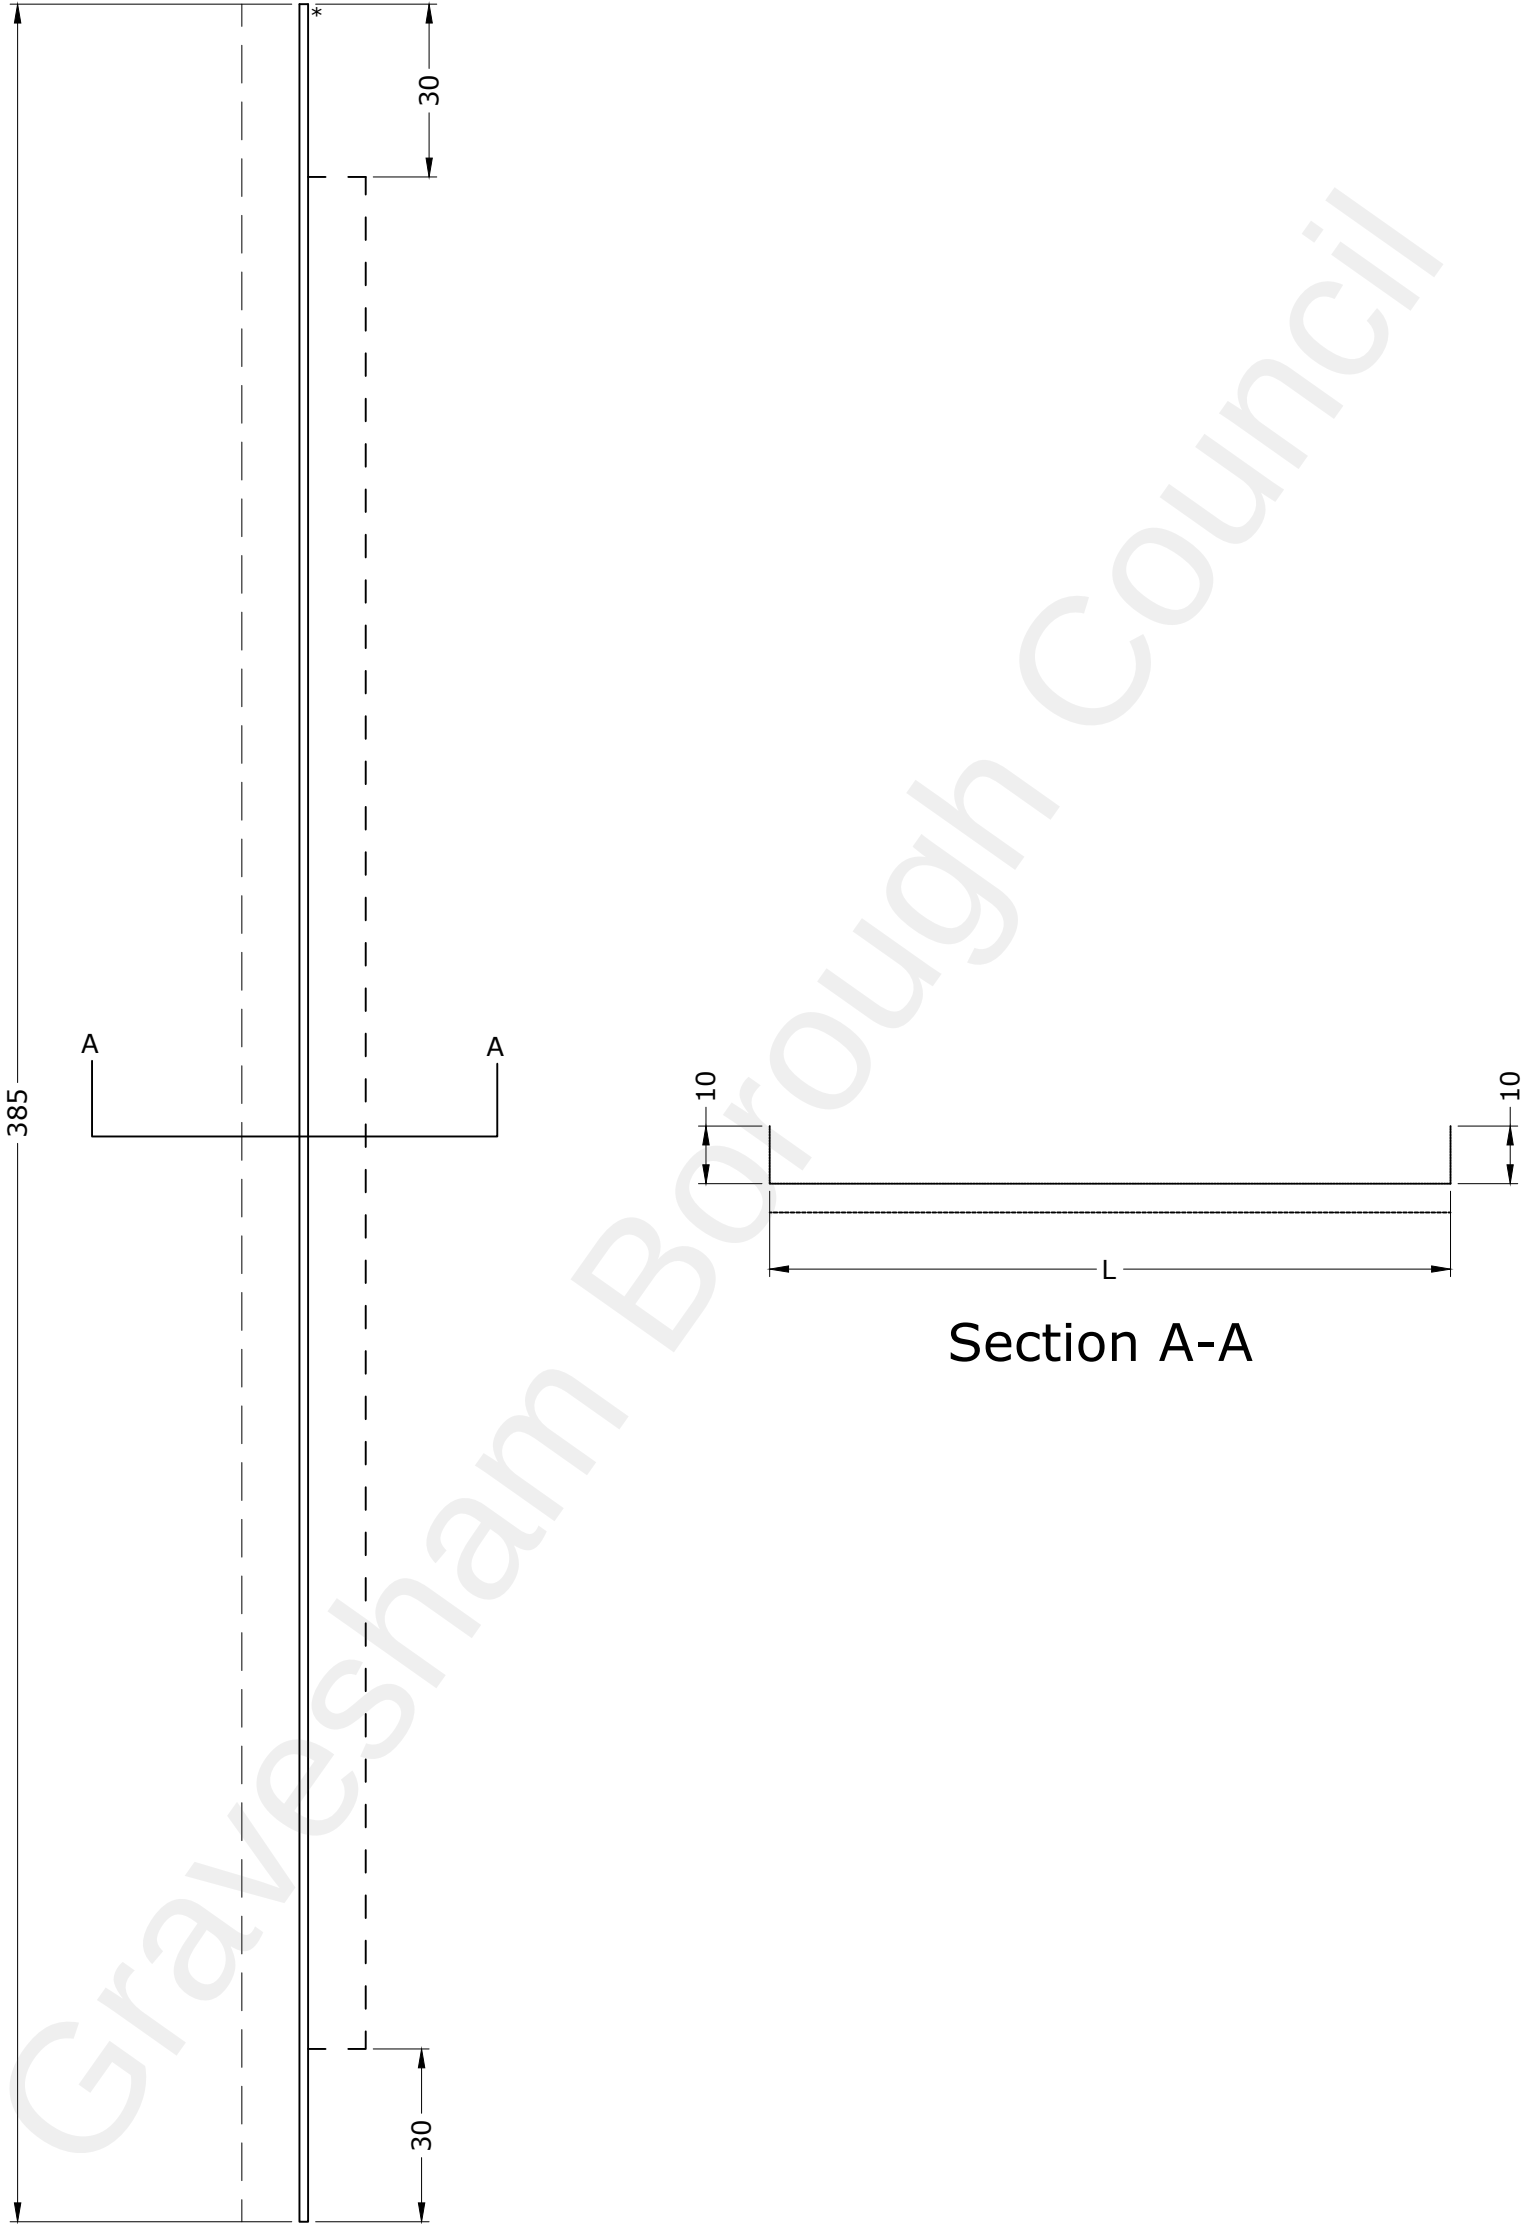

AS BUILT

Sunparadise system WD100 Light
Aluminium powder coated frame - RAL 7016 30% MATT
Balustrade section with 6.8mm clear laminated safety glass.
8mm clear toughened frameless sliding folding opening glass,
opening inwards through 90°.
1.5mm ppc aluminium pressings to the perimeter inside and
out, RAL 7016 30% MATT
Outward opening door 10mm clear toughened glass with


sunparadise

Sunparadise Systems Limited
12 Newmarket Business Centre
341 Exning Road, Newmarket,
SUFFOLK CB8 0AT

	Date	Init.:	Unit:	mm	Rev.	Description	Date	Init.:
Design:	Jan'21	GRO	Scale:		A	System description & colour added	02/02/21	GRO
Checked:					B			
Order name:	St Patricks Garden Gravesend Kent				C			
					D			
Subject:	External horizontal flashing				Business Opp: St Patricks Project ID: 1006-01			

3 No. L=1520mm

* denotes position of hanging hole

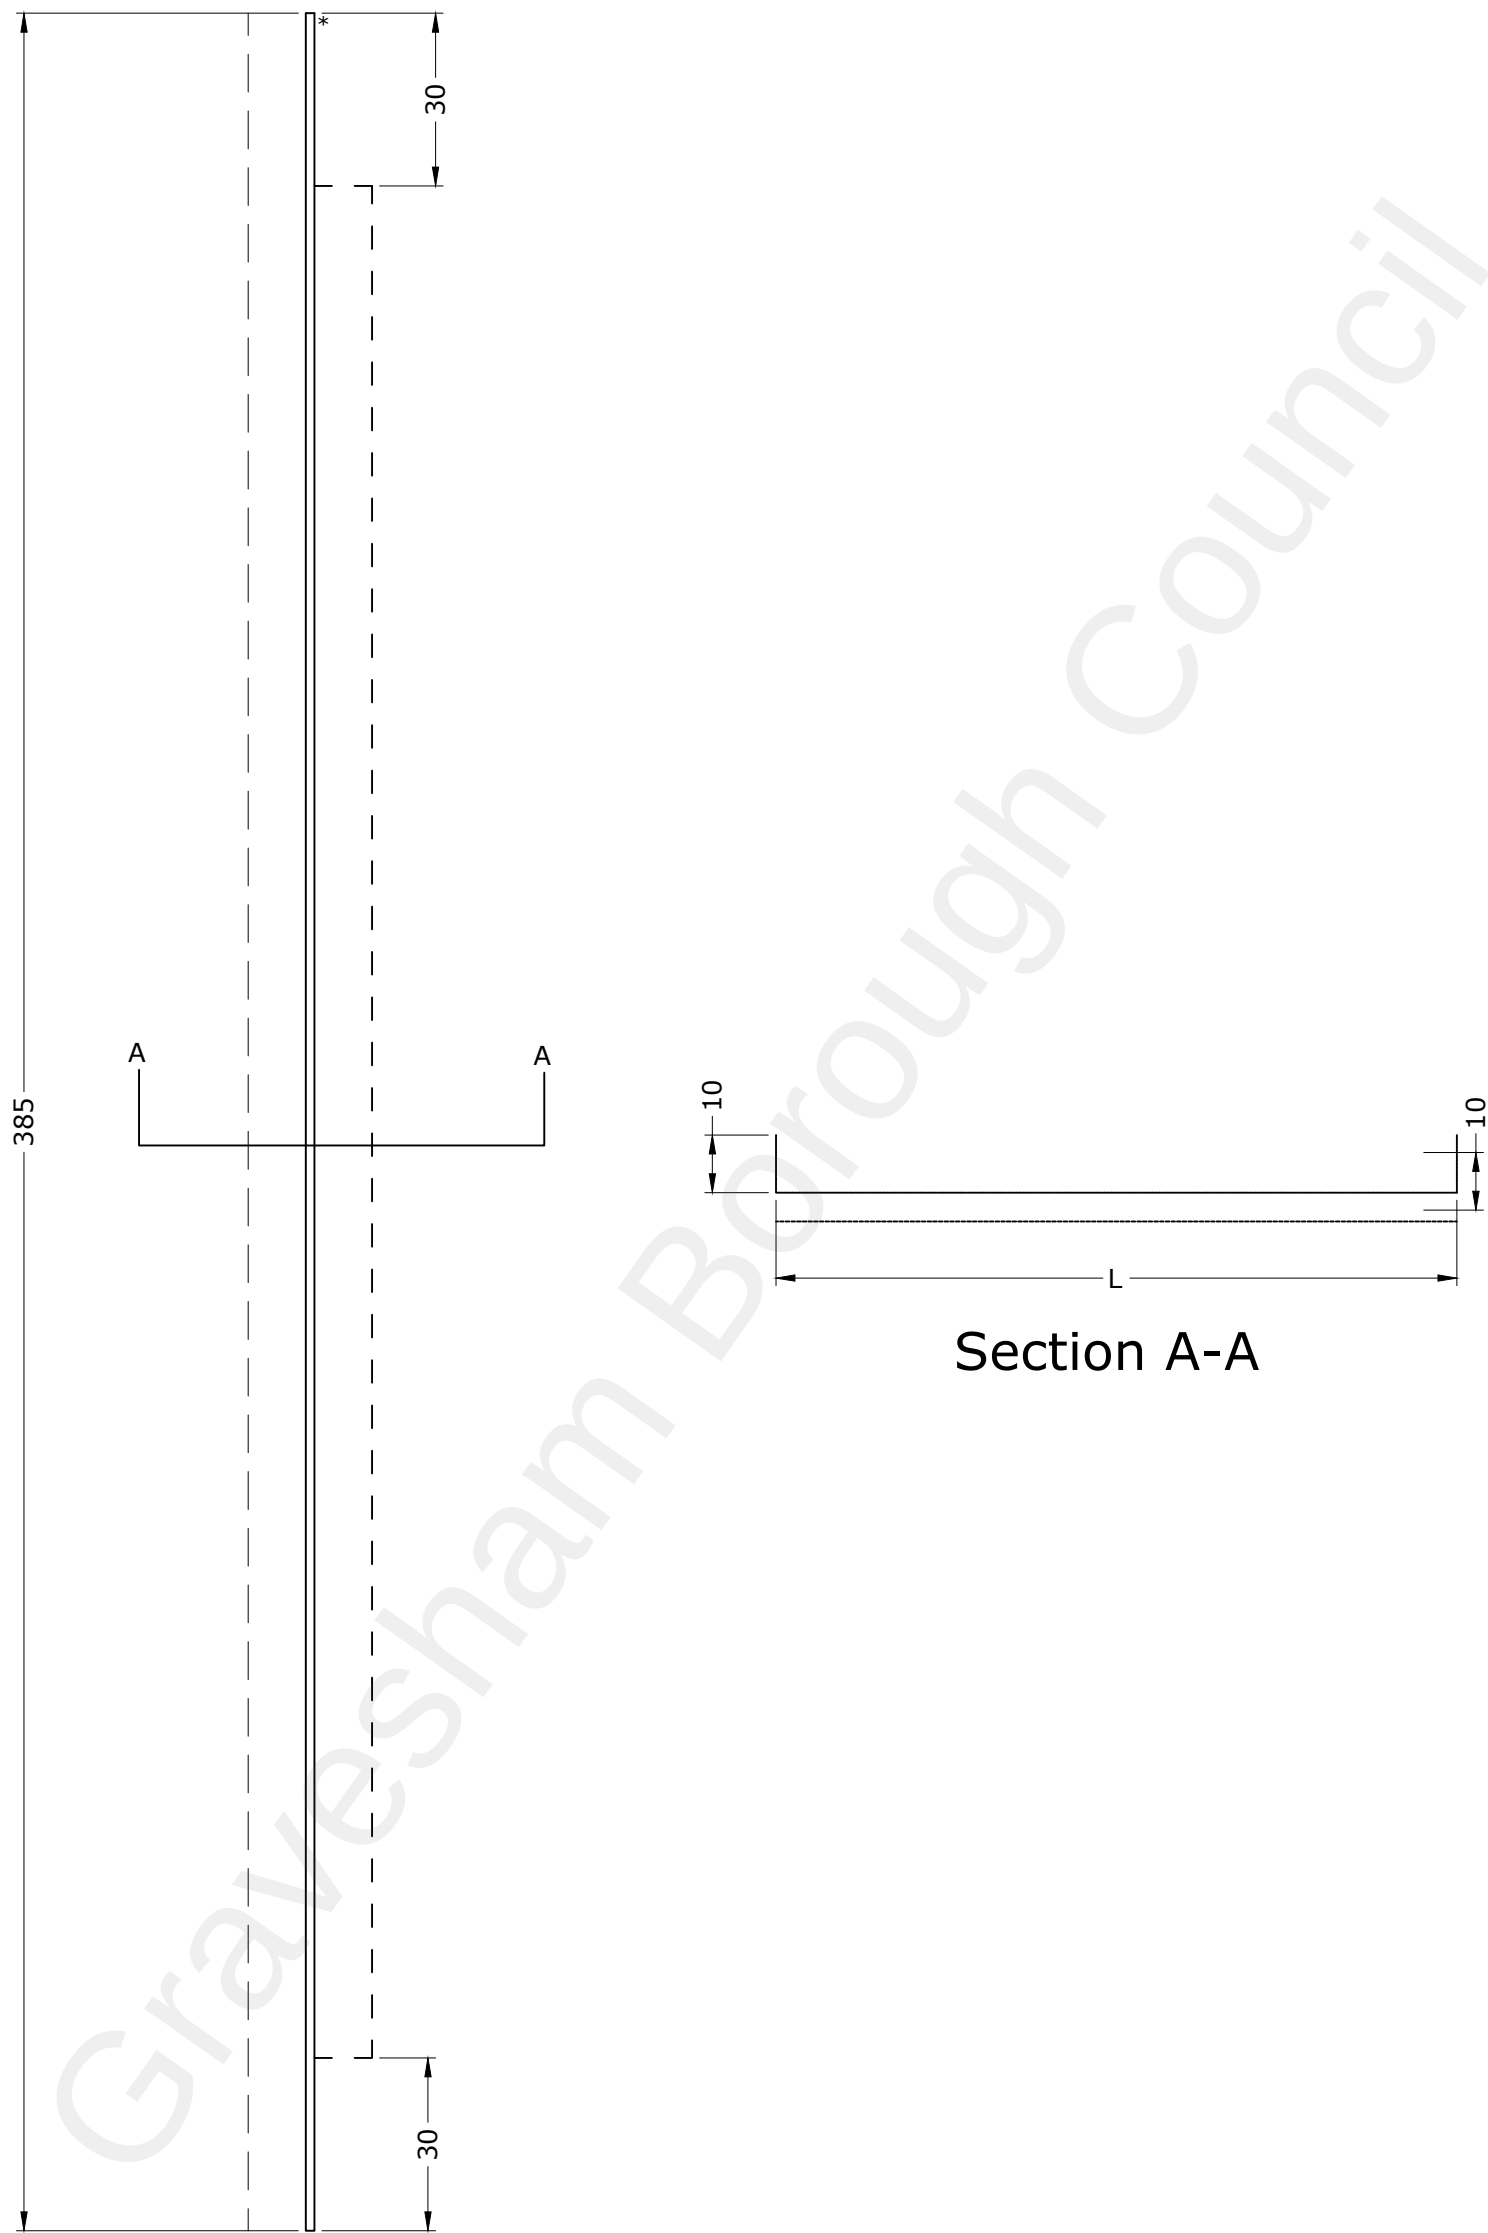

AS BUILT


Sunparadise system WD100 Light
Aluminium powder coated frame - RAL 7016 30% MATT
Balustrade section with 6.8mm clear laminated safety glass.
8mm clear toughened frameless sliding folding opening glass,
opening inwards through 90°.
1.5mm ppc aluminium pressings to the perimeter inside and
out, RAL 7016 30% MATT
Outward opening door 10mm clear toughened glass with

sunparadise

Sunparadise Systems Limited
12 Newmarket Business Centre
341 Exning Road, Newmarket,
SUFFOLK CB8 0AT

	Date	Init.:	Unit:	mm	Rev.	Description	Date	Init.:
Design:	Jan'21	GRO	Scale:		A	System description & colour added	02/02/21	GRO
Checked:					B			
Order name:	St Patricks Garden Gravesend Kent				C			
					D			
Subject:	External horizontal flashing				Business Opp: St Patricks Project ID: 1006-01			

ppc surface
* denotes position of hanging hole

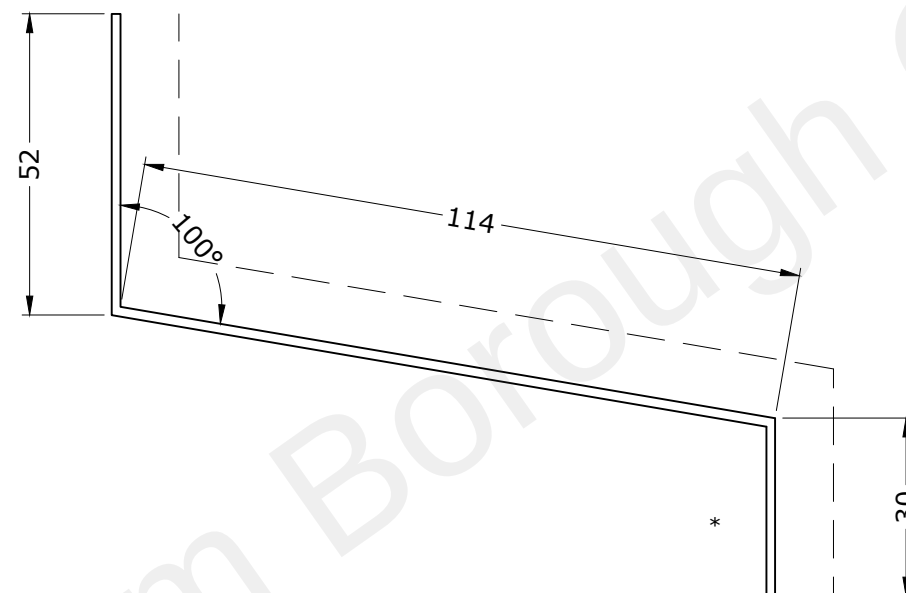



Aluminium powder coated frame - RAL 7016 30% MATT
Balustrade section with 6.8mm clear laminated safety glass.
8mm clear toughened frameless sliding folding opening glass,
opening inwards through 90°.
1.5mm ppc aluminium pressings to the perimeter inside and
out, RAL 7016 30% MATT
Outward opening door 10mm clear toughened glass with
manifestation (to be agreed), stainless steel handle.
6mm clear laminated glass fanlight.

sunparadise

Sunparadise Systems Limited
12 Newmarket Business Centre
341 Exning Road, Newmarket,
SUFFOLK CB8 0AT
Phone: 0870 067 88
www.sunparadise.com

	Date	Init.:	Unit: mm	Rev.	Description	Date	Init.:
Design:	Jan'21	GRO	Scale:	A	System description & colour added	02/02/21	GRO
Checked:				B			
Order name:	St Patricks Garden Gravesend KENT			C			
				D			
				Business Opp: St Patricks Project ID: 1006-01 Drawing No.: 327			
Subject:	Cill flashing - Inside 714						

Technical drawing of a U-shaped profile. The overall height is 325. The distance from the top edge to the centerline of the vertical leg is 175. The distance from the centerline of the vertical leg to the top edge of the horizontal flange is 150. The width of the horizontal flange is 66. The thickness of the horizontal flange is 8.

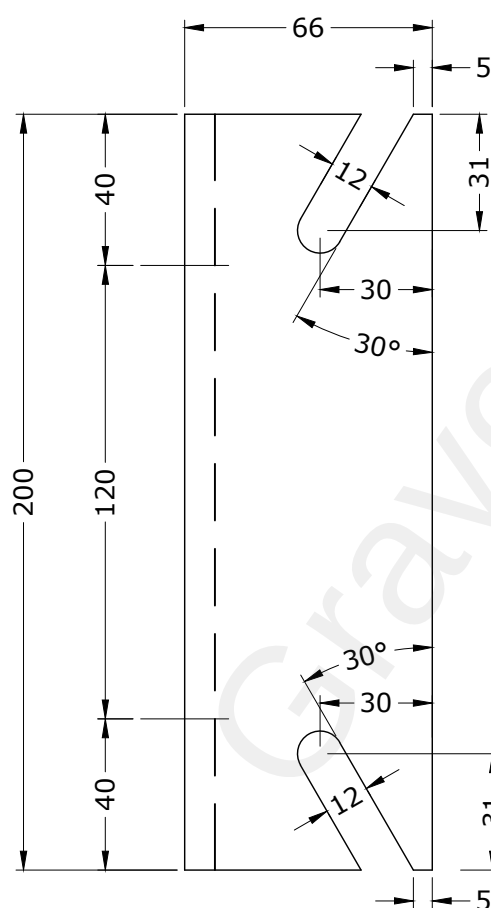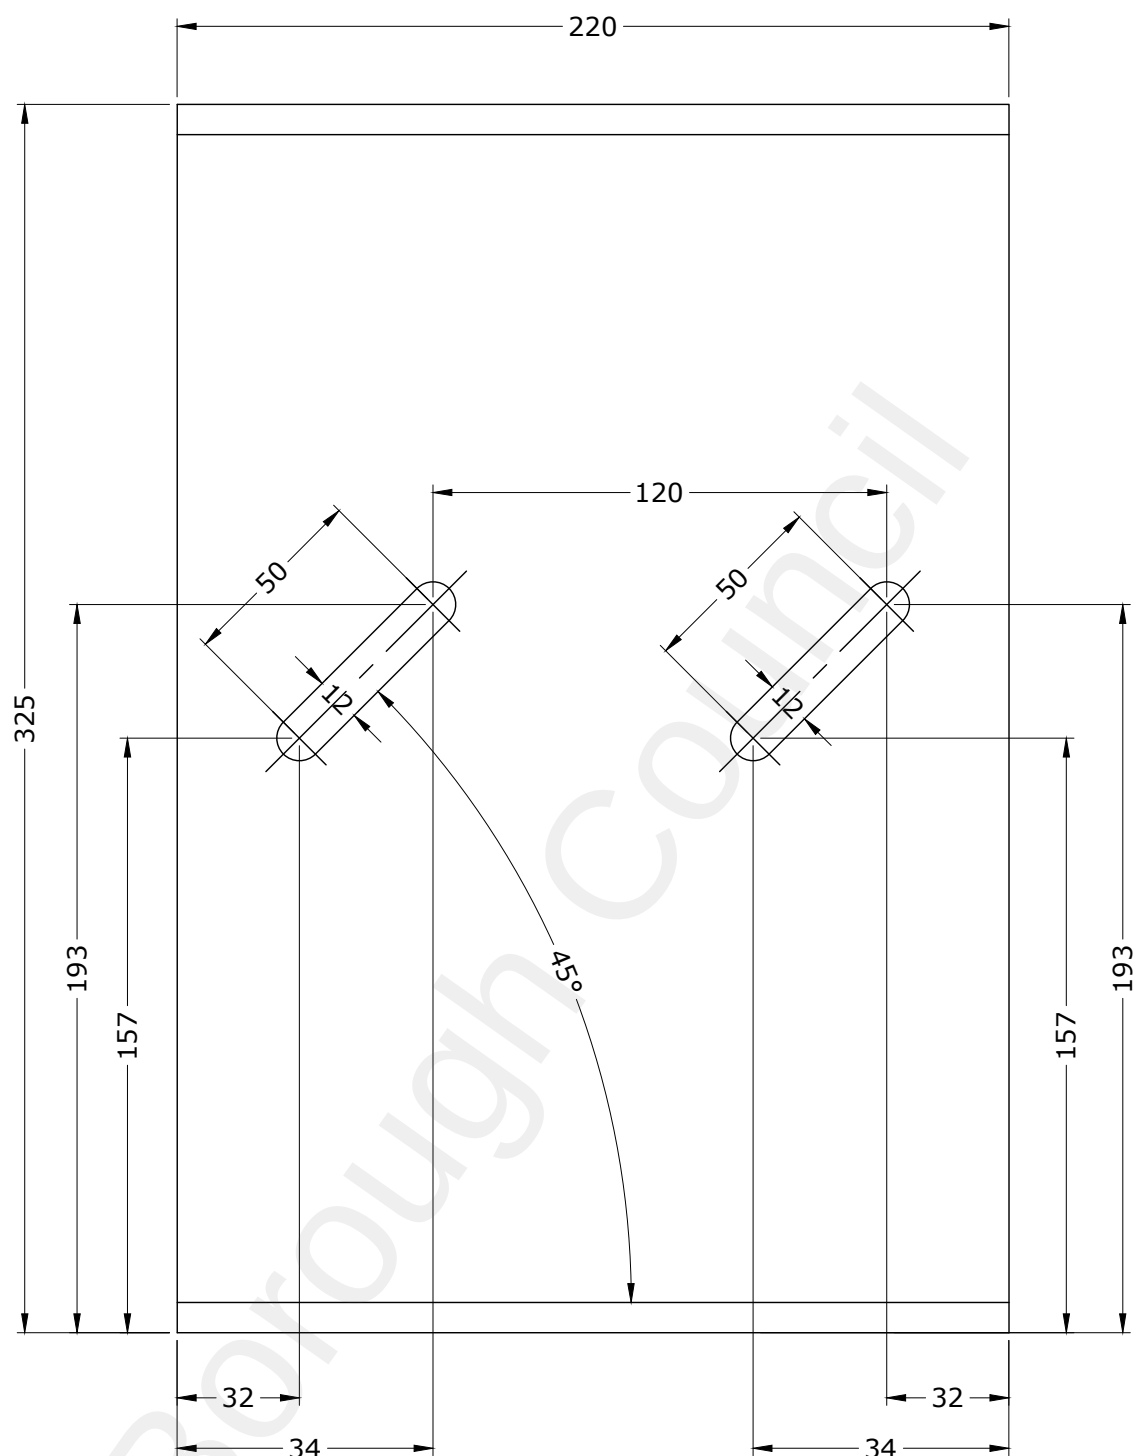

sunparadise


	Date	Init.:	Unit: mm
Design:	Dec'20	GRO	Scale: 1:2
Checked:			

Subject: Giving bracket to

Rev.	Description	Date	Init.:
A			
B			
C			
D			

Business Opp:	St Patricks
Project ID:	1006-01




All manufacturing to be performed according to EN 1090-2

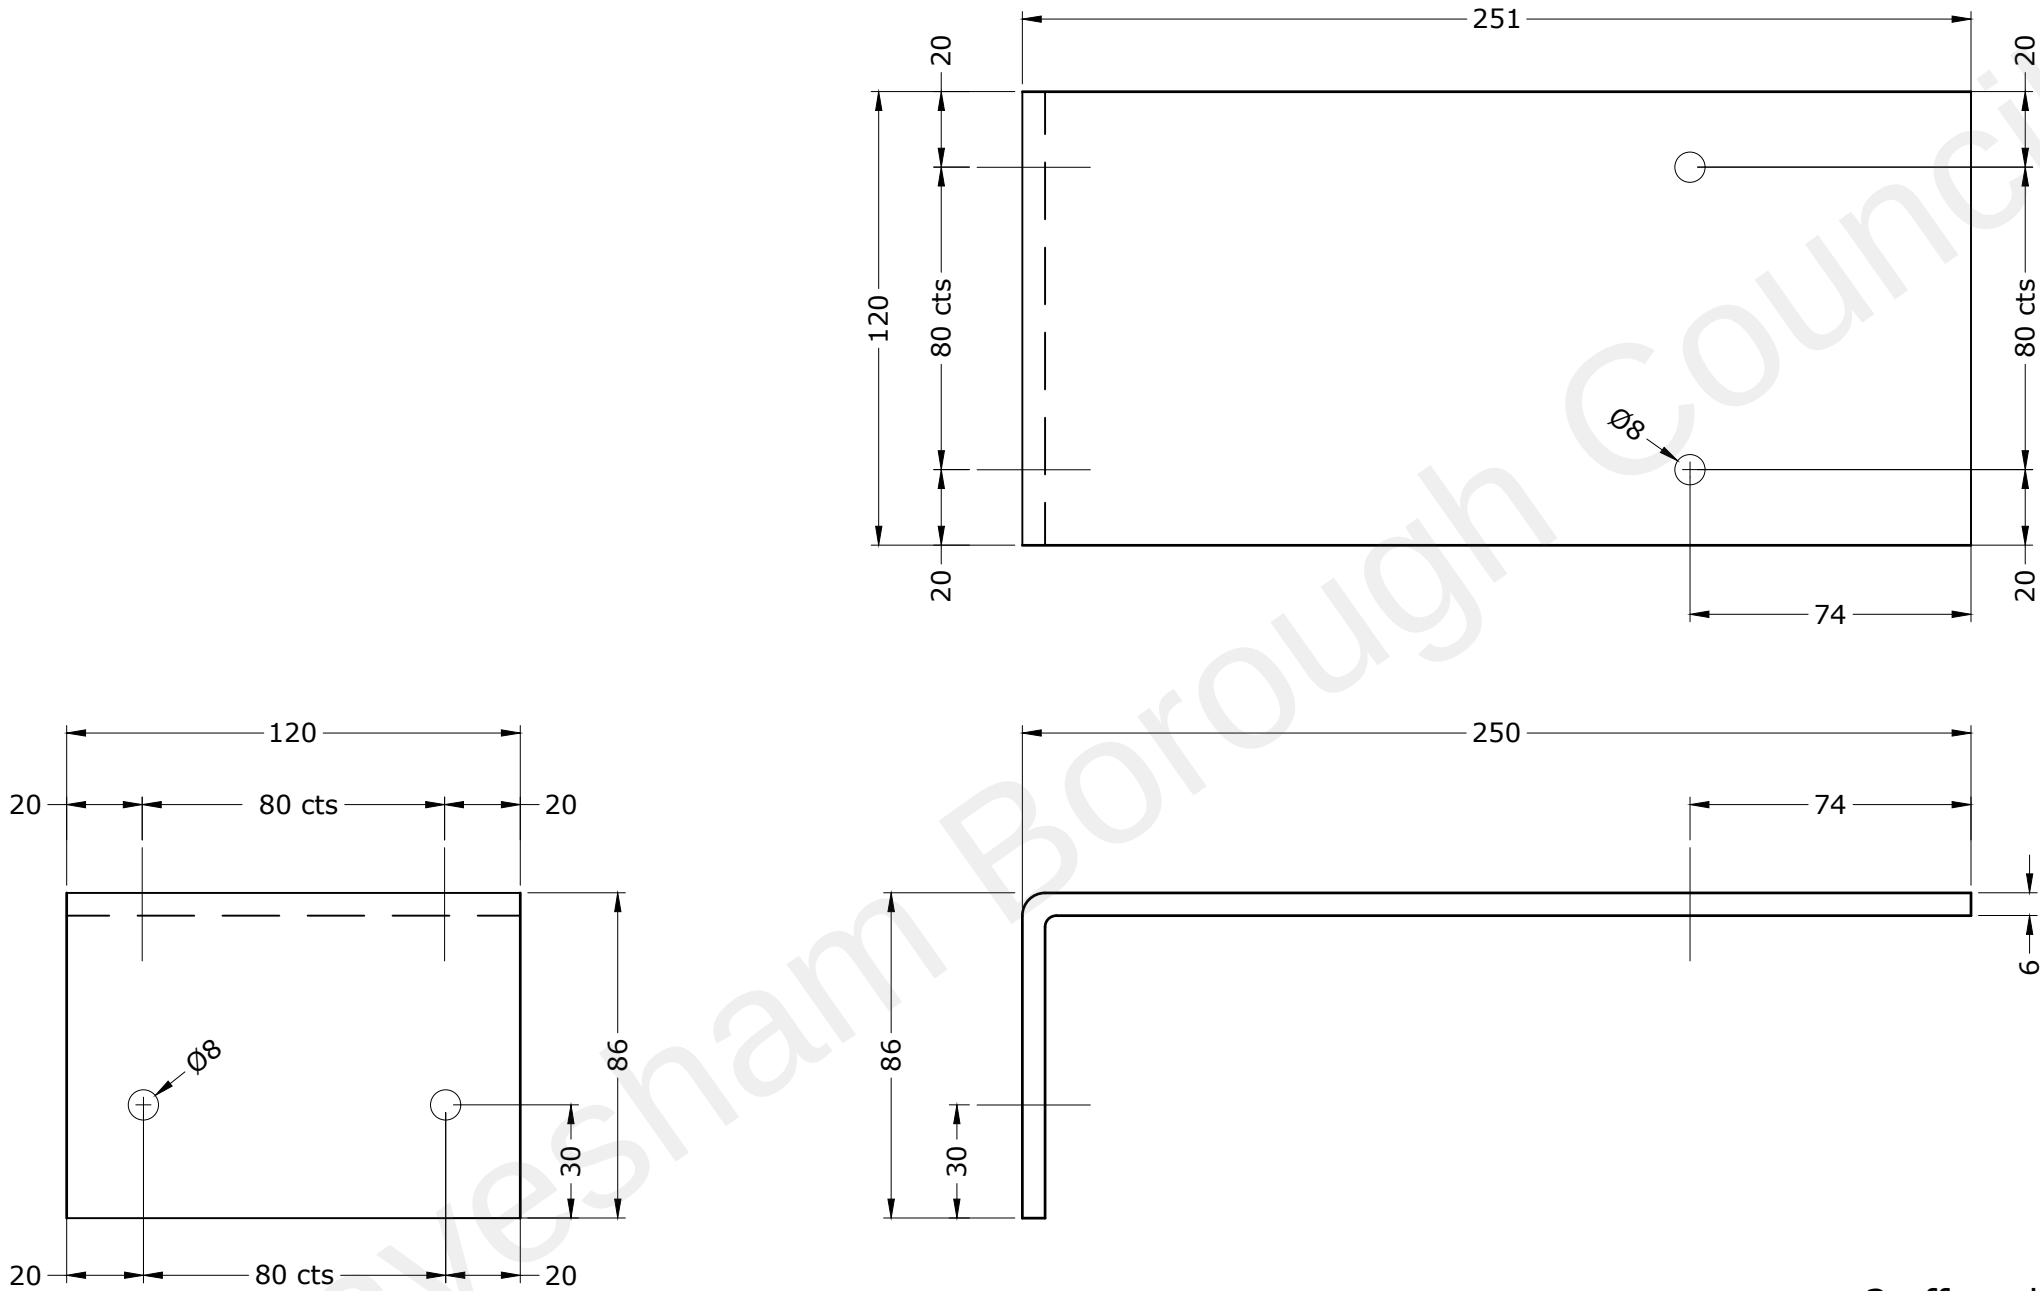

3 off as drawn
S275 hot dip galvanised finish
6mm thick folded angle
86mm x 250mm
120mm long
4 No. 8Ø

 Sunparadise Systems Limited 12 Newmarket Business Centre 341 Exning Road, Newmarket, SUFFOLK CB8 0AT Phone: 0870 067 88 www.sunparadise.com		Date	Init.:	Unit:	mm	Rev.	Description	Date	Init.:
	Design:	Dec'20	JCB	Scale:		A			
	Checked:					B			
	Order name:	St Patricks Garden Gravesend KENT				C			
						D			
Subject:	Head bracket 1				Business Opp: St Patricks Project ID: 1006-01 Drawing No.: 452				




All manufacturing to be performed according to EN 1090-2

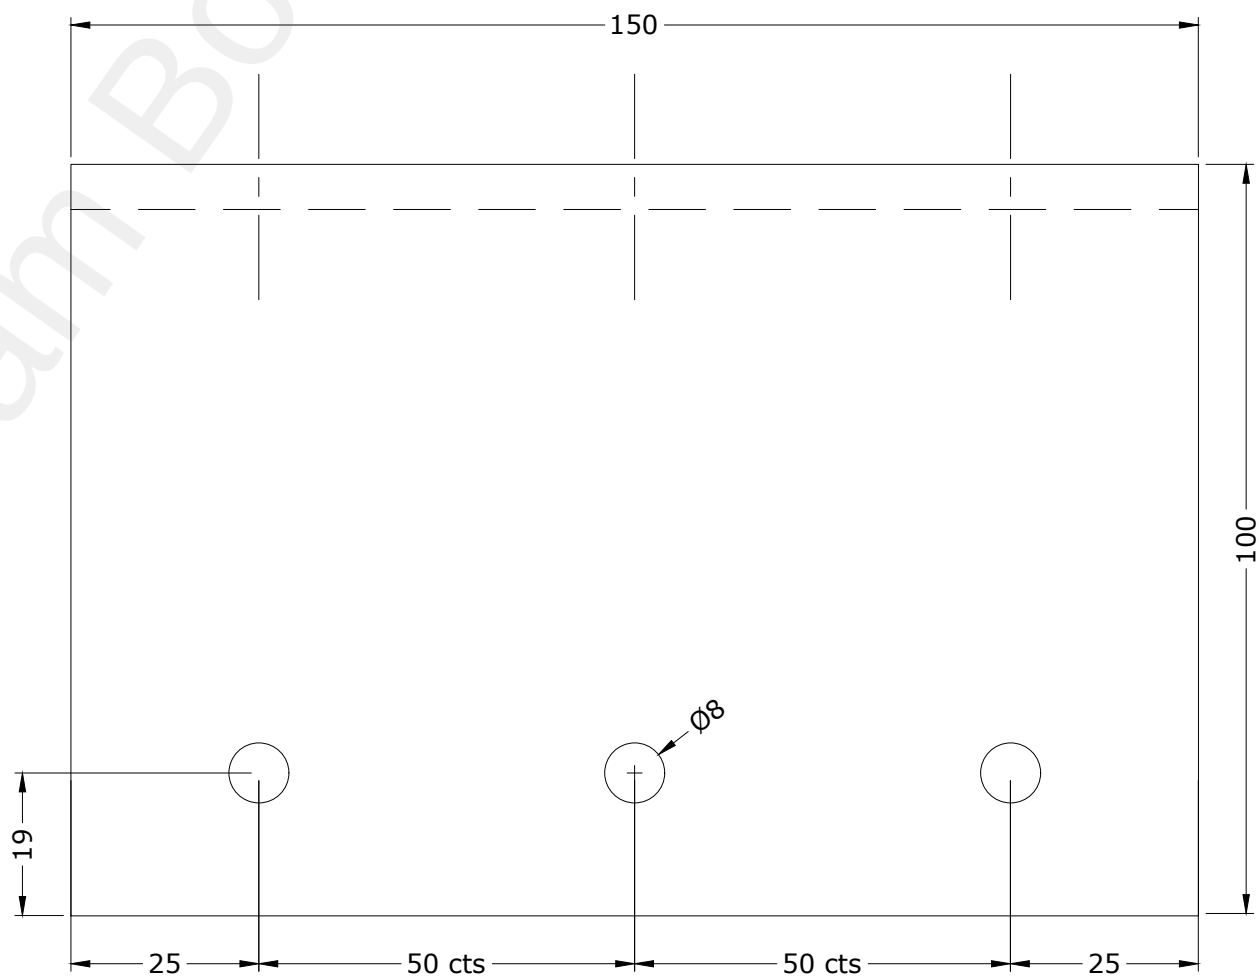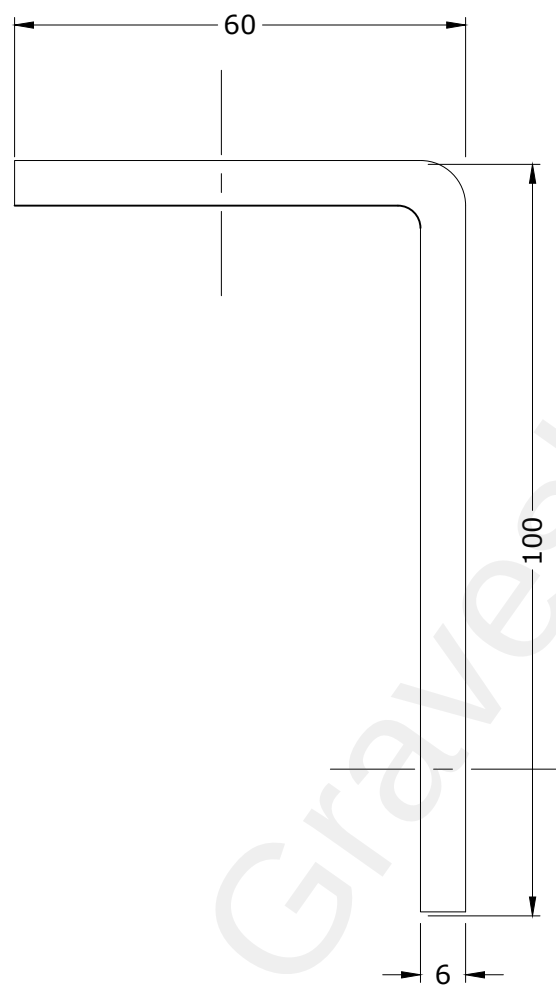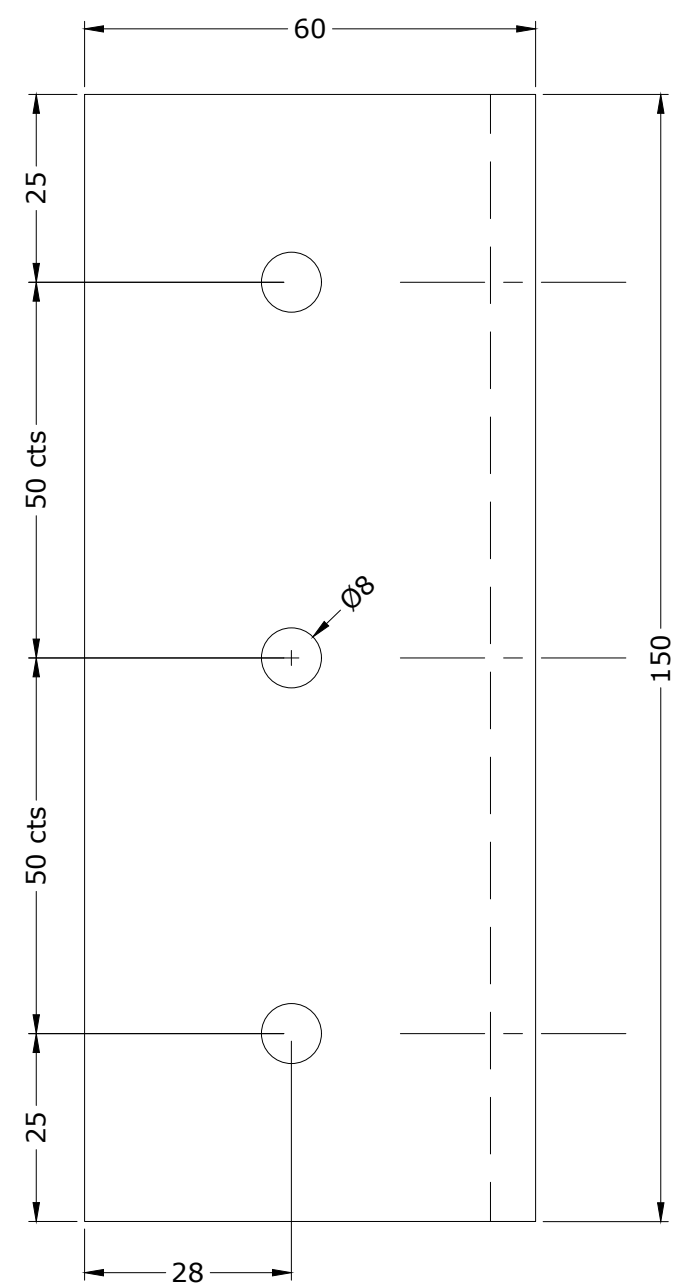

28 off as drawn
S275 hot dip galvanised finish
6mm thick folded angle
100mm x 60mm x 150mm

Sunparadise Systems Limited 12 Newmarket Business Centre 341 Exning Road, Newmarket, SUFFOLK CB8 0AT	Design: Dec'20 Checked: Order name: St Patricks Garden Gravesend KENT Subject: Head bracket 2				Rev. Description A B C D Business Opp: St Patricks Project ID: 1006-01			
	Date: Dec'20 Init.: GRO Unit: mm Scale: 1:2				Date: Init.:			
	Order name: St Patricks Garden Gravesend KENT Subject: Head bracket 2				Date: Init.:			
	Date: Dec'20 Init.: GRO Unit: mm Scale: 1:2				Date: Init.:			




All manufacturing to be performed according to EN 1090-2

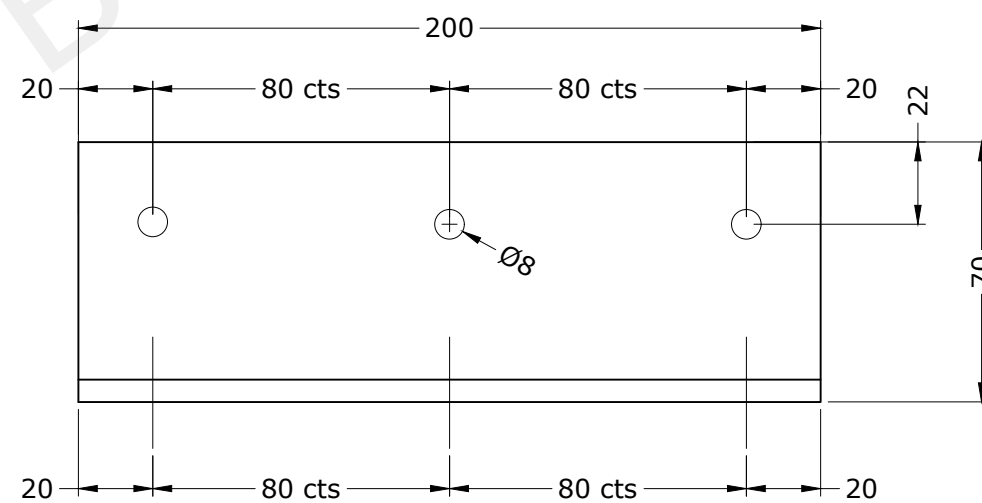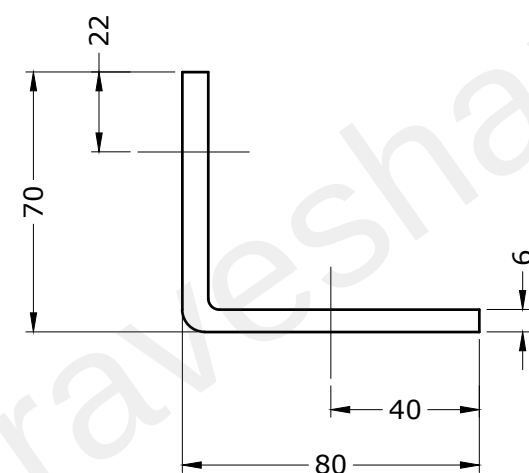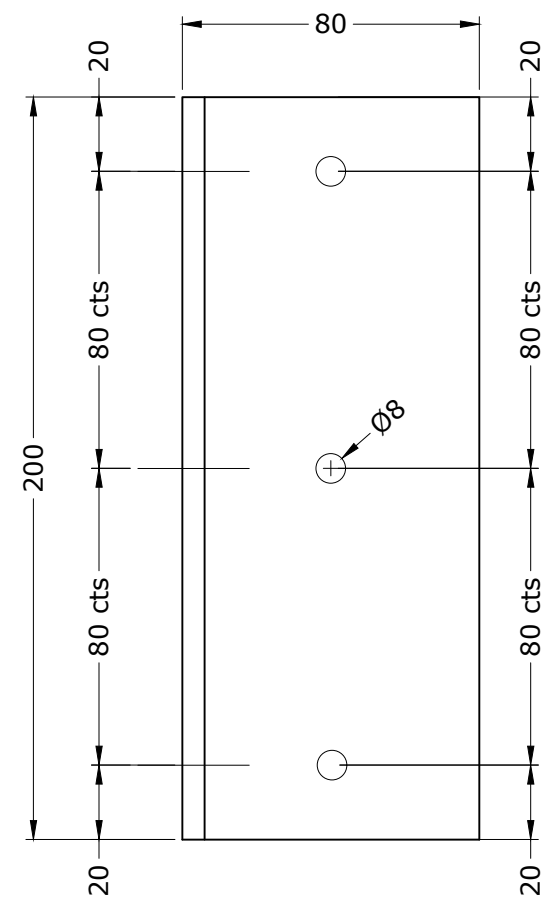

16 off as drawn
S275 hot dip galvanised finish
6mm thick folded angle
70mm x 80mm x 200mm

 Sunparadise Systems Limited 12 Newmarket Business Centre 341 Exning Road, Newmarket, SUFFOLK CB8 0AT Phone: 0870 067 88 www.sunparadise.com		Date	Init.:	Unit:	mm	Rev.	Description	Date	Init.:
	Design:	Dec'20	JCB	Scale:		A			
	Checked:					B			
	Order name:	St Patricks Garden Gravesend KENT				C			
						D			
Subject:	Cill bracket				Business Opp: St Patricks Project ID: 1006-01 Drawing No.: 454				


All manufacturing to be performed according to EN 1090-2

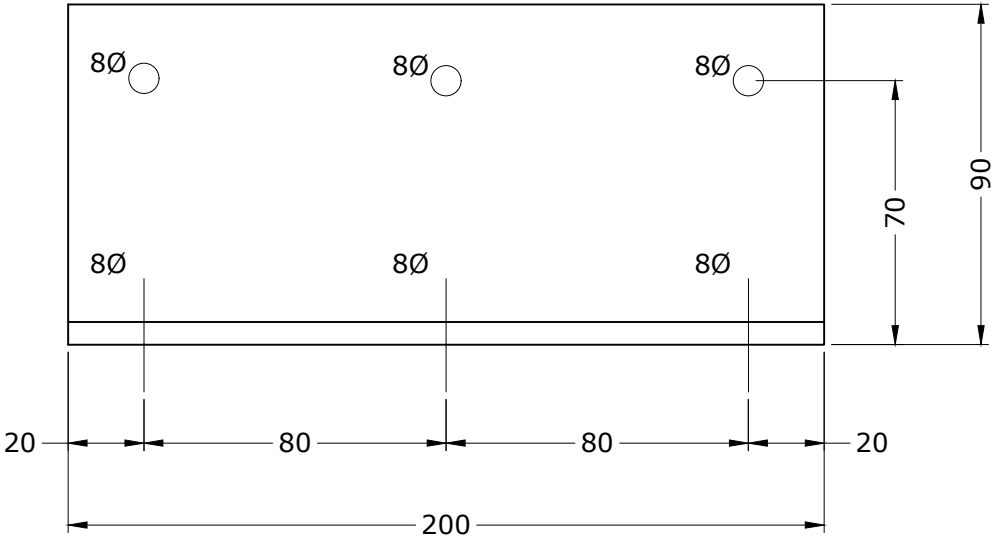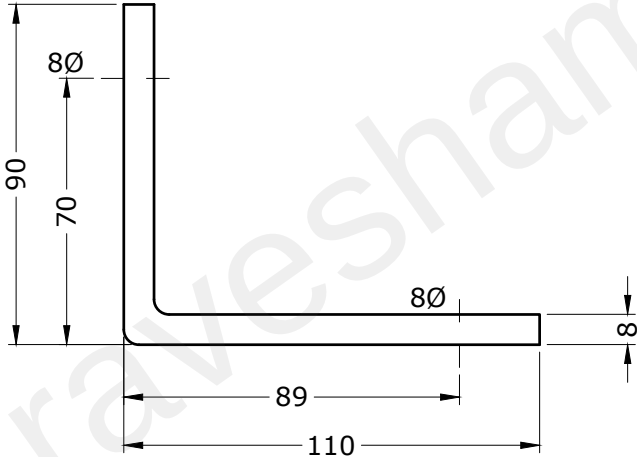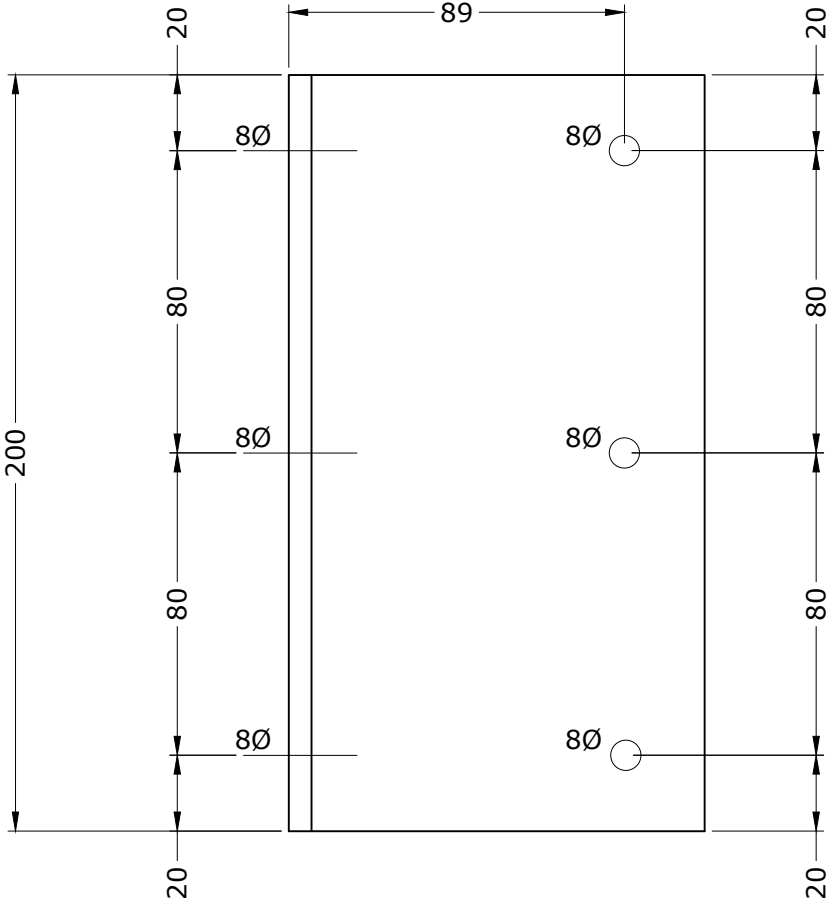

3 off as drawn
S275 hot dip galvanised finish
6mm thick folded angle
90mm x 110mm x 200mm

 Sunparadise Systems Limited 12 Newmarket Business Centre 341 Exning Road, Newmarket, SUFFOLK CB8 0AT Phone: 0870 067 88 www.sunparadise.com		Date	Init.:	Unit: mm	Rev.	Description	Date	Init.:
	Design:	Jan'21	JCB	Scale:	A			
	Checked:				B			
	Order name:	St Patricks Garden Gravesend KENT			C			
					D			
					Business Opp: St Patricks Project ID: 1006-01 Drawing No.: 455			
Subject:	Cill bracket 719							

No. of panel: 2	Opening side (seen from inside) Left ☒ Right ☐	Panel type:			Panel mounted in Yes ☐ No ☒	Setelement: Packaging: Assembled ☒ Knock-down ☐
		<u>Light</u> 6 mm hard. ☐ 8 mm hard. ☒ 10 mm hard. ☐	<u>Silhuett</u> 6 mm float ☐ 6 mm hard. ☐	<u>Shadow</u> 20 mm insu. ☐		

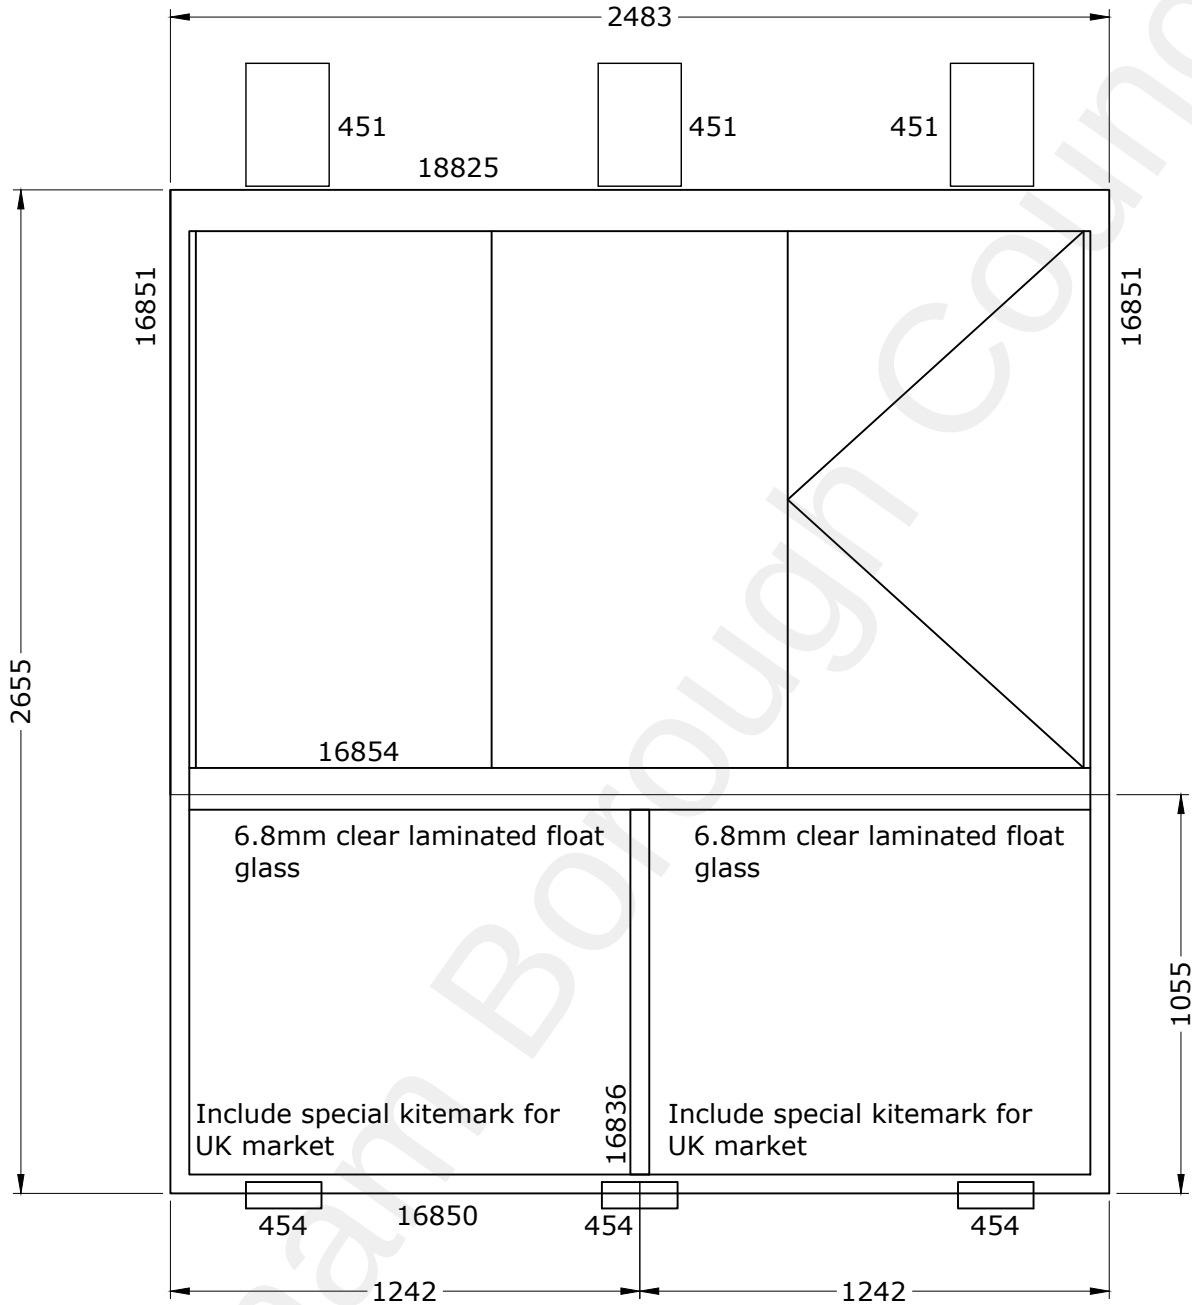


Element seen from outside

Description: (UK)	Colour	Add. info
Profiles, element:	RAL 7016, GI.30	
Profiles, hatches:	RAL 7016, GI.30	
Glazing profiles:	RAL 7016, GI.30	Indv./internal
Alveolit:	Black	10x12 mm on all 4 sides

AS BUILT

 Sunparadise Systems Limited 12 Newmarket Business Centre 341 Exning Road, Newmarket, SUFFOLK CB8 0AT Phone: 0870 067 88 www.sunparadise.com	Design:	Date	Init.:	Unit:	Rev.	Description	Date	Init.:
	Checked:	Dec'20	JCB	Scale:	A			
	Order name:	St Patricks Garden Gravesend KENT			B			
	Subject:	Element 702			C			
					D			
					Business Opp: St Patricks Project ID: 1006-01 Drawing No.: 702			

No. of panel: 4	Opening side (seen from inside) Left ☒ Right ☐	Panel type: Light 6 mm hard. ☐ 8 mm hard. ☒ 10 mm hard. ☐ Silhuett 6 mm float ☐ 6 mm hard. ☐ Shadow 20 mm insu. ☐			Panel mounted in Yes ☐ No ☒	Setelement: Packaging: Assembled ☒ Knock-down ☐
------------------------	--	--	--	--	--	---

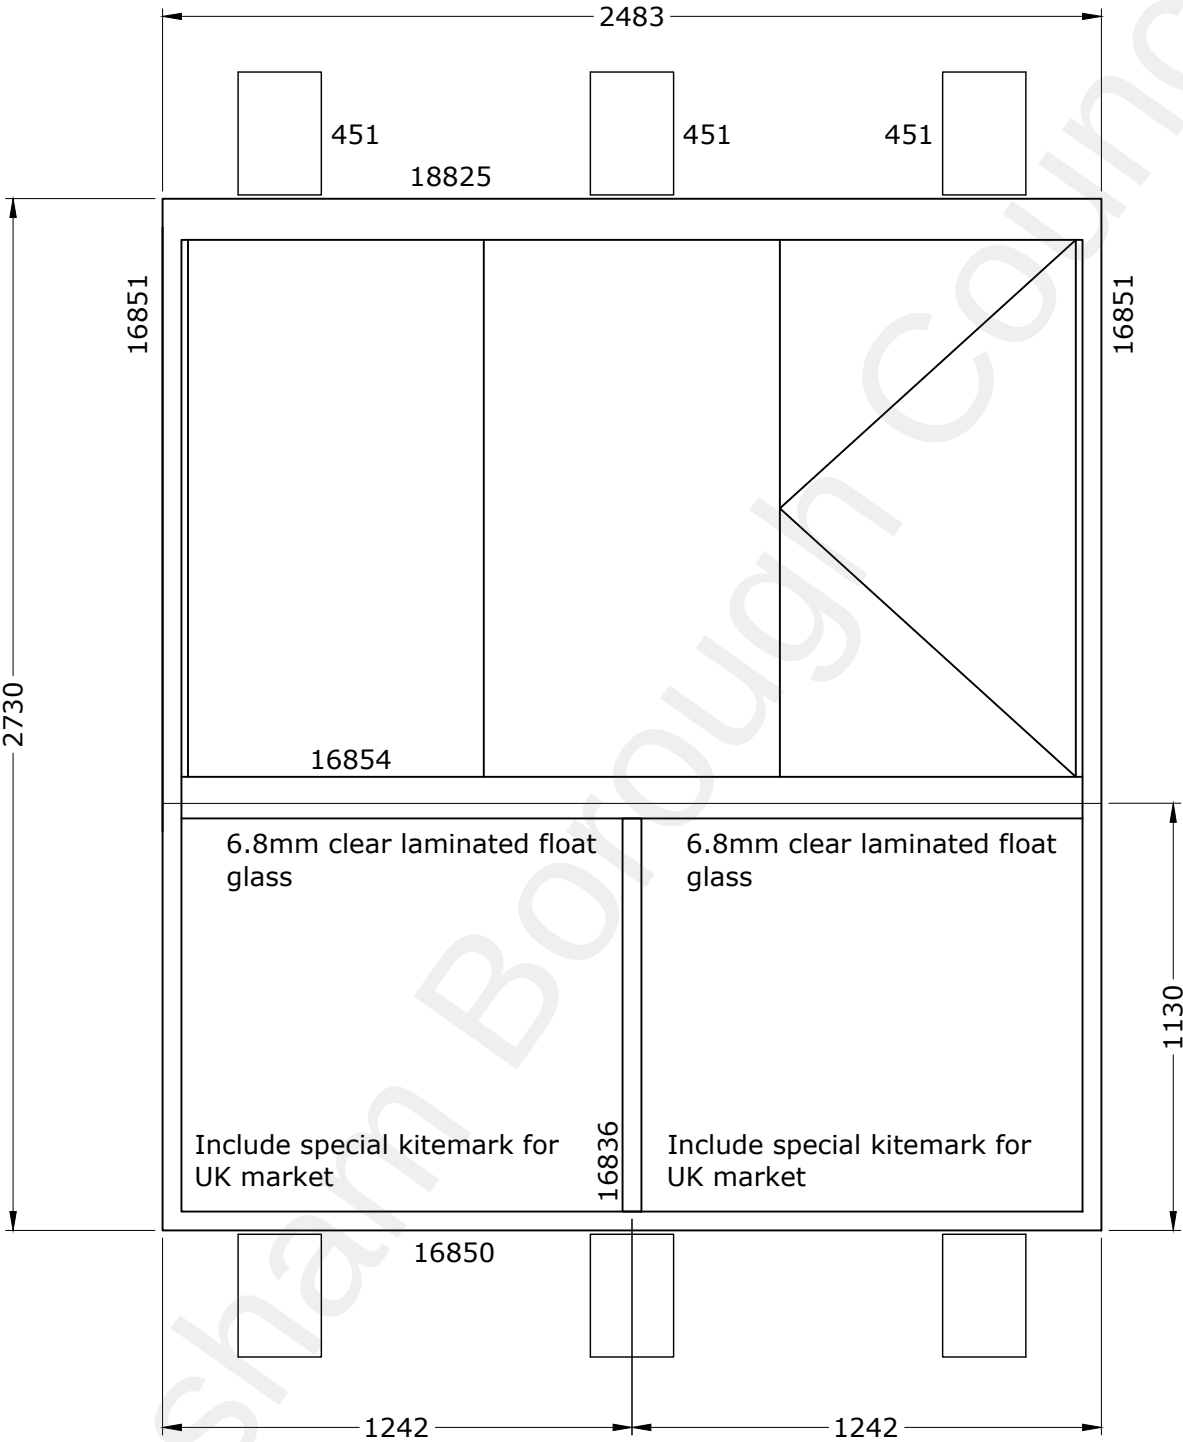


Element seen from outside

Description: (UK)	Colour	Add. info
Profiles, element:	RAL 7016, Gl.30	
Profiles, hatches:	RAL 7016, Gl.30	
Glazing profiles:	RAL 7016, Gl.30	Indv./internal
Alveolit:	Black	10x12 mm on all 4 sides

AS BUILT

 Sunparadise Systems Limited 12 Newmarket Business Centre 341 Exning Road, Newmarket, SUFFOLK CB8 0AT Phone: 0870 067 88 www.sunparadise.com	Design:	Date	Init.:	Unit:	Rev.	Description	Date	Init.:
	Checked:	Dec'20	JCB	Scale:	A			
	Order name:				B			
	Subject: Element 704				C			
				D				
				Business Opp: St Patricks Project ID: 1006-01 Drawing No.: 704				

No. of panel: 2	Opening side (seen from inside) Left ☐ Right ☒	Panel type: Light 6 mm hard. ☐ 8 mm hard. ☒ 10 mm hard. ☐ Silhuett 6 mm float ☐ 6 mm hard. ☐ Shadow 20 mm insu. ☐	Panel mounted in Yes ☐ No ☒	Setelement: Packaging: Assembled ☒ Knock-down ☐
------------------------	--	---	--	---

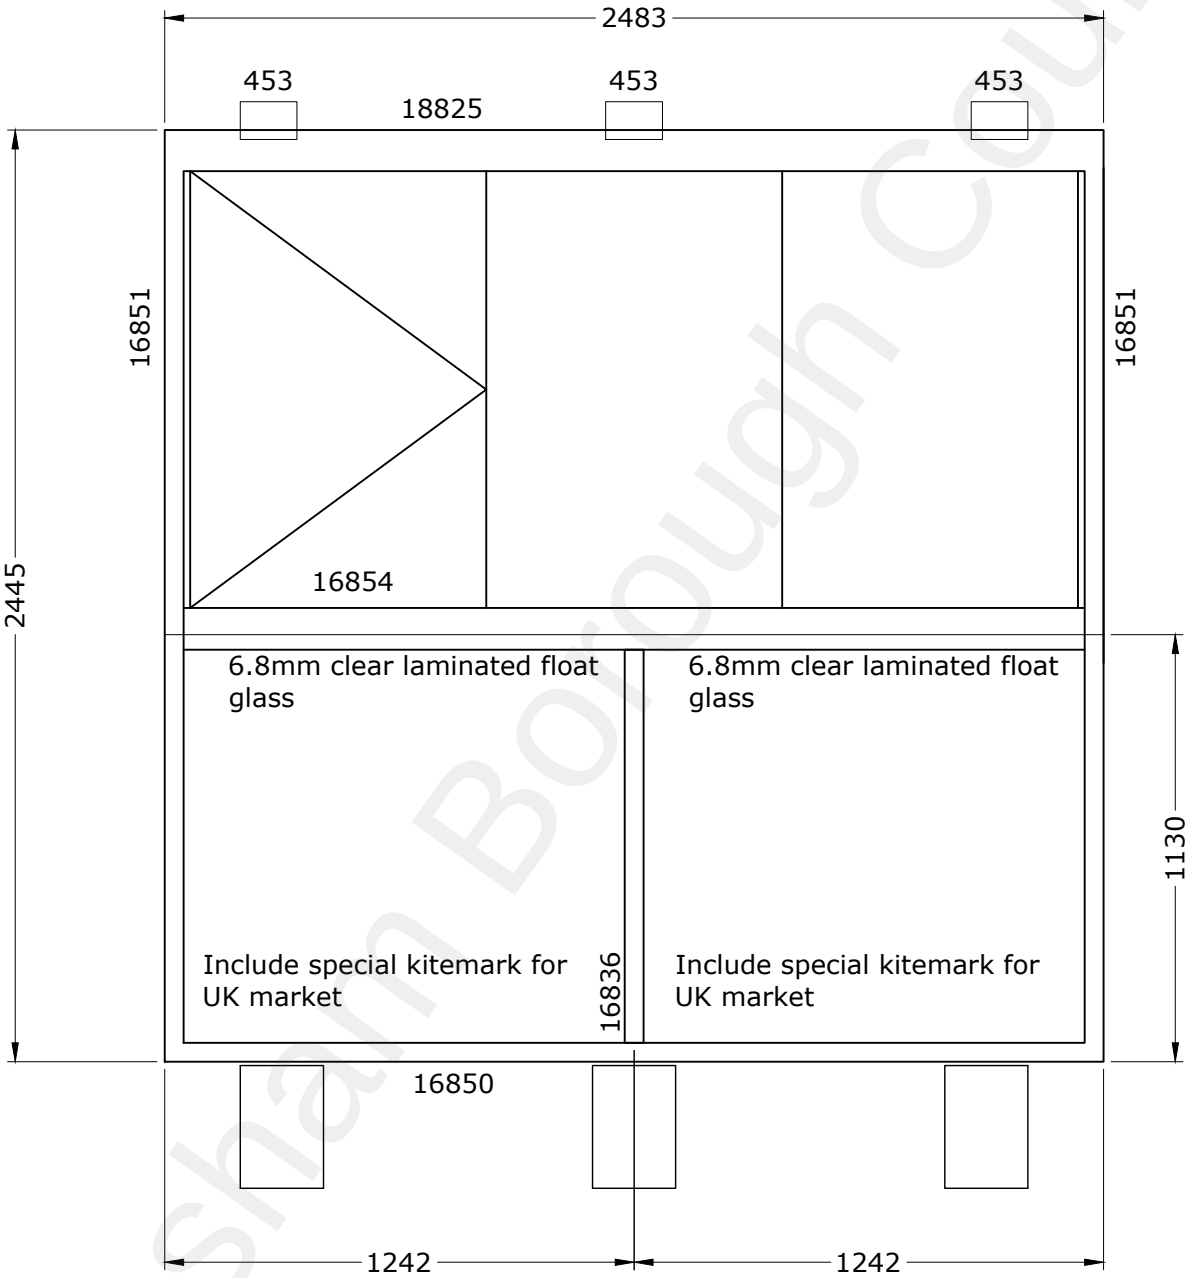


Element seen from outside

Description: (UK)	Colour	Add. info
Profiles, element:	RAL 7016, GI.30	
Profiles, hatches:	RAL 7016, GI.30	
Glazing profiles:	RAL 7016, GI.30	Indv./internal
Alveolit:	Black	10x12 mm on all 4 sides

AS BUILT

 Sunparadise Systems Limited 12 Newmarket Business Centre 341 Exning Road, Newmarket, SUFFOLK CB8 0AT Phone: 0870 067 88 www.sunparadise.com	Design:	Date	Init.:	Unit:	Rev.	Description	Date	Init.:
	Checked:	Dec'20	JCB	Scale:	A	Height TBC	29-04-21	GRO
	Order name:	St Patricks Garden Gravesend KENT				B		
	Subject:	Element 705				C		
					D			
					Business Opp: St Patricks Project ID: 1006-01 Drawing No.: 705			

No. of panel: 2	Opening side (seen from inside) Left ☒ Right ☐	Panel type: Light 6 mm hard. ☐ 8 mm hard. ☒ 10 mm hard. ☐ Silhuett 6 mm float ☐ 6 mm hard. ☐ Shadow 20 mm insu. ☐	Panel mounted in Yes ☐ No ☒	Setelement: Packaging: Assembled ☒ Knock-down ☐
------------------------	--	---	--	---

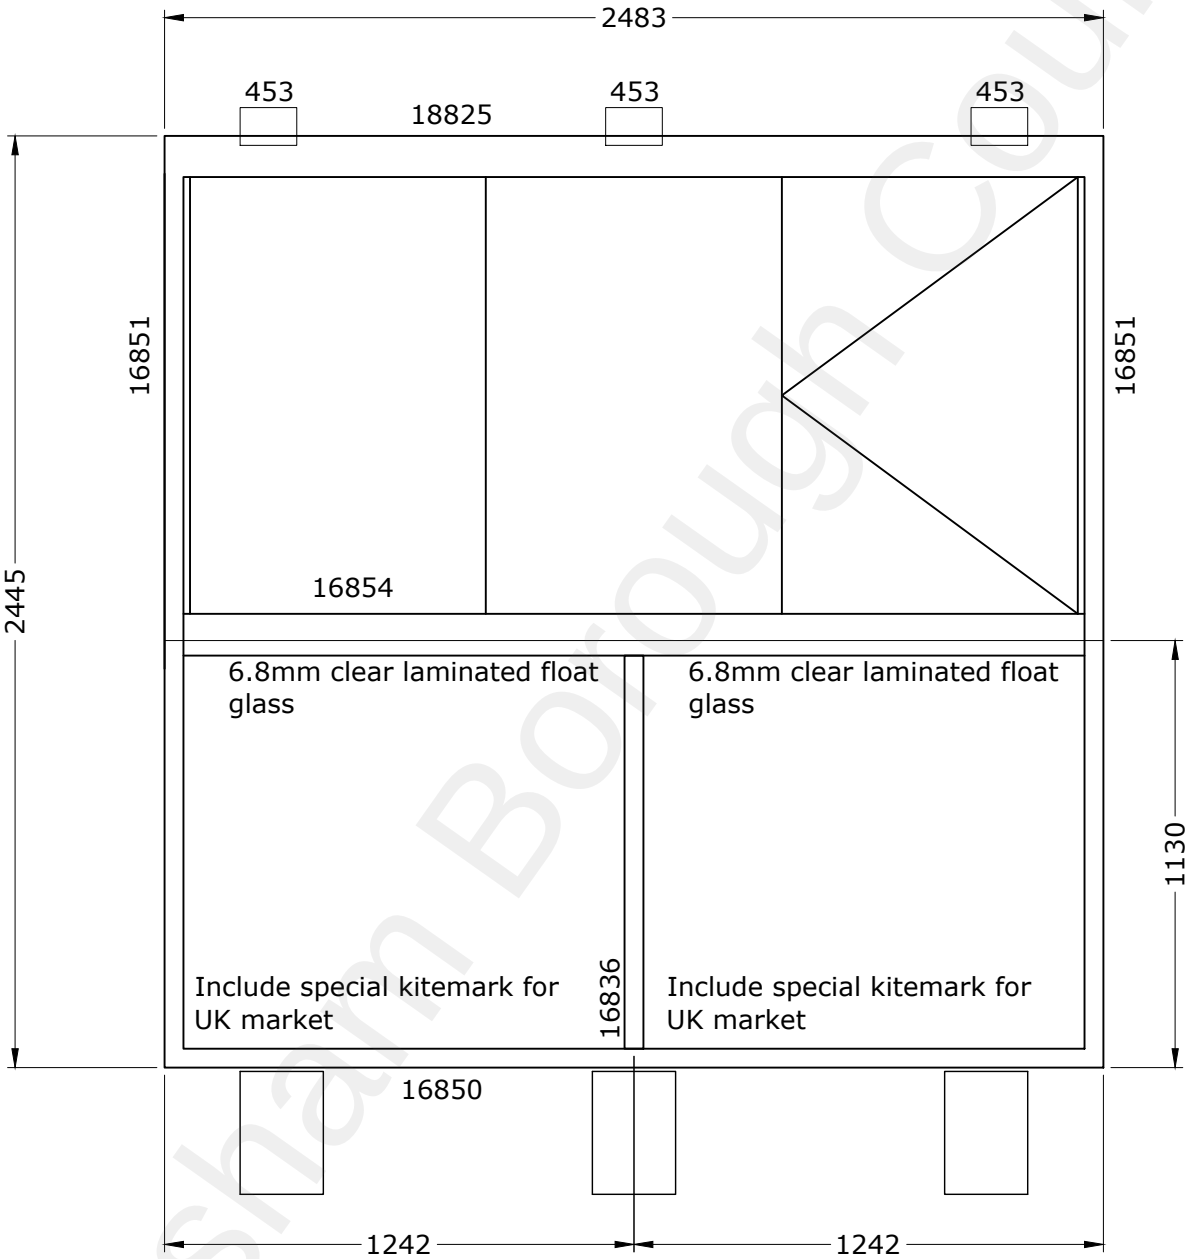


Element seen from outside

Description: (UK)	Colour	Add. info
Profiles, element:	RAL 7016, GI.30	
Profiles, hatches:	RAL 7016, GI.30	
Glazing profiles:	RAL 7016, GI.30	Indv./internal
Alveolit:	Black	10x12 mm on all 4 sides

AS BUILT

 Sunparadise Systems Limited 12 Newmarket Business Centre 341 Exning Road, Newmarket, SUFFOLK CB8 0AT Phone: 0870 067 88 www.sunparadise.com	Design:	Date	Init.:	Unit:	Rev.	Description	Date	Init.:
	Checked:	Dec'20	JCB	Scale:	A	Height TBC	29-04-21	GRO
	Order name:	St Patricks Garden Gravesend KENT				B		
	Subject:	Element 706				C		
					D			
					Business Opp: St Patricks Project ID: 1006-01 Drawing No.: 706			

No. of panel: 2	Opening side (seen from inside) Left ☐ Right ☒	Panel type: Light 6 mm hard. ☐ 8 mm hard. ☒ 10 mm hard. ☐ Silhuett 6 mm float ☐ 6 mm hard. ☐ Shadow 20 mm insu. ☐	Panel mounted in Yes ☐ No ☒	Setelement: Packaging: Assembled ☒ Knock-down ☐
------------------------	--	--	--	--

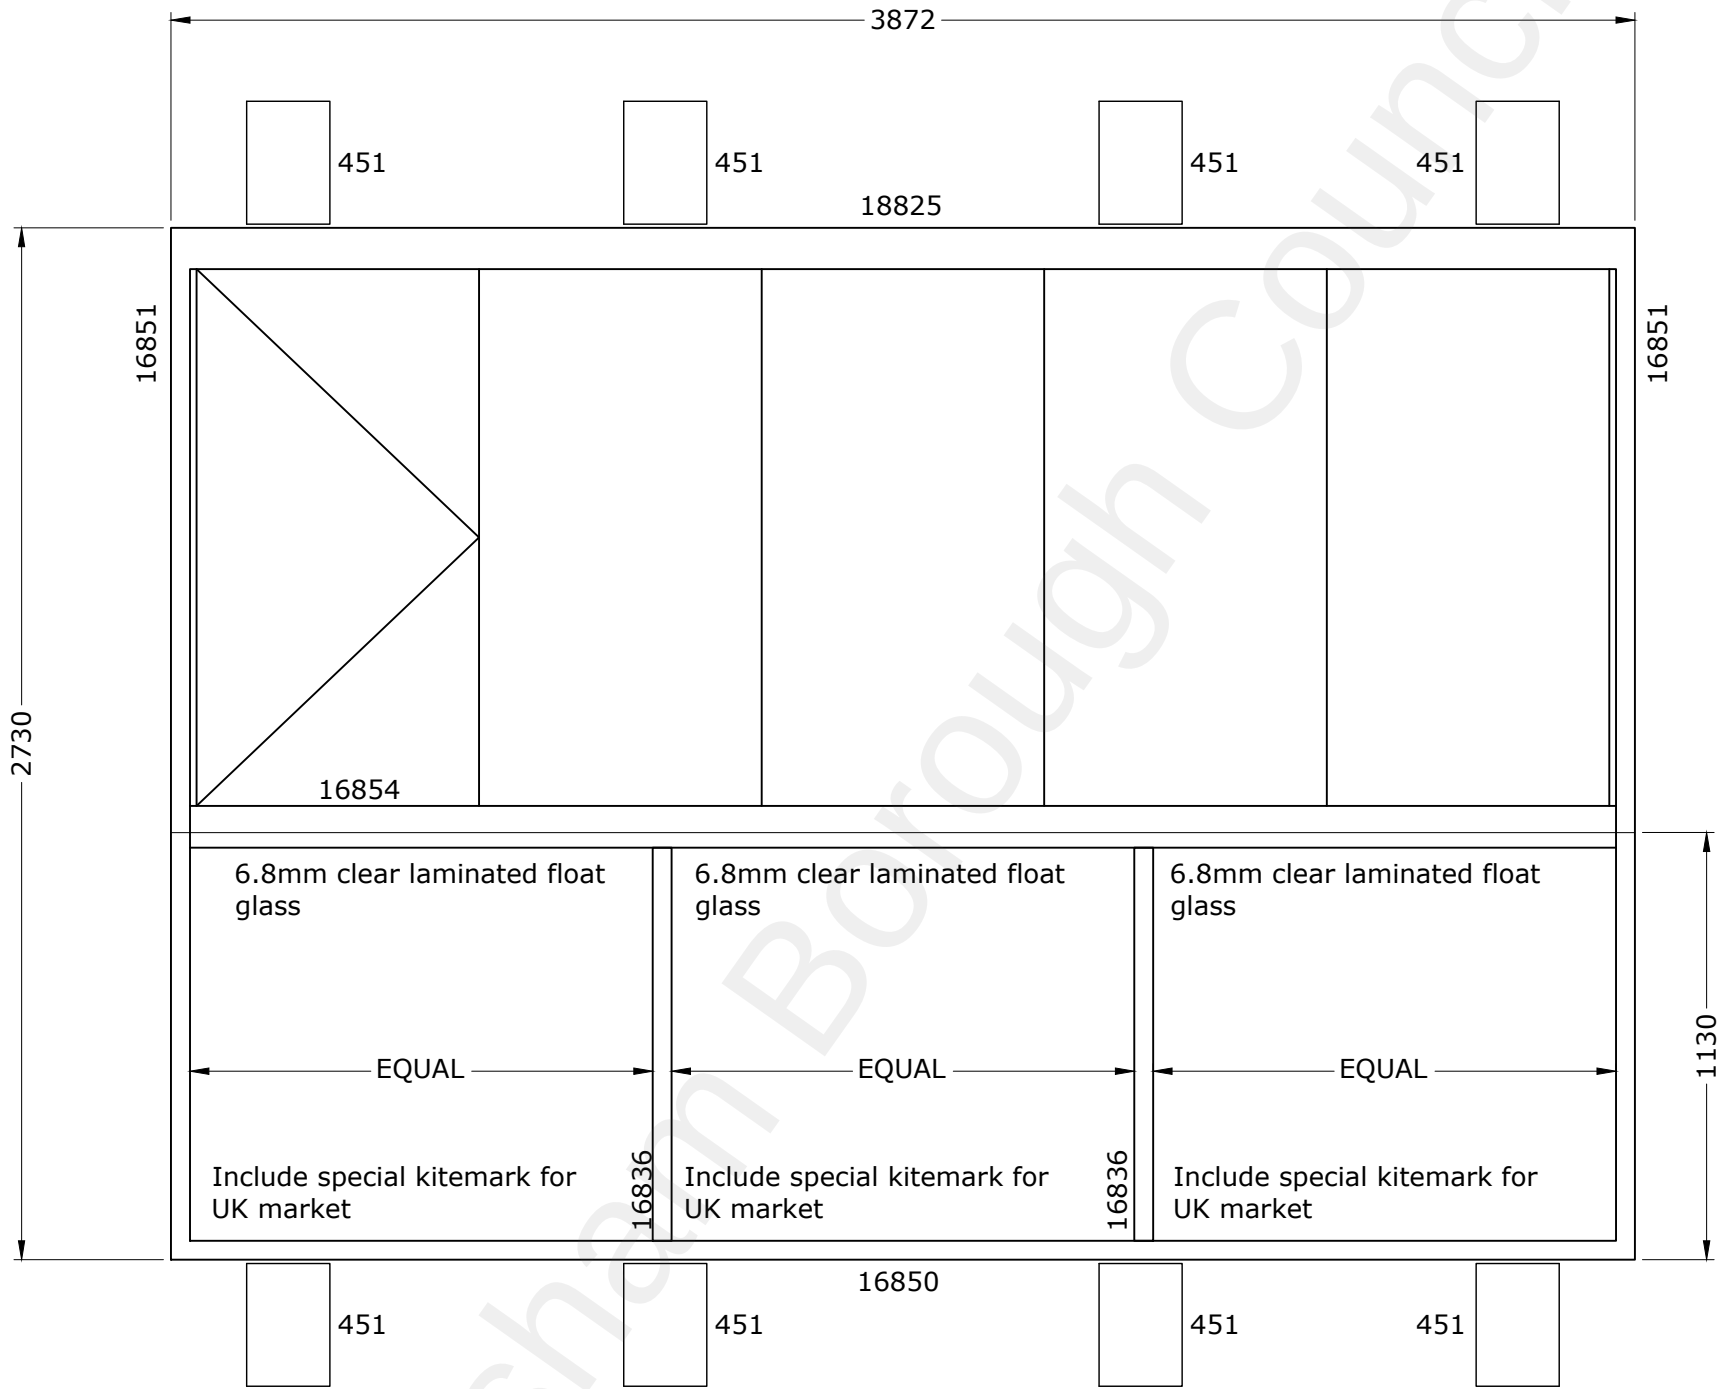


Element seen from outside

Description: (UK)	Colour	Add. info
Profiles, element:	RAL 7016, GI.30	
Profiles, hatches:	RAL 7016, GI.30	
Glazing profiles:	RAL 7016, GI.30	Indv./internal
Alveolit:	Black	10x12 mm on all 4 sides

AS BUILT

 Sunparadise Systems Limited 12 Newmarket Business Centre 341 Exning Road, Newmarket, SUFFOLK CB8 0AT Phone: 0870 067 88 www.sunparadise.com		Date	Init.:	Unit:	Rev.	Description	Date	Init.:
	Design:	Dec'20	JCB	Scale:	A	Mullion dims updated to be equal	18-02-21	GRO
	Checked:				B	Panel glass dim ref updated	19-02-21	GRO
	Order name:	St Patricks Garden Gravesend KENT			C			
					D			
					Business Opp: St Patricks Project ID: 1006-01 Drawing No.: 707			
Subject:	Element 707							

No. of panel: 2	Opening side (seen from inside) Left ☒ Right ☐	Panel type: Light 6 mm hard. ☐ 8 mm hard. ☒ 10 mm hard. ☐ Silhuett 6 mm float ☐ 6 mm hard. ☐ Shadow 20 mm insu. ☐	Panel mounted in Yes ☐ No ☒	Setelement: Packaging: Assembled ☒ Knock-down ☐
------------------------	--	---	--	---

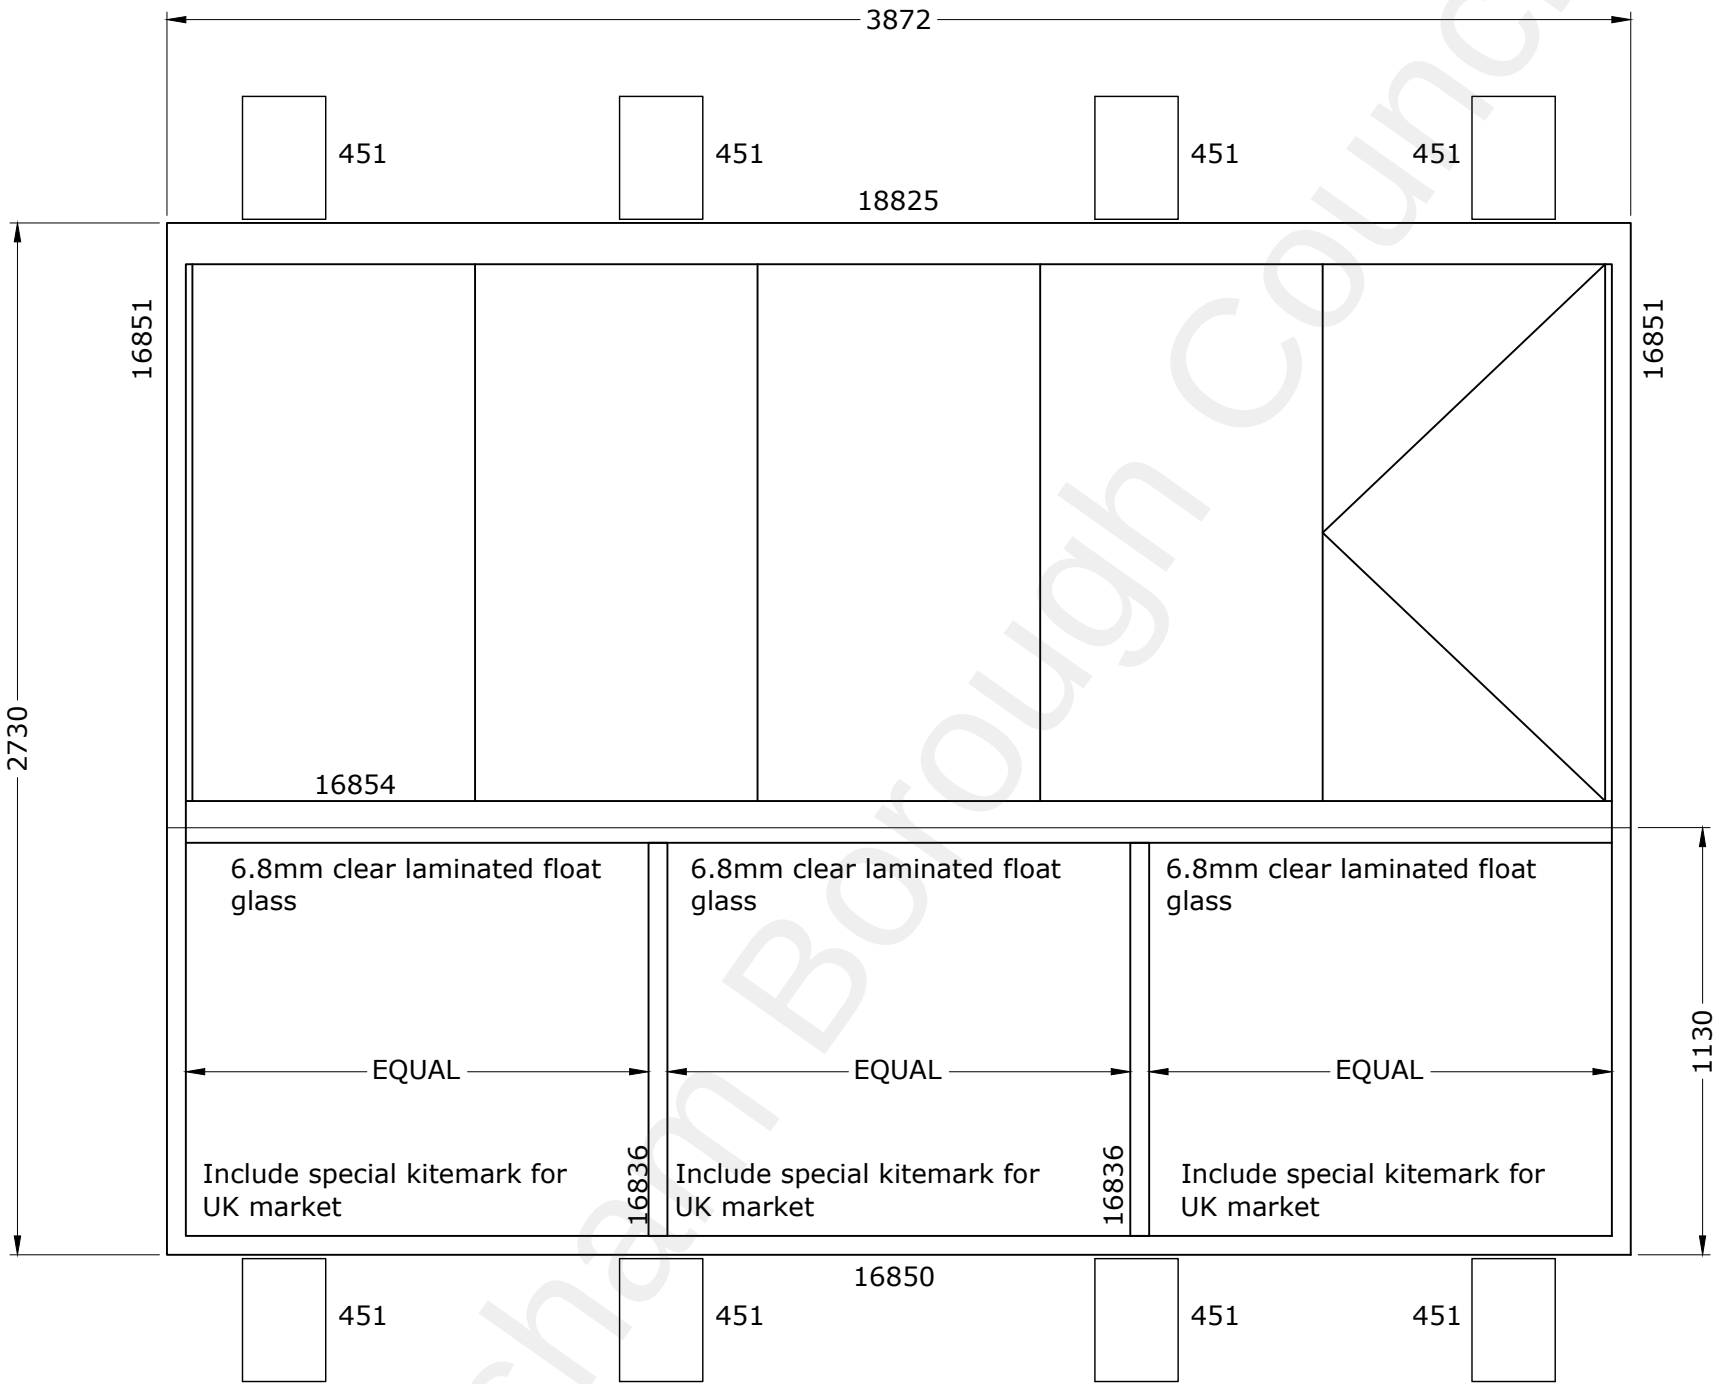


Element seen from outside

Description: (UK)	Colour	Add. info
Profiles, element:	RAL 7016, GI.30	
Profiles, hatches:	RAL 7016, GI.30	
Glazing profiles:	RAL 7016, GI.30	Indv./internal
Alveolit:	Black	10x12 mm on all 4 sides

AS BUILT

 Sunparadise Systems Limited 12 Newmarket Business Centre 341 Exning Road, Newmarket, SUFFOLK CB8 0AT Phone: 0870 067 88 www.sunparadise.com	Design:	Date	Init.:	Unit:	Rev.	Description	Date	Init.:
	Checked:	Dec'20	JCB	Scale:	A	Mullion dims updated to be equal	18-02-21	GRO
	Order name:	St Patricks Garden Gravesend KENT			B	Panel glass dim ref updated	19-02-21	GRO
	Subject:	Element 708			C			
					D			
					Business Opp: St Patricks Project ID: 1006-01 Drawing No.: 708			

No. of panel: 1	Opening side (seen from inside) Left ☐ Right ☒	Panel type: Light 6 mm hard. ☐ 8 mm hard. ☒ 10 mm hard. ☐ Silhuett 6 mm float ☐ 6 mm hard. ☐ Shadow 20 mm insu. ☐			Panel mounted in Yes ☐ No ☒	Setelement: Packaging: Assembled ☒ Knock-down ☐
------------------------	--	---	--	--	--	---

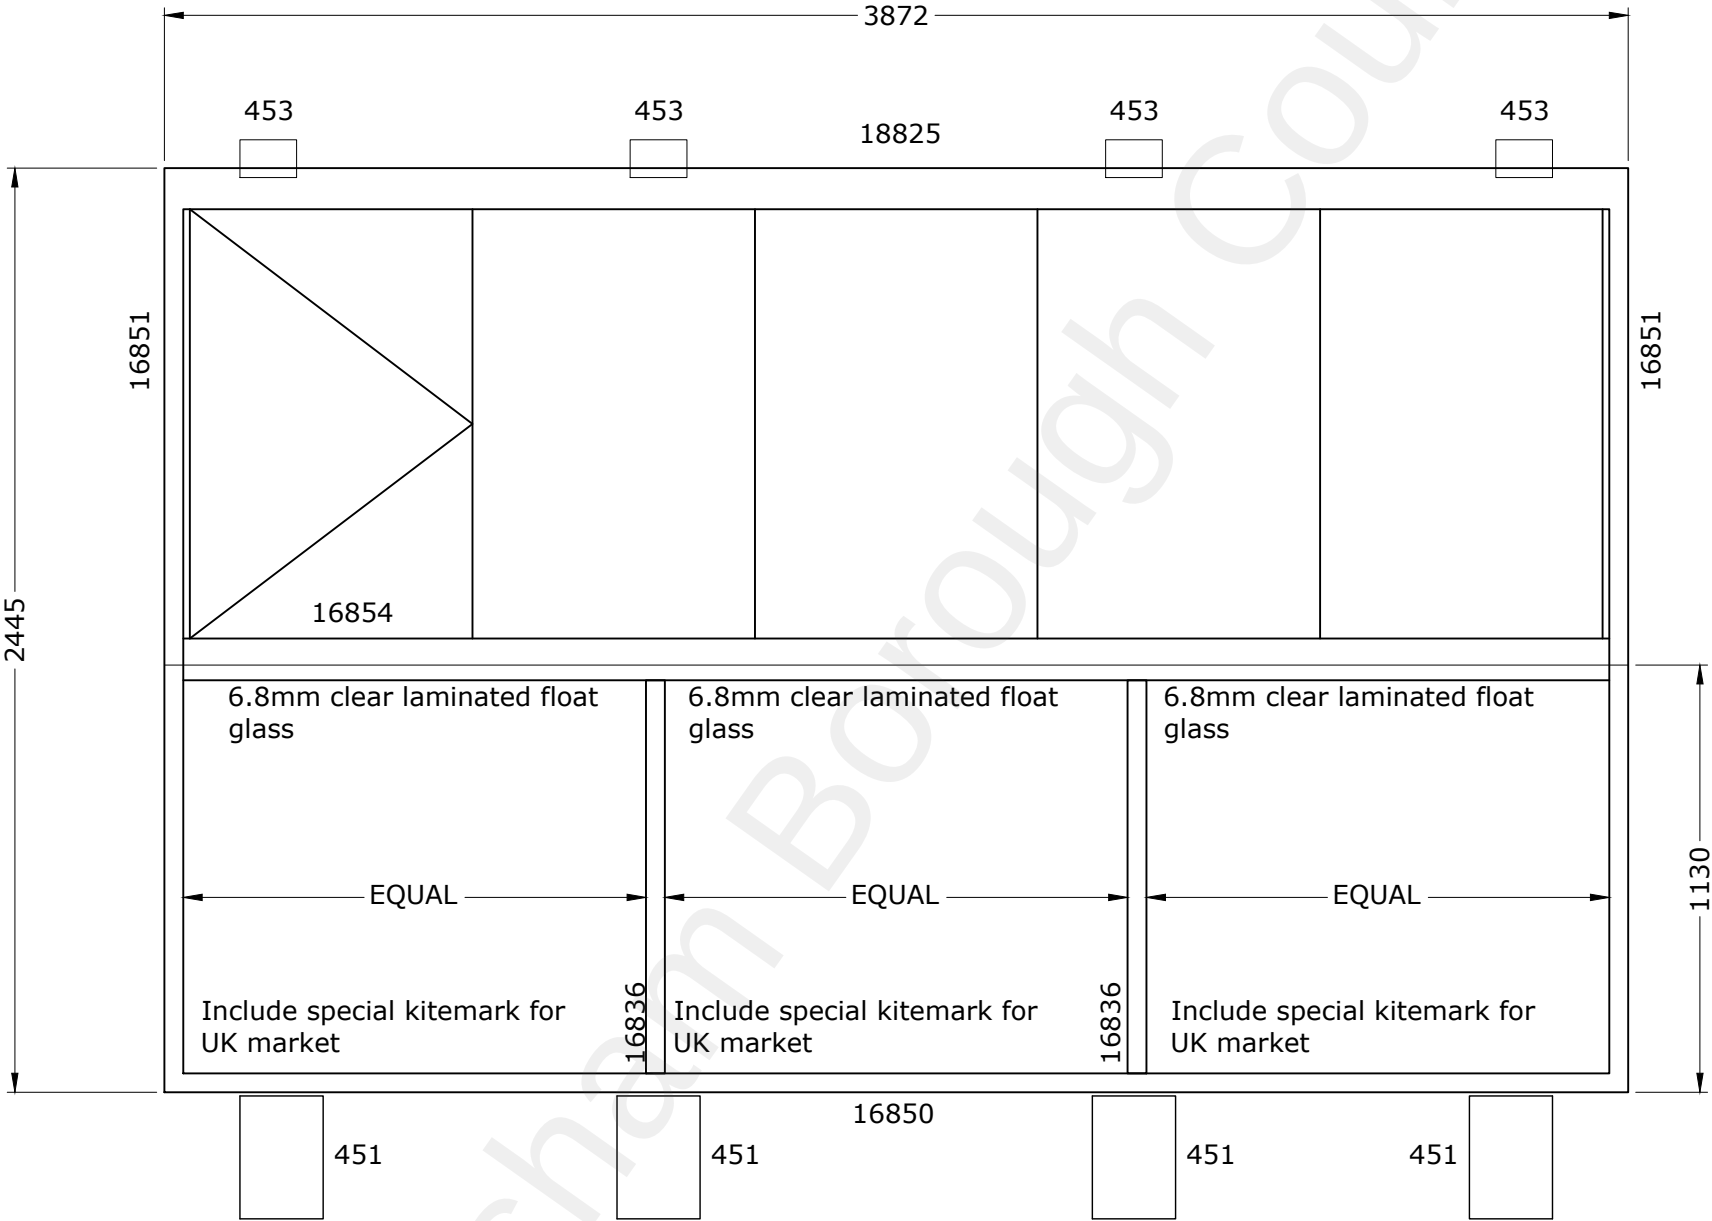

Element seen from outside

Description: (UK)	Colour	Add. info
Profiles, element:	RAL 7016, GI.30	
Profiles, hatches:	RAL 7016, GI.30	
Glazing profiles:	RAL 7016, GI.30	Indv./internal
Alveolit:	Black	10x12 mm on all 4 sides

AS BUILT


 Sunparadise Systems Limited 12 Newmarket Business Centre 341 Exning Road, Newmarket, SUFFOLK CB8 0AT Phone: 0870 067 88 www.sunparadise.com		Date	Init.:	Unit:	Rev.	Description	Date	Init.:
	Design:	Dec'20	JCB	Scale:	A	Mullion dims updated to be equal	18-02-21	GRO
	Checked:				B	Panel glass dim ref updated	19-02-21	GRO
	Order name:	St Patricks Garden Gravesend KENT			C	Height reduced to2445mm	29-04-21	GRO
					D			
Subject:	Element 709			Business Opp: St Patricks Project ID: 1006-01 Drawing No.: 709				

[illegible]

AS BUILT

 Sunparadise Systems Limited 12 Newmarket Business Centre 341 Exning Road, Newmarket, SUFFOLK CB8 0AT Phone: 0870 067 88 www.sunparadise.com		Date	Init.:	Unit:	Rev.	Description	Date	Init.:
	Design:	Dec'20	JCB	Scale:	A	Mullion dims updated to be equal	18-02-21	GRO
	Checked:				B	Panel glass dim ref updated	19-02-21	GRO
	Order name:	St Patricks Garden Gravesend KENT			C	Height reduced to 2445mm	29-04-21	GRO
					D			
Subject: Element 710	Business Opp: St Patricks Project ID: 1006-01 Drawing No.: 710							

No. of panel: 1	Opening side (seen from inside) Left ☐ Right ☒	Panel type: Light 6 mm hard. ☐ 8 mm hard. ☒ 10 mm hard. ☐ Silhuett 6 mm float ☐ 6 mm hard. ☐ Shadow 20 mm insu. ☐	Panel mounted in Yes ☐ No ☒	Setelement: Packaging: Assembled ☒ Knock-down ☐
------------------------	--	---	--	---

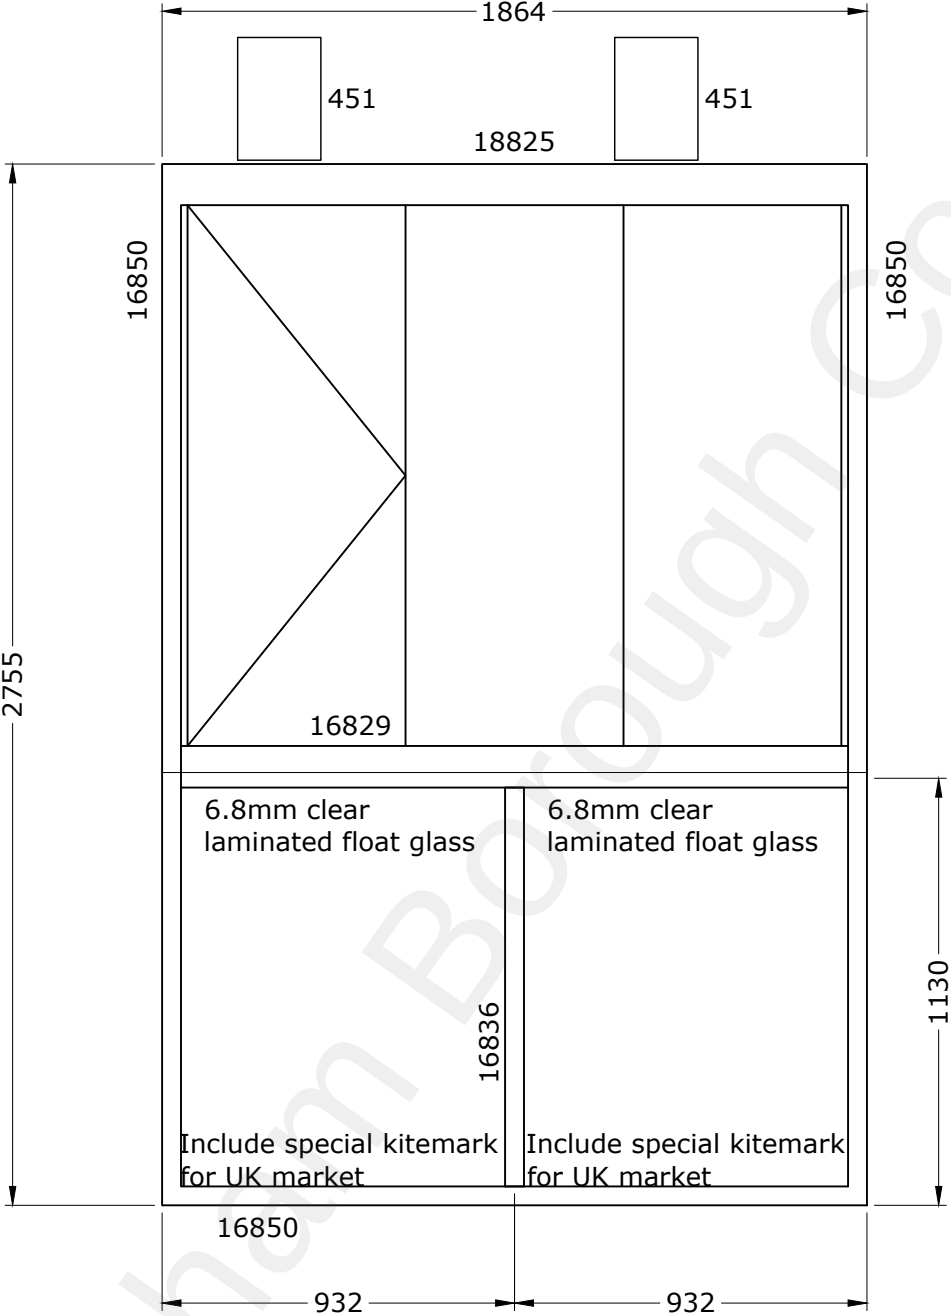


Element seen from outside

Description: (UK)	Colour	Add. info
Profiles, element:	RAL 7016, GI.30	
Profiles, hatches:	RAL 7016, GI.30	
Glazing profiles:	RAL 7016, GI.30	Indv./internal
Alveolit:	Black	10x12 mm on all 4 sides

AS BUILT

 Sunparadise Systems Limited 12 Newmarket Business Centre 341 Exning Road, Newmarket, SUFFOLK CB8 0AT Phone: 0870 067 88 www.sunparadise.com	Design:	Date	Init.:	Unit:	Rev.	Description	Date	Init.:
	Checked:	Dec'20	JCB	Scale:	A			
	Order name:	St Patricks Garden Gravesend KENT			B			
	Subject:	Element 711			C			
					D			
					Business Opp: St Patricks Project ID: 1006-01 Drawing No.: 711			

No. of panel: 1	Opening side (seen from inside) Left ☒ Right ☐	Panel type: Light 6 mm hard. ☐ 8 mm hard. ☐ 10 mm hard. ☒ Silhuett 6 mm float ☐ 6 mm hard. ☐ Shadow 20 mm insu. ☐	Panel mounted in Yes ☐ No ☒	Setelement: Packaging: Assembled ☒ Knock-down ☐
------------------------	--	---	--	---

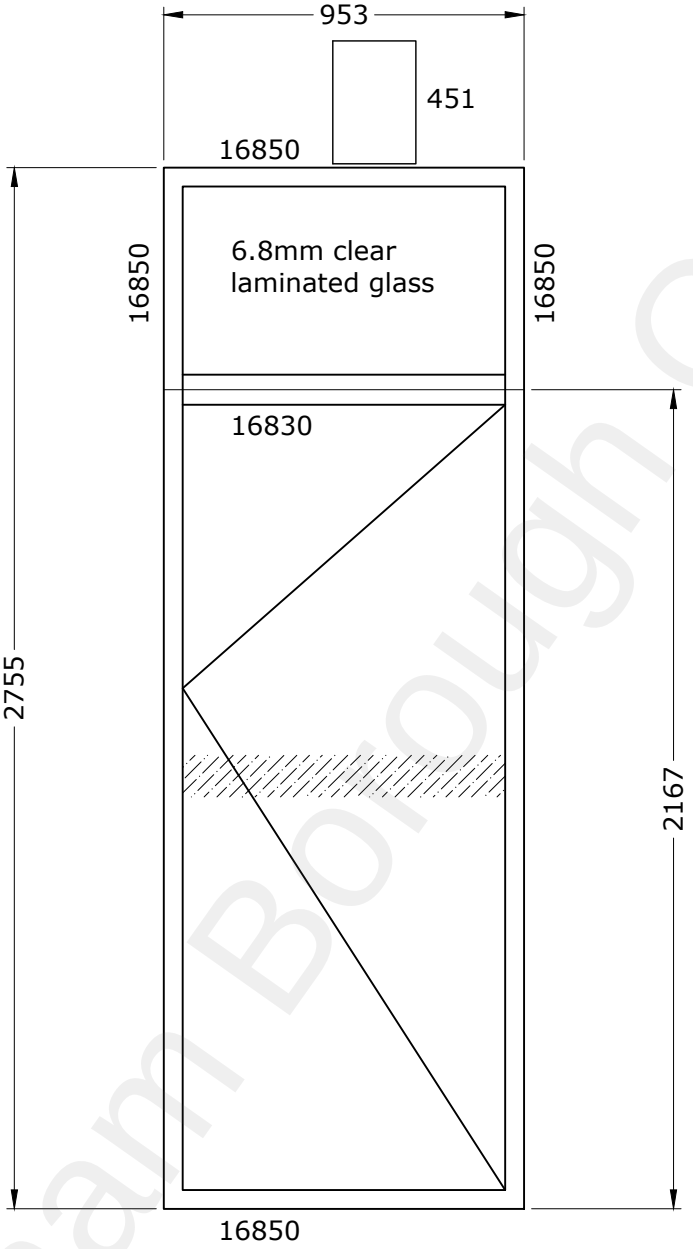


Element seen from outside

Description: (UK)	Colour	Add. info
Profiles, element:	RAL 7016, GI.30	
Profiles, hatches:	RAL 7016, GI.30	
Glazing profiles:	RAL 7016, GI.30	Indv./internal
Alveolit:	Black	10x12 mm on all 4 sides

AS BUILT

 Sunparadise Systems Limited 12 Newmarket Business Centre 341 Exning Road, Newmarket, SUFFOLK CB8 0AT Phone: 0870 067 88 www.sunparadise.com	Design:	Date	Init.:	Unit:	Rev.	Description	Date	Init.:
	Checked:	Dec'20	JCB	Scale:	A			
	Order name:	St Patricks Garden Gravesend KENT			B			
	Subject:	Element 712			C			
					D			
					Business Opp: St Patricks Project ID: 1006-01 Drawing No.: 712			

No. of panel: 1	Opening side (seen from inside) Left ☒ Right ☐	Panel type: Light 6 mm hard. ☐ 8 mm hard. ☒ 10 mm hard. ☐ Silhuett 6 mm float ☐ 6 mm hard. ☐ Shadow 20 mm insu. ☐	Panel mounted in Yes ☐ No ☒	Setelement: Packaging: Assembled ☒ Knock-down ☐
------------------------	--	---	--	---

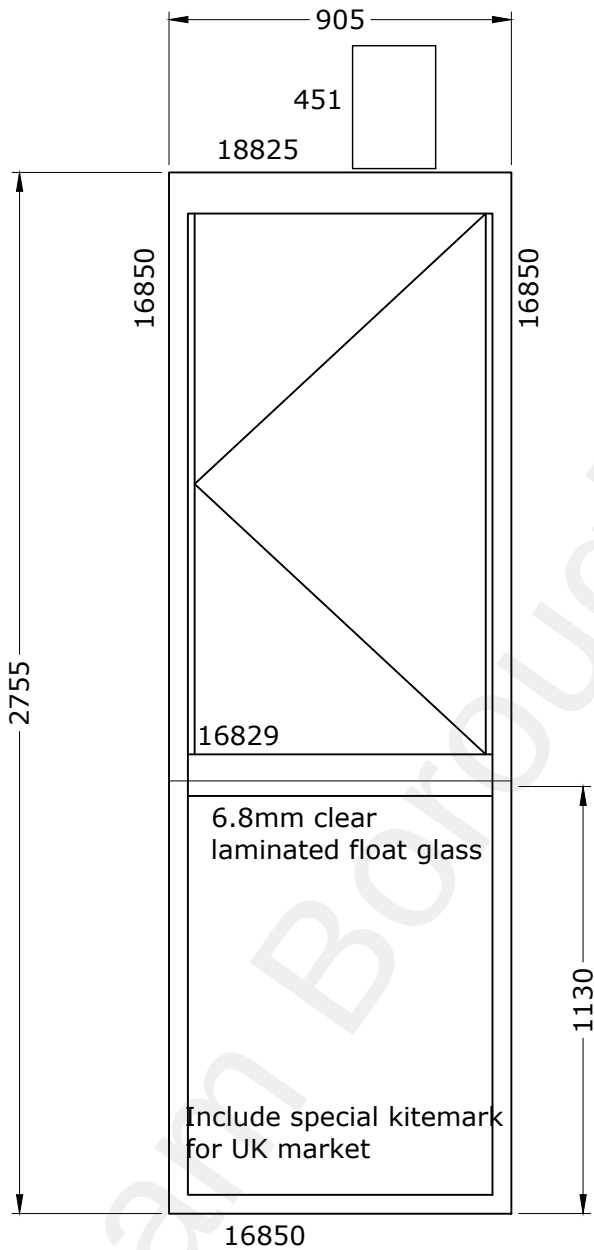

Element seen from outside

Description: (UK)	Colour	Add. info
Profiles, element:	RAL 7016, GI.30	
Profiles, hatches:	RAL 7016, GI.30	
Glazing profiles:	RAL 7016, GI.30	Indv./internal
Alveolit:	Black	10x12 mm on all 4 sides

AS BUILT

 Sunparadise Systems Limited 12 Newmarket Business Centre 341 Exning Road, Newmarket, SUFFOLK CB8 0AT Phone: 0870 067 88 www.sunparadise.com	Design:	Date	Init.:	Unit:	Rev.	Description	Date	Init.:
	Checked:	Dec'20	JCB	Scale:	A			
	Order name:	St Patricks Garden Gravesend KENT			B			
	Subject:	Element 713			C			
					D			
					Business Opp: St Patricks Project ID: 1006-01 Drawing No.: 713			

Technical drawing of a window unit showing dimensions and specifications.

Overall Dimensions:

- Overall Width: 3622
- Overall Height: 2655

Top Section (Header):

- Width: 18825
- Height: 16851
- Four small rectangular elements, each labeled 451.

Main Section (Body):

- Width: 16851
- Height: 16851
- Left side features a diagonal line and the number 16854.

Bottom Section (Footer):

- Width: 16850
- Height: 1045
- Three rectangular elements, each labeled 454.
- Three rectangular elements, each labeled 16836.
- Text: "6.8mm clear laminated float glass" (repeated three times).
- Text: "Include special kitemark for UK market" (repeated three times).

Bottom Dimensions:

- 1262
- 1236
- 1125

Element seen from outside

<u>Description: (UK)</u>	<u>Colour</u>	<u>Add. info</u>
<u>Profiles, element:</u>	RAL 7016, Gl.30	
<u>Profiles, hatches:</u>	RAL 7016, Gl.30	
<u>Glazing profiles:</u>	RAL 7016, Gl.30	Indv./internal
<u>Alveolit:</u>	Black	10x12 mm on all 4 sides

 Sunparadise Systems Limited 12 Newmarket Business Centre 341 Exning Road, Newmarket, SUFFOLK CB8 0AT Phone: 0870 067 88 www.sunparadise.com		Date	Init.:	Unit:	Rev.	Description	Date	Init.
	Design:	Dec'20	JCB	Scale:	A	Mullion dim positions changed	19-02-21	GR
	Checked:				B			
	Order name:	St Patricks Garden Gravesend KENT			C			
					D			
Subject:	Element 714	Business Opp: St Patricks Project ID: 1006-01 Drawing No.: 714						

AS BUILT

Technical drawing of a window unit showing dimensions and components.

Overall Dimensions:

- Overall Width: 3760
- Overall Height: 2730

Window Unit Components and Dimensions:

- Top Sill:** Four vertical sections, each 451 wide. Total width: 18825.
- Main Window Frame:** Divided into five vertical sections. The leftmost section is labeled 16854 and contains a diagonal line.
- Bottom Sill:** Three vertical sections, each 16836 wide. Total width: 16850.
- Bottom Labels:** Each of the three bottom sill sections is labeled "6.8mm clear laminated float glass" and "Include special kitemark for UK market".
- Bottom Spacing:** The distance between the bottom sill and the main window frame is 1130.

AS BUILT

Technical drawing of a glass partition wall. The overall dimensions are 3760 (width) by 2730 (height). The wall is composed of several panels and a base.

Top Section: A horizontal row of four small rectangular panels, each labeled 451. The total width of this section is 3760. The height of the top section is 16851.

Main Section: A large rectangular area divided into five vertical panels. The first four panels are labeled 16854. The fifth panel is a triangular panel. The total width of this section is 18825. The height of this section is 16851.

Base Section: A horizontal row of three rectangular panels, each labeled 451. The total width of this section is 16850. The height of this section is 1130. Each panel contains the text "6.8mm clear laminated float glass" and "Include special kitemark for UK market". The panels are separated by vertical lines labeled 16836. The width of each panel is labeled "EQUAL".

Dimensions:

- Overall width: 3760
- Overall height: 2730
- Top section height: 16851
- Main section height: 16851
- Base section height: 1130
- Base section width: 16850
- Base section panel width: 16836
- Base section panel height: 16850
- Base section panel width: 16836
- Base section panel height: 16850
- Base section panel width: 16836
- Base section panel height: 16850

Element seen from outside

10x12 mm on all 4 sides

 Sunparadise Systems Limited 12 Newmarket Business Centre 341 Exning Road, Newmarket, SUFFOLK CB8 0AT Phone: 0870 067 88 www.sunparadise.com		Date	Init.:	Unit:	Rev.	Description	Date	Init
	Design:	Dec'20	JCB	Scale:	A	Mullion dims updated to be equal	18-02-21	GR
	Checked:				B	Panel glass dim ref updated	19-02-21	GR
	Order name:	St Patricks Garden Gravesend KENT			C			
					D			
Subject:	Element 716			Business Opp: St Patricks Project ID: 1006-01 Drawing No.: 716				

AS BUILT

Technical drawing of a window unit with the following specifications:

- Overall Dimensions:**
 - Width: 3760
 - Height: 2445
- Top Section (Height 16851):**
 - Divided into four equal vertical sections by three vertical mullions.
 - Each section is 453 units wide.
 - Leftmost section contains a diagonal line and is labeled 16854.
 - Rightmost section is labeled 18825.
- Bottom Section (Height 1130):**
 - Divided into three equal vertical sections by two vertical mullions.
 - Each section is 16836 units wide.
 - Each section contains the text: "6.8mm clear laminated float glass" and "Include special kitemark for UK market".
 - Each section is labeled 16836.
- Bottom Section (Height 16850):**
 - Divided into four equal vertical sections by three vertical mullions.
 - Each section is 451 units wide.


Element seen from outside

<u>Description: (UK)</u>	<u>Colour</u>	<u>Add. info</u>
<u>Profiles, element:</u>	RAL 7016, Gl.30	
<u>Profiles, hatches:</u>	RAL 7016, Gl.30	
<u>Glazing profiles:</u>	RAL 7016, Gl.30	Indv./internal
<u>Alveolit:</u>	Black	10x12 mm on all 4 sides

 Sunparadise Systems Limited 12 Newmarket Business Centre 341 Exning Road, Newmarket, SUFFOLK CB8 0AT Phone: 0870 067 88 www.sunparadise.com		Date	Init.:	Unit:	Rev.	Description	Date	Init.
	Design:	Dec'20	JCB	Scale:	A	Mullion dims updated to be equal	18-02-21	GR
	Checked:				B	Panel glass dim ref updated	19-02-21	GR
	Order name:	St Patricks Garden Gravesend KENT		C	Height reduced to 2445mm	29-04-21	GR	
			D					
Subject: Element 717	Business Opp: St Patricks Project ID: 1006-01 Drawing No.: 717							

AS BUILT

No. of panel: 1	Opening side (seen from inside) Left ☒ Right ☐	Panel type: Light 6 mm hard. ☐ 8 mm hard. ☒ 10 mm hard. ☐ Silhuett 6 mm float ☐ 6 mm hard. ☐ Shadow 20 mm insu. ☐	Panel mounted in Yes ☐ No ☒	Setelement: Packaging: Assembled ☒ Knock-down ☐
------------------------	--	---	--	---

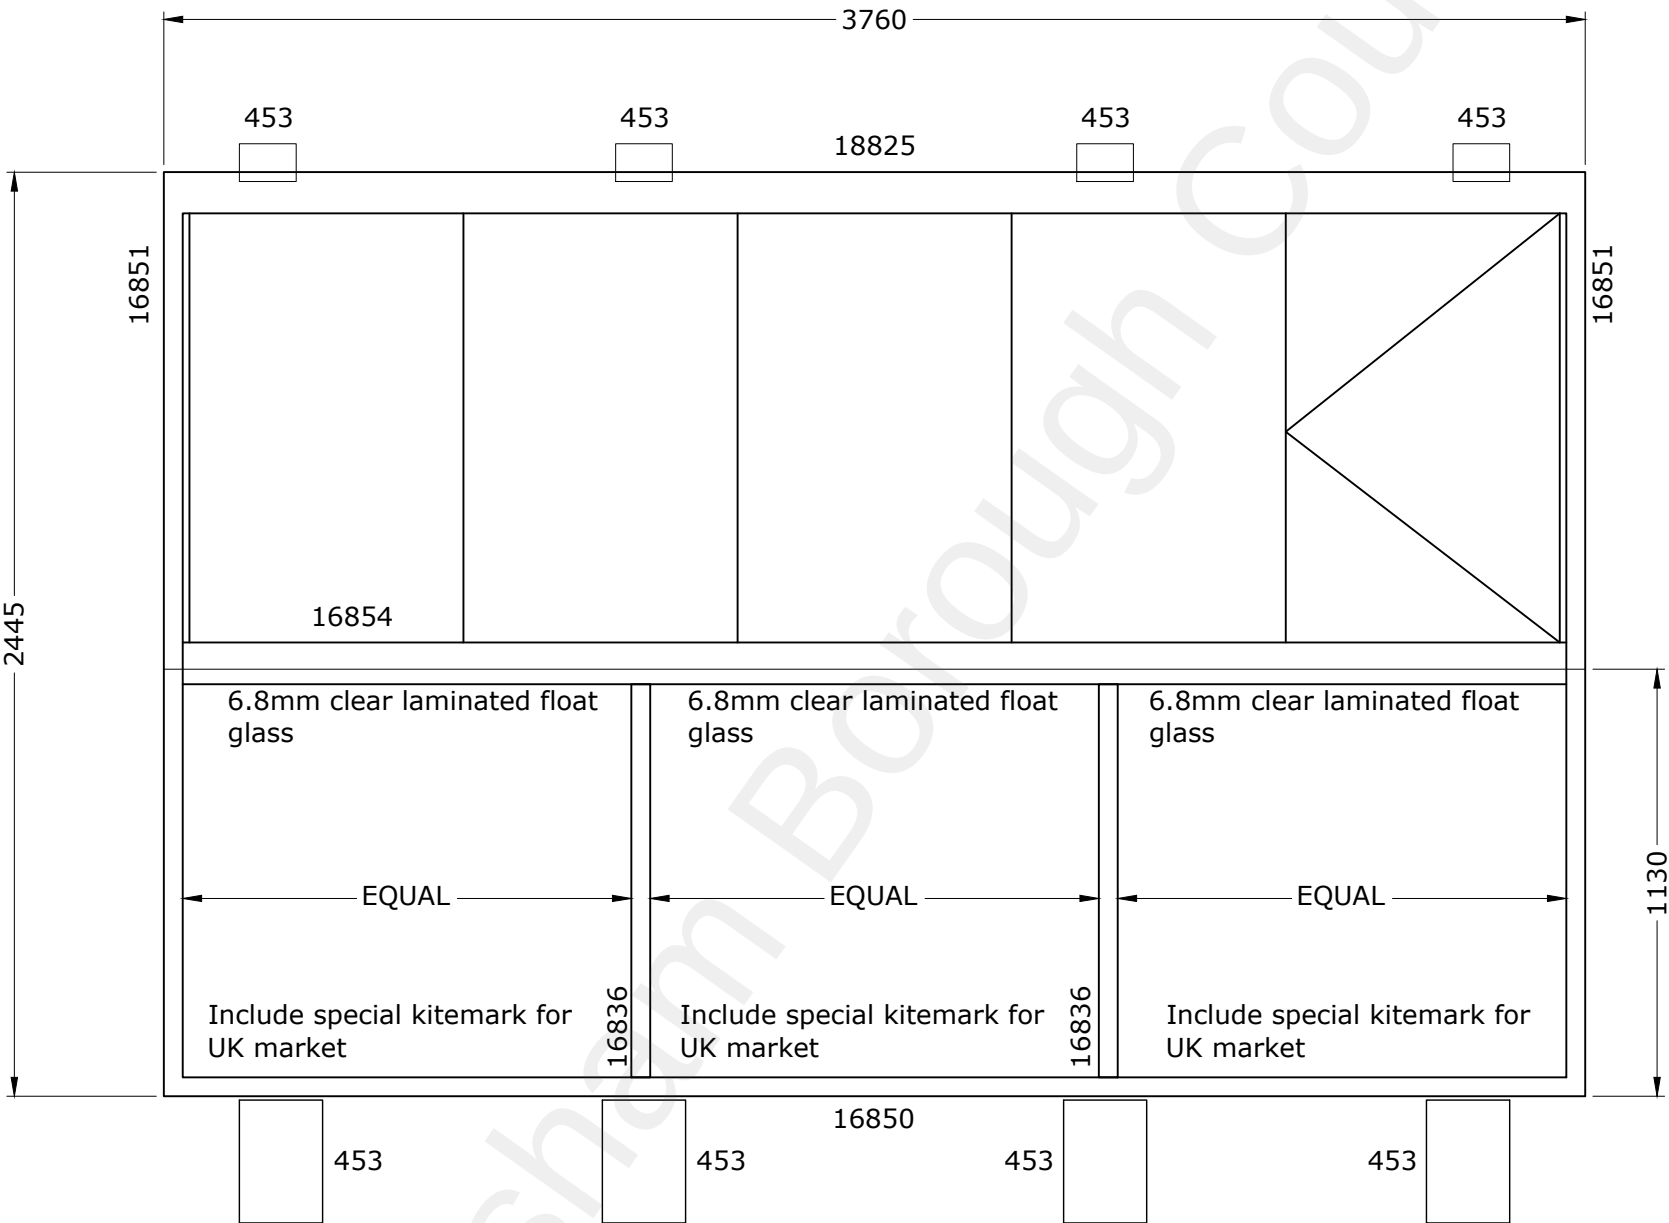

Element seen from outside

Description: (UK)	Colour	Add. info
Profiles, element:	RAL 7016, GI.30	
Profiles, hatches:	RAL 7016, GI.30	
Glazing profiles:	RAL 7016, GI.30	Indv./internal
Alveolit:	Black	10x12 mm on all 4 sides


AS BUILT



Sunparadise Systems Limited
12 Newmarket Business Centre
341 Exning Road, Newmarket,
SUFFOLK CB8 0AT
Phone: 0870 067 88
www.sunparadise.com

	Date	Init.:	Unit:	Rev.	Description	Date	Init.:
Design:	Dec'20	JCB	Scale:	A	Panel glass dim ref updated	19-02-21	GRO
Checked:				B	Height reduced to 2445mm	29-04-21	GRO
Order name:	St Patricks Garden Gravesend KENT			C			
				D			
				Business Opp: St Patricks Project ID: 1006-01 Drawing No.: 718			
Subject:	Element 718						

No. of panel: 1	Opening side (seen from inside) Left ☐ Right ☒	Panel type: Light 6 mm hard. ☐ 8 mm hard. ☒ 10 mm hard. ☐ Silhuett 6 mm float ☐ 6 mm hard. ☐ Shadow 20 mm insu. ☐	Panel mounted in Yes ☐ No ☒	Setelement: Packaging: Assembled ☒ Knock-down ☐
------------------------	--	---	--	---

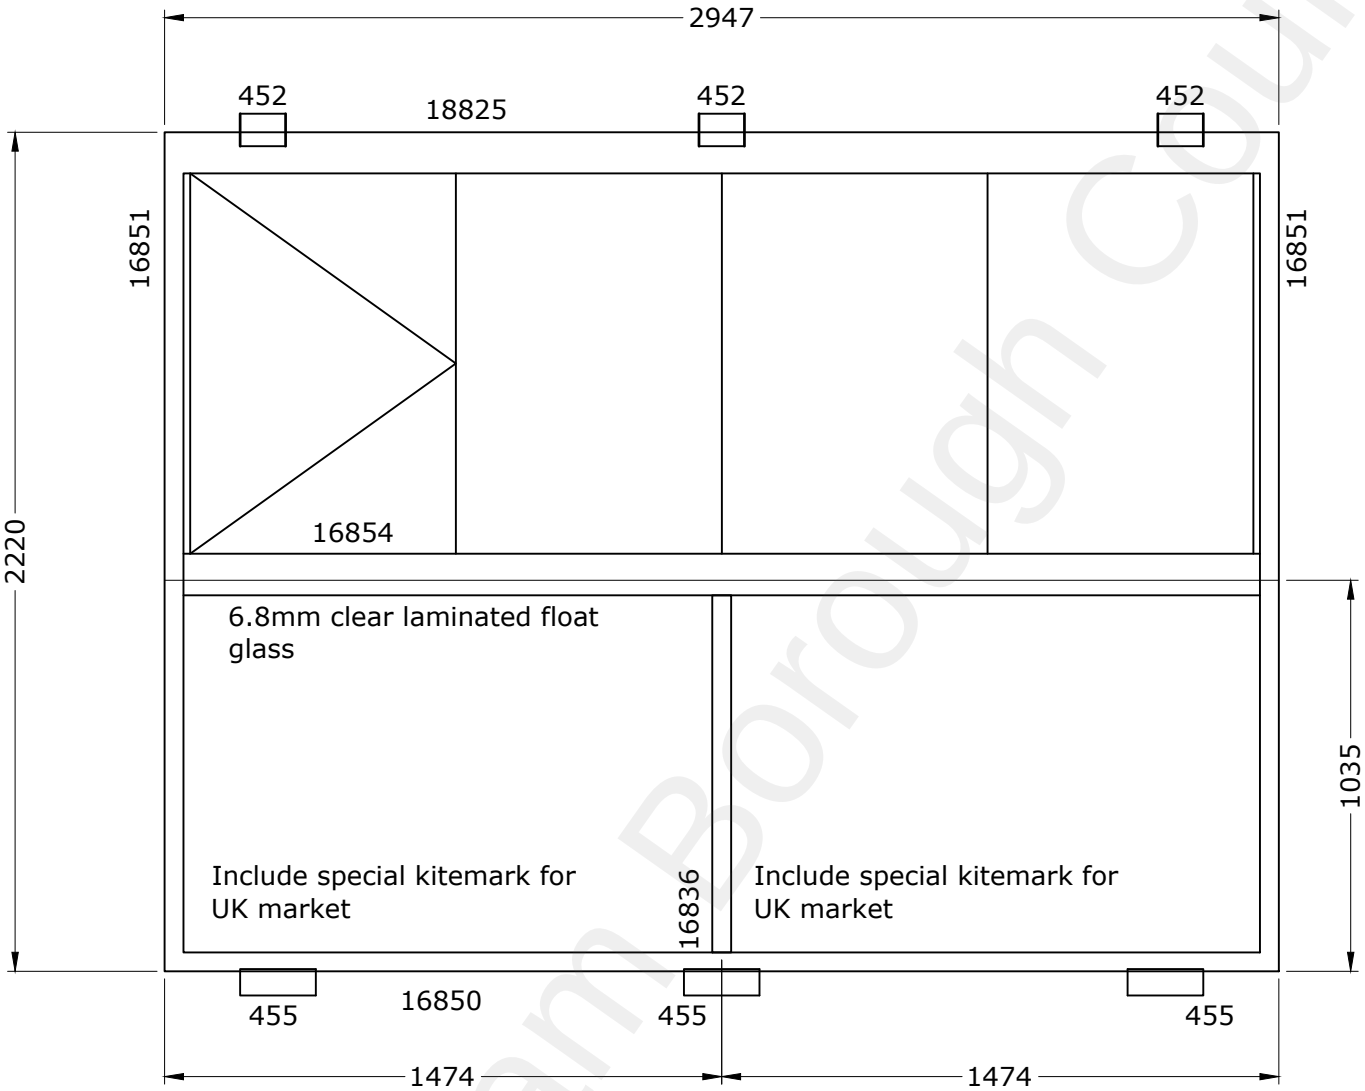

Element seen from outside

Description: (UK)	Colour	Add. info
Profiles, element:	RAL 7016, GI.30	
Profiles, hatches:	RAL 7016, GI.30	
Glazing profiles:	RAL 7016, GI.30	Indv./internal
Alveolit:	Black	10x12 mm on all 4 sides

AS BUILT

 Sunparadise Systems Limited 12 Newmarket Business Centre 341 Exning Road, Newmarket, SUFFOLK CB8 0AT Phone: 0870 067 88 www.sunparadise.com	Design:	Date	Init.:	Unit:	Rev.	Description	Date	Init.:
	Checked:	Dec'20	JCB	Scale:	A			
	Order name:	St Patricks Garden Gravesend KENT			B			
	Subject:	Element 719			C			
					D			
					Business Opp: St Patricks Project ID: 1006-01 Drawing No.: 719			