



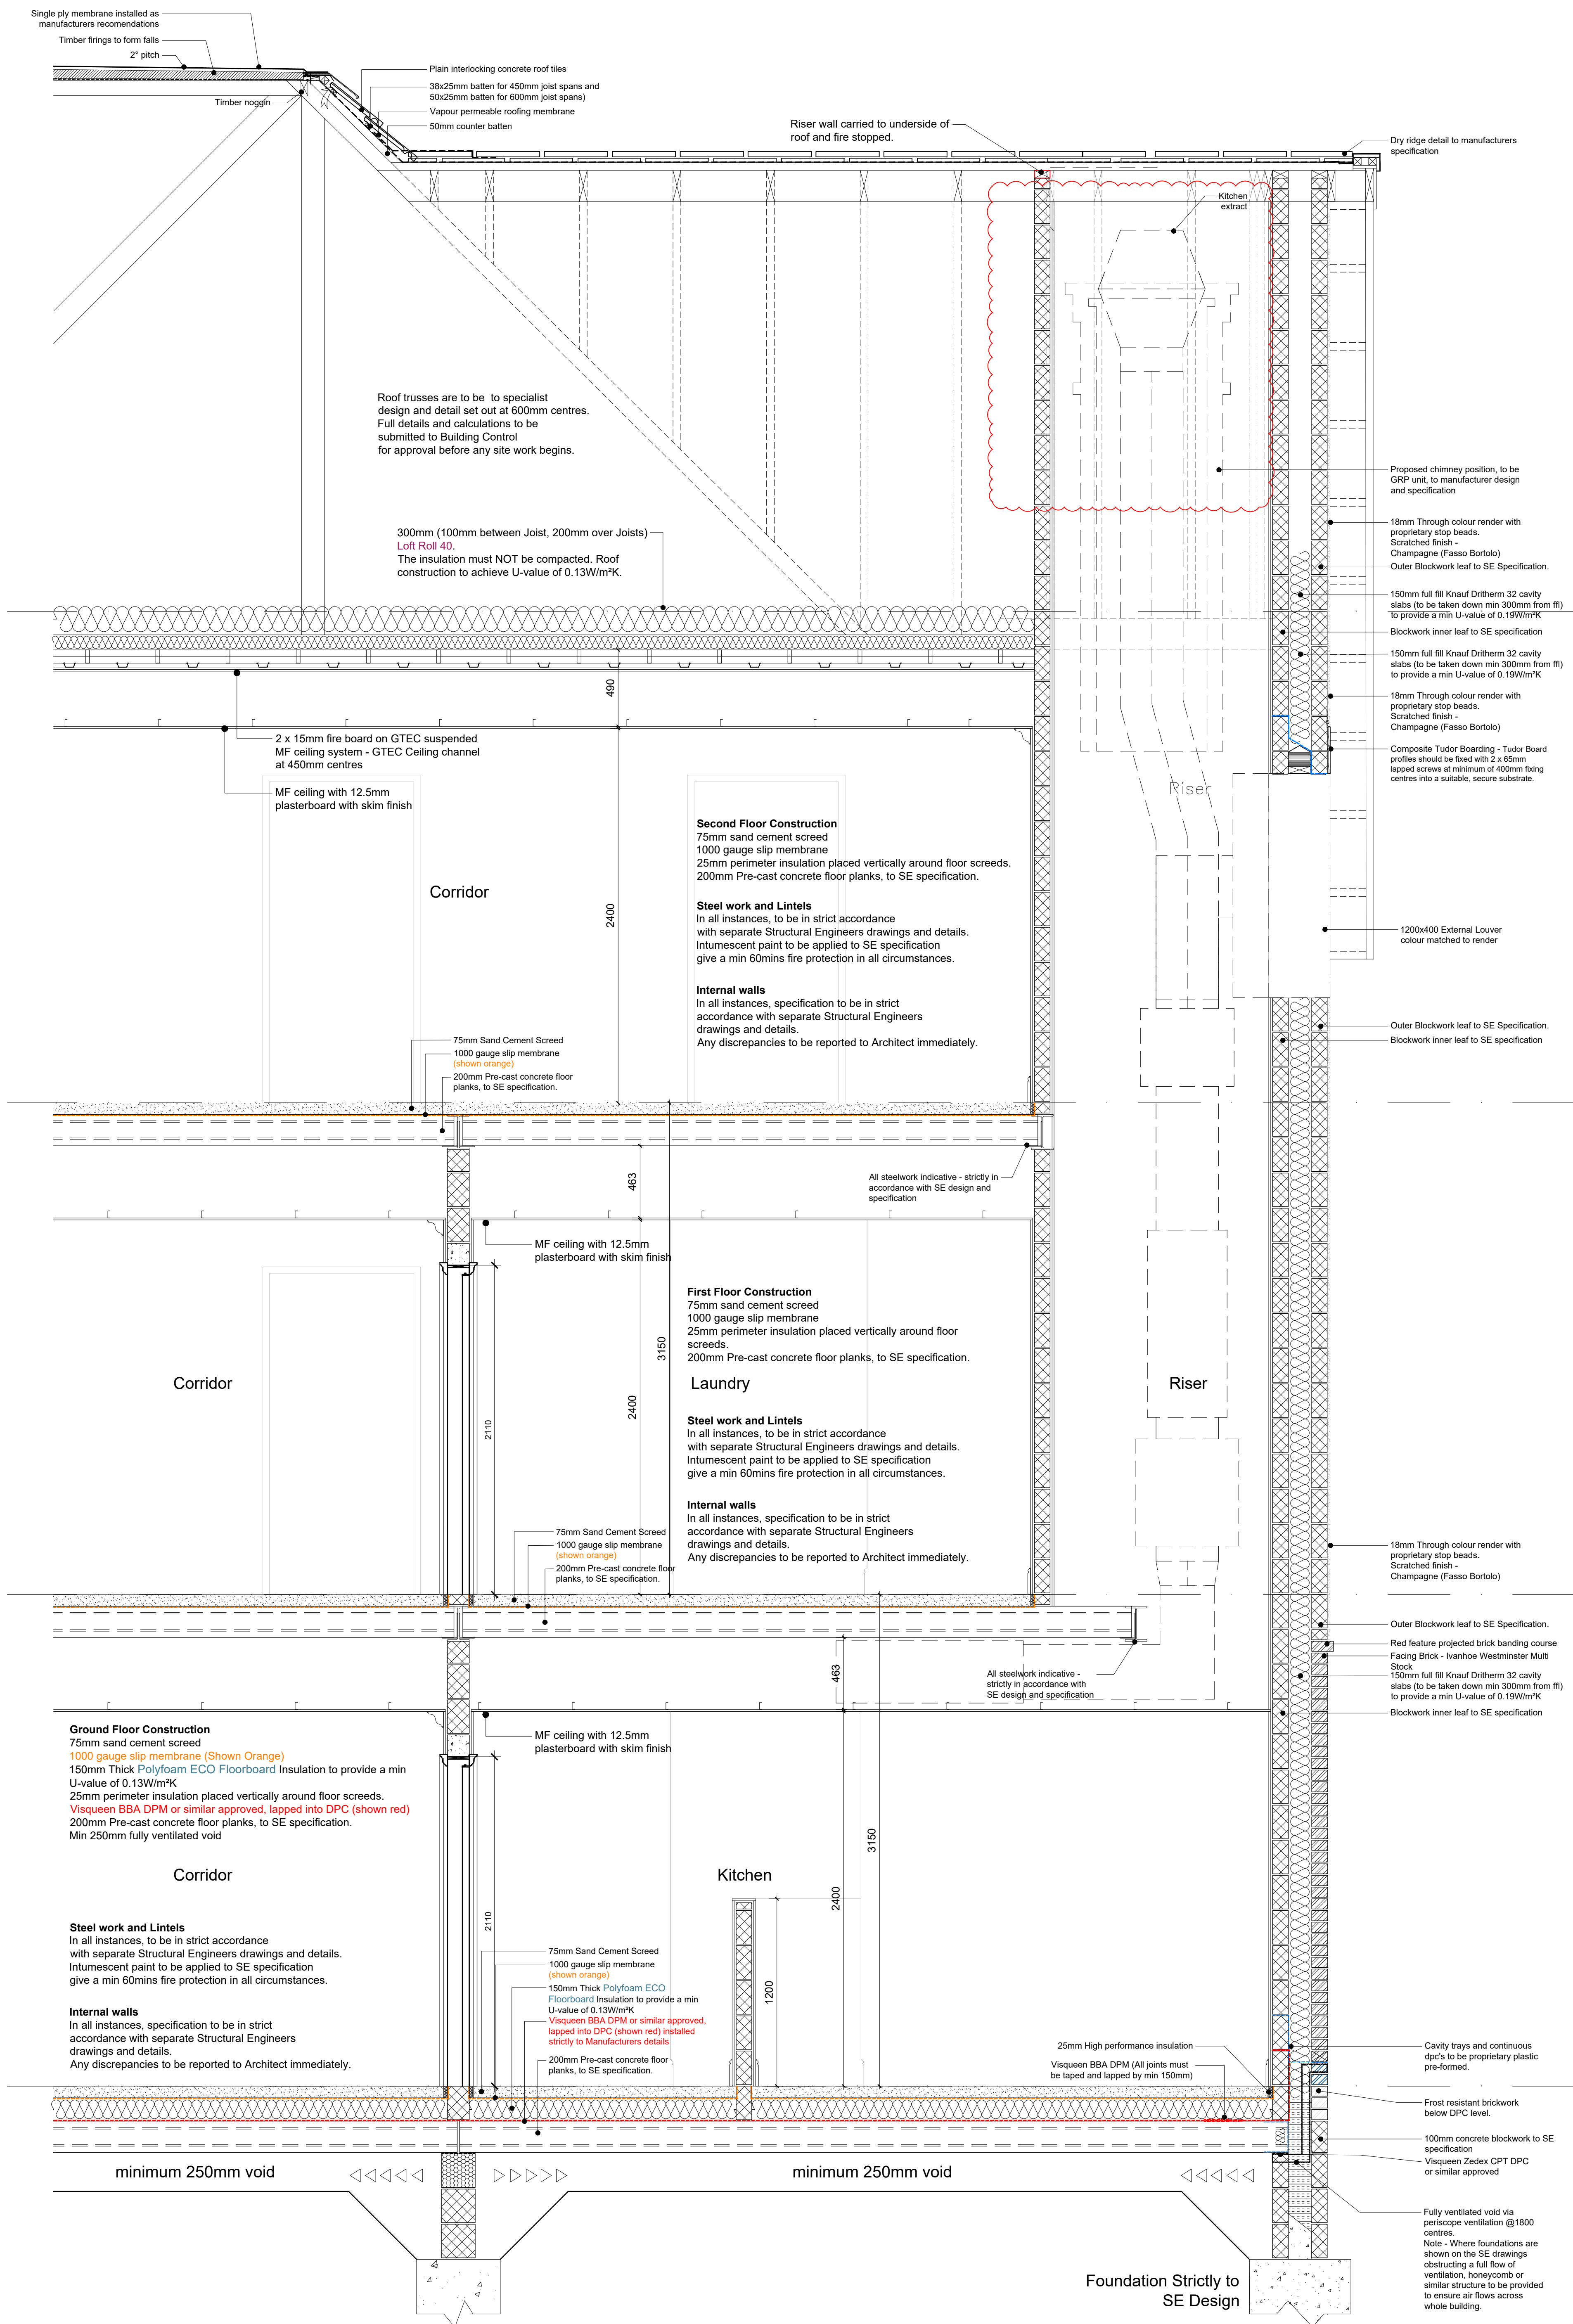

Section H-H

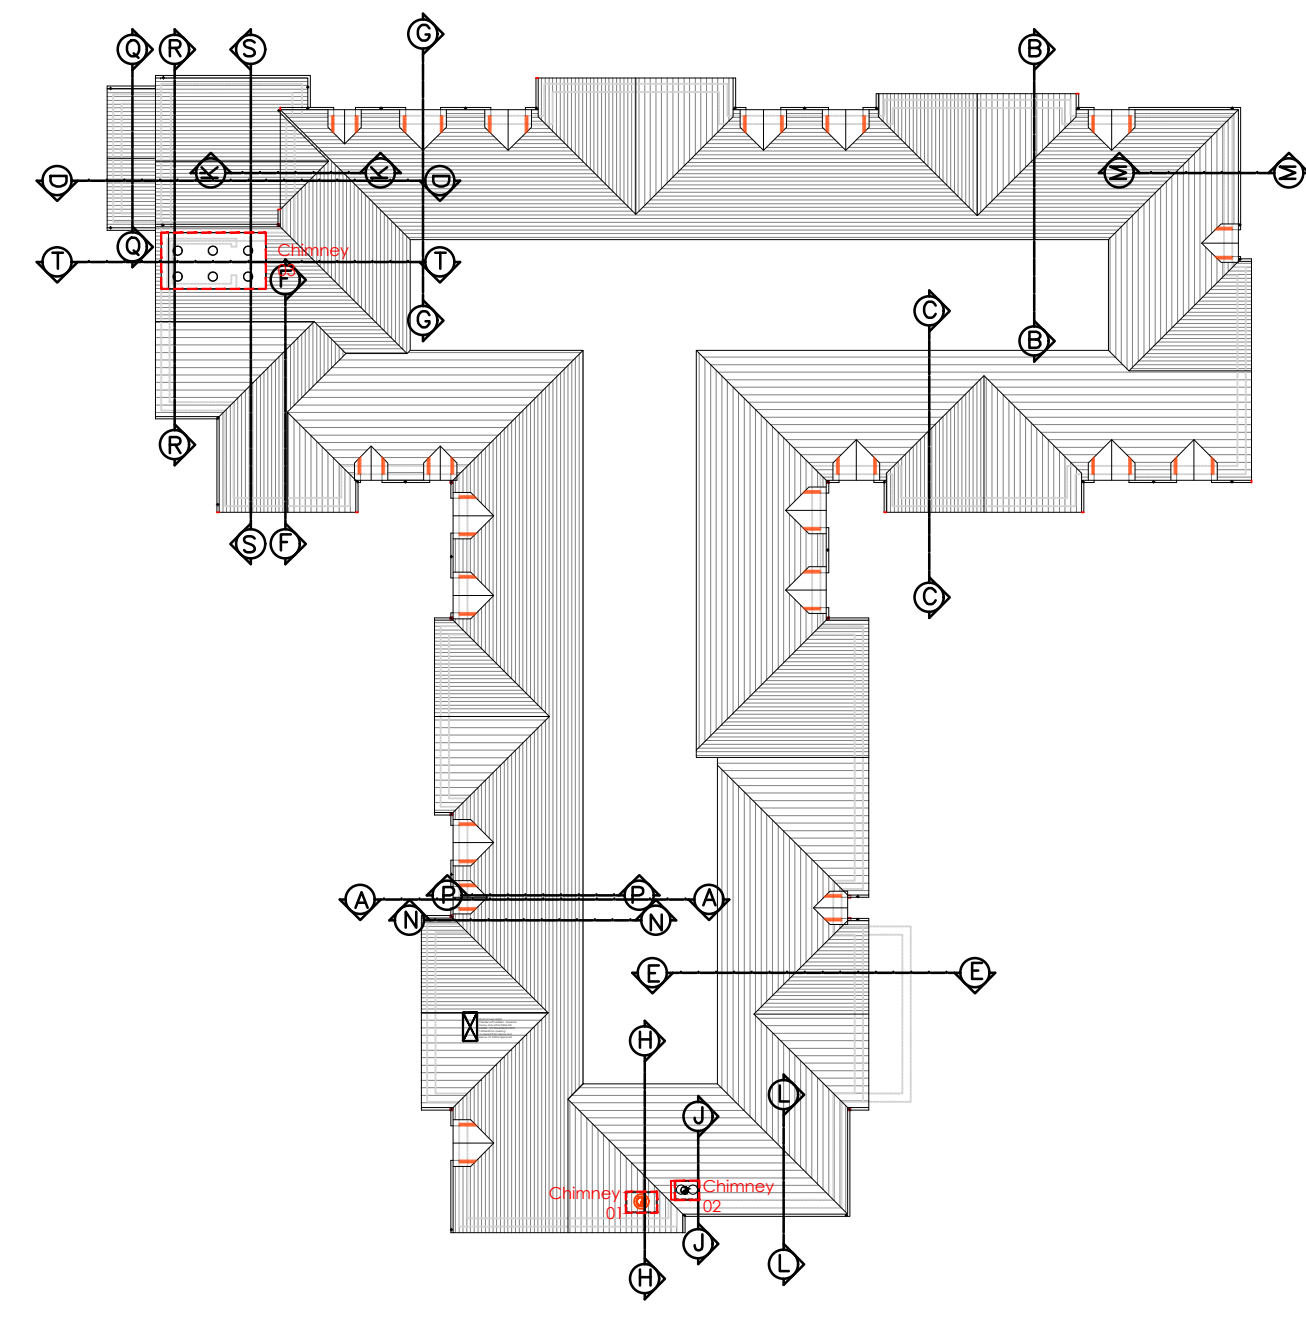

Notes



Do not scale, use figured dimensions only.

All dimensions to be verified on site prior to the commencement of any work or the production of any shop drawing. All discrepancies to be reported to the Architect.

This drawing is to be read in conjunction with all related Architect's and Engineer's drawings and any other relevant information.

This drawing is copyright © of TDC Architects Ltd.

REV	DATE	REVISION	INITIALS	CHECK
A	03.11.23	Riser equipment indicated as per M&E information, riser & chimney positions amended following JTM	TP	RMJB
B	14.01.24	Timber noggin indicated to roof junction	TP	SEL
C	10.04.24	Laundry chimney elevation updated	TP	SEL
D	02.05.24	Indicative chimney height for kitchen riser amended to maximum 3000mm as agreed on site	TP	SEL
E	22.05.24	Fire rated ceiling detail updated	TP	SEL
F	13.06.24	Cowl height reduced	TP	SEL

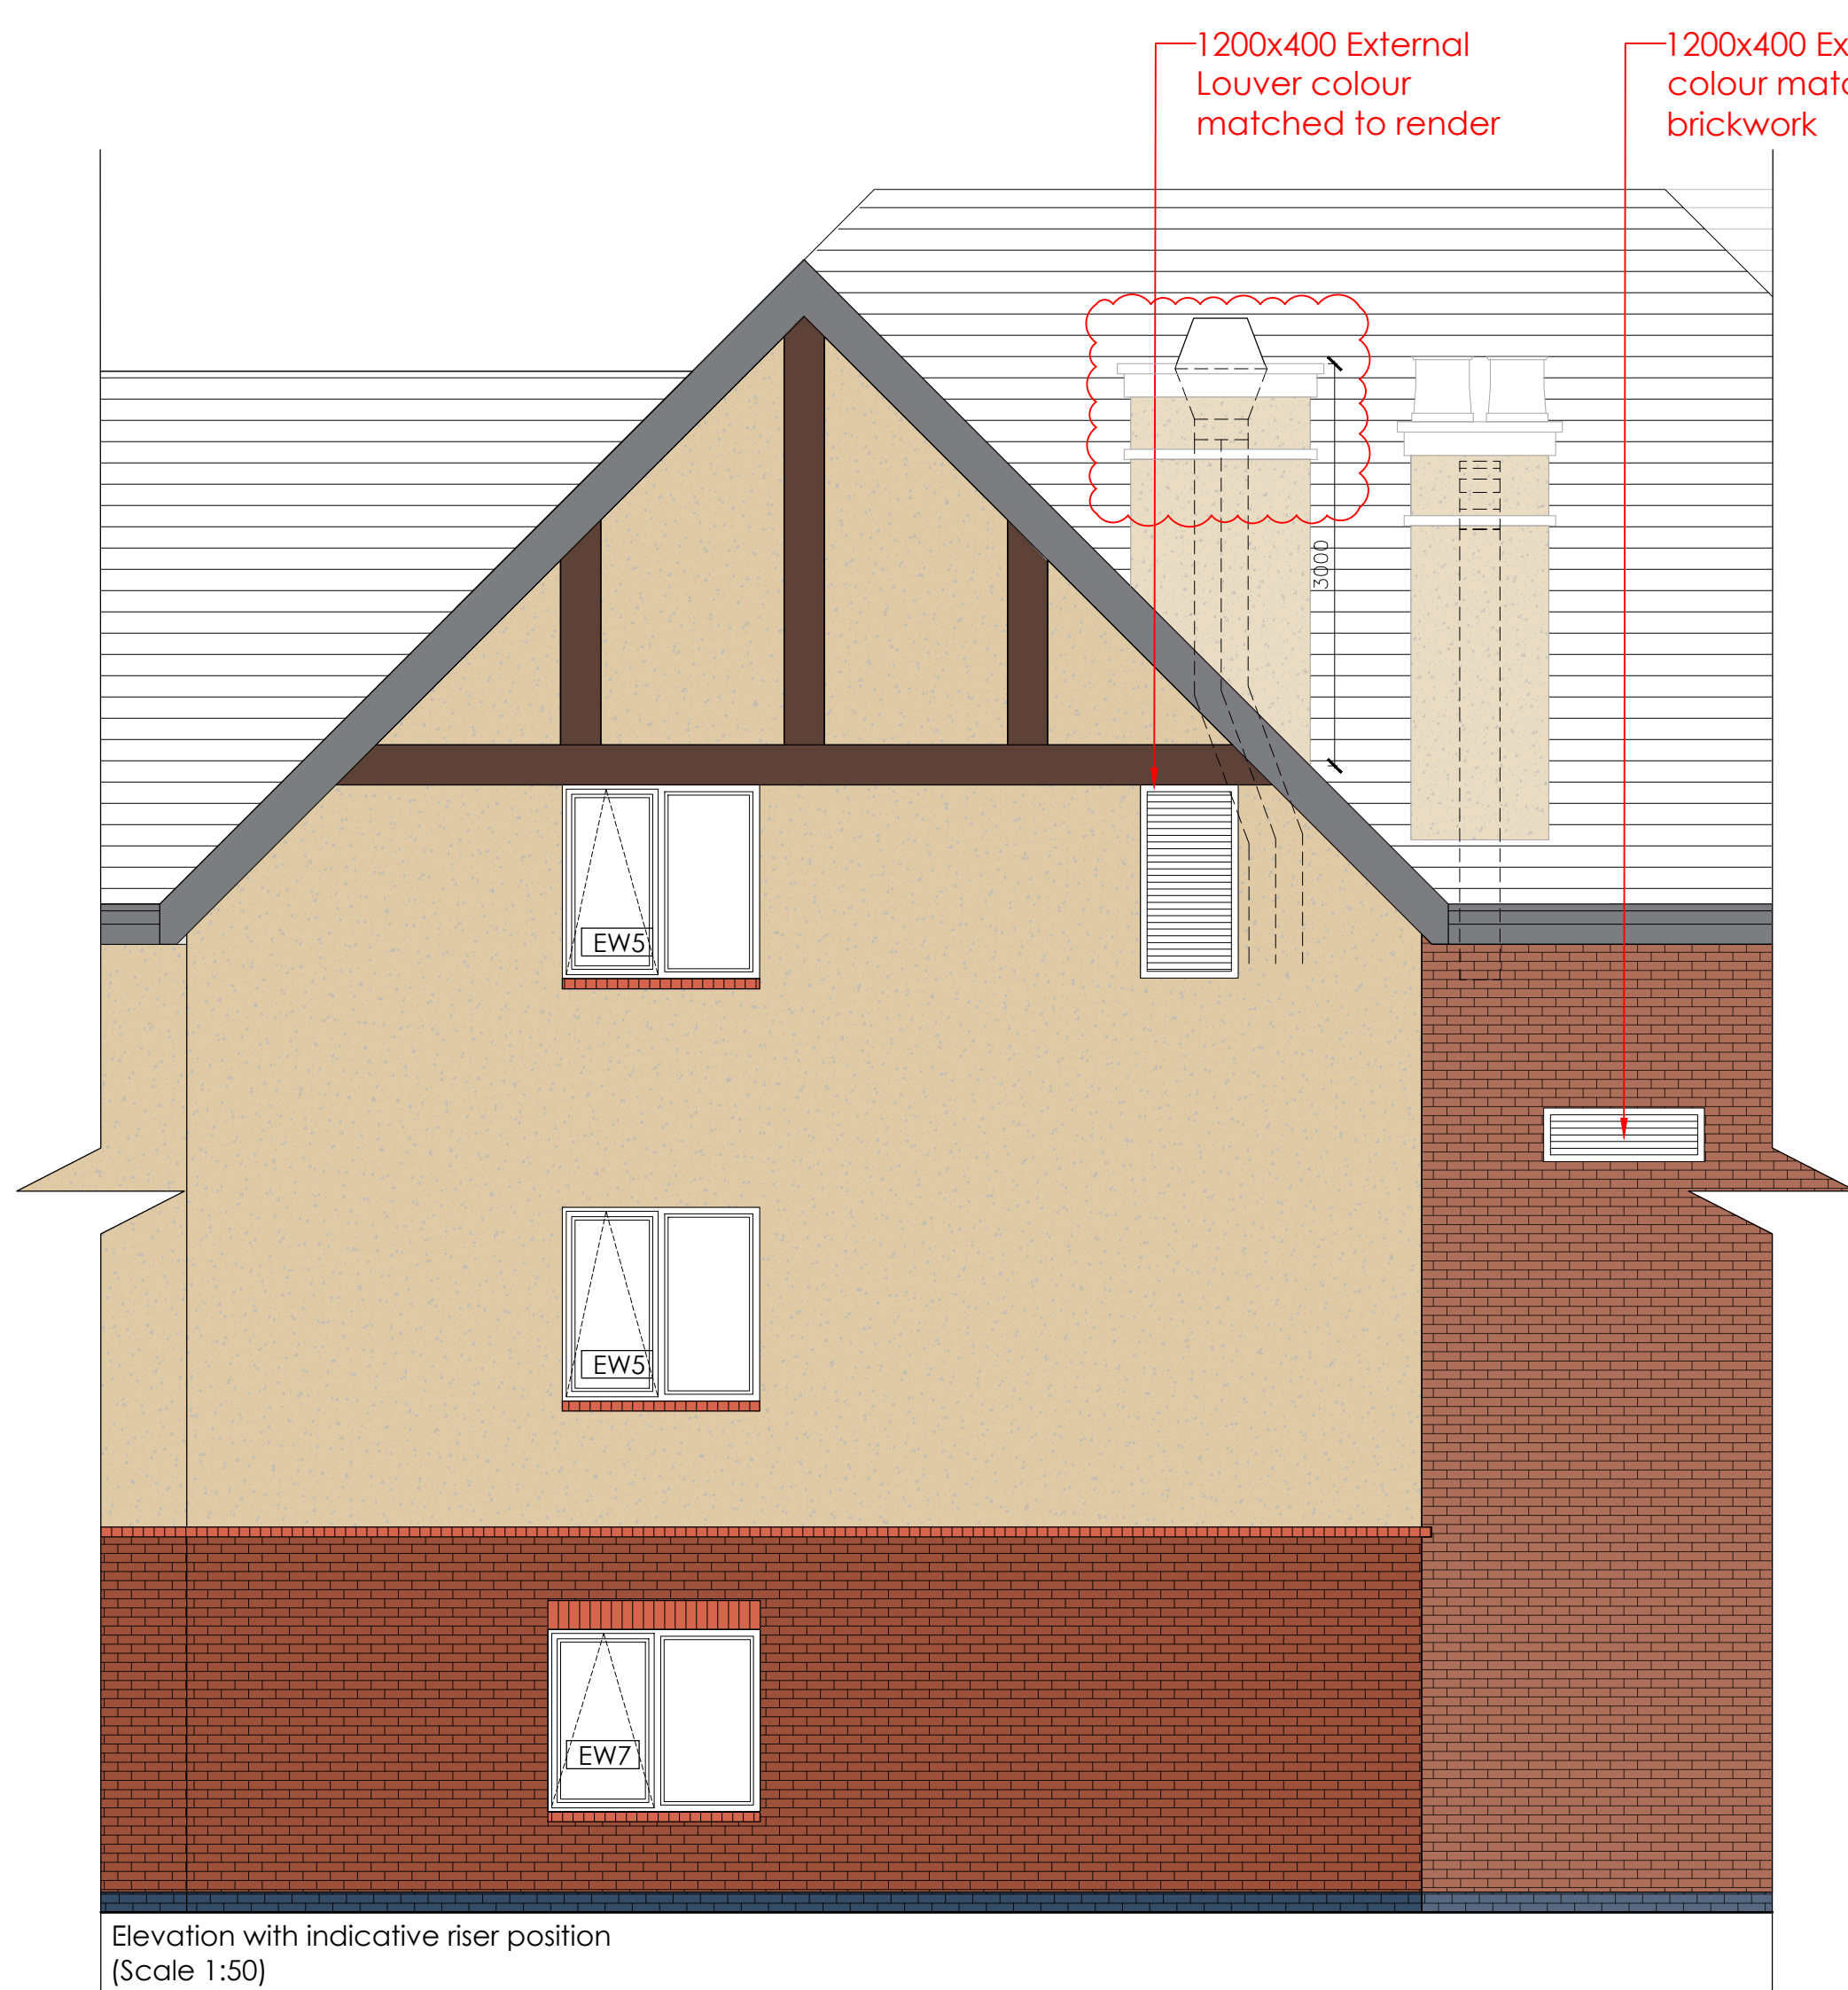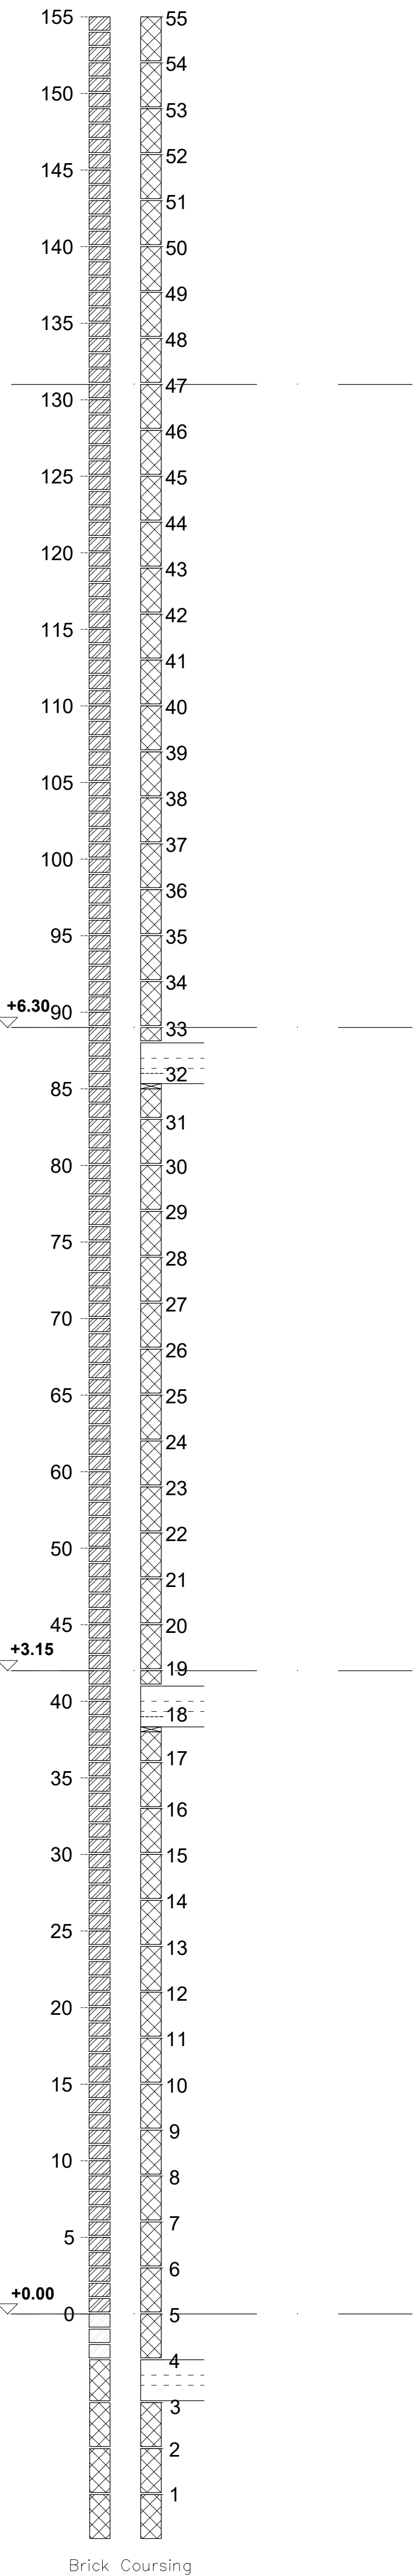

DRAWING STATUS

AS-RECORDED	☐
AS-BUILT	☐
FOR CONSTRUCTION	☒
FOR COORDINATION	☐
FOR PLANNING	☐
FOR DISCUSSION	☐
FOR TENDER	☐

TDC ARCH DESIGN
The Design Collective Architects

2nd Fl. | 13 Museum St.
York | YO1 7JT
info@tdc-arch.design

www.tdc-arch.design

Client

Avery

Project
Proposed Care Home,
Central Avenue, Gravesend

Drawing Title
Section H-H

Scale
1:20 @ A0

Date
October 2023

Drawn by
TP

Checked by
RMJB

Job No.
A202043

Drawing No.
AL(2)217

Rev.
F