



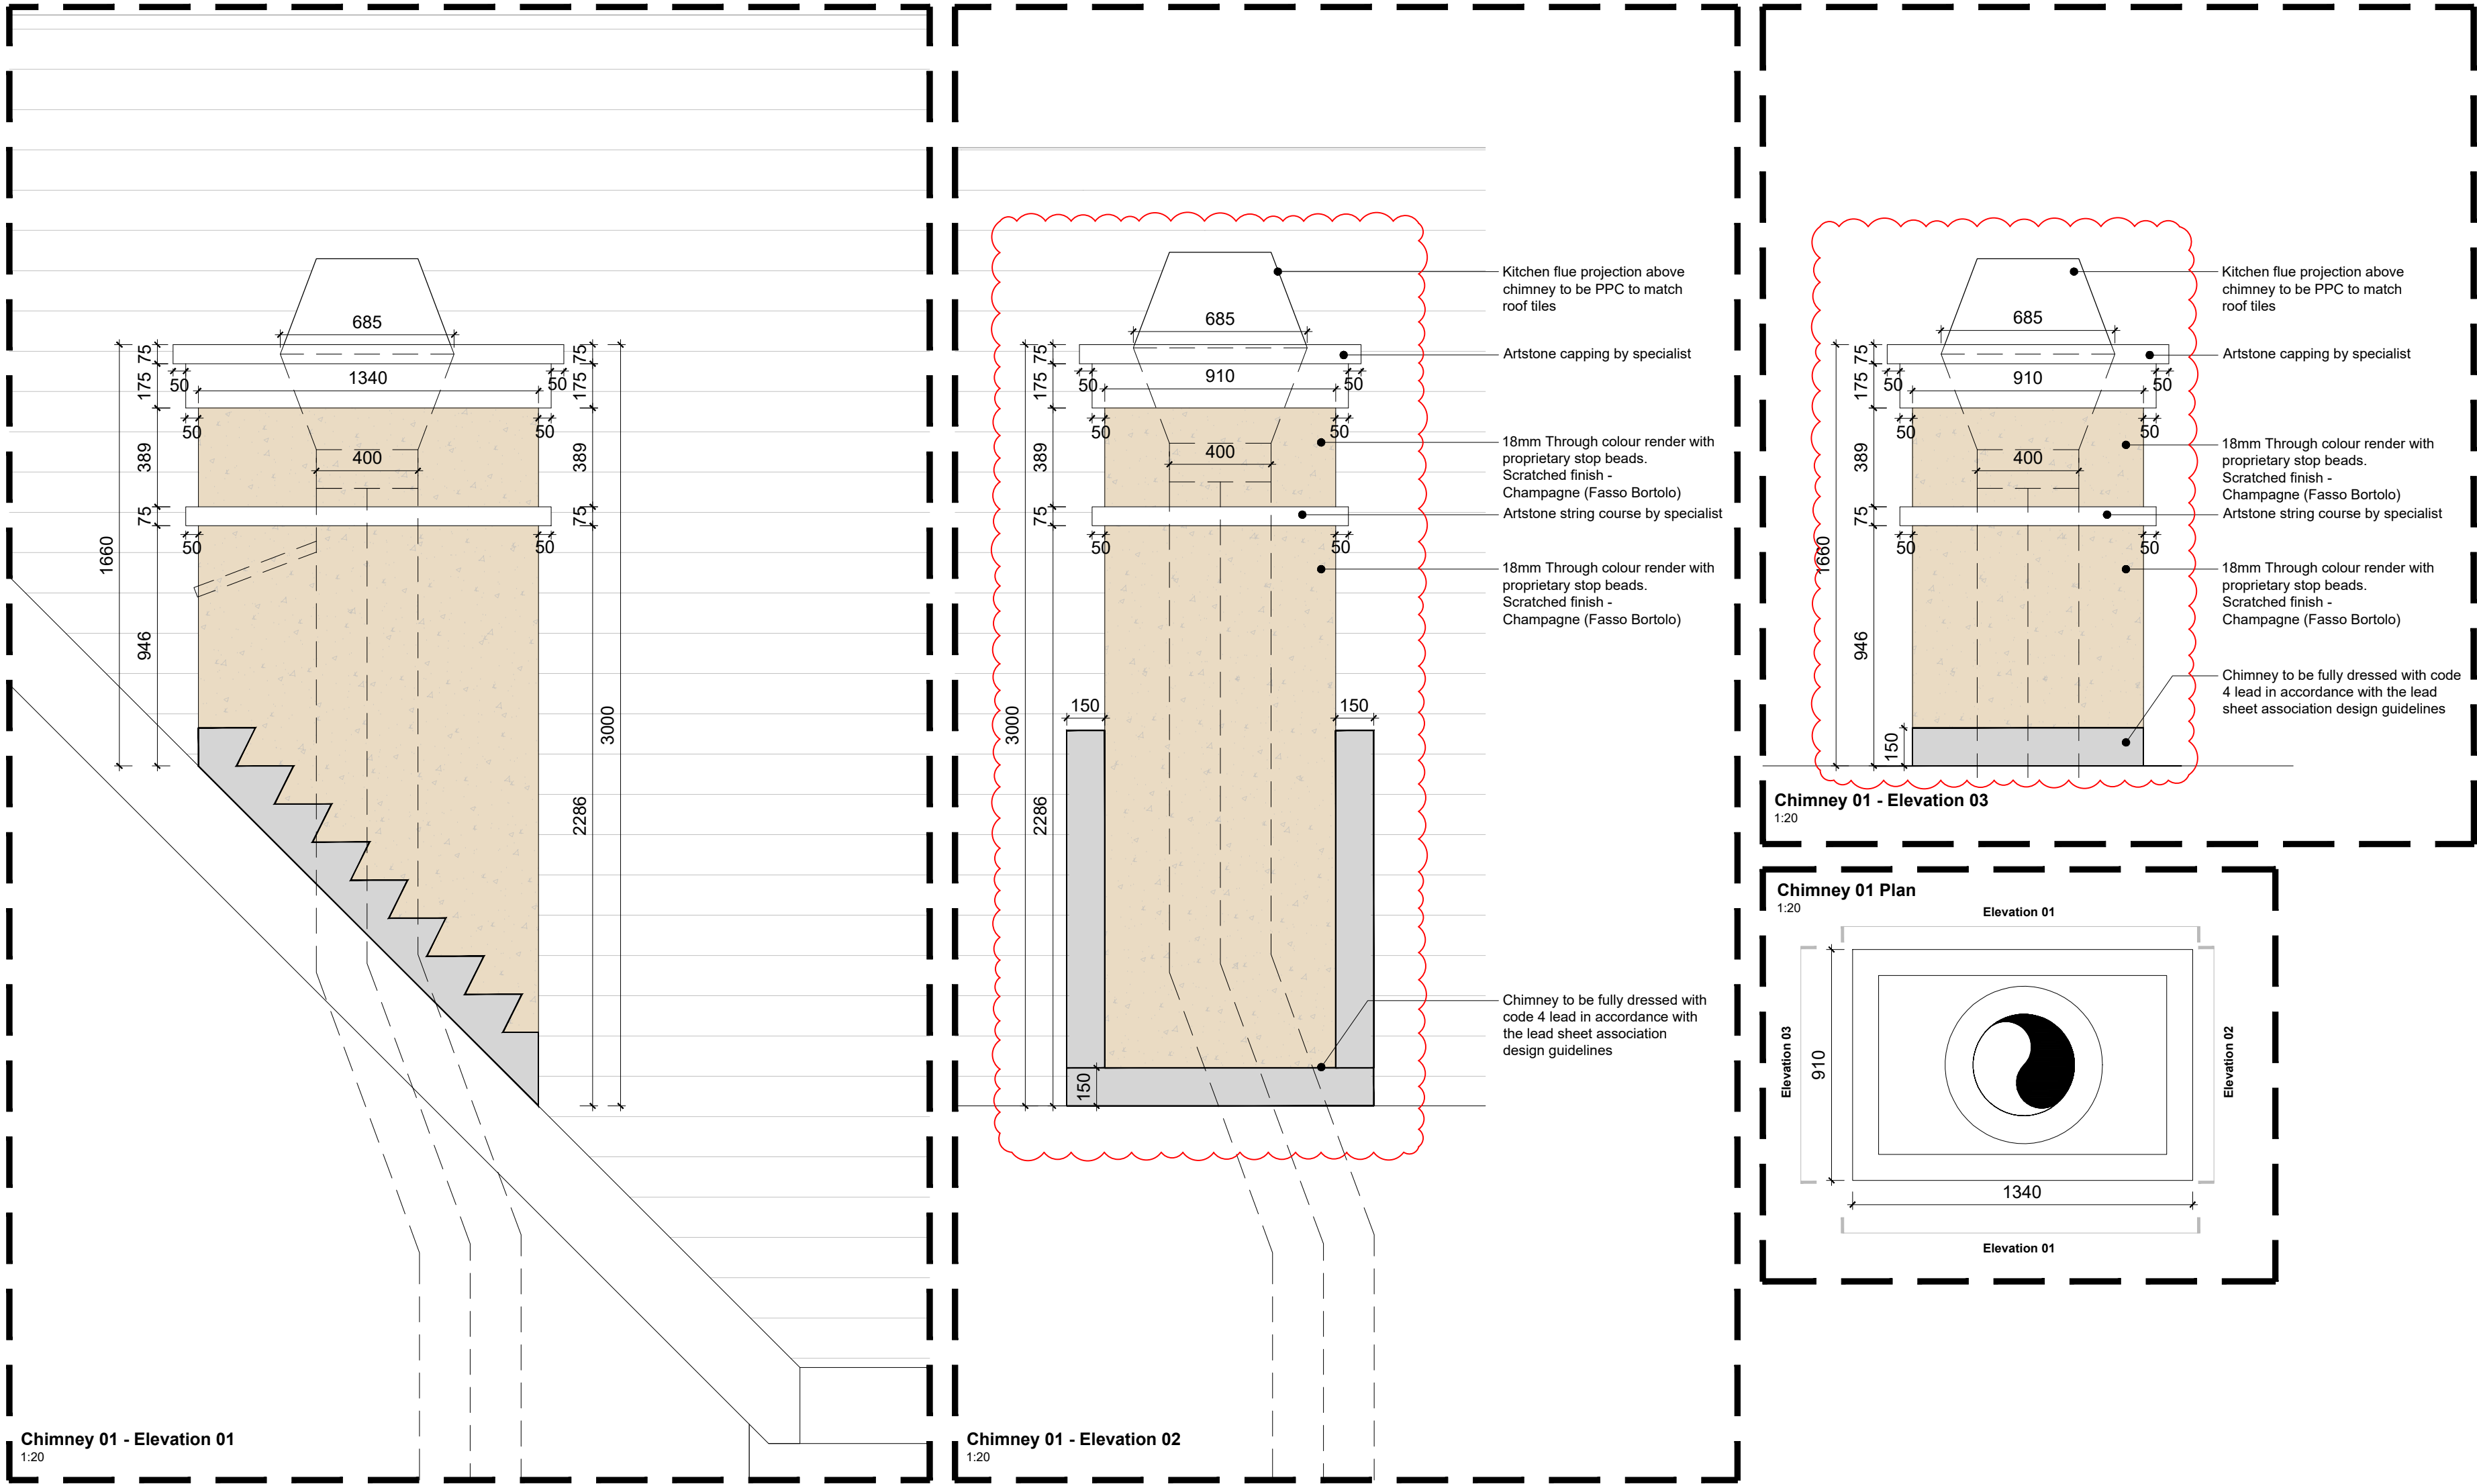

Key Plan (NTS)

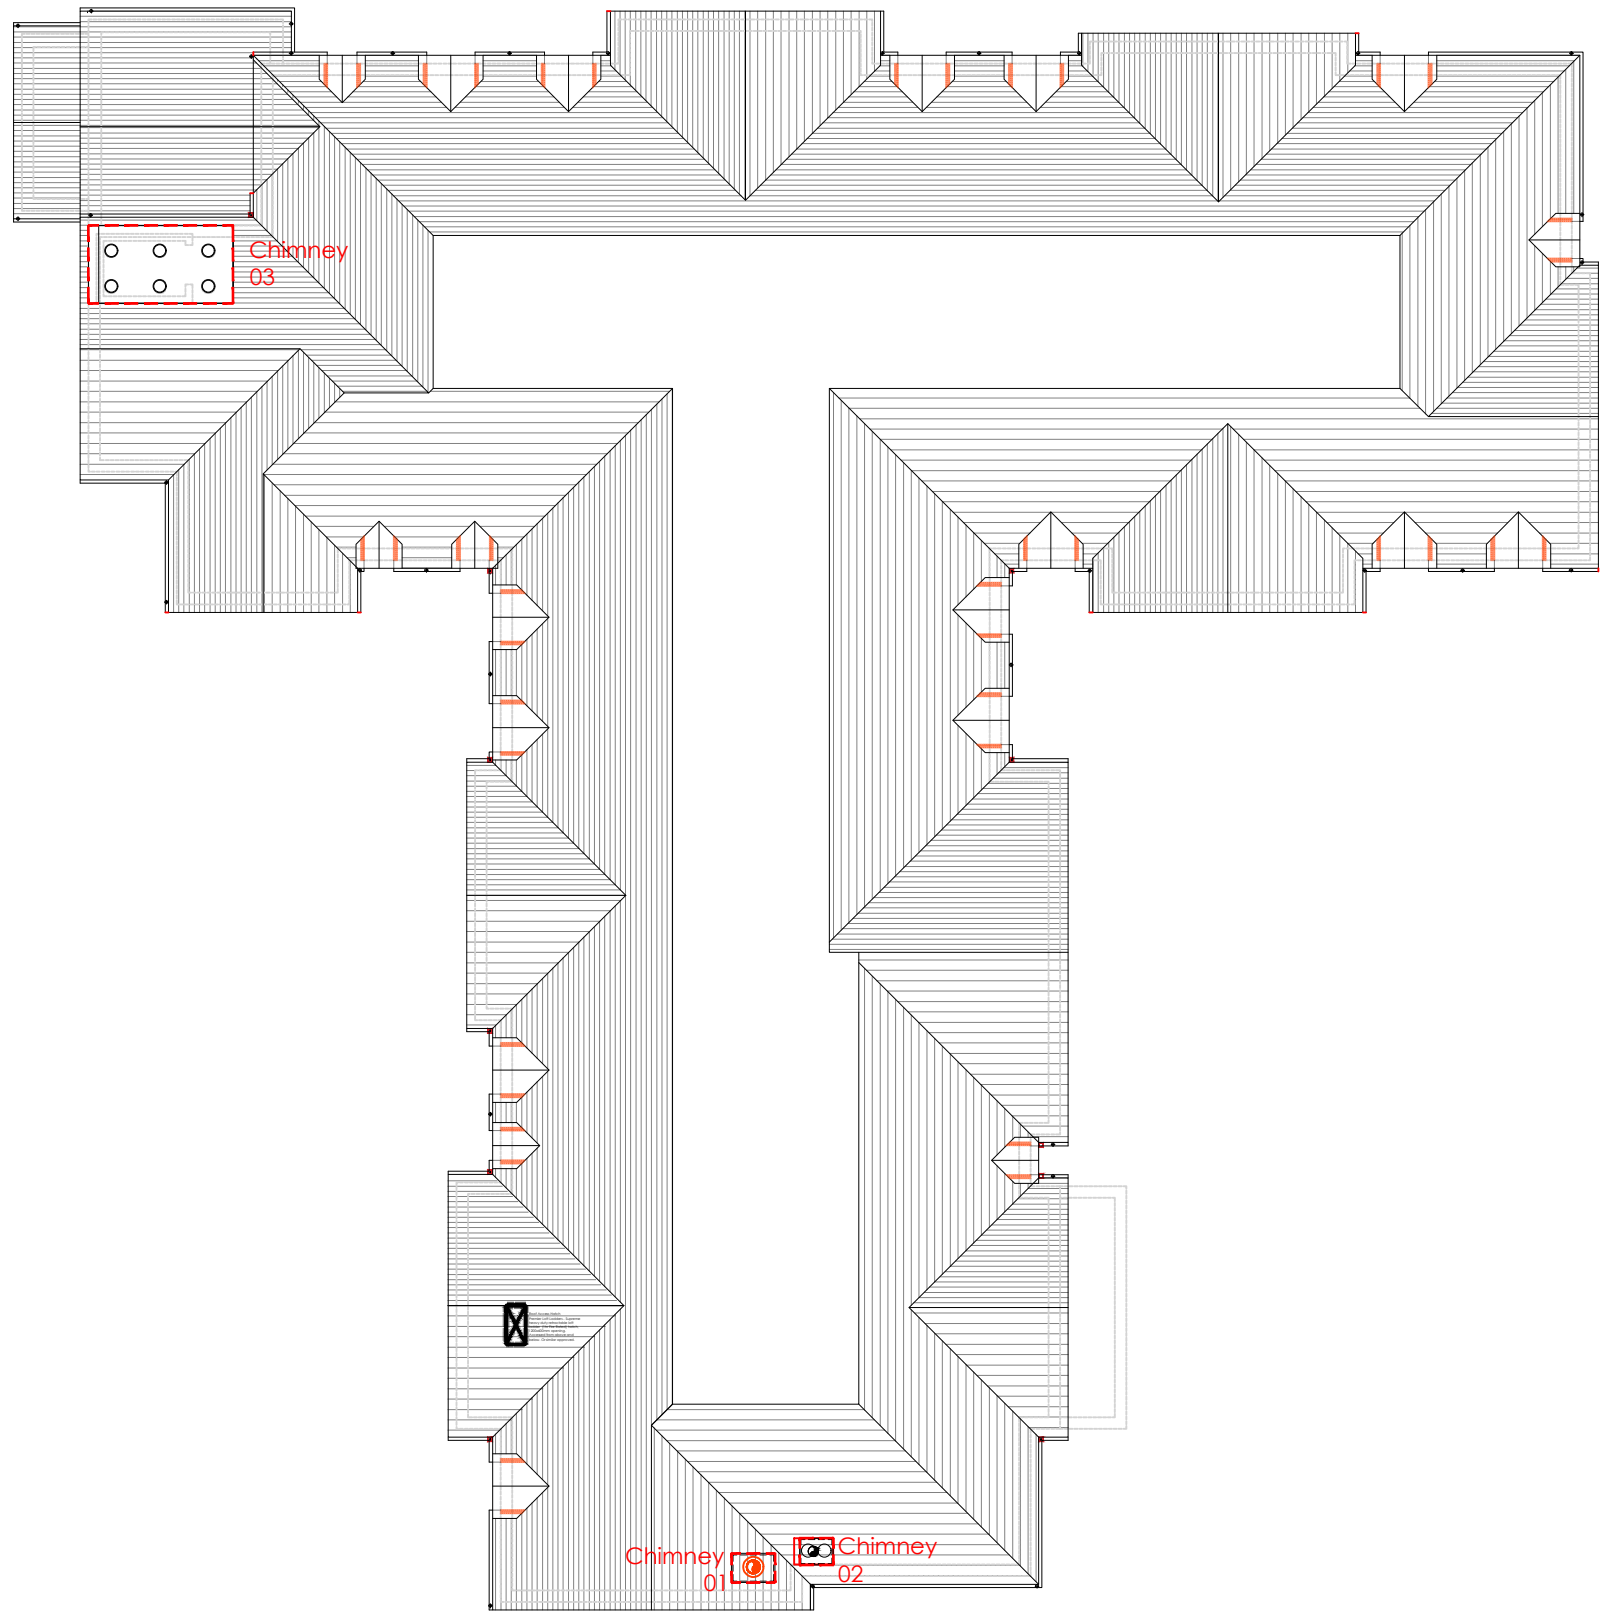

Notes


Do not scale, use figured dimensions only.

All dimensions to be verified on site prior to the commencement of any work or the production of any shop drawing. All discrepancies to be reported to the Architect.

This drawing is to be read in conjunction with all related Architect's and Engineer's drawings and any other relevant information.

This drawing is copyright © of TDC Architects Ltd.

REV	DATE	REVISION	INITIALS	CHECK
A	02.05.2024	Chimney 01 max height adjusted to 3m as discussed agreed on site. chimney 02 flue direction updated to reflect section drawings	TP	SEL
B	13.06.2024	Chimney dimensions updated to reflect as built on site. Chimney 1 cowl height reduced. Chimney 2 flue pipe direction updated as per M&E design	TP	SEL

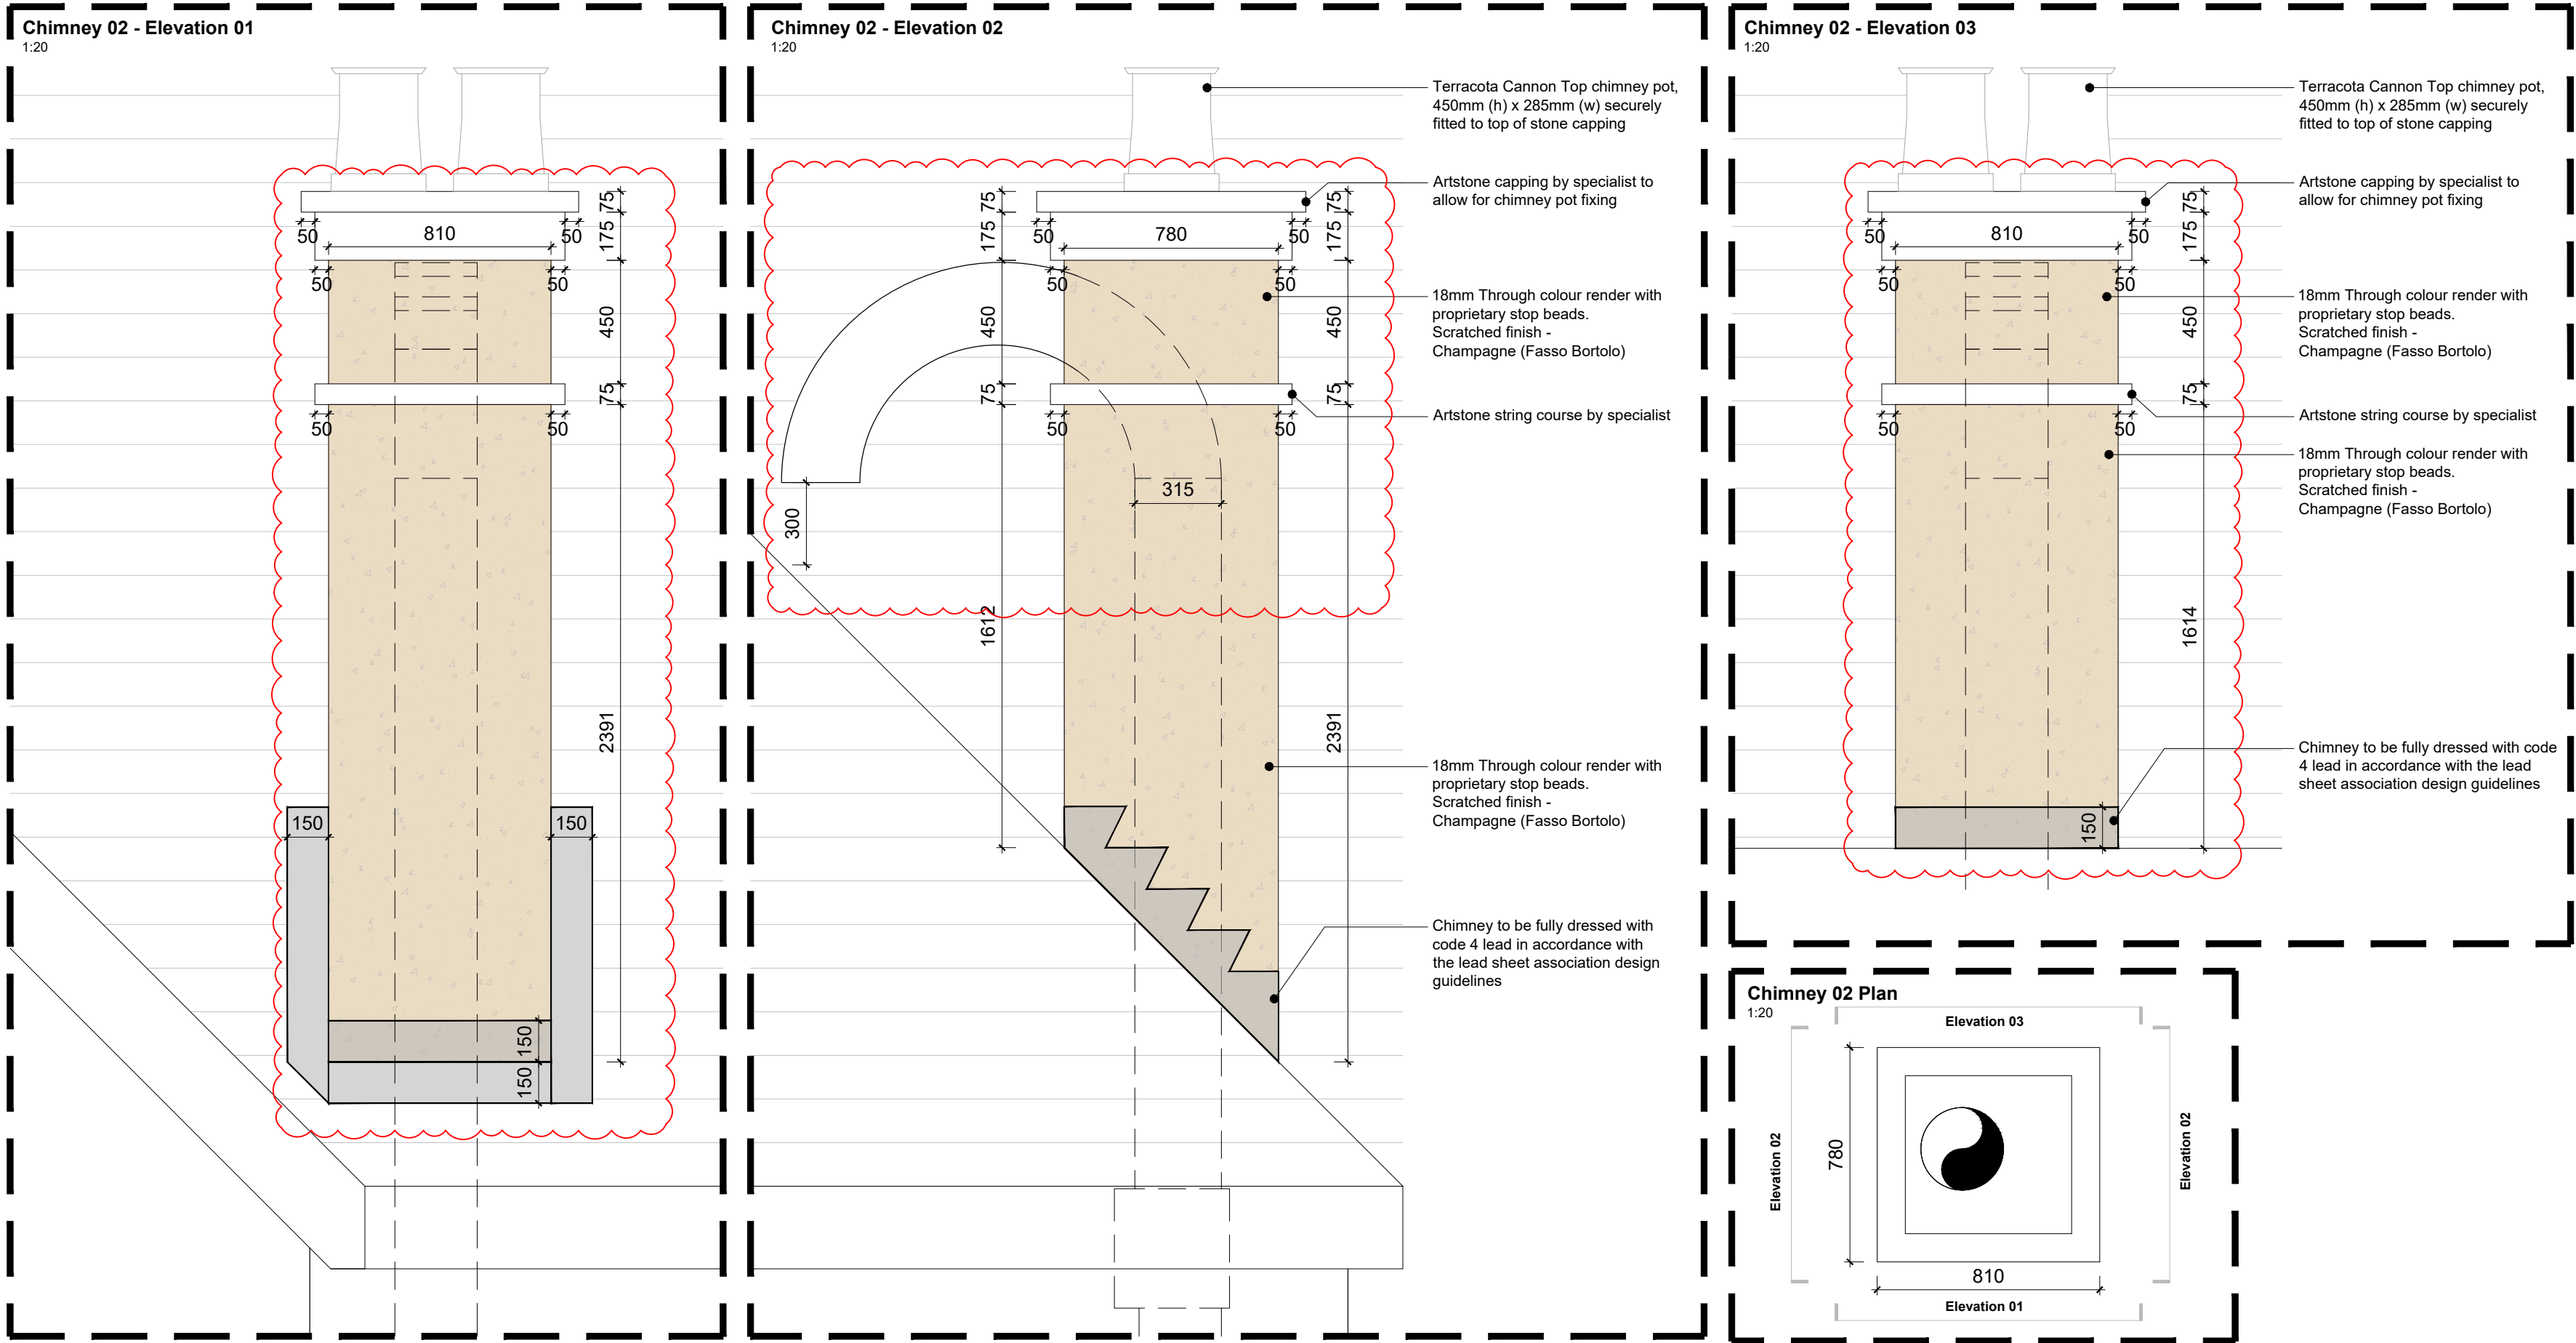

DRAWING STATUS

AS-RECORDED	☐
AS-BUILT	☐
FOR CONSTRUCTION	☒
FOR COORDINATION	☐
FOR PLANNING	☐
FOR DISCUSSION	☐
FOR TENDER	☐

TDC ARCH DESIGN
The Design Collective Architects

2nd Fl. | 13 Museum St.
York | YO1 7JT
info@tdc-arch.design

www.tdc-arch.design



Project
Proposed Care Home,
Central Avenue, Gravesend

Drawing Title
Typical Building Details 08
Chimney Details

Scale
1:20 @ A1

Date
April 2024

Drawn by
TP

Checked by
RMJB

Job No.
A202043

Drawing No.
AL(2)257

Rev.
B