




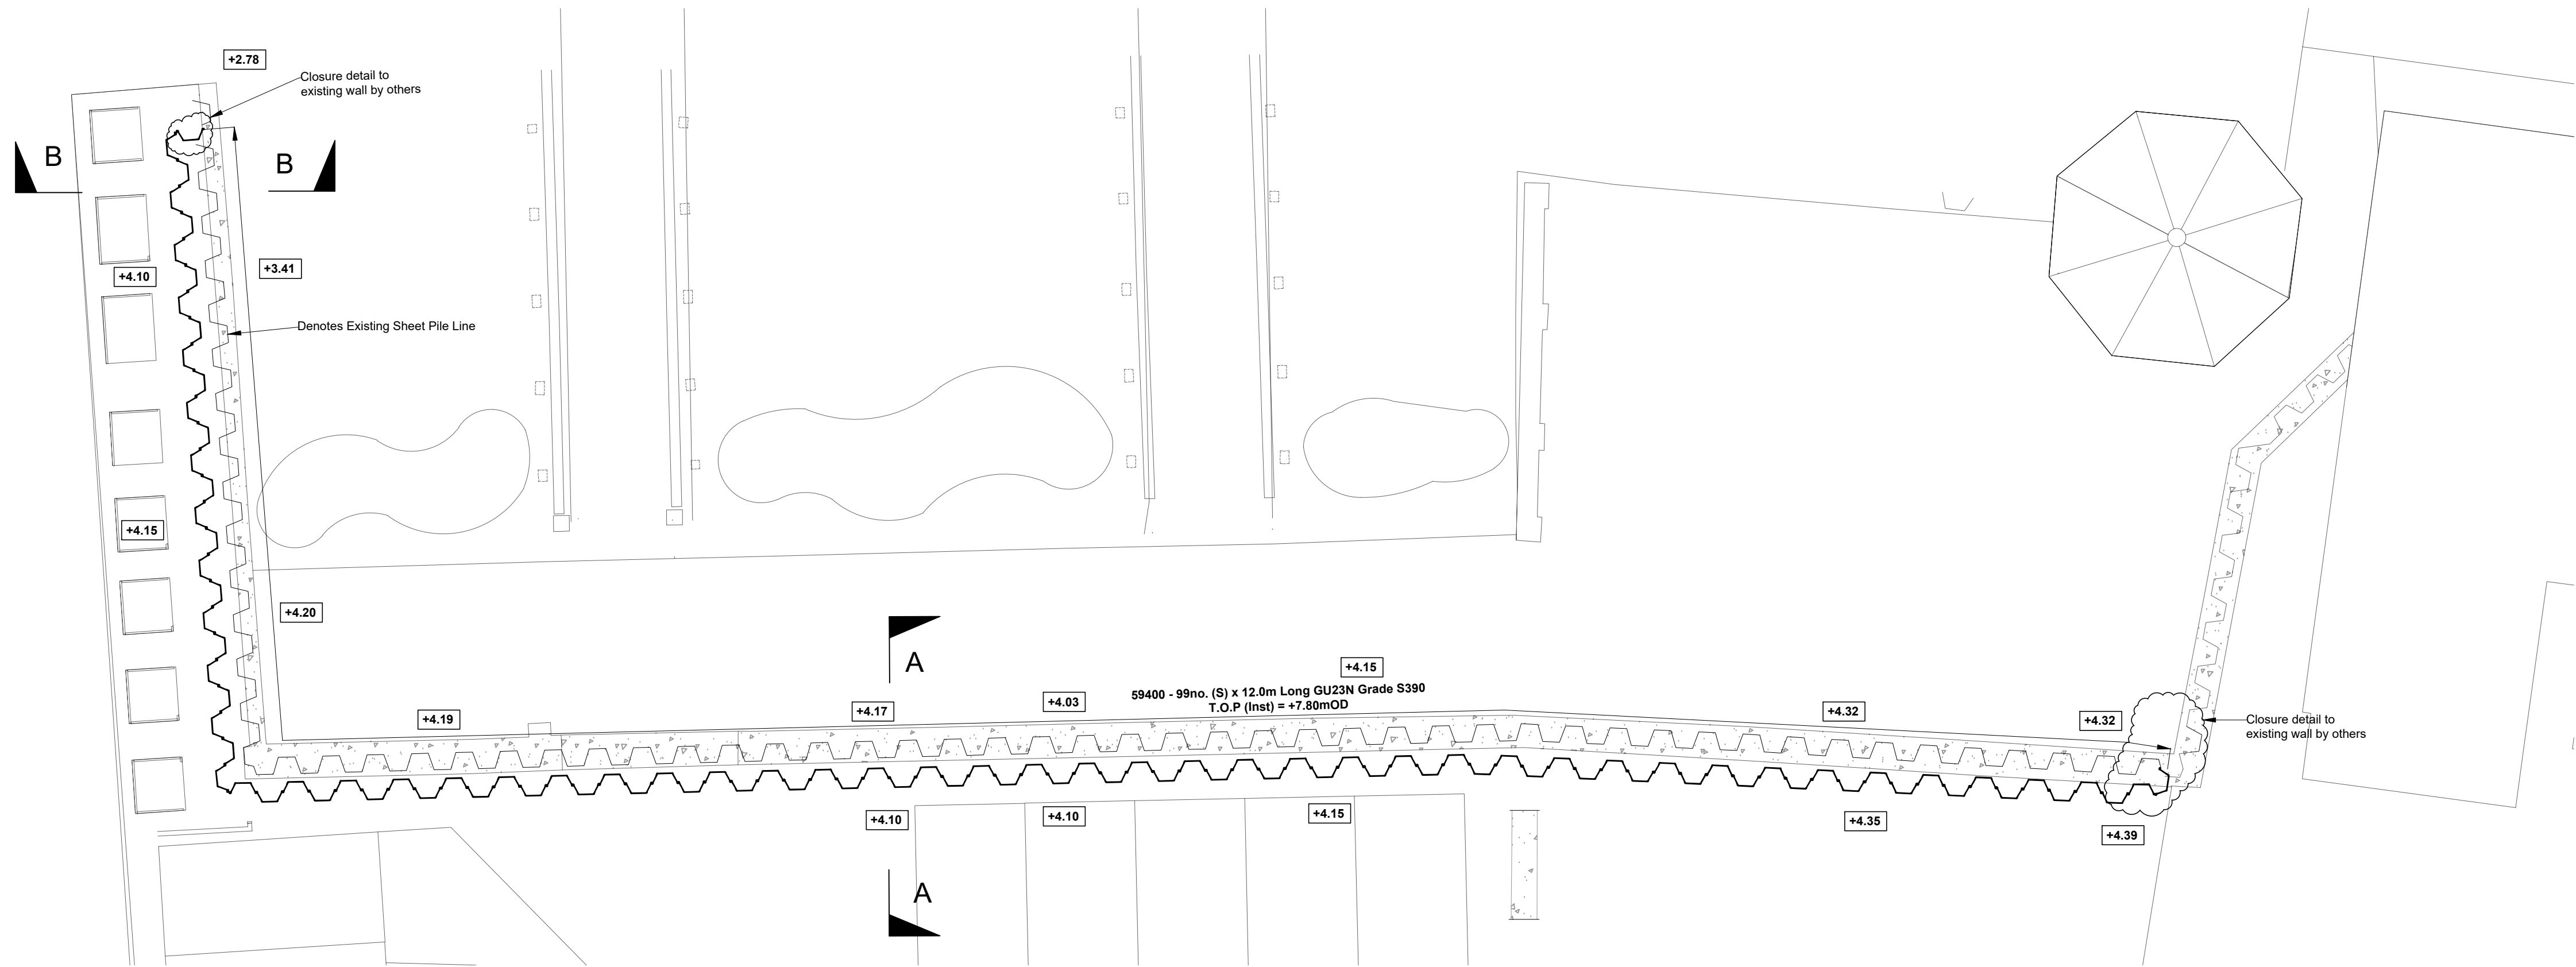


PERMANENT SHEET PILE GENERAL ARRANGEMENT
Scale 1:100

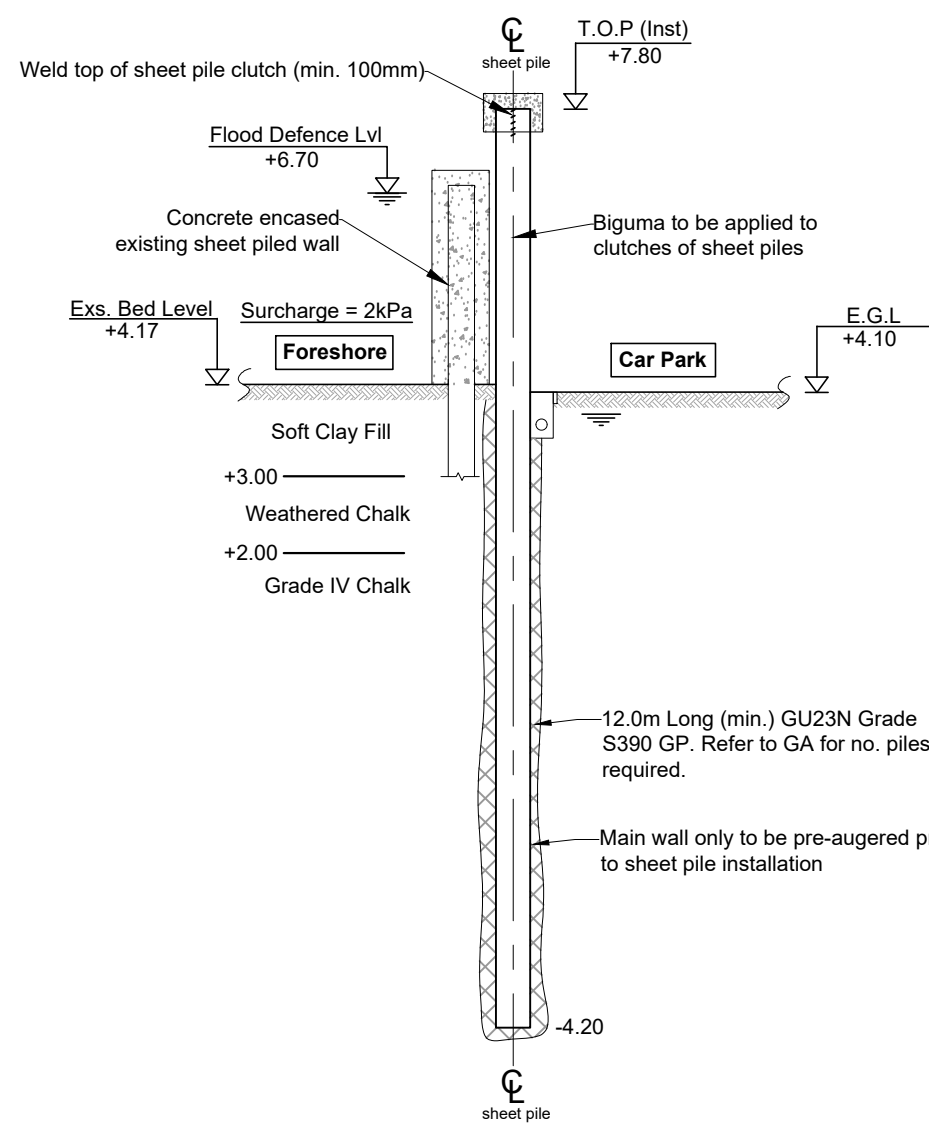

DESIGN SECTION A-A (DS/1)
Scale 1:100

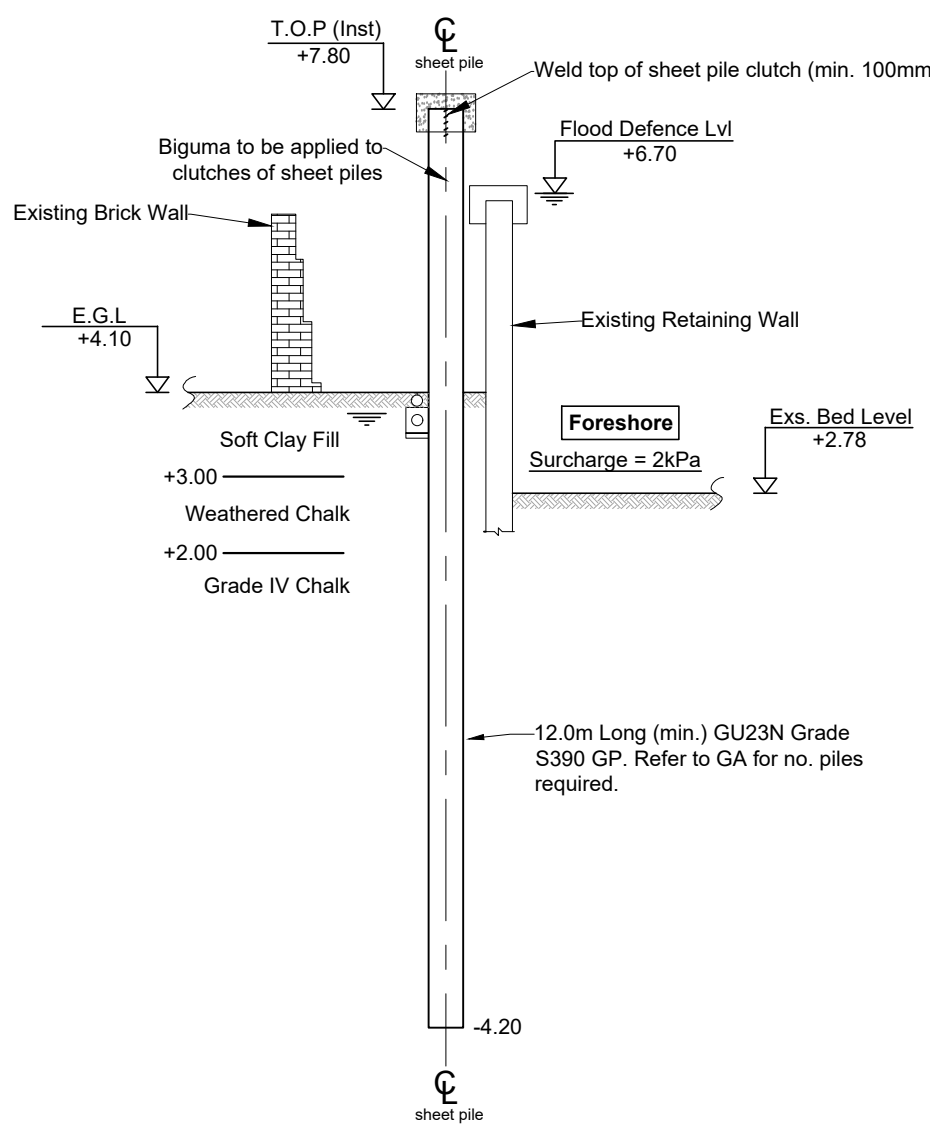

DESIGN SECTION B-B (DS/2)
Scale 1:100

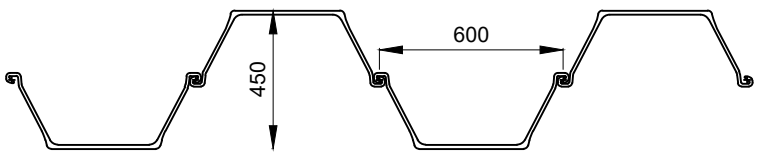

GU23N
Scale 1:25

- GENERAL NOTES**
- SEE ALSO SPUK METHOD STATEMENT
 - SEE ALSO SPUK DESIGN REPORT
 - SETTING OUT BY OTHERS
 - PILE NUMBERS, WALL PLAN LENGTHS AND PILE ORIENTATIONS INDICATED ARE INDICATIVE ONLY AND ARE SUBJECT TO ROLLING AND INSTALLATION TOLERANCES BELOW:
 - 75mm PLAN POSITION FROM GIVEN LINE AT COMMENCEMENT LEVEL
 - 50mm VERTICALITY OF SPECIFIED PILE HEAD LEVEL
 - MAXIMUM 1:75 RAKE IN VERTICALITY
 - BACKFILL TO BE CLEAN IMPORTED 6N/6P PLACED AND COMPACTED IN LAYERS NOT EXCEEDING 250mm IN ACCORDANCE WITH "SPECIFICATION FOR HIGHWAYS WORKS".

AB1	30/10/2025	"AS BUILT" ISSUE	ADR
-----	------------	------------------	-----

Client :
DDS CONTRACTING

Project :
CUSTOM HOUSE, GRAVESEND

Drawing Title :
**PERMANENT SHEET PILE
GENERAL ARRANGEMENT AND
DETAILS**

OCT 2025	Scale @ A1 : SHOWN	Drawn by : ADR	Checked : SD
ORIGINAL SIZE A1	Drawing No. C1877-SPUK-GRA-DRG-001	Revision : AB01	

Unit C, Clayton Green Business Park, Library Road,
Clayton-Le-Woods, Chorley, Lancashire, PR6 7EN
Telephone: 01772 794141
Facsimile: 01772 795151
E-Mail: enquires@sheetpilinguk.com
Web: www.sheetpilinguk.com



AS BUILT