



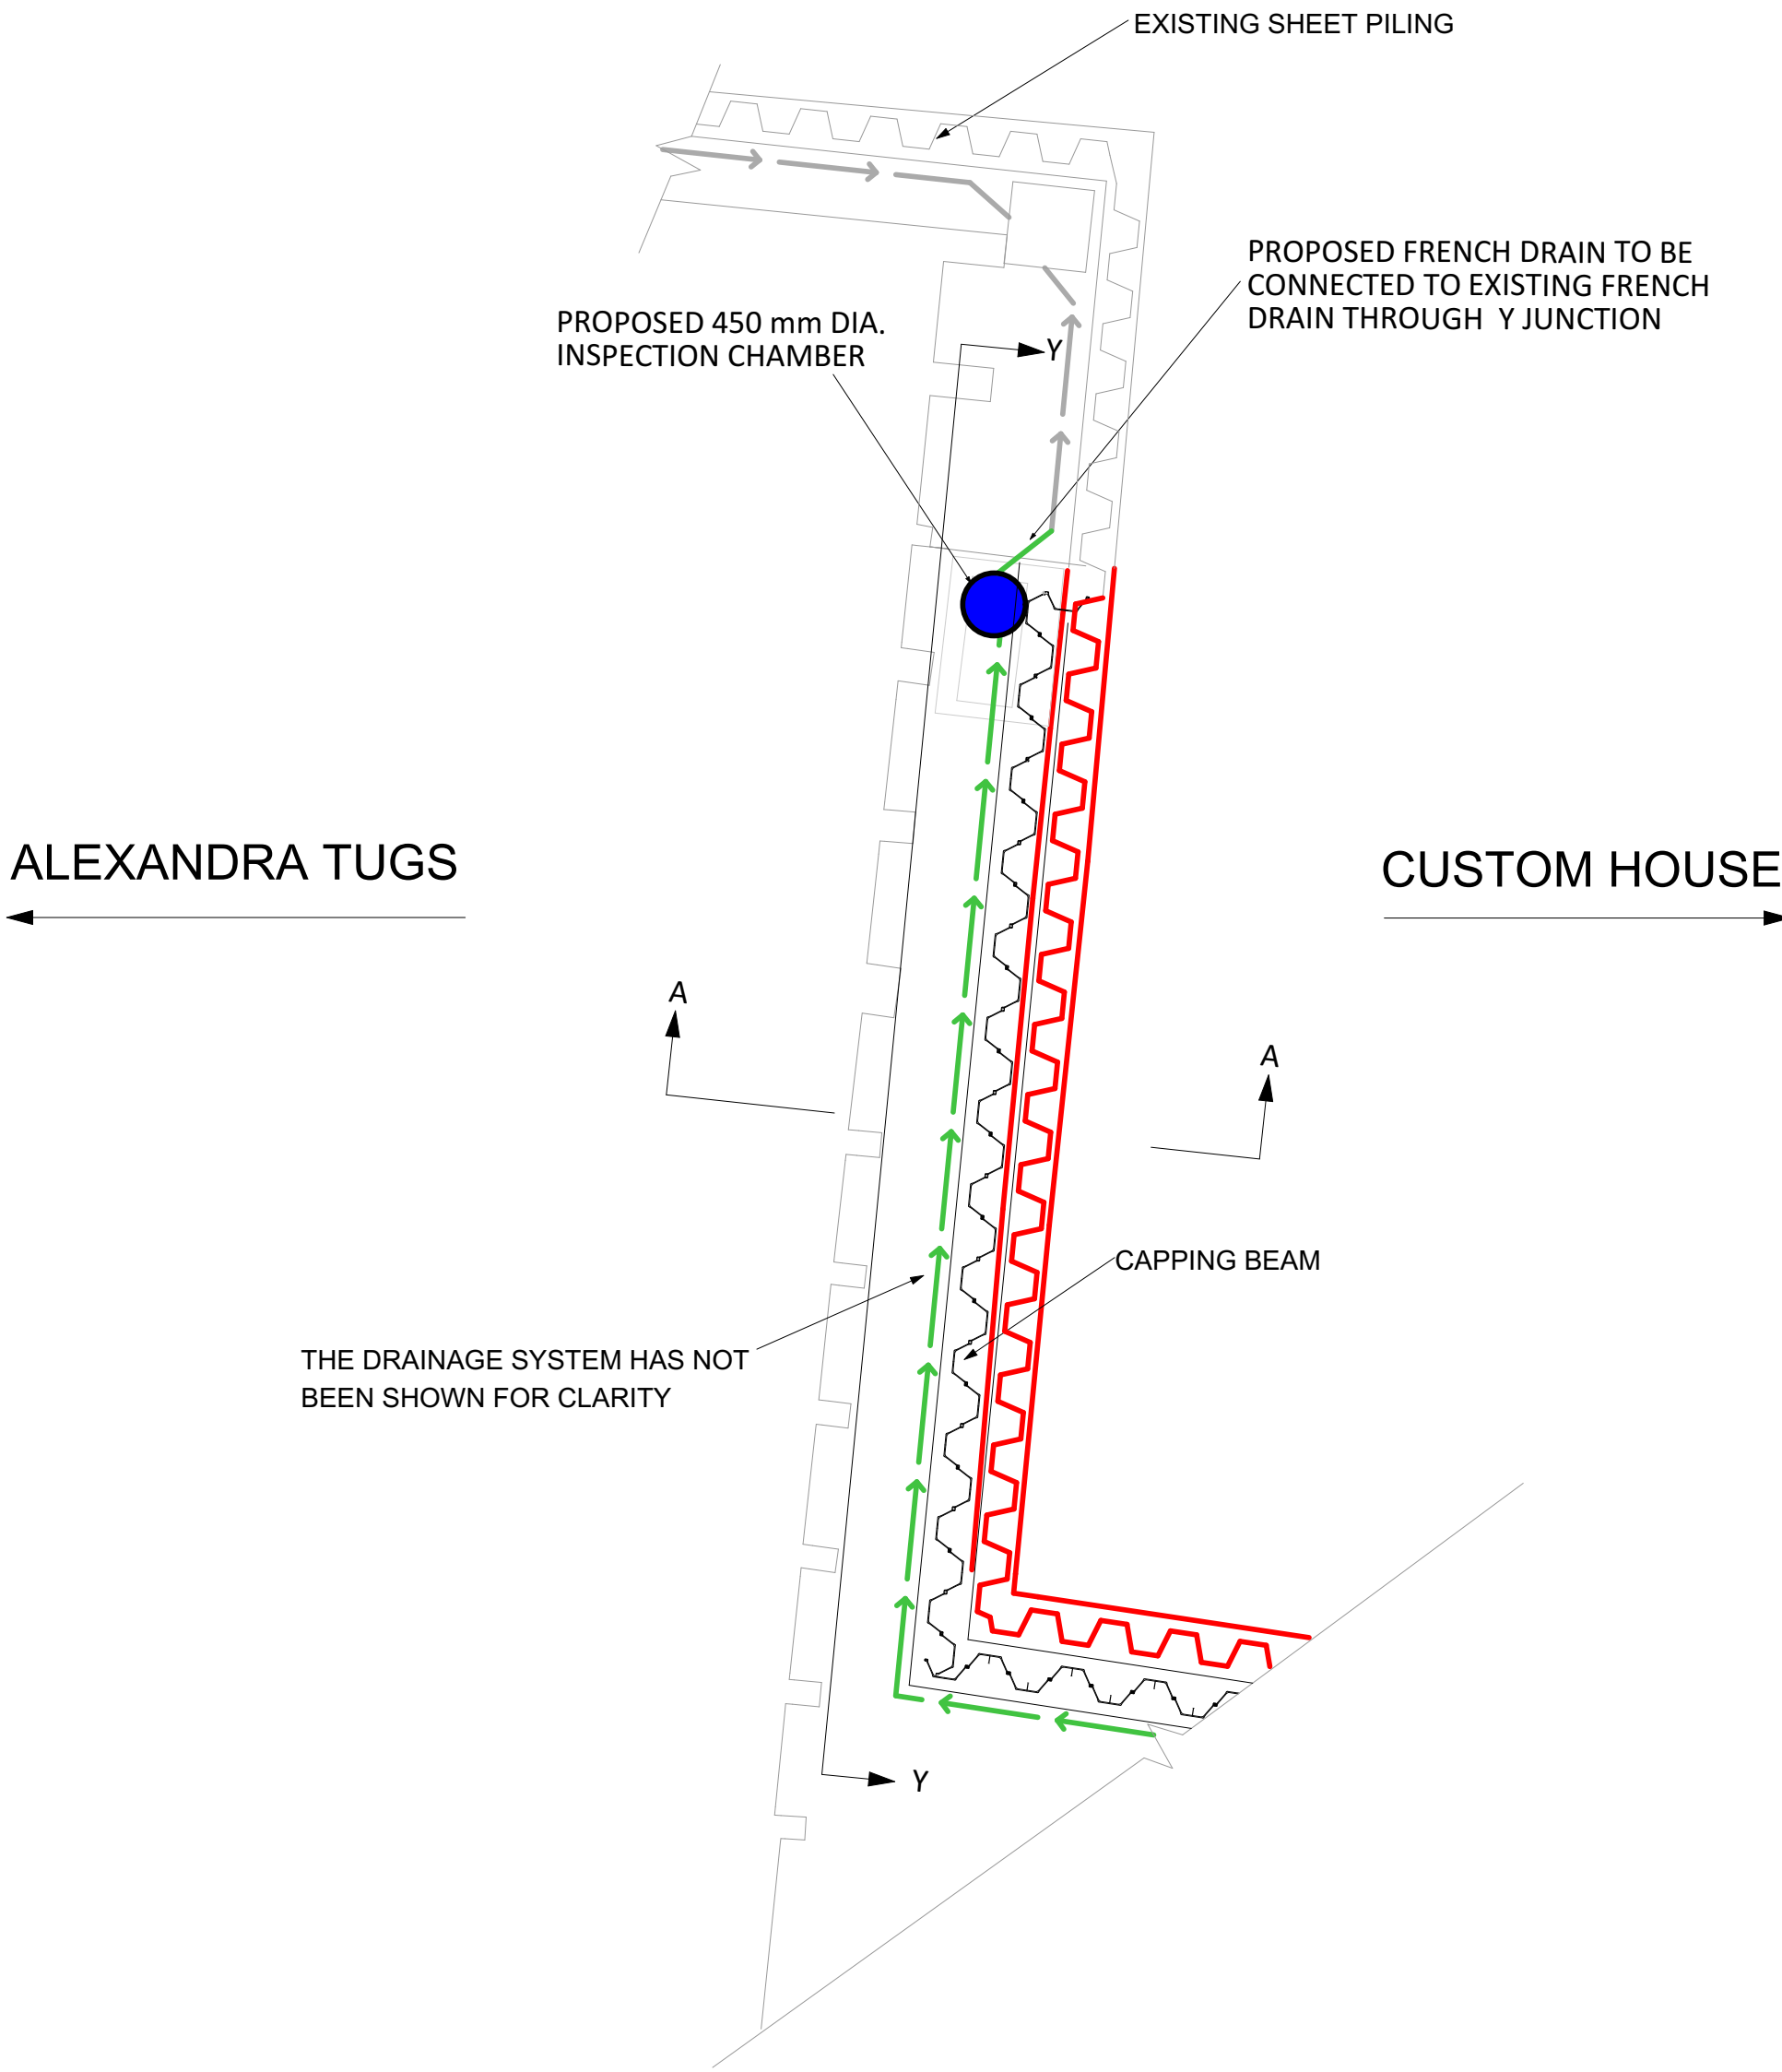

PLAN OF JUNCTION AT ALEXANDRA TUGS AND CUSTOM HOUSE 1:100

CUSTOM HOUSE

FORESHORE

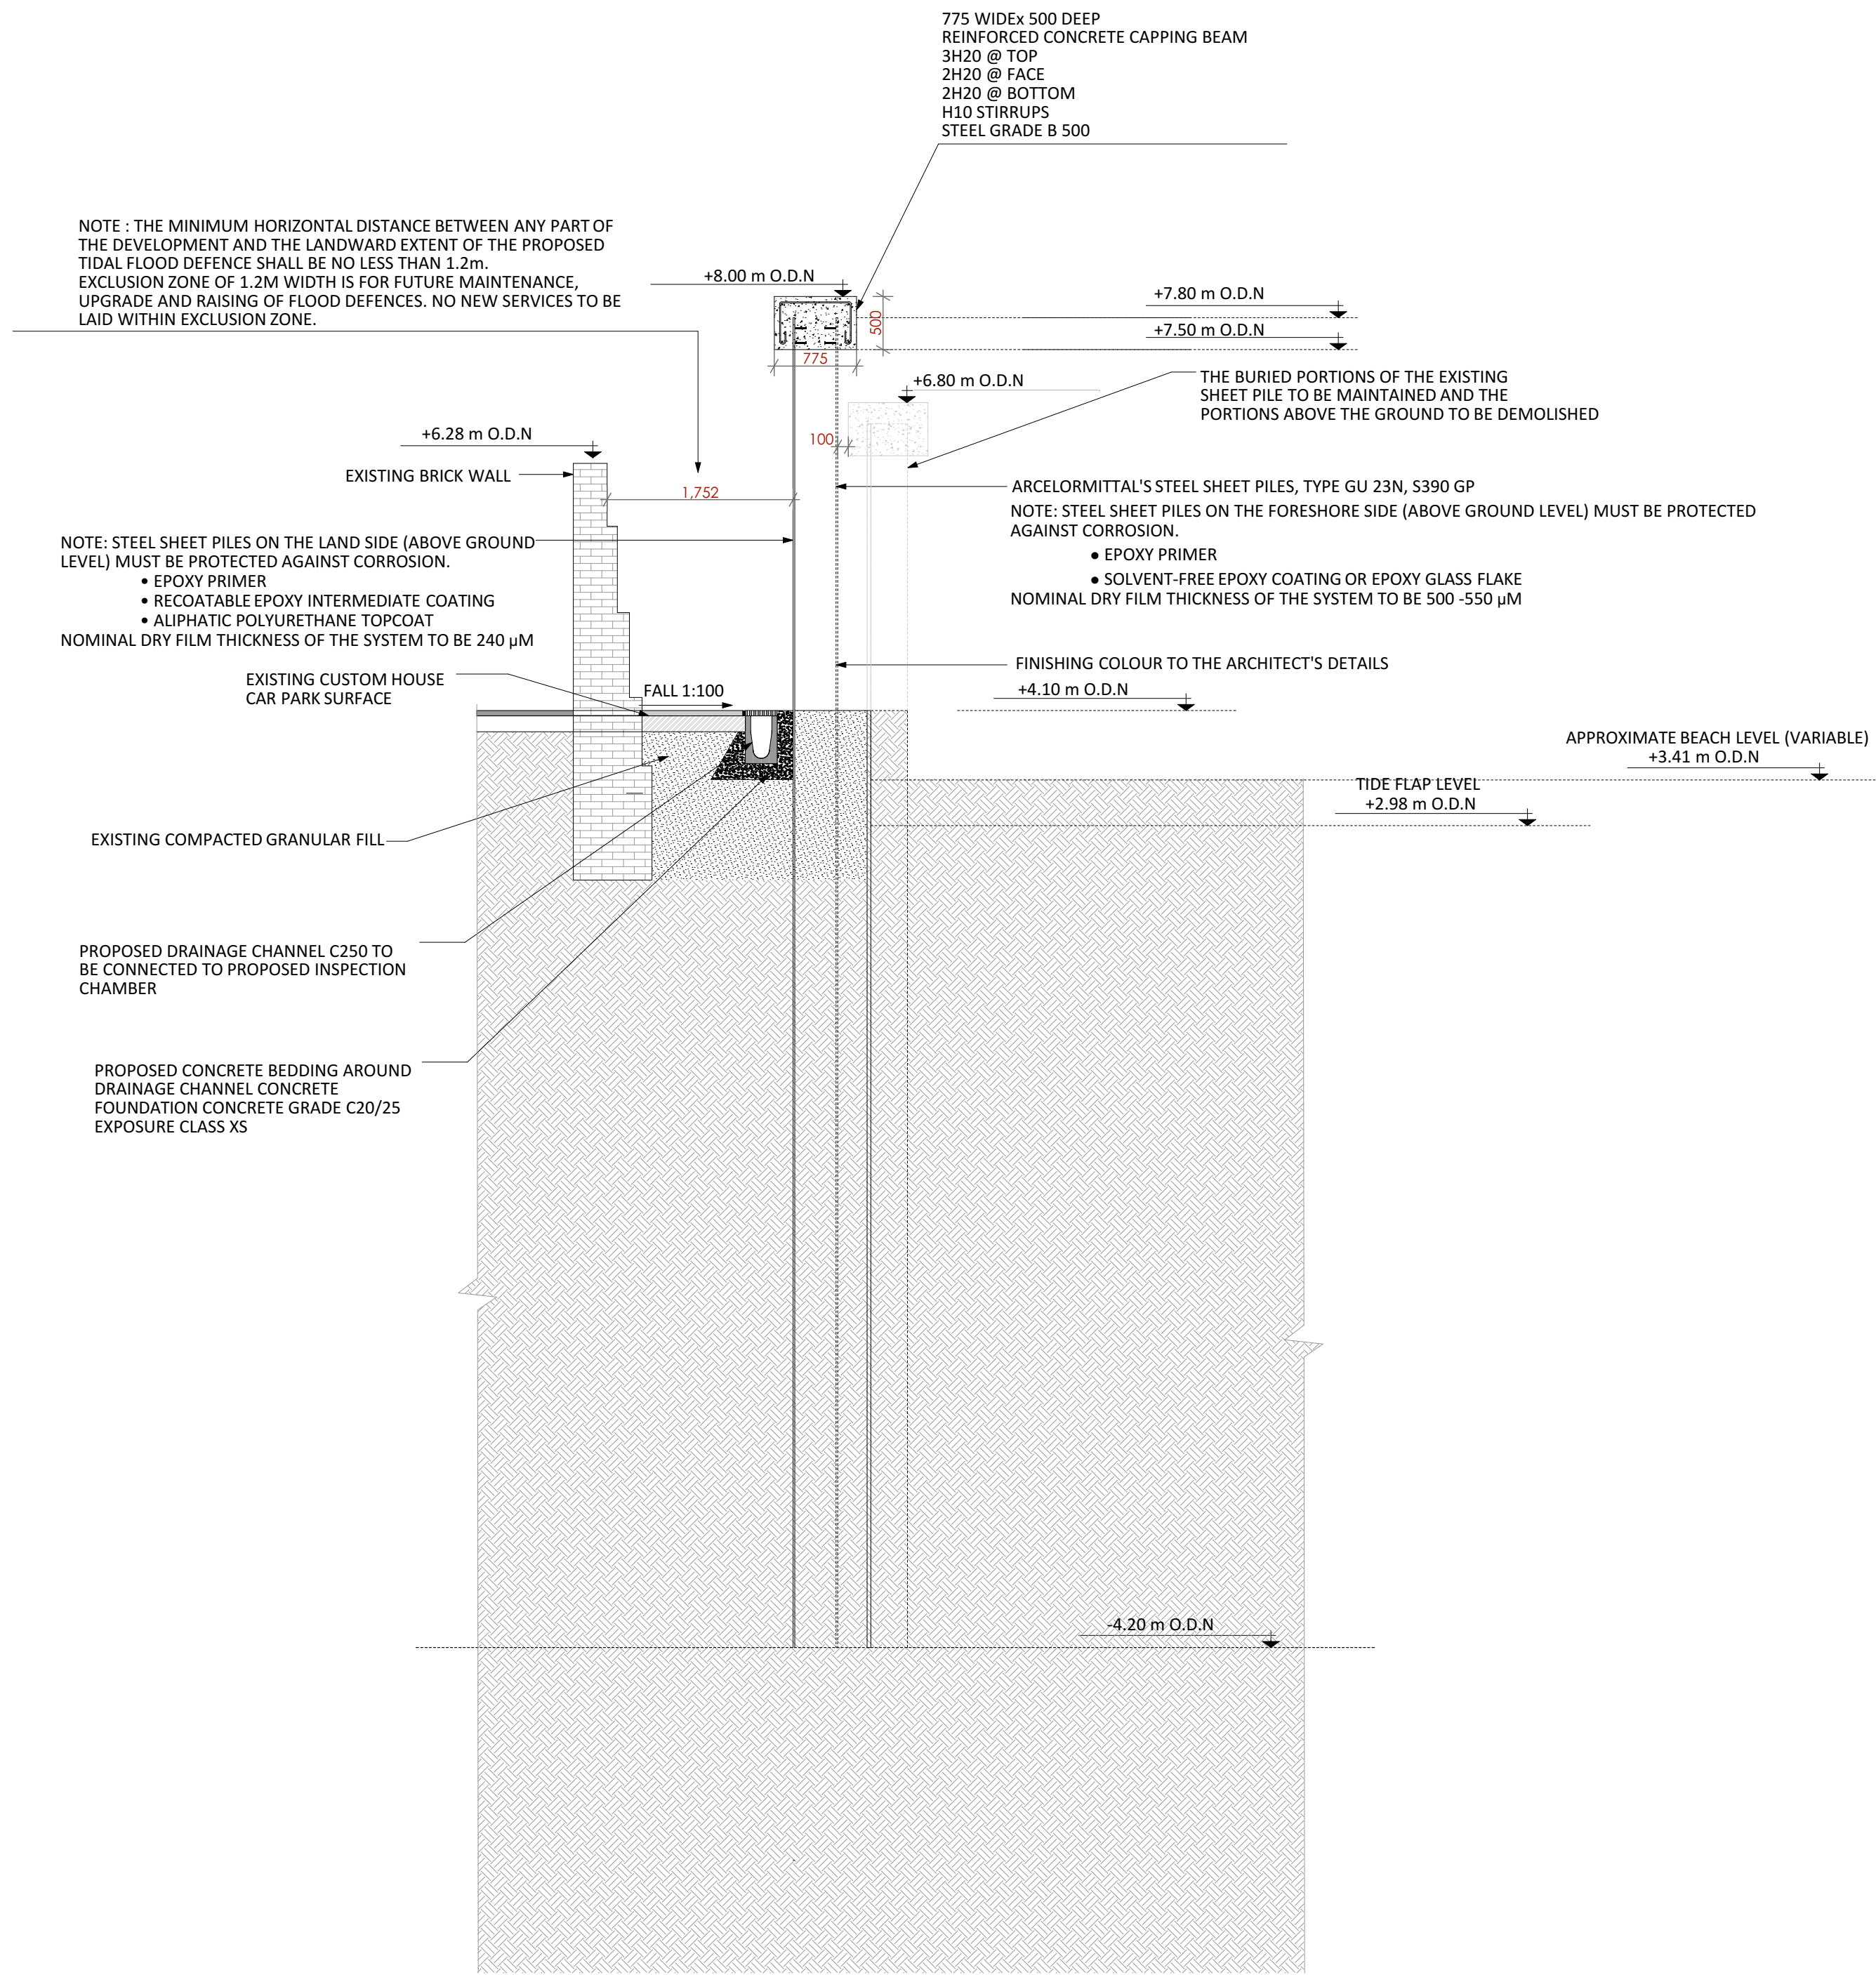

SECTION A-A 1:50

As Built
13/03/2026
Per provided Statement by DDS

Construction Risks	Maintenance/Clearing Risks	Demolition/Adaptation Risks
In addition to the hazards/risks normally associated with the types of work detailed on this drawing take note of the above. It is assumed that all works on this drawing will be carried out by a competent contractor working, where appropriate, to an appropriate method statement.		

Safety Health and Environmental Information Box

Notes:
This document and its design content are copyright ©. It shall be read in conjunction with all other associated project information including models, specifications, schedules, and related consultants documents. Do not scale from documents. All dimensions are to be checked on site immediately report any discrepancies, errors, or omissions on this document to the Originator. Adkins accepts no liability for the accuracy of the survey and proposed layout information supplied by others. If in doubt, ASK.

KEY	
	PROPOSED SHEET PILE
	EXISTING SURFACE WATER CHAMBER
	PROPOSED INSPECTION CHAMBER
	EXISTING SURFACE WATER SEWER
	PROPOSED SURFACE WATER SEWER
	EXISTING FRENCH DRAIN
	PROPOSED FRENCH DRAIN
	EXISTING LEVEL

- NOTES:**
- 1- ALL DIMENSIONS AND LEVELS TO BE CONFIRMED (TBC) ON SITE PRIOR TO CONSTRUCTION.
 - 2- VEHICLE BARRIER TO BE INSTALLED AT CAR PARK IN COORDINATION WITH ARCHITECT'S OR ENGINEER'S RESPONSIBLE FOR EXTERNAL WORKS DESIGN. THIS IS TO PREVENT ANY IMPACT FROM CARS ON SEA DEFENCE WALL.
 - 3- PROTECTIVE COATING SHALL UNDERGO REGULAR MAINTENANCE IN ACCORDANCE WITH THE MAINTENANCE STRATEGY. MAINTENANCE RESPONSIBILITY LIES WITH THE SITE OWNER OR DEVELOPER.
 - 4- THE SHEET PILING CONTRACTOR IS TO PROVIDE CLOSURE DETAILS AND INSTALLATION METHODS FOR THE CONNECTION BETWEEN THE EXISTING AND PROPOSED SHEET PILES.

RevID	Layout	Comment	Issue Date	Issue Initials	Approved by
C03	FOR CONSTRUCTION		08/07/2025		MBM
C01	FOR CONSTRUCTION		30/06/2025		MBM
P04	FOR APPROVAL		28/03/2025		MBM
P04	FOR APPROVAL		28/01/2025		MBM
P03	FOR APPROVAL		05/11/2024		MBM
P02	FOR APPROVAL		15/10/2024		MBM
P01	FOR APPROVAL		05/09/2024		MBM

Scales @ A1 1:100, 1:50	Issuing Office Kent	Project No. 0524SD4169
----------------------------	------------------------	---------------------------

Client Approval	
A - Approved	
B - Approved with Comments	
C - Do Not Use	

Status	Purpose of Issue
S4	FOR CONSTRUCTION

Originator	Adkins Consultants Ltd 130 Ashford Rd, Bearsted, Maidstone ME14 4AF
------------	--

Project	CUSTOM HOUSE THE TERRACE GRAVESEND, DA12 2BW
---------	--

Layout Title	PROPOSED WALL SECTIONS SHEET 1/3
--------------	-------------------------------------

Client	Mile Property Group Ltd
--------	-------------------------

Drawing Number						
project	originator	volume	level	type	number	rev
CH	AA	XX	XX	DS - E	0200	C03