
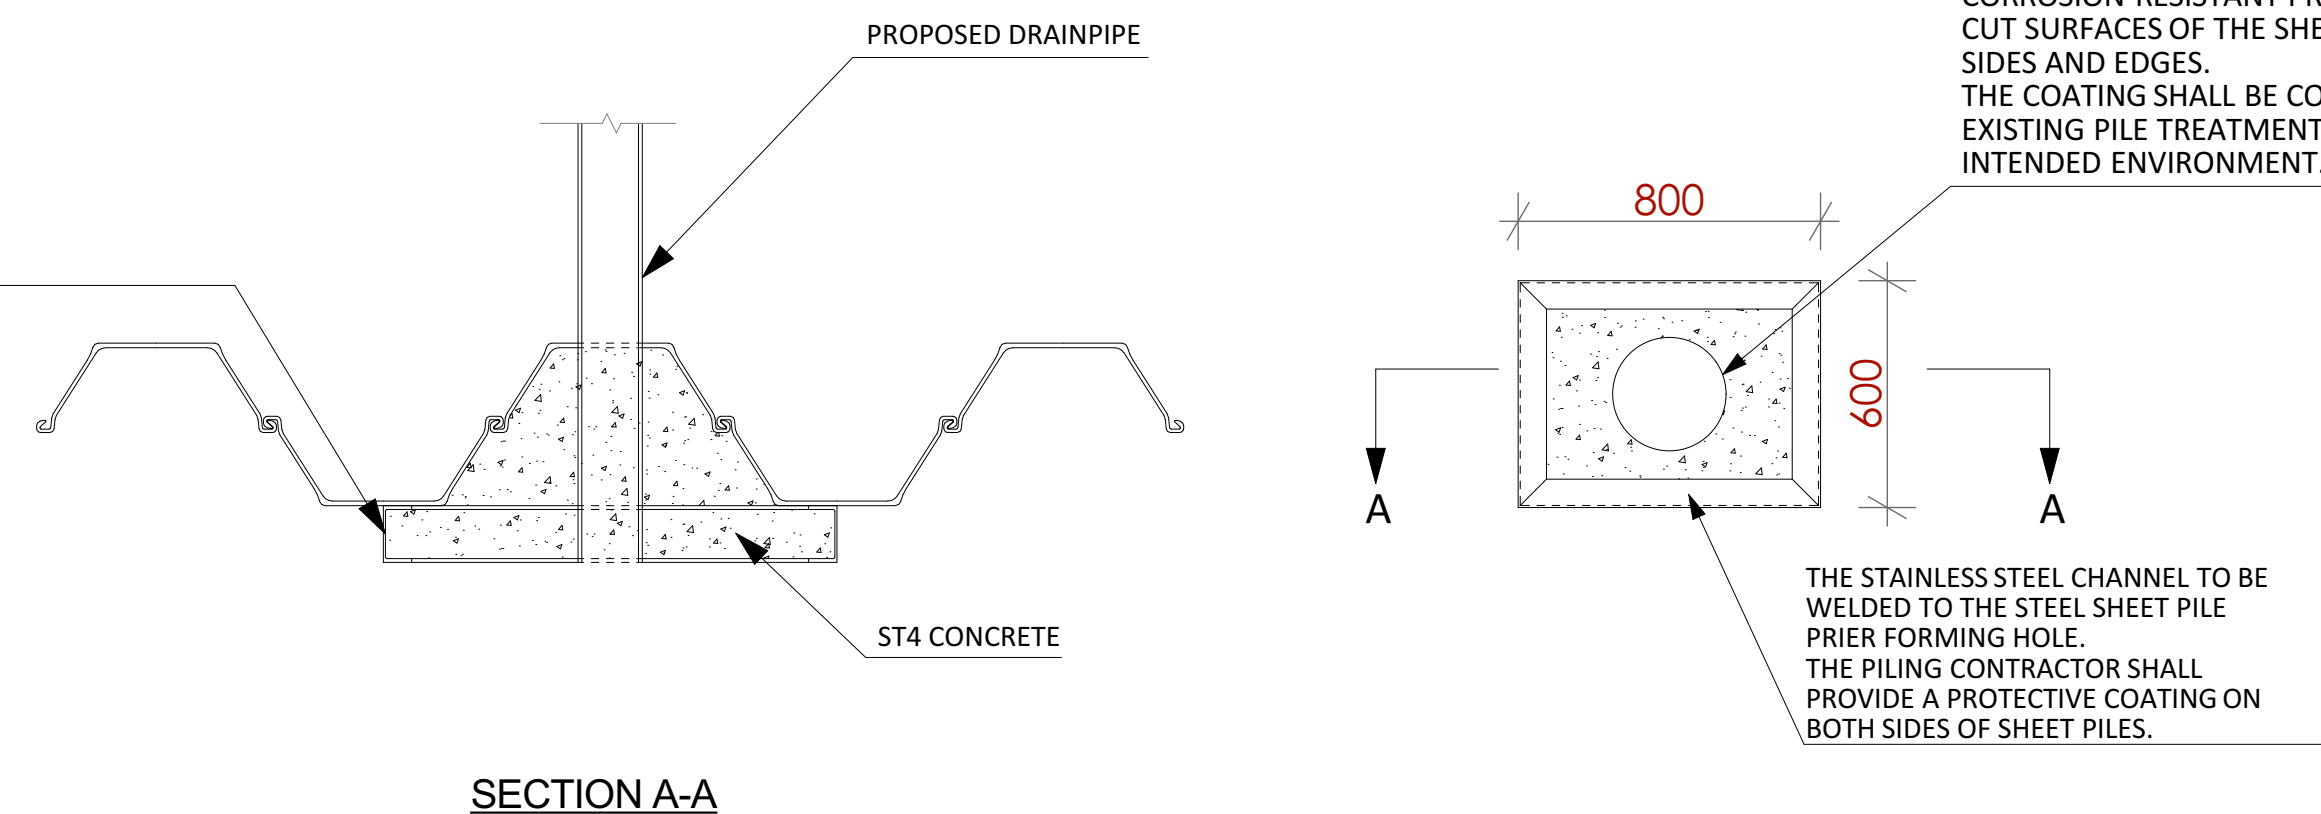
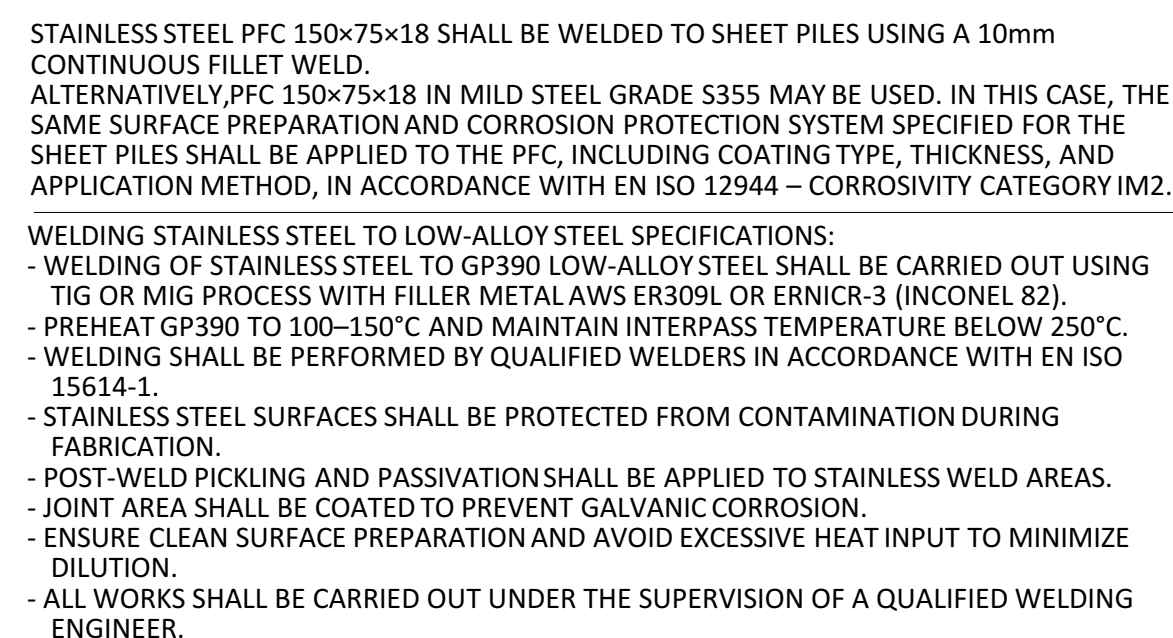
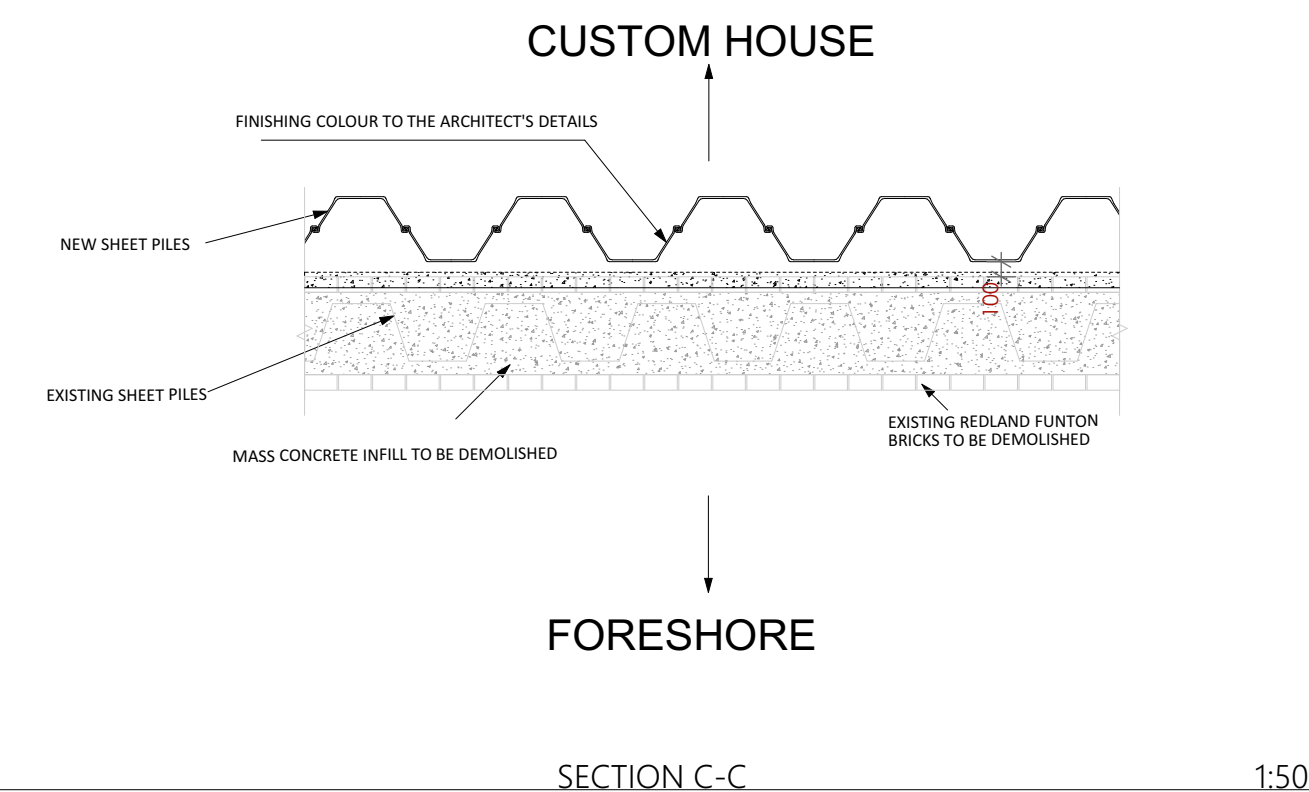
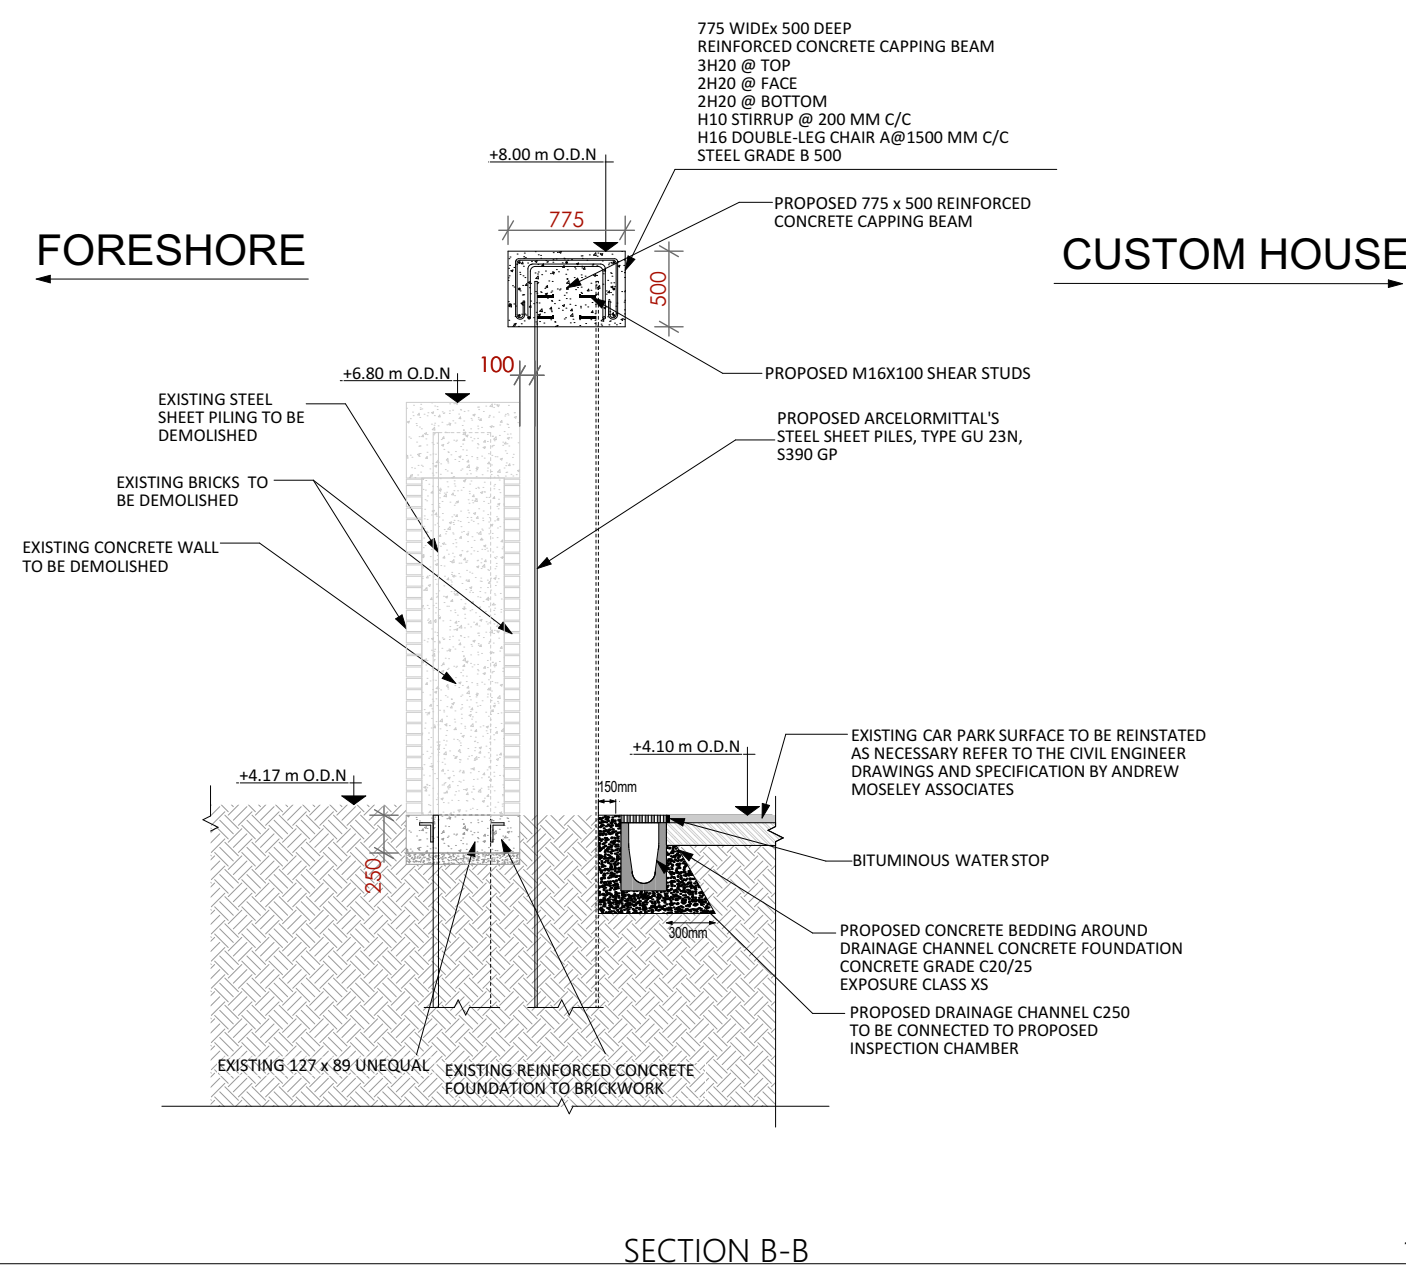
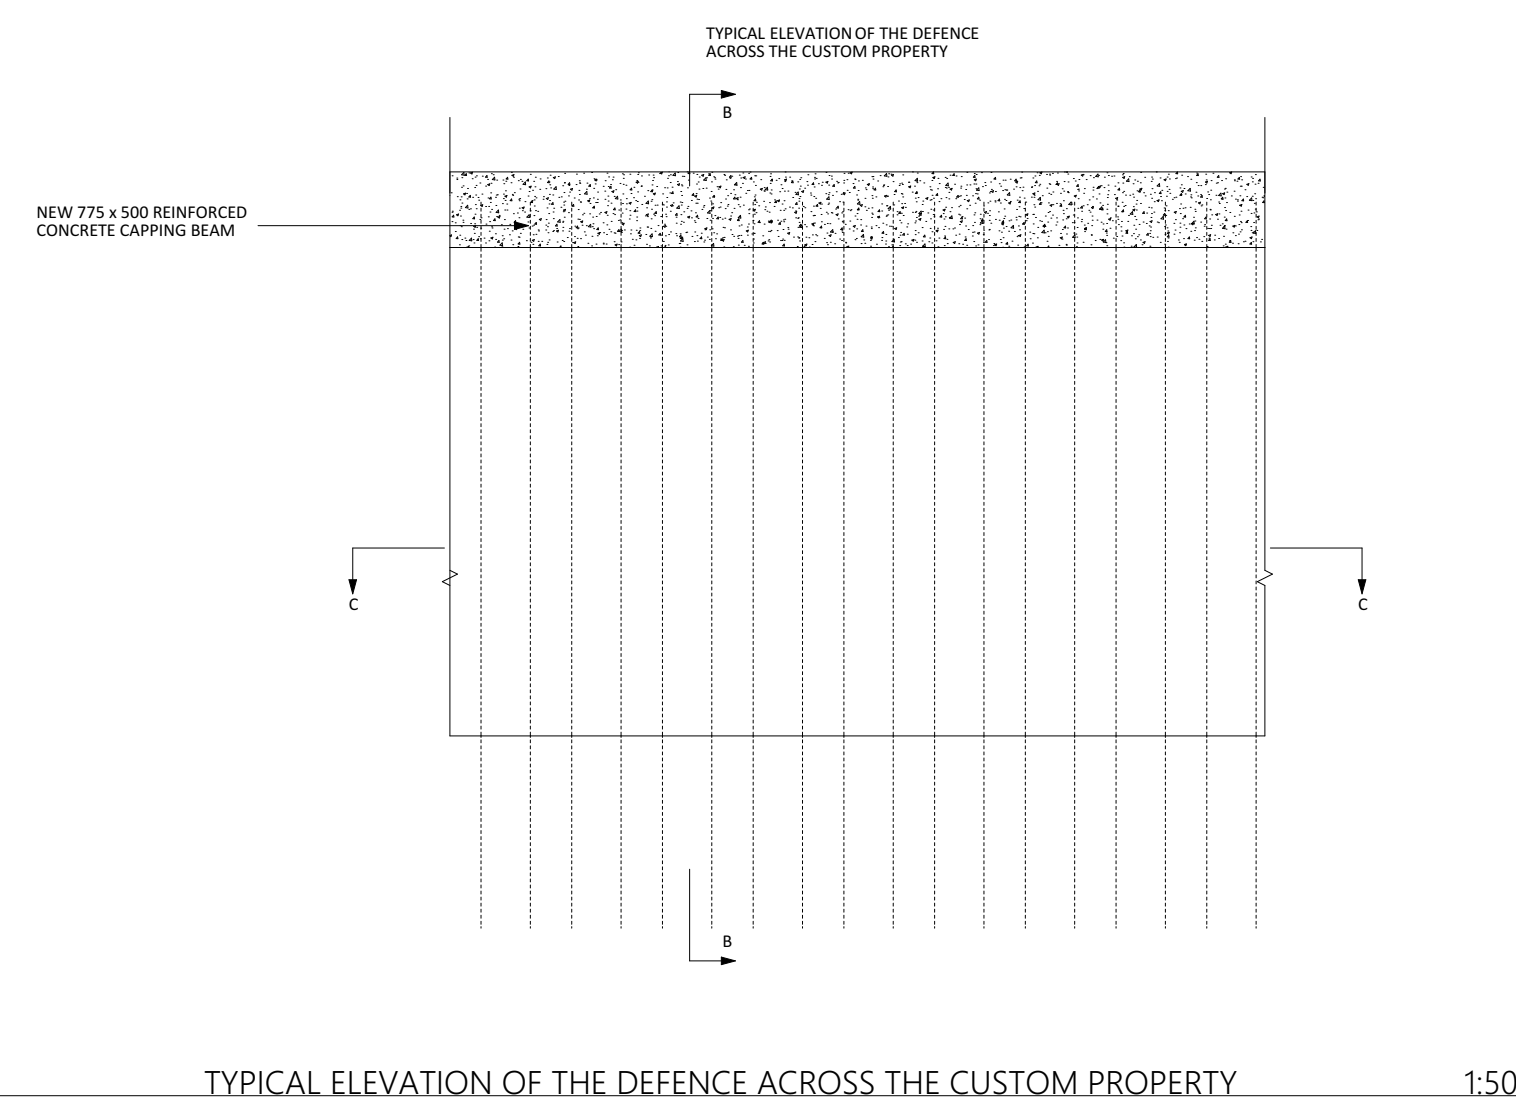
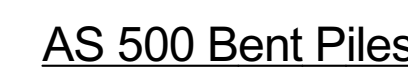
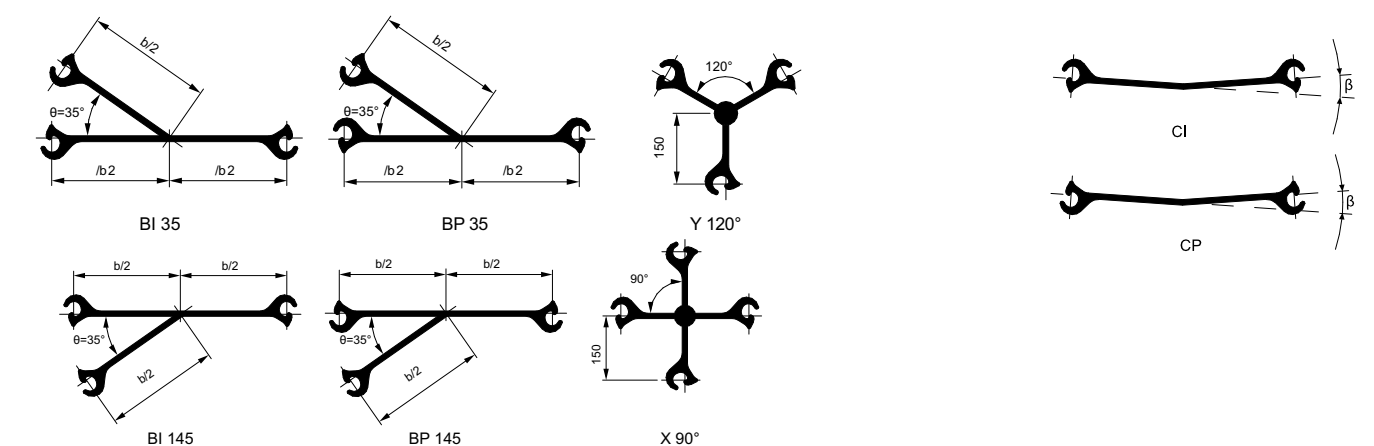
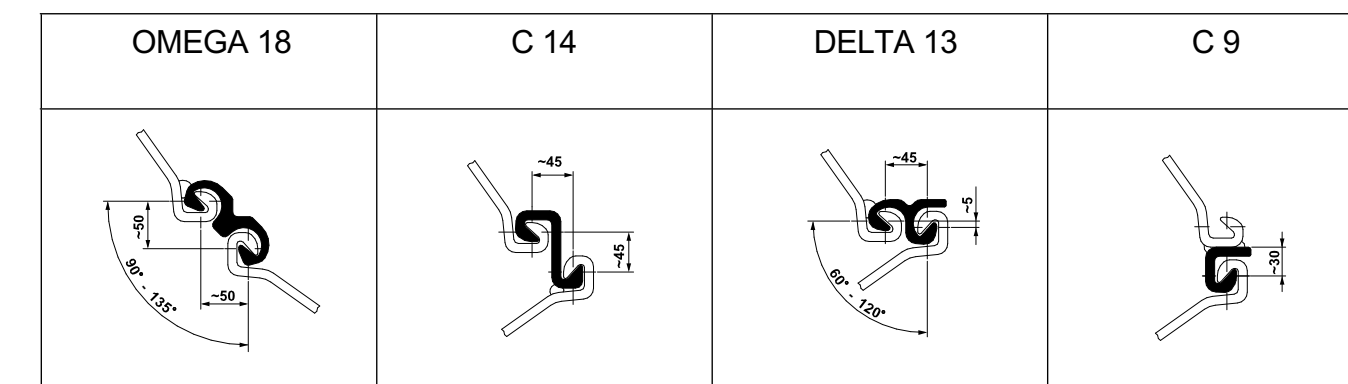


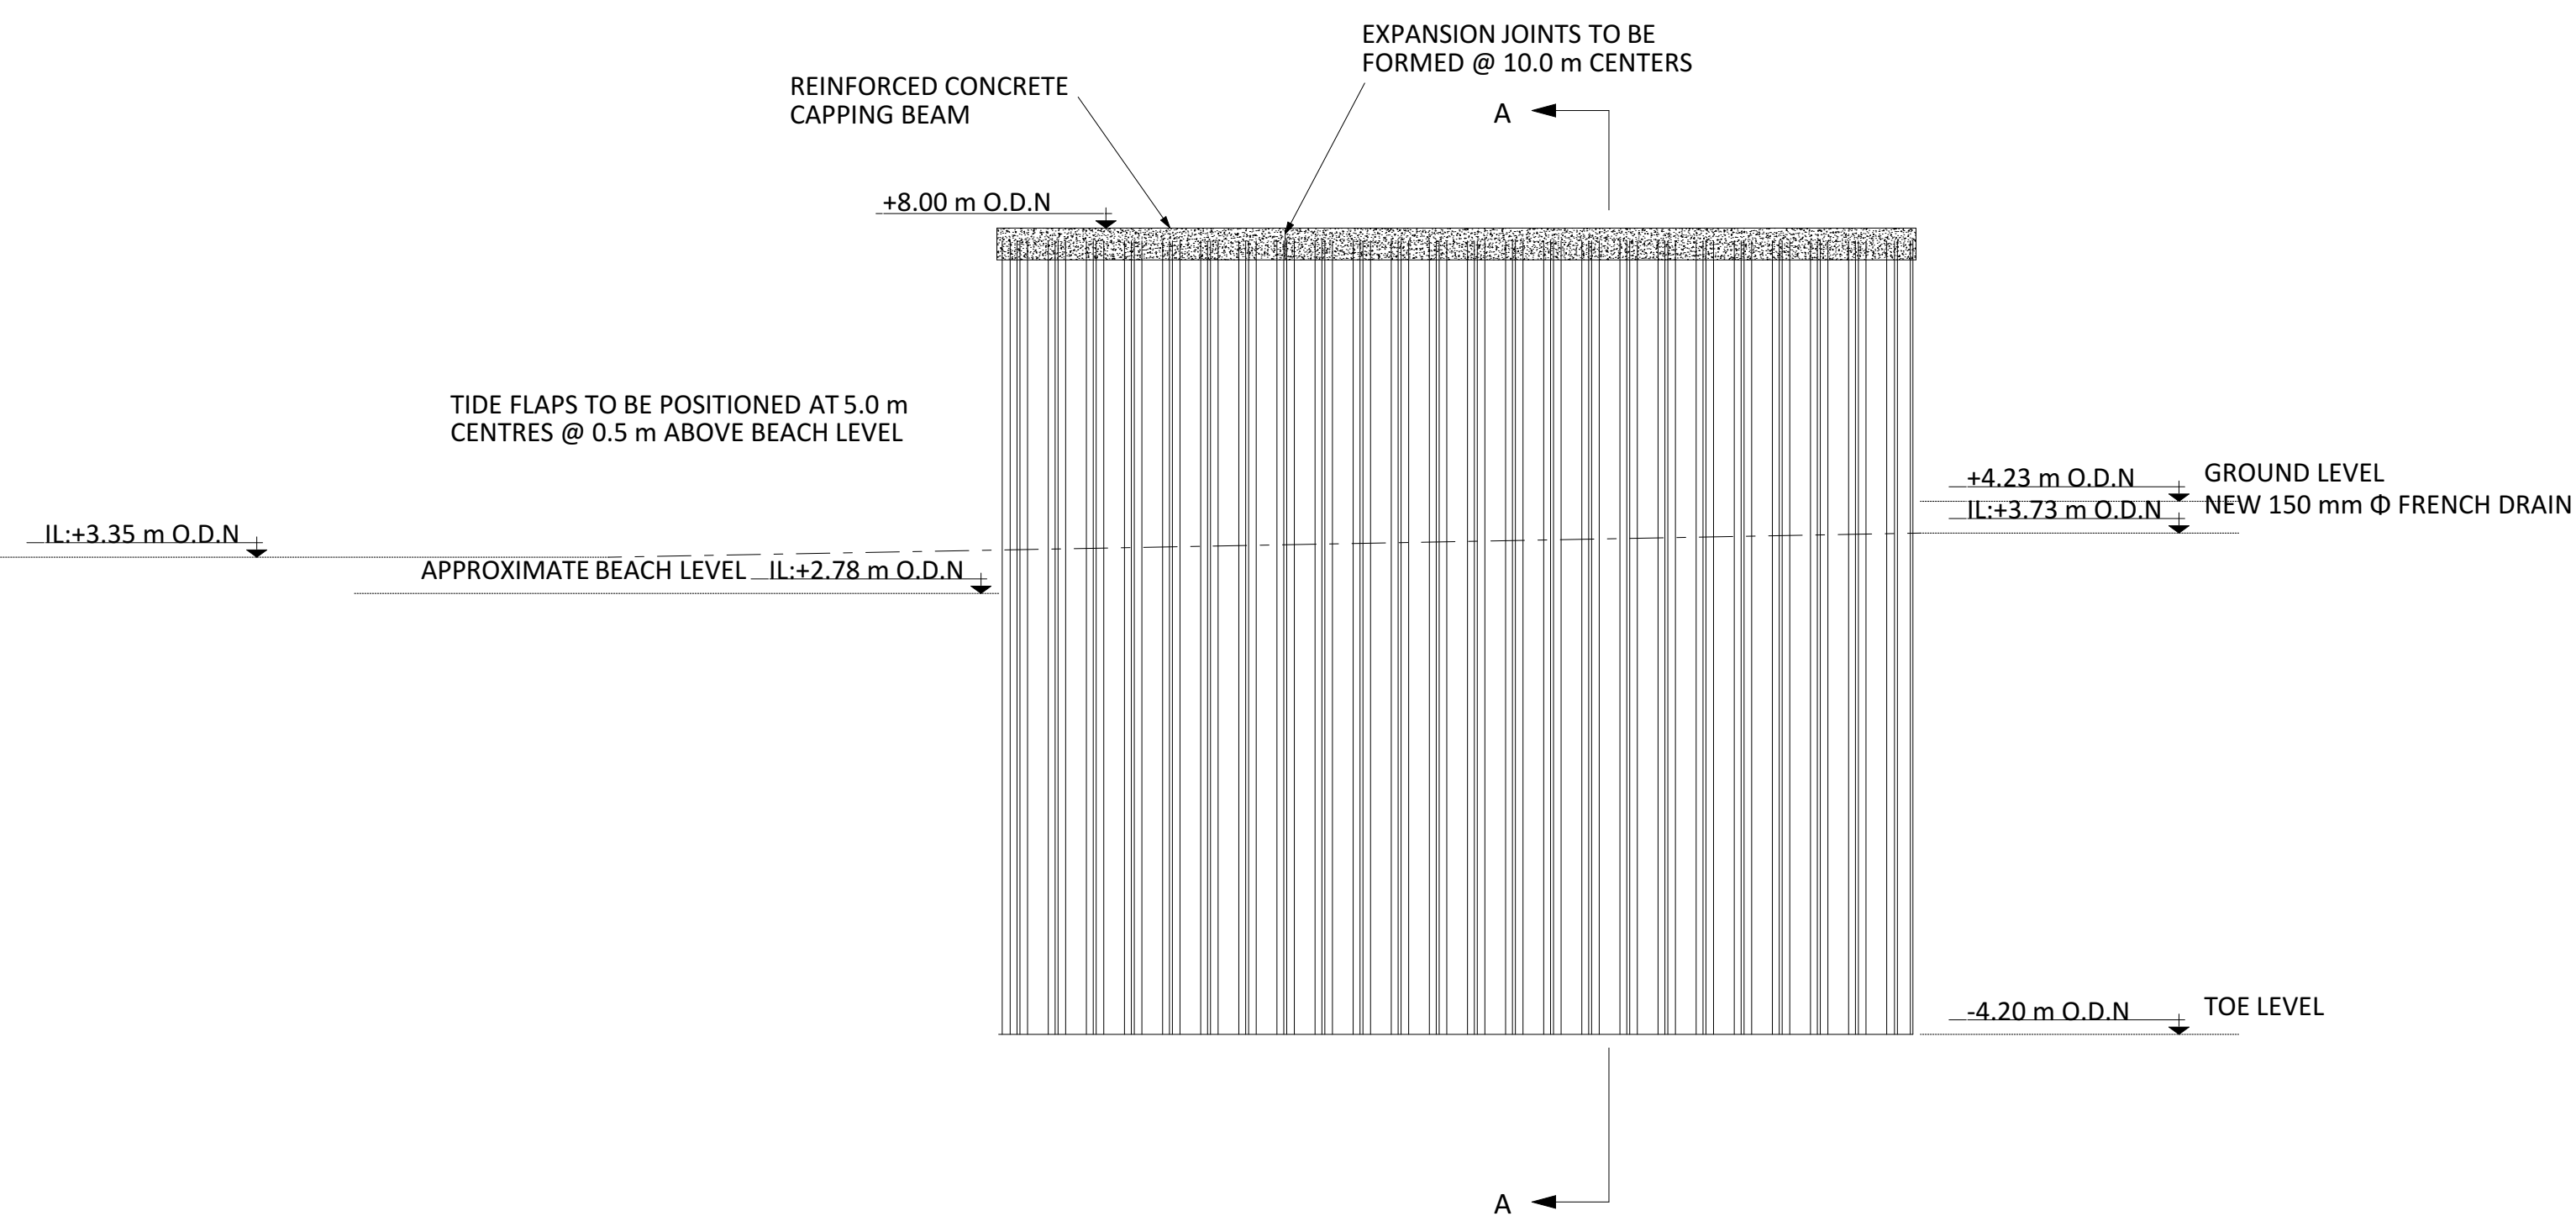

THE PILING CONTRACTOR SHALL APPLY AN APPROVED CORROSION-RESISTANT PROTECTIVE COATING TO ALL CUT SURFACES OF THE SHEET PILES, INCLUDING BOTH SIDES AND EDGES. THE COATING SHALL BE COMPATIBLE WITH THE EXISTING PILE TREATMENT AND SUITABLE FOR THE INTENDED ENVIRONMENT.

THE STAINLESS STEEL CHANNEL TO BE WELDED TO THE STEEL SHEET PILE PRIOR FORMING HOLE.
THE PILING CONTRACTOR SHALL PROVIDE A PROTECTIVE COATING ON BOTH SIDES OF SHEET PILES.

As Built
13/03/2026
Per provided Statement by DDS

Construction Risks	Maintenance/clearing Risks	Demolition/adaptation Risks
--------------------	----------------------------	-----------------------------

In addition to the hazard/risks normally associated with the types of work detailed on this drawing take note of the above. It is assumed that all works on this drawing will be carried out by a competent contractor working, where appropriate, to an appropriate method statement.

Safety Health and Environmental Information Board

Notes:
This document and its design content are copyright ©. It shall be read in conjunction with all other associated project information including models, specifications, schedules, and related consultants documents. Do not scale from documents. All dimensions are to be checked on site. Immediately report any discrepancies, errors, or omissions on this document to the Originator. Adkins accepts no liability for the accuracy of the survey and proposed layout information supplied by others. If in doubt, ASK.

NOTES:

1- ALL DIMENSIONS AND LEVELS TO BE CONFIRMED (TBC) ON SITE PRIOR TO CONSTRUCTION.

2- VEHICLE BARRIER TO BE INSTALLED AT CAR PARK IN COORDINATION WITH ARCHITECT'S OR ENGINEER'S RESPONSIBLE FOR EXTERNAL WORKS DESIGN. THIS IS TO PREVENT ANY IMPACT FROM CARS ON SEA DEFENCE WALL.

3- PROTECTIVE COATING SHALL UNDERGO REGULAR MAINTENANCE IN ACCORDANCE WITH THE MAINTENANCE STRATEGY. MAINTENANCE RESPONSIBILITY LIES WITH THE SITE OWNER OR DEVELOPER.

4- THE SHEET PILING CONTRACTOR IS TO PROVIDE CLOSURE DETAILS AND INSTALLATION METHODS FOR THE CONNECTION BETWEEN THE EXISTING AND PROPOSED SHEET PILES.

C03	FOR CONSTRUCTION	08/07/2025								MBM
C02	FOR CONSTRUCTION	30/06/2025								MBM
C01	FOR CONSTRUCTION	28/03/2025								MBM
P04	FOR APPROVAL	20/01/2025								MBM
P03	FOR APPROVAL	05/11/2024								MBM
P02	FOR APPROVAL	15/10/2024								MBM
P01	FOR APPROVAL	05/09/2024								MBM
RegD	Initial Design	Issue Date	Issue year-month							Approved by:

Scale @ A1 1:100, 1:50, 1:20	Issuing Office Kent	Project No. 0524SD4169
------------------------------------	-------------------------------	----------------------------------

Client Approval

	A - Approve
--	-------------

	B - Approved with Comments
--	----------------------------

	C - Do Not Use
--	----------------

Status	Purpose of Issue
--------	------------------

S4 FOR CONSTRUCTION

Originator	
------------	--

Adkins Consultants Ltd
130 Ashford Rd, Bearsted, Maidstone ME14 4AF

Project	
---------	--

CUSTOM HOUSE
THE TERRACE
GRAVESEND, DA12 2BW

Layout Title

PROPOSED WALL SECTIONS SHEET
2/3

Client	
--------	--

Mile Property Group Ltd

Drawing Number

project	originator	volume	level	type	role	number	rev
---------	------------	--------	-------	------	------	--------	-----

CH - AA - XX - XX - DS - E- 0201	C03
----------------------------------	-----