




FRONT ELEVATION

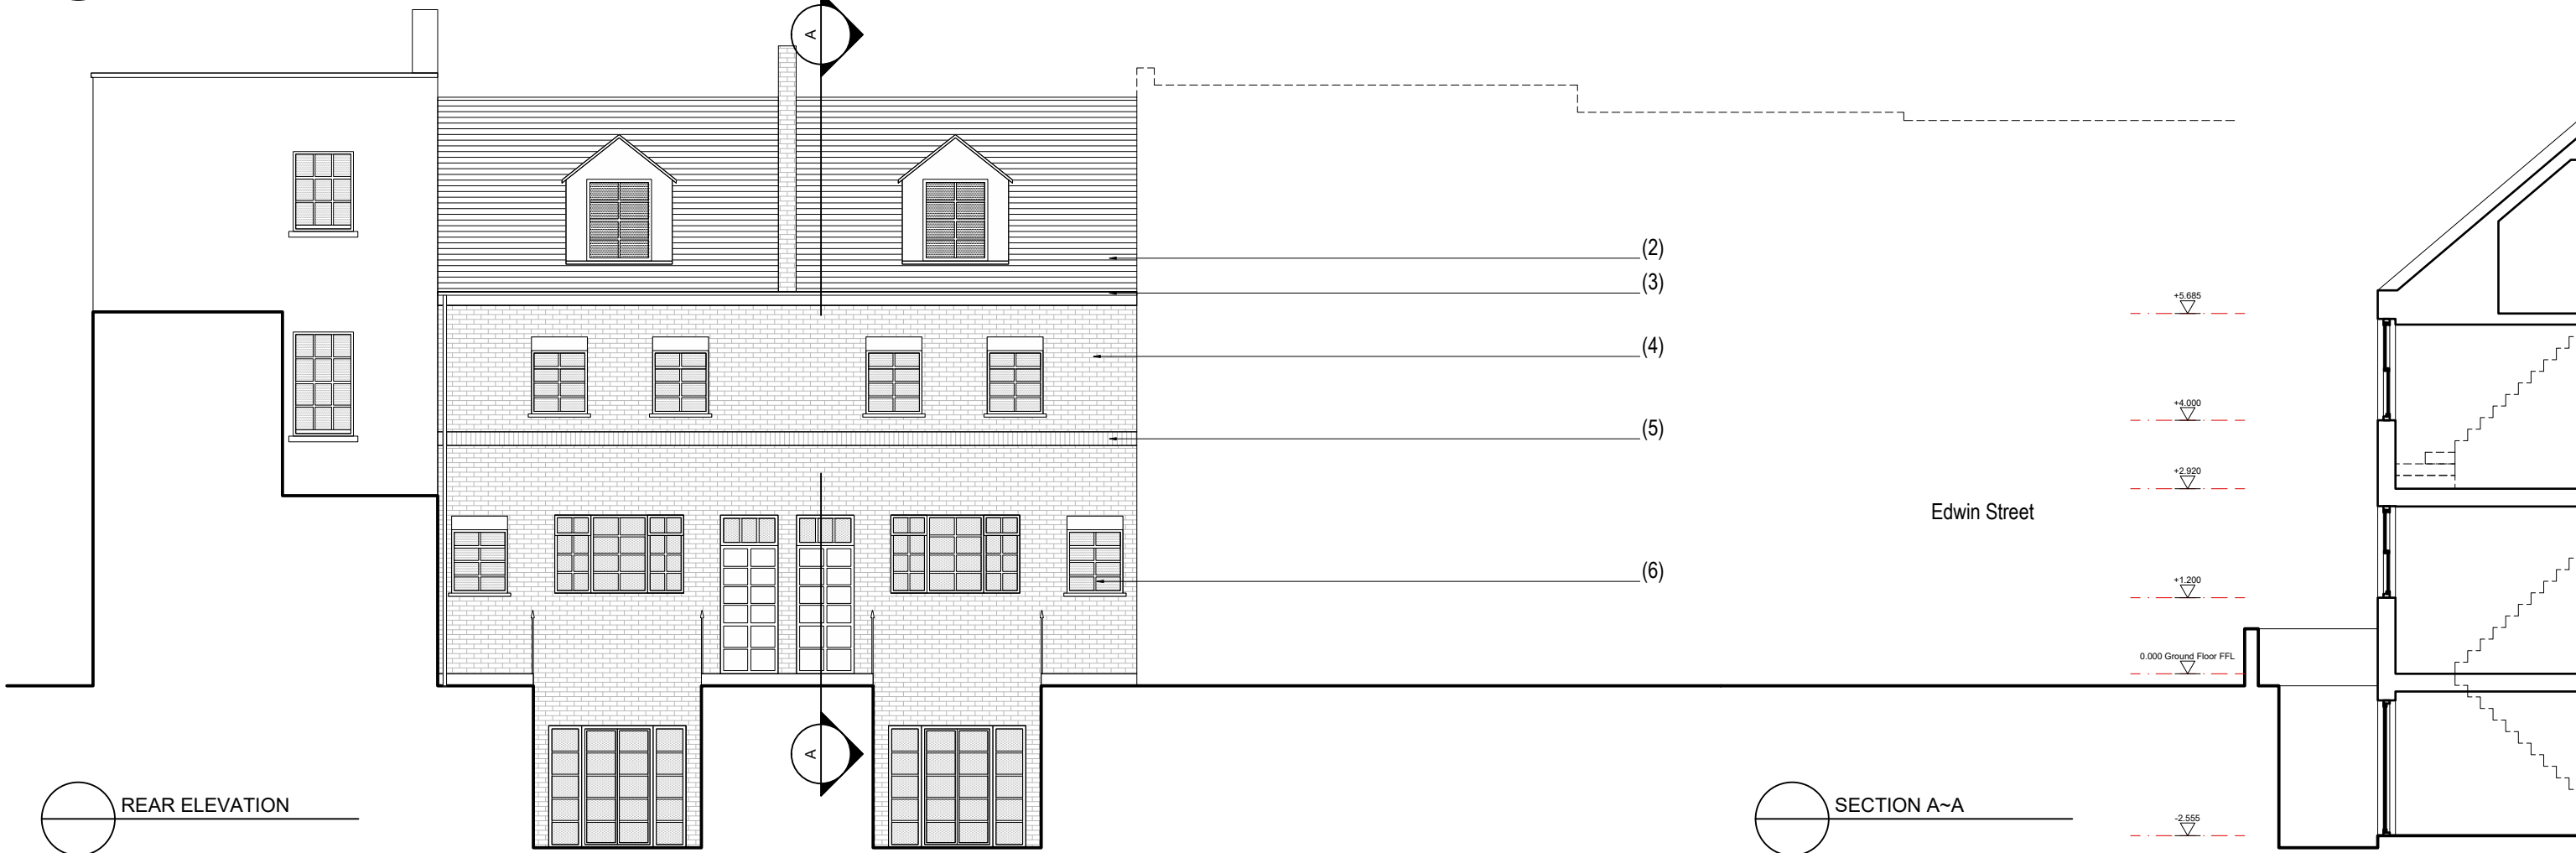

REAR ELEVATION

SECTION A-A

KEY

- (1) Conservation Roof lights
- (2) Dark grey slate
- (3) Black plastic rainwater goods
- (4) Yellow stock brickwork
- (5) Soldier course
- (6) Timber sash and casement windows
- (7) Timber paneled doors

ACCOMMODATION SCHEDULE

Flat A - 1b 2p - 70m²

Kitchen/Dining	- 24.4m ²
Shower Room	- 4.4m ²
Living Room	- 14.6m ²
Bedroom	- 17.0m ²
Storage	- 2.2m ²

Flat B - 1b 2p - 70m²


Kitchen/Dining	- 24.4m ²
Shower Room	- 4.4m ²
Living Room	- 14.6m ²
Bedroom	- 17.0m ²
Storage	- 2.2m ²

Flat C - 1b 2p - 62m²

Kitchen/Dining/Living	- 21.1m ²
Shower Room	- 4.7m ²
Bedroom	- 17.6m ²
Storage	- 1.1m ²

Flat D - 1b 2p - 62m²

Kitchen/Dining/Living	- 21.1m ²
Shower Room	- 4.7m ²
Bedroom	- 17.6m ²
Storage	- 1.1m ²

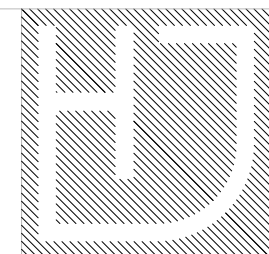

architects

12 Blackstock Mews
London
N4 2BT

t:
+44 (0) 20 7998 7651

m:
+44 (0) 78 8267 6709

e:
mail@hjarchitecture.co.uk

This drawing and design is for use solely in connection with the project described below. The drawing and the design is the copyright of H and J architecture and must not be reissued, loaned or copied without written consent. All dimensions and setting out to be checked on site before construction. Do not scale from this drawing. The drawing is to be read in conjunction with all other information relevant to the project. Any apparent discrepancy to be brought to the attention of the architect.

drawing
Planning Application:
Sections:
Plans, Section, and Elevations
as Built

drawing number
2211-PA-BT-01



revision
-

status
PLANNING


scale
1:100

size
A1


project
19 EDWIN STREET

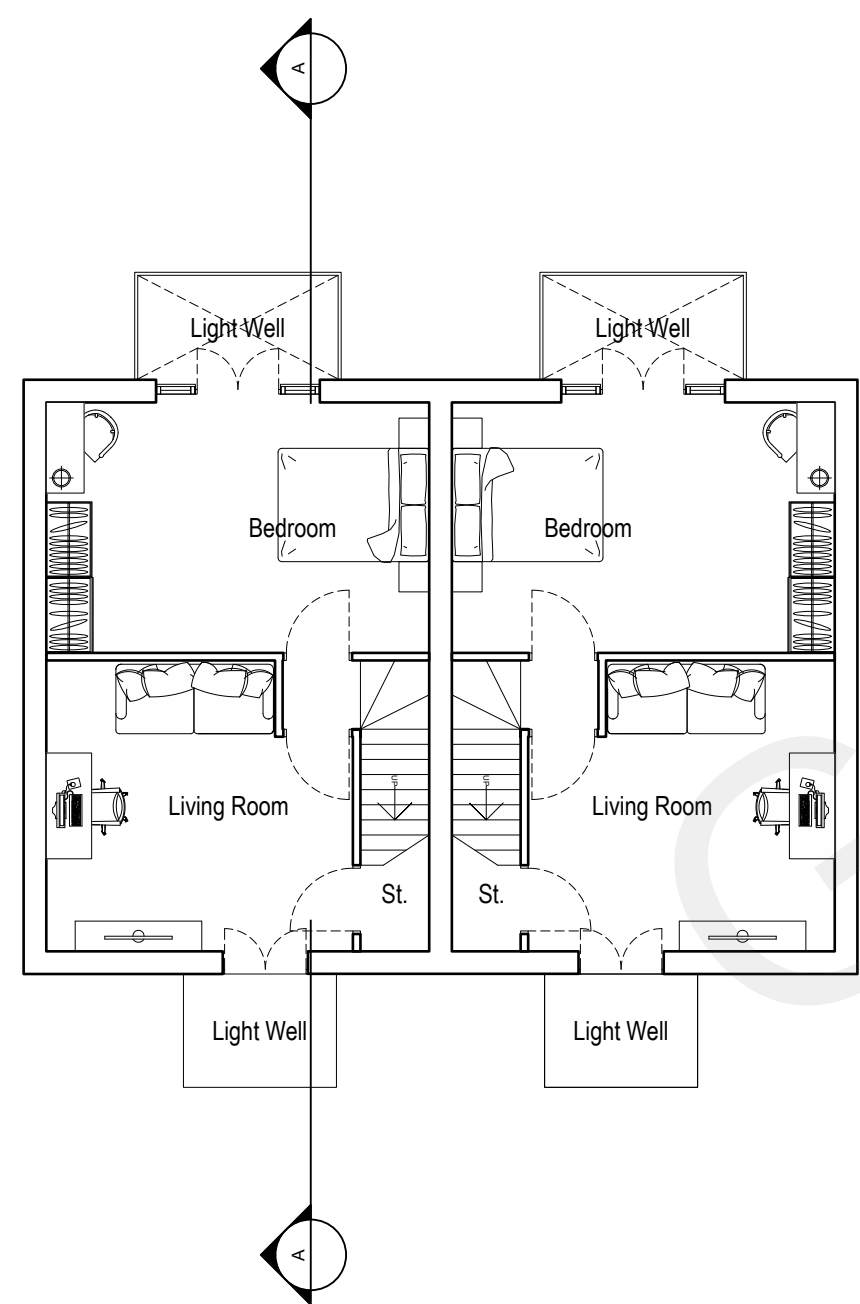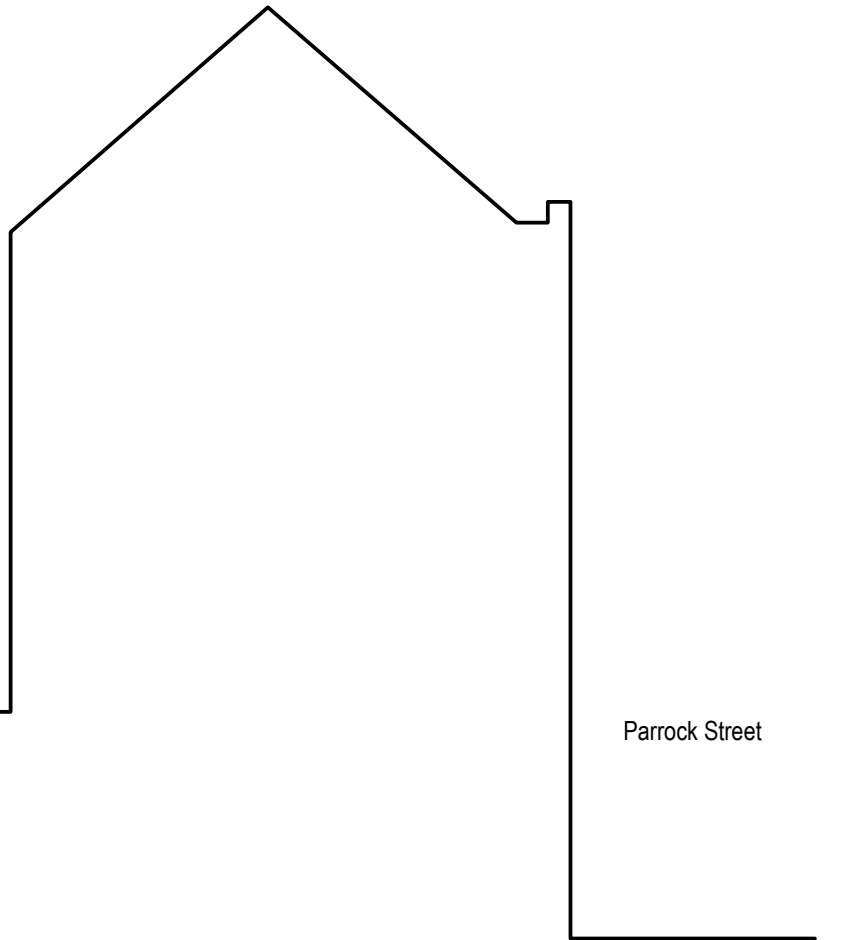


BASEMENT PLAN

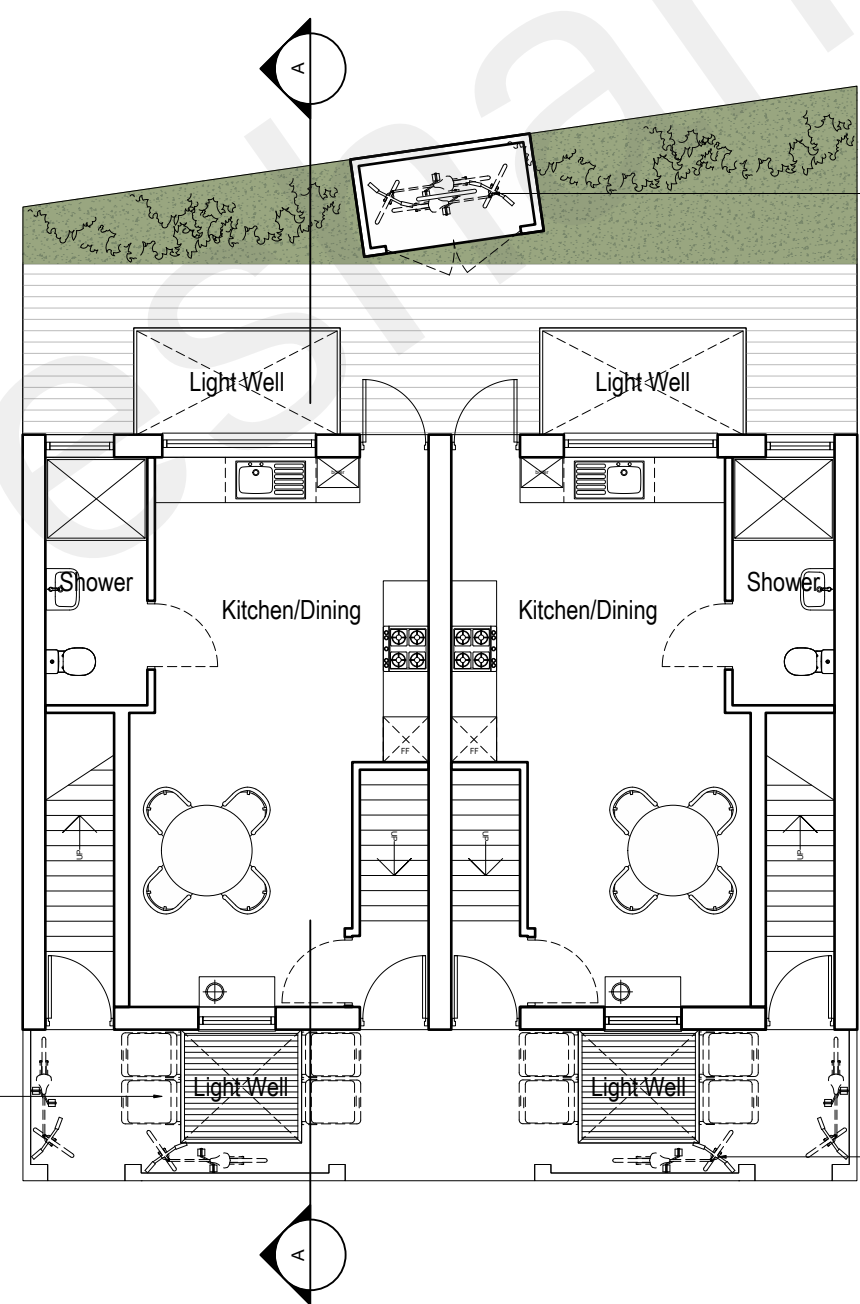

GROUND FLOOR PLAN

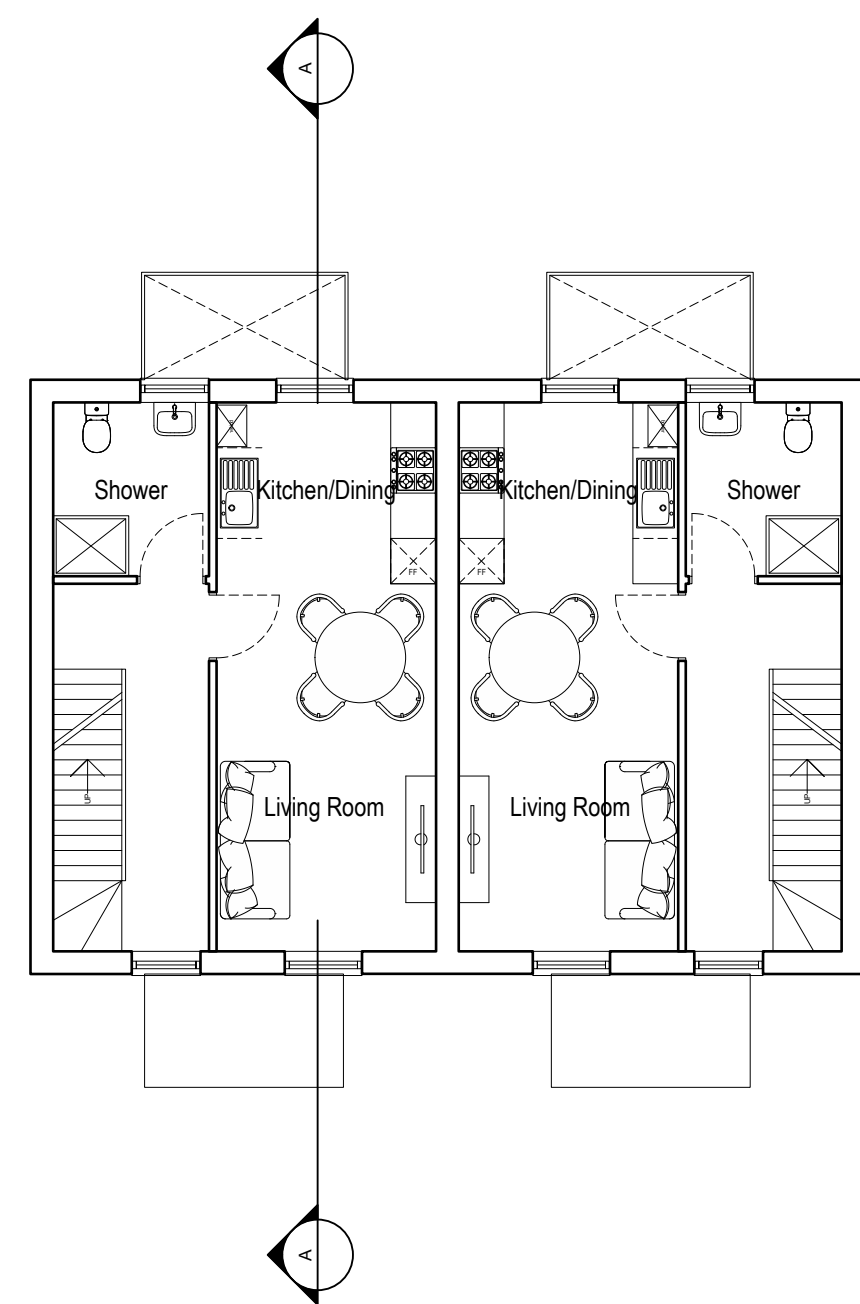

FIRST FLOOR PLAN

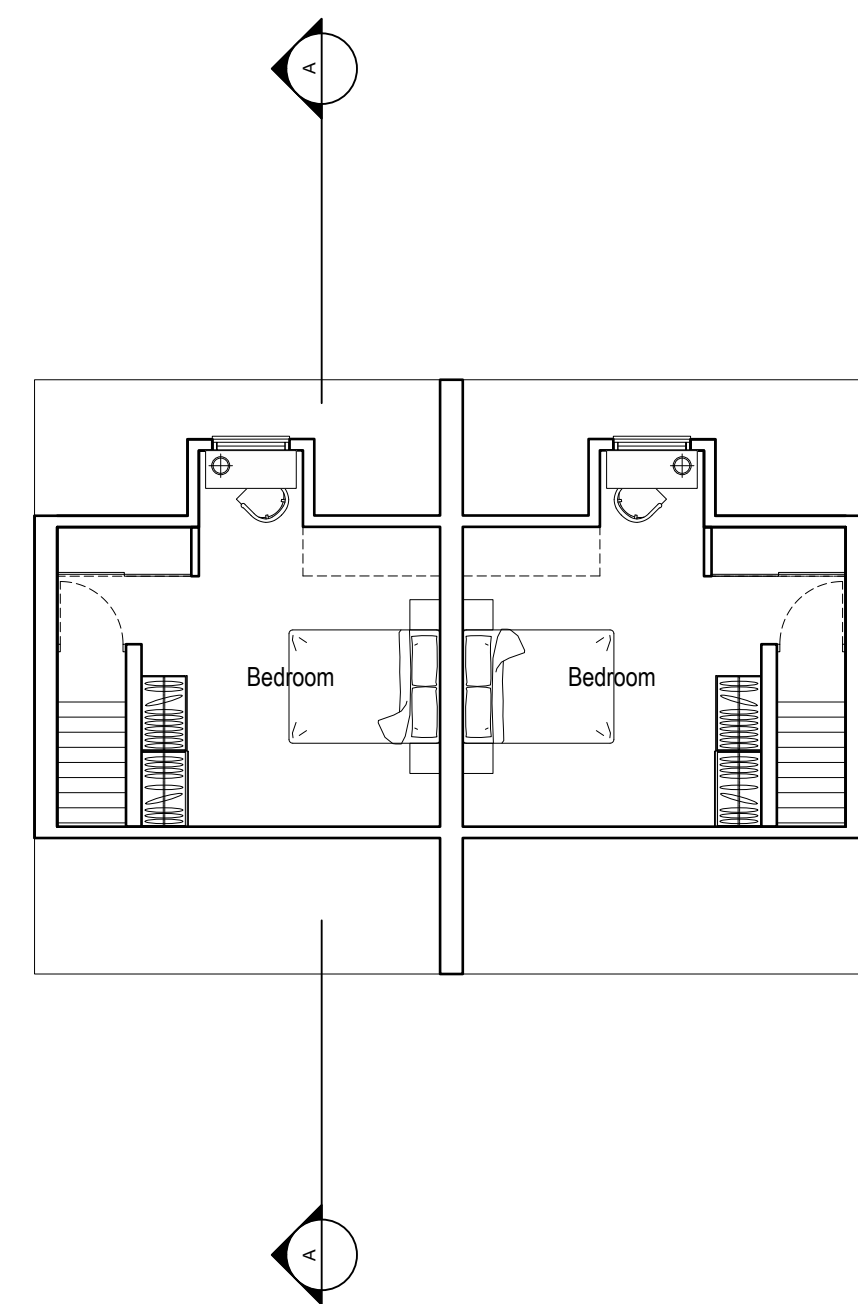

SECOND FLOOR PLAN

0 1 5 10
Metres
Scale 1:100