




PROPOSED GARAGE & OFFICE

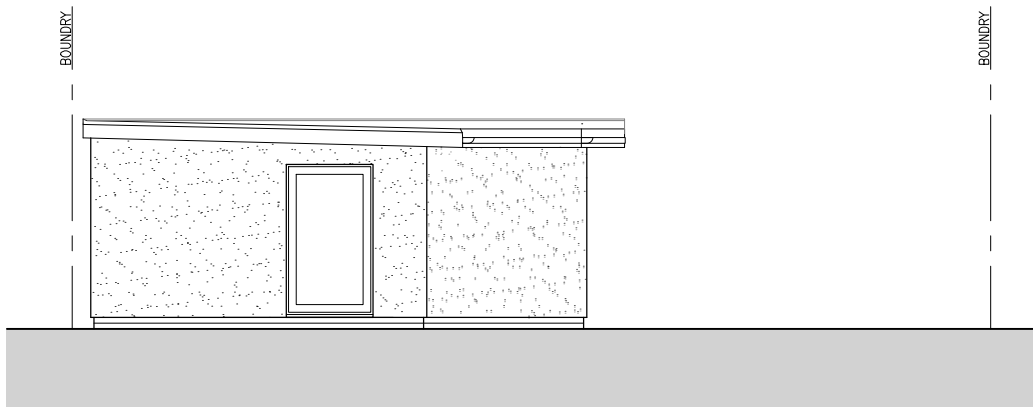


PROPOSED SIDE ELEVATION  
1:100

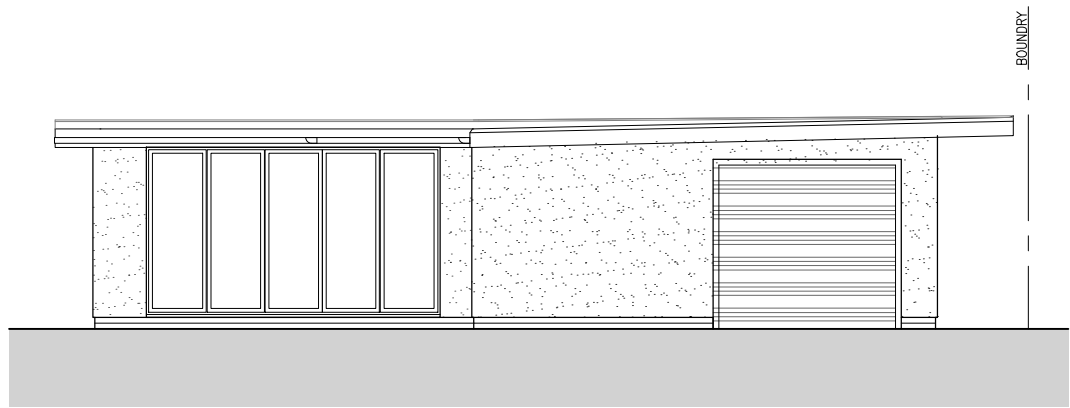


PROPOSED FRONT ELEVATION  
1:100

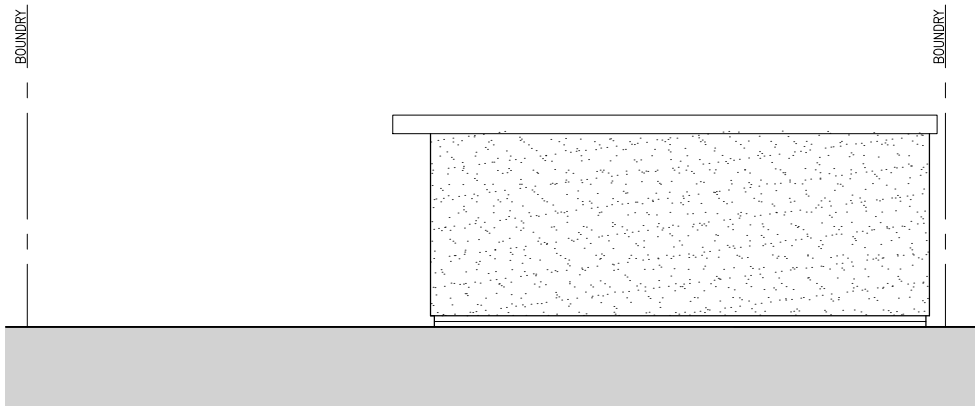


PROPOSED SIDE ELEVATION  
1:100

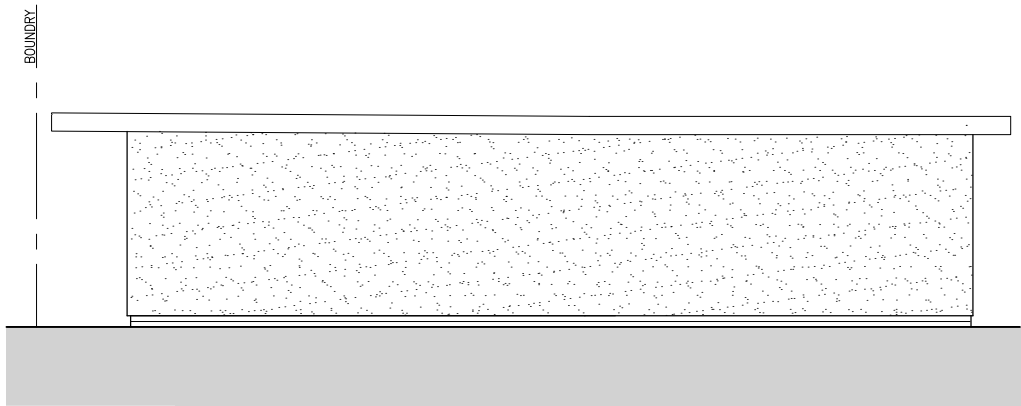


PROPOSED REAR ELEVATION  
1:100

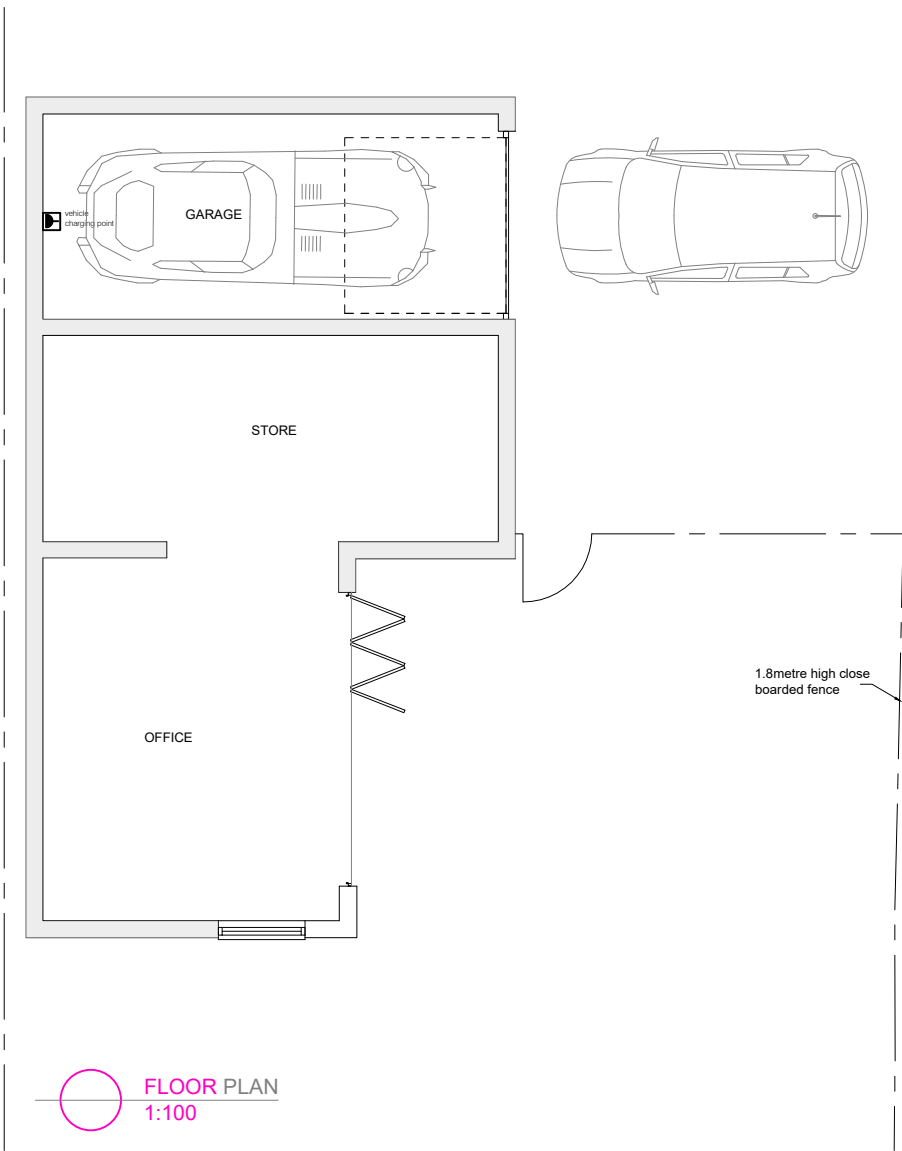

FLOOR PLAN  
1:100

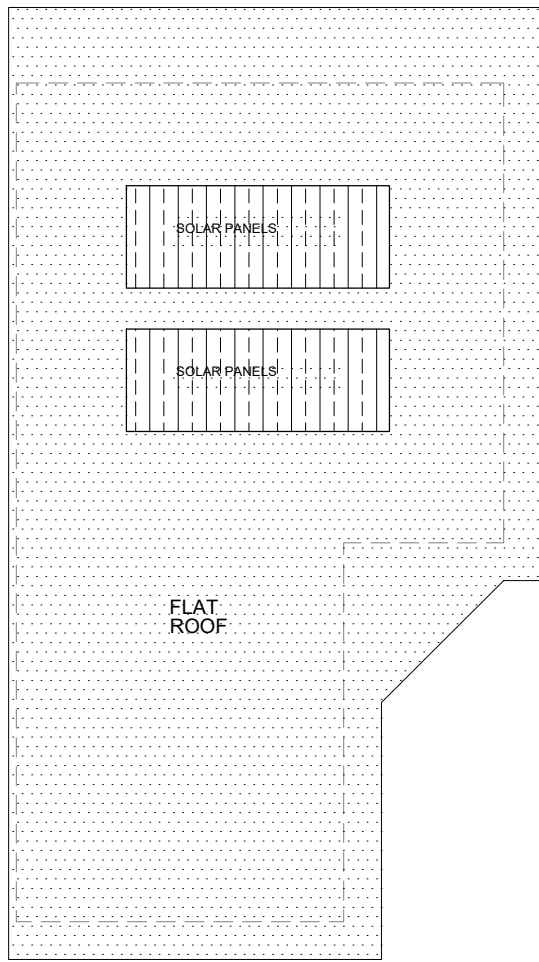

ROOF PLAN  
1:100

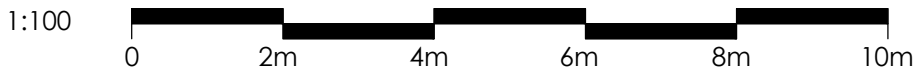

Rev C Up-dated to as built so far and Client instruction  
Rev B Carport removed and garage roof changed to flat roof

|                                                                  |                                |                                                                            |               |
|------------------------------------------------------------------|--------------------------------|----------------------------------------------------------------------------|---------------|
| JOB TITLE<br>196 LOWER HIGHAM ROAD<br>GRAVESEND<br>KENT DA12 2NN |                                | DRAWING TITLE<br>PROPOSED GARAGE AND OFFICE<br>PLANS, ELEVATIONS & SECTION |               |
| SCALE<br>1:100@A2                                                | DRAWING NUMBER<br>BDS-LHR-P903 | DATE<br>DEC '20                                                            | REVISION<br>D |

