



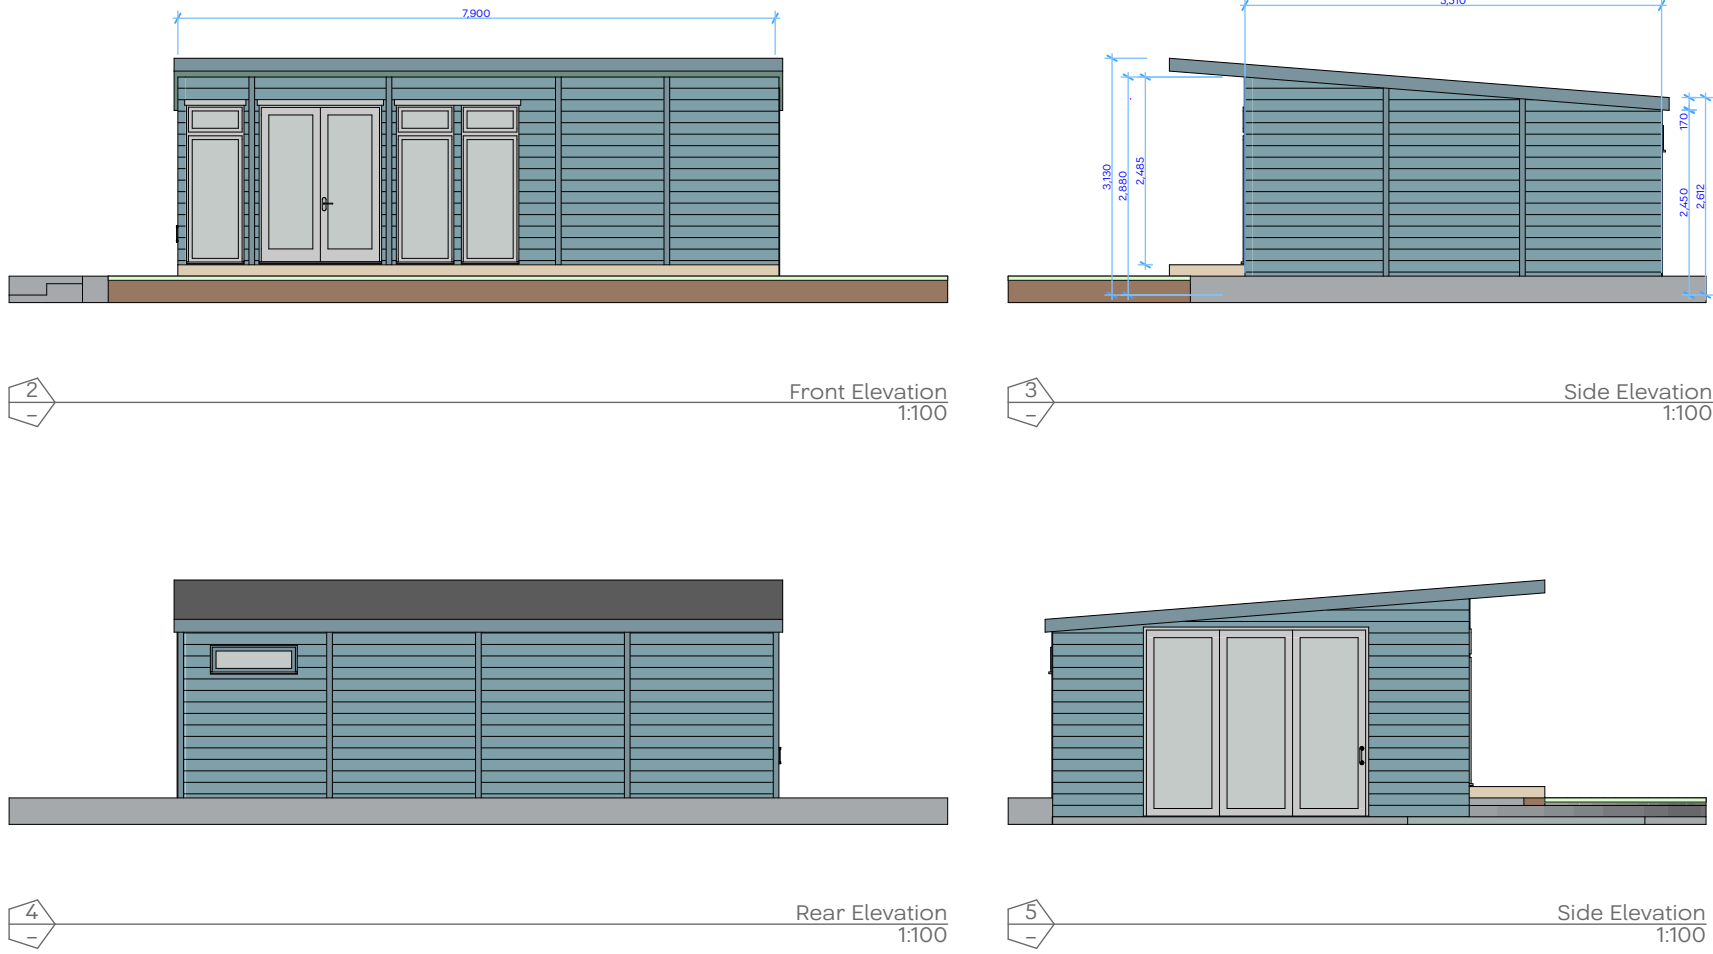

As-Built Plan and Elevations

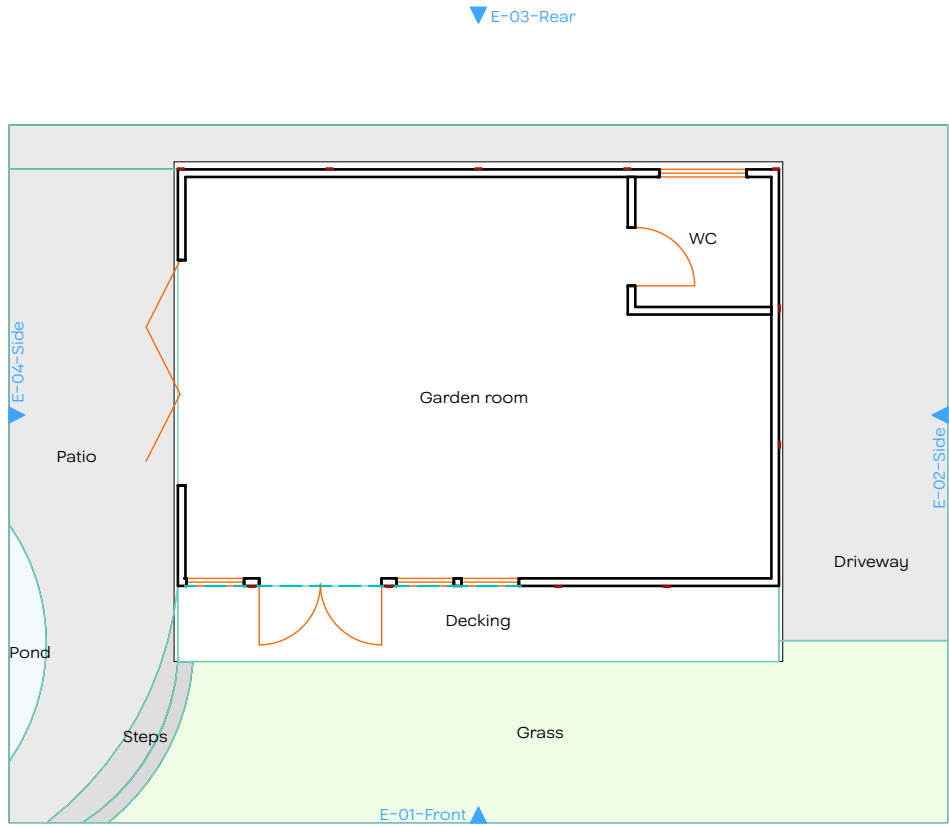

Kevin Wise
Town Planning

The Old Estate Office, Ewell Manor Estate, Ewell Lane,
West Farleigh, Kent ME15 0NG
Email:info@kevinwiseplanning.co.uk

RTPI
mediation of space · making of place

Address :-

68 Beechwood Drive, Culverstone, Kent

Project :-

Outbuilding

Scale :-
As Marked

Date :-
Oct 2023

Drawing No. :-
P.01

Paper Size :-
A2




Drawn by :-
JLRC

Revision :-

www.kevinwiseplanning.co.uk

01622 813349

Revision :-

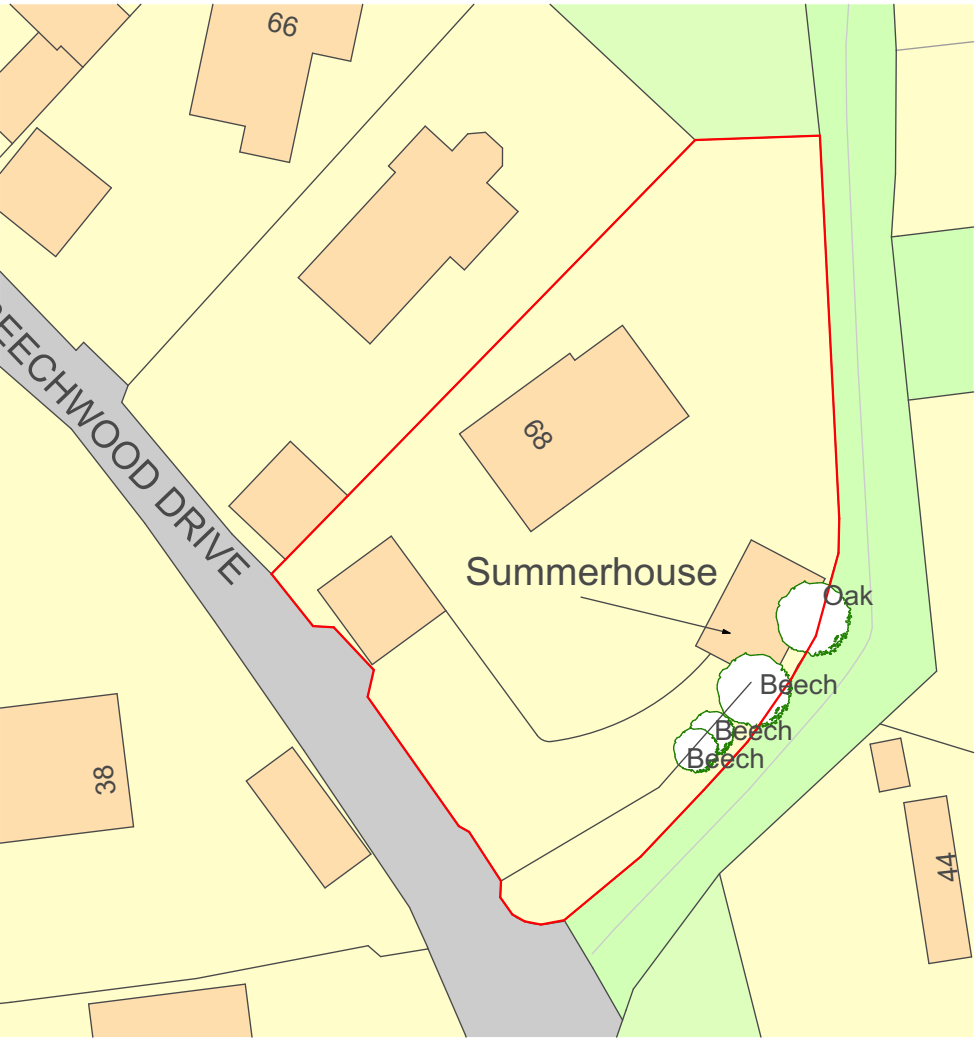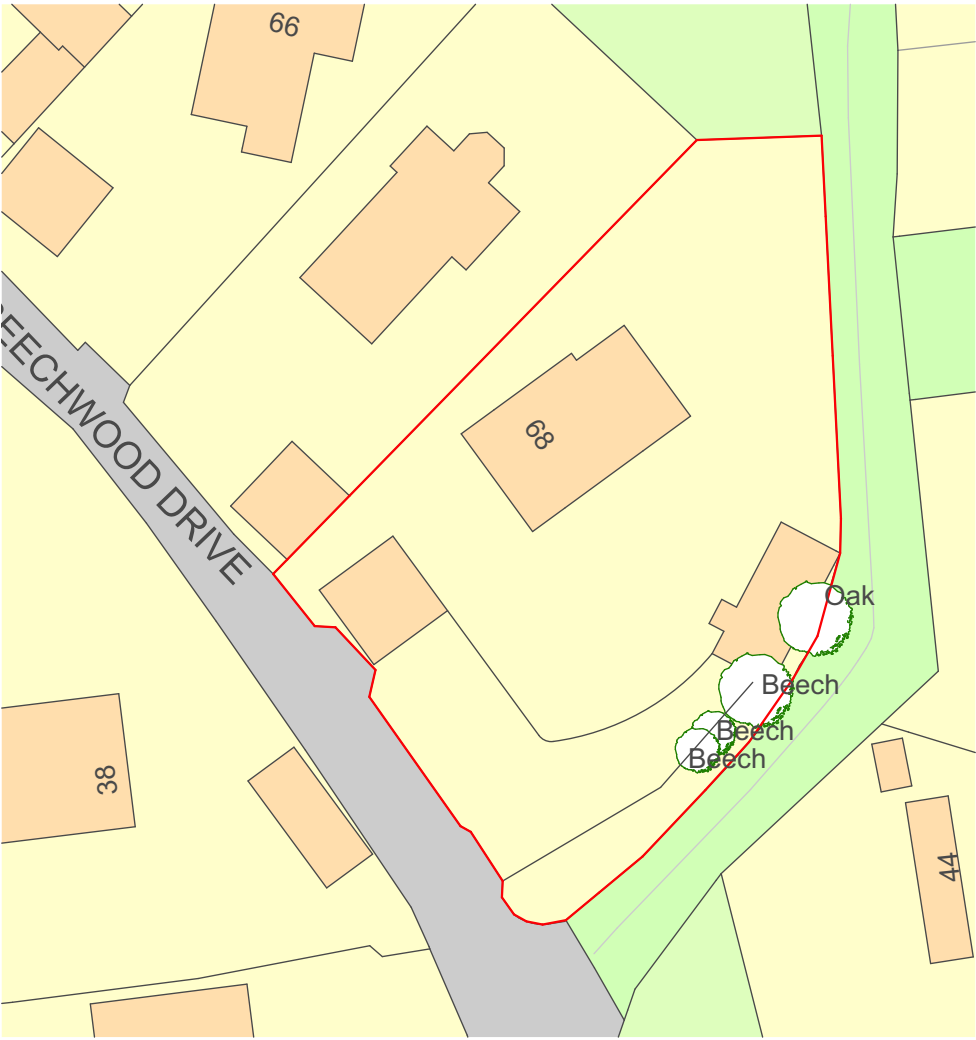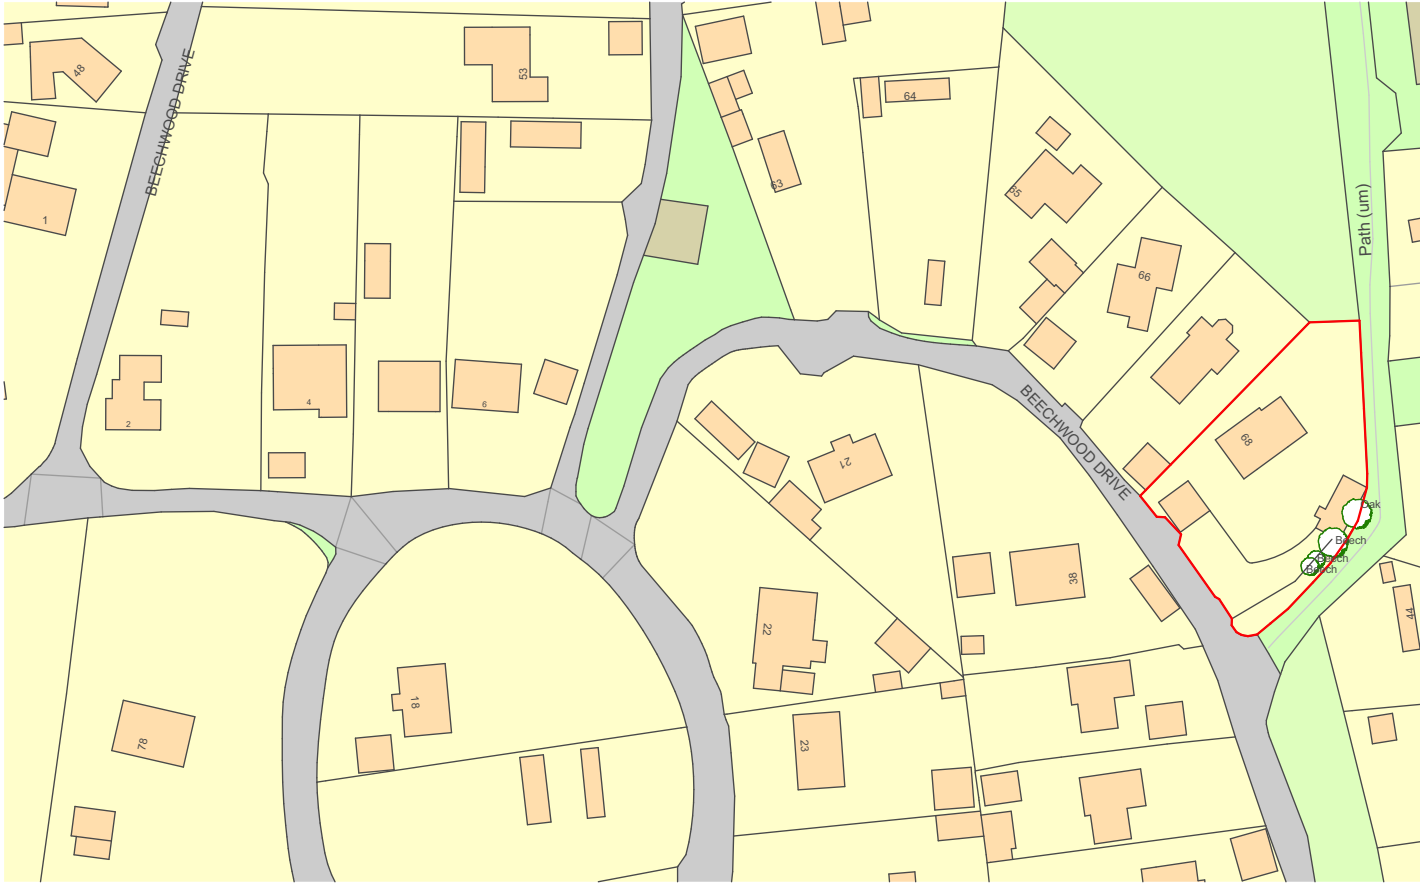

6 Location Plan 1:1250 7 Existing Block Plan 1:500 8 Proposed Block Plan 1:500

