


FRONT VIEW : FOR CONVERSION OF OUTBUILDING TO ANNEXE
AT 124 ST DUNSTONS DRIVE DA12 4BQ 18-10-2021.

SCALE 1:100 ON A4.  5metres DWG N° 3

NB. THERE ARE NO DIMENSIONAL OR STRUCTURAL CHANGES.

OR CHANGES TO EXTERNAL APPEARANCE AT ALL

EXISTING AS BUILT IN 2013

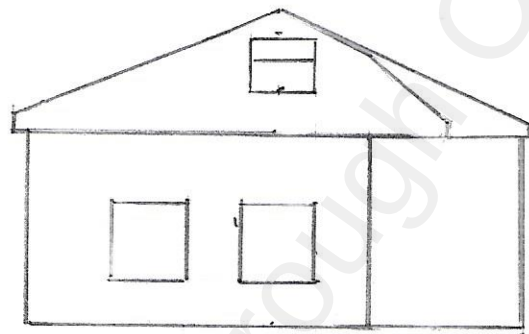

PROPOSED (NO CHANGE AT ALL)

