




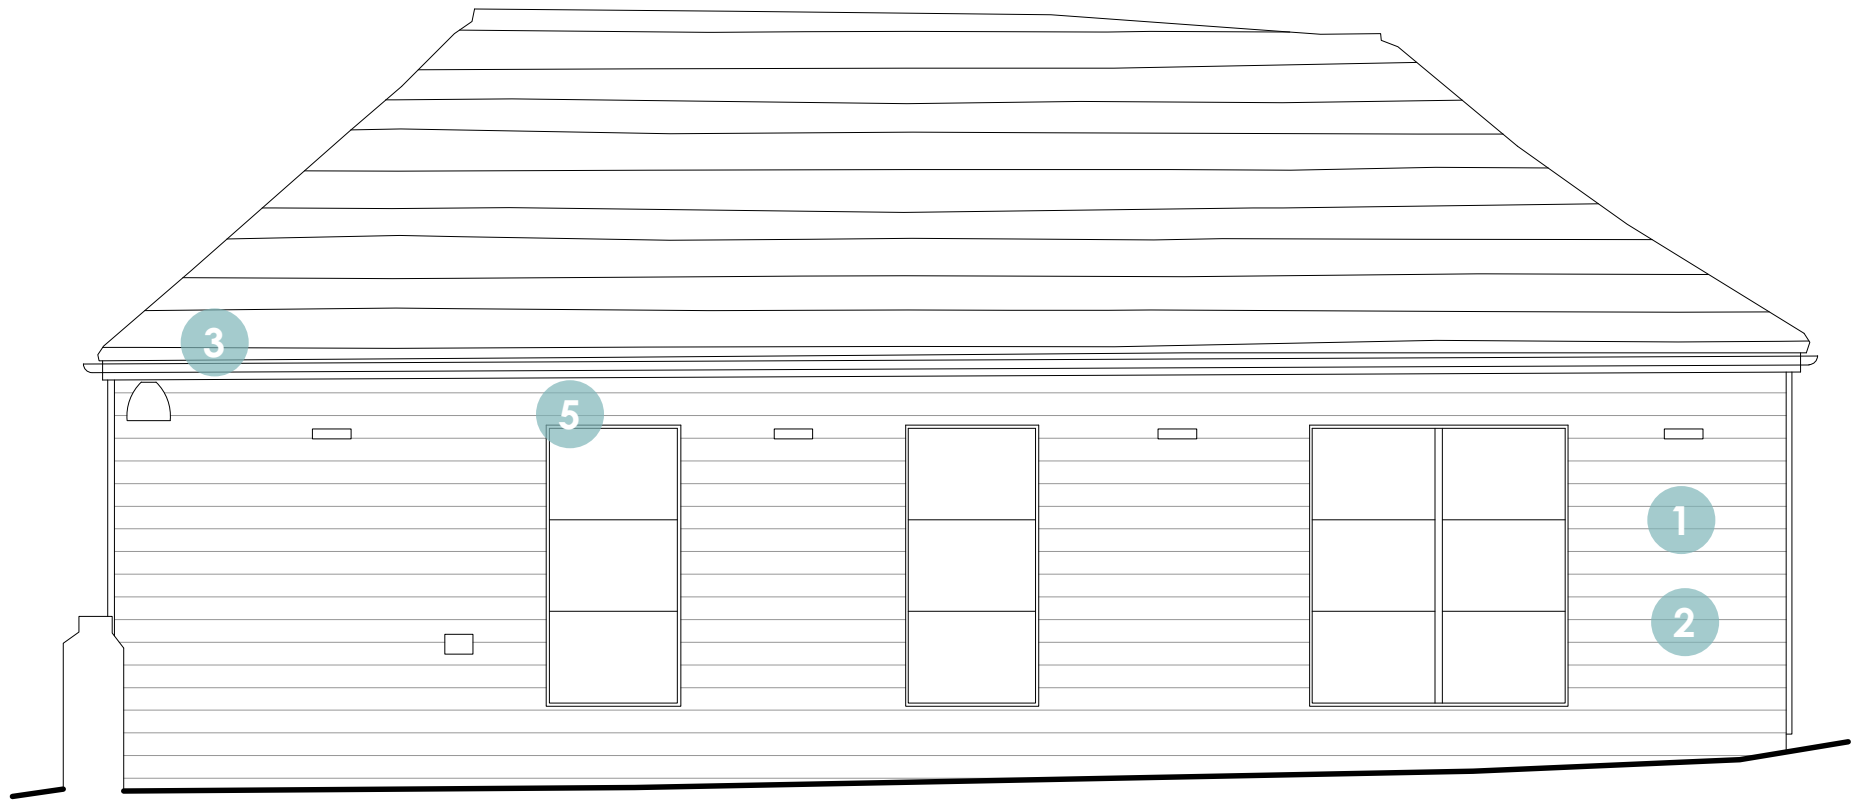


Proposed Elevation 27 as constructed

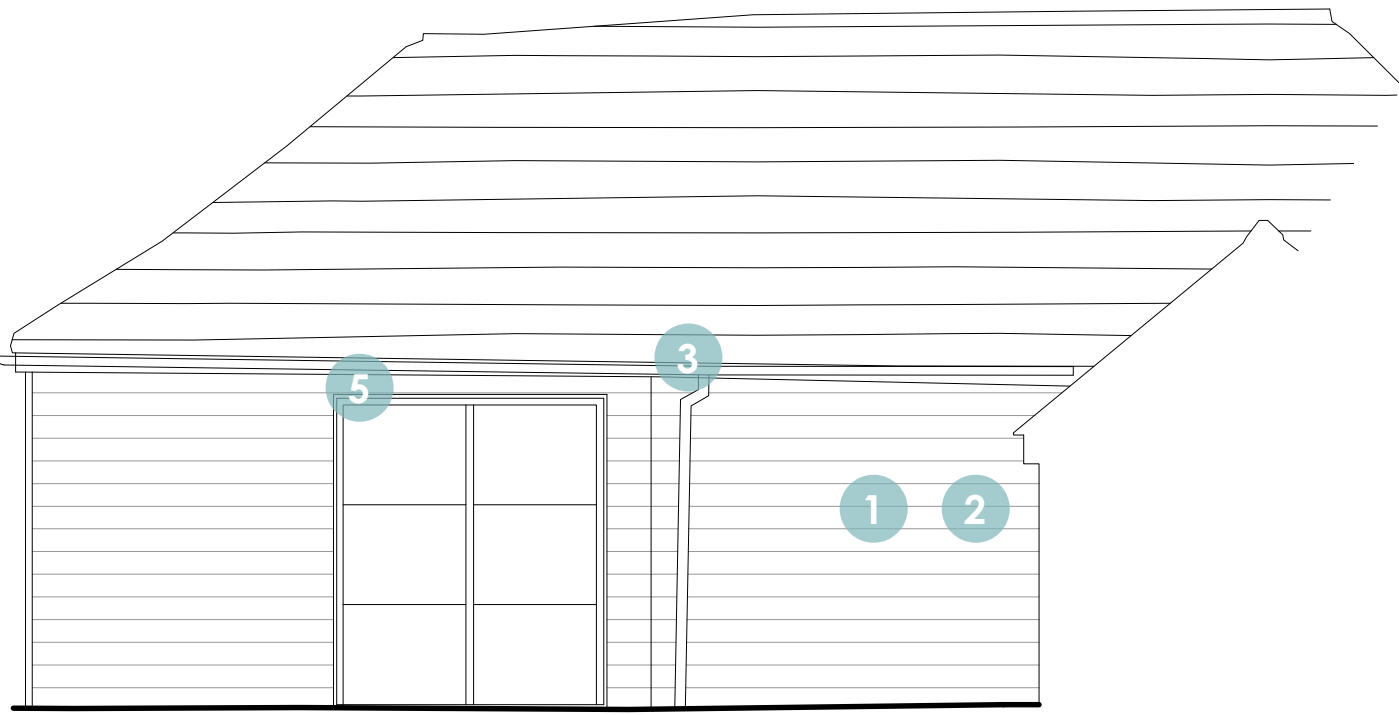


Proposed Elevation 25 as constructed

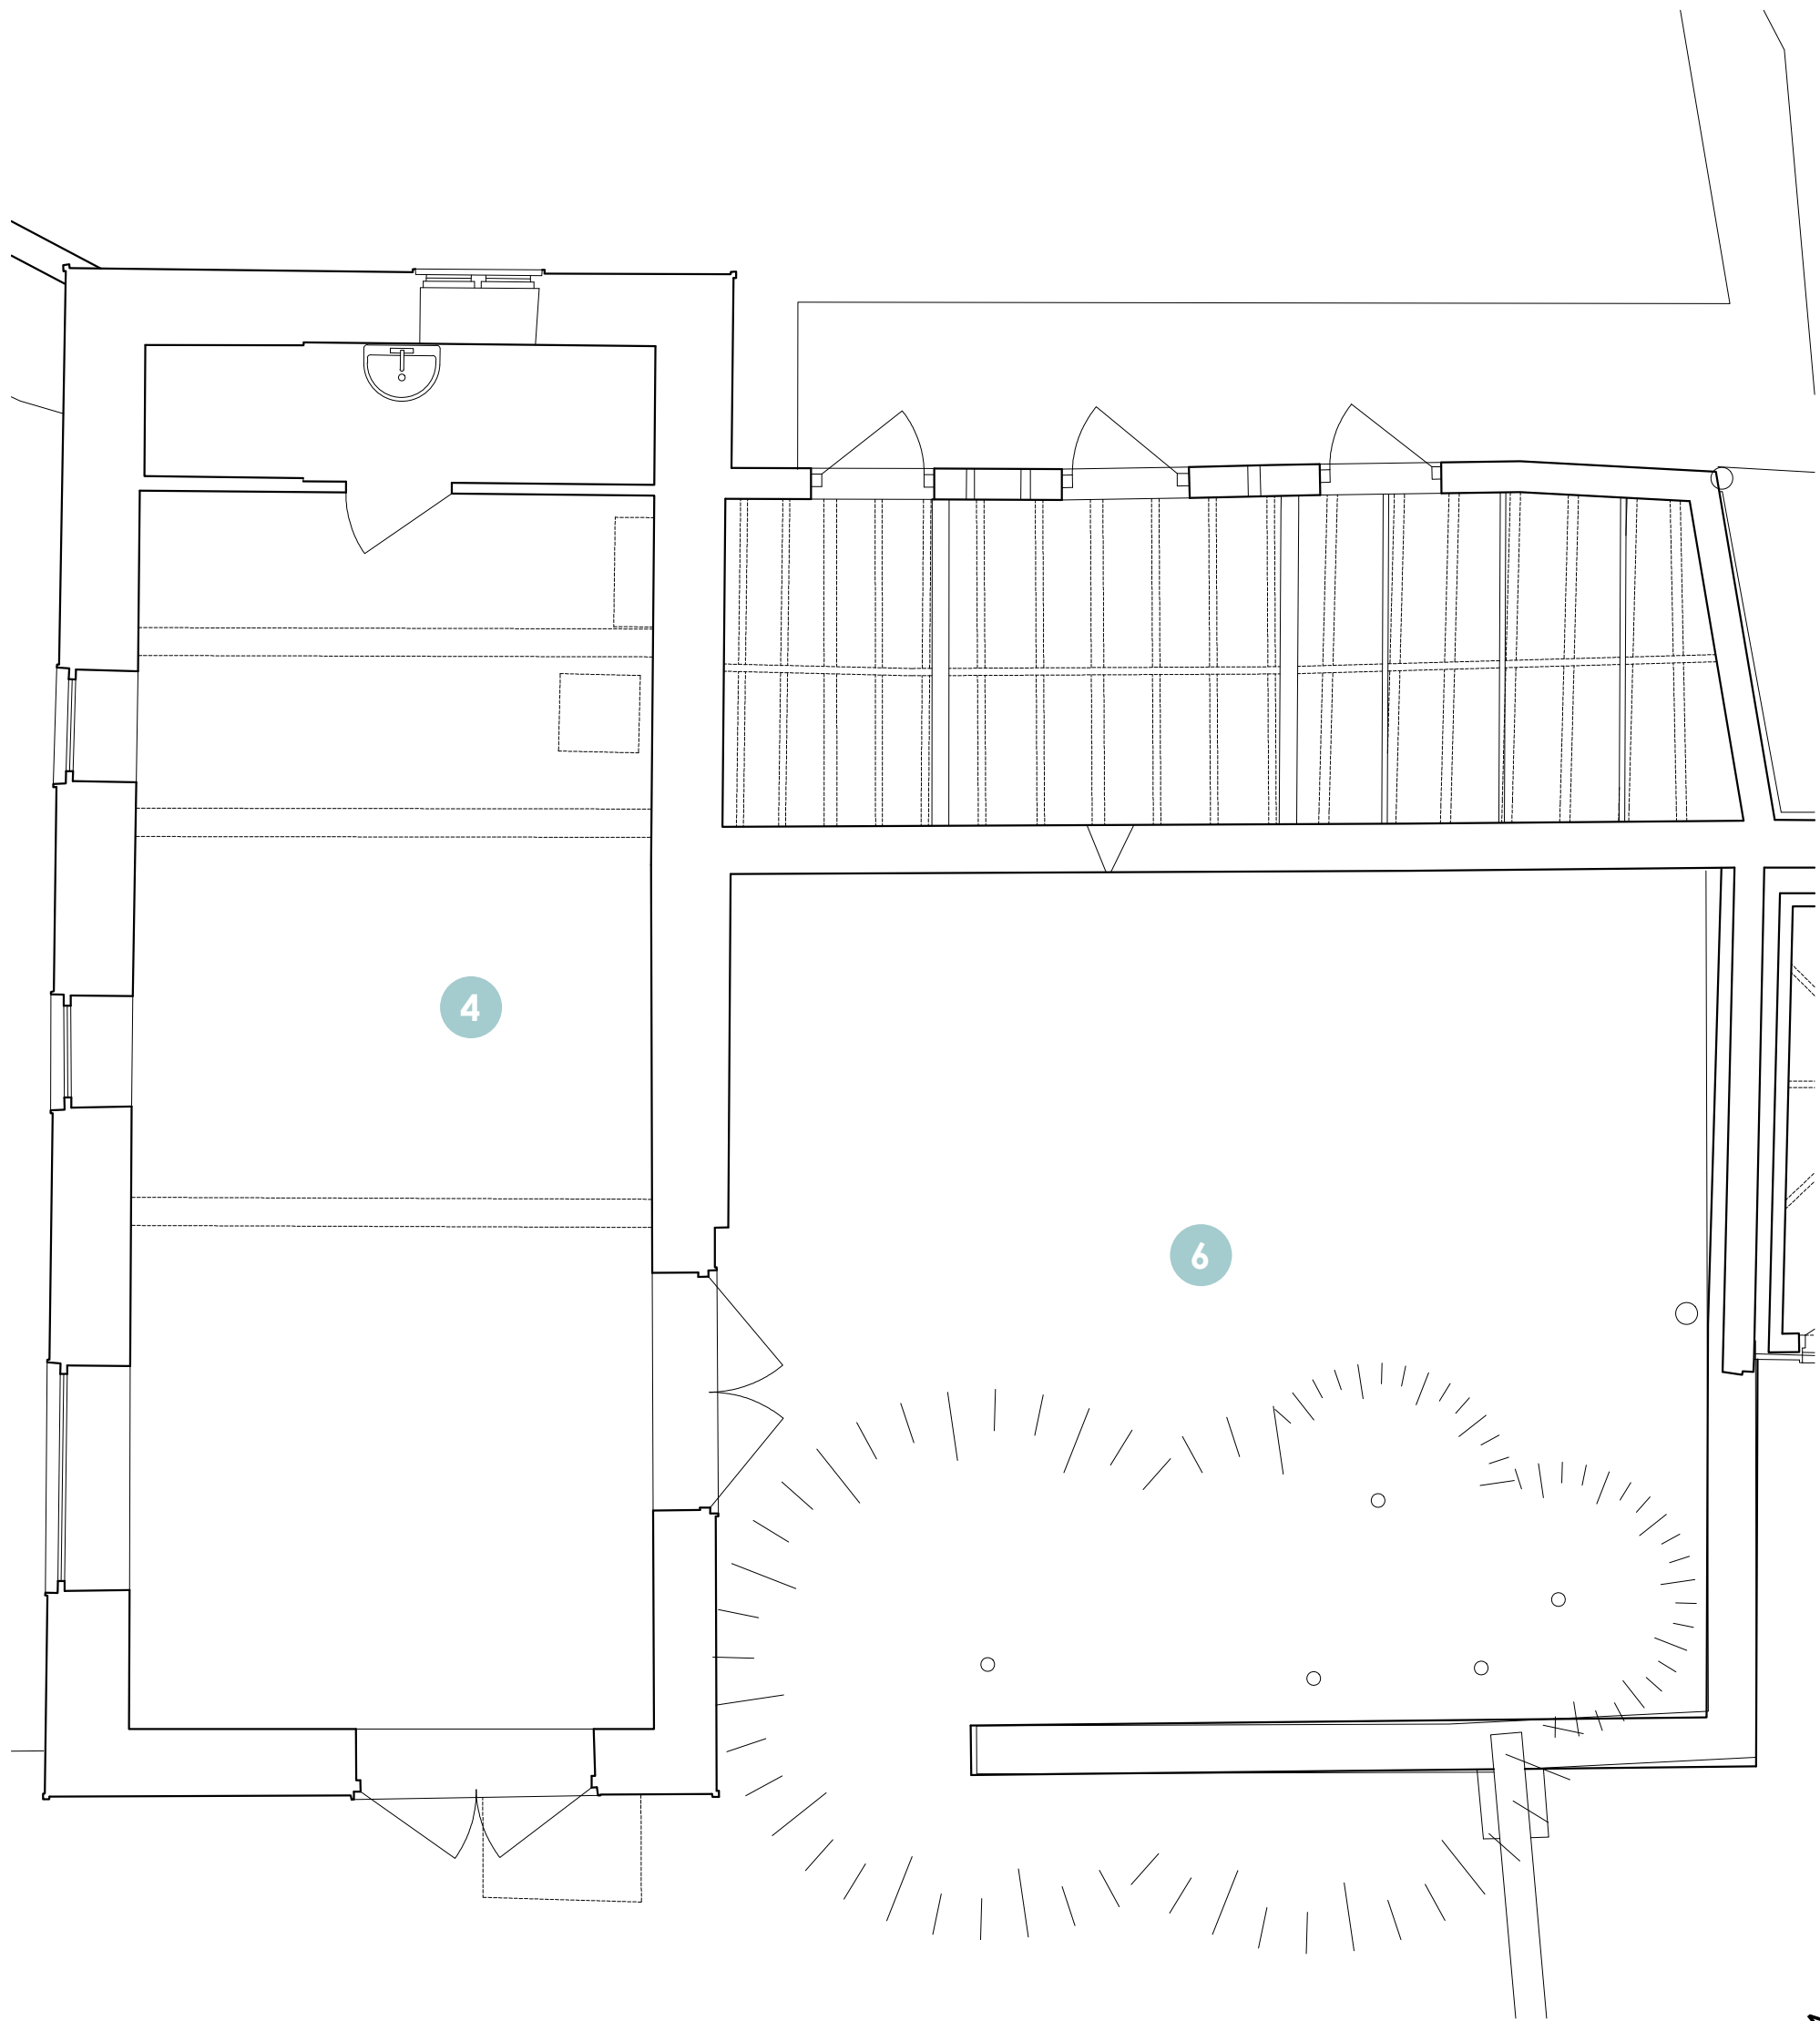

Proposed Floor Plan as constructed

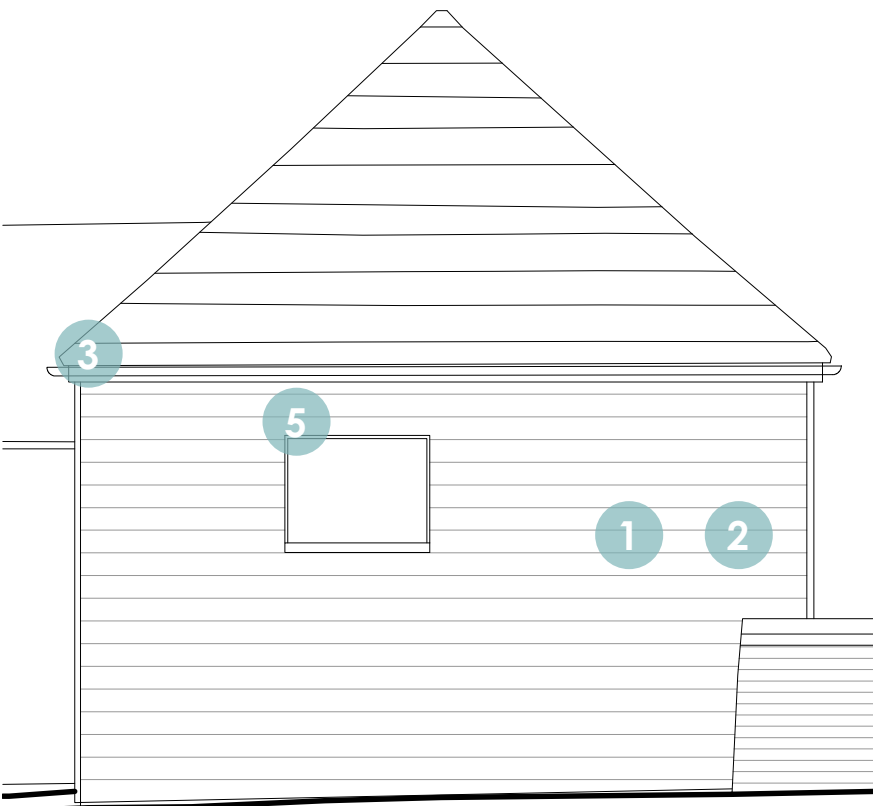

Proposed Elevation 28 as constructed

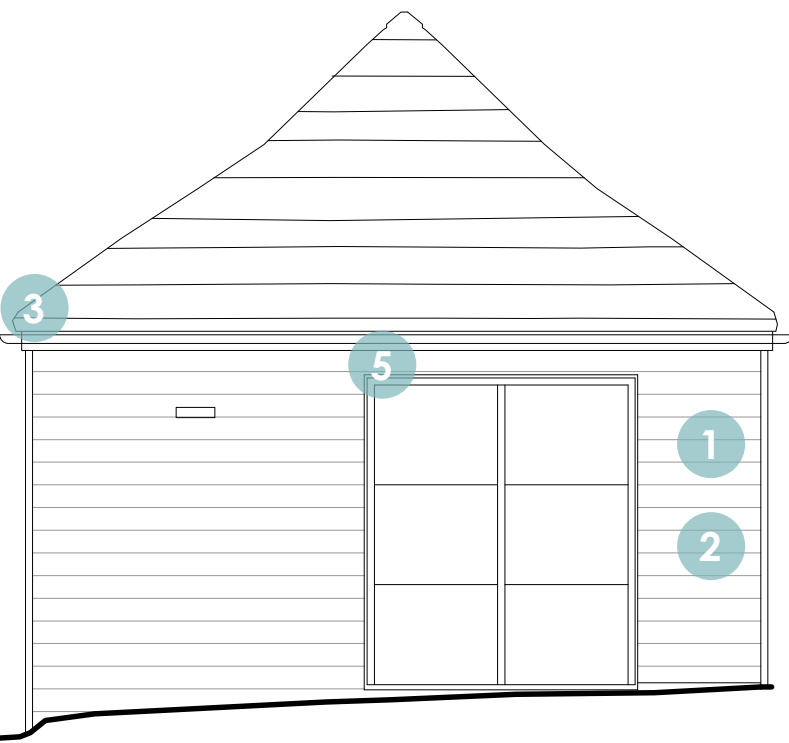

Proposed Elevation 26 as constructed



Photo of Elevation 25



Photo of Elevation 26



Photo of Elevation 27

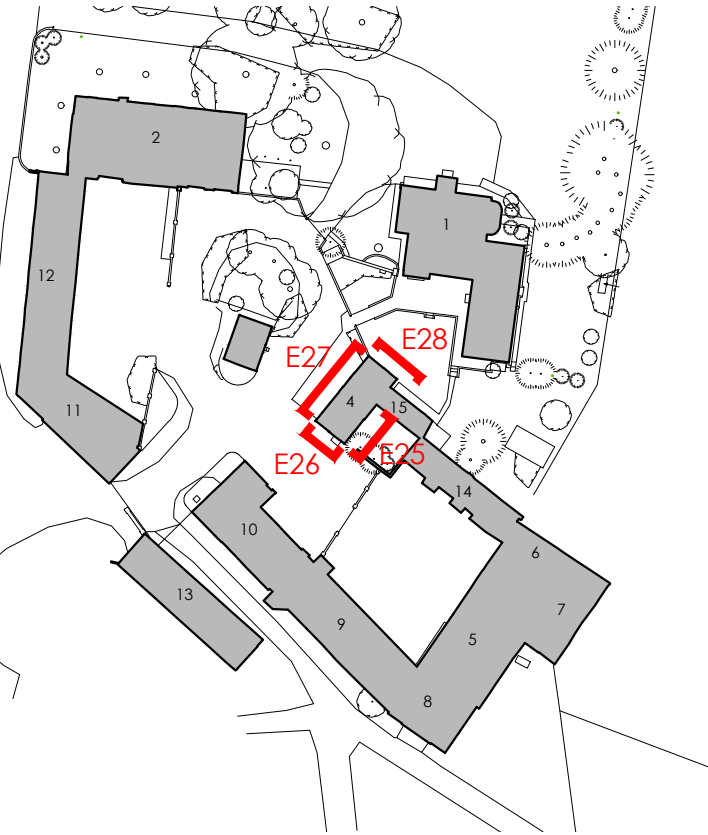


Photo of Elevation 28

This drawing and the design are the copyright of **ON Architecture Ltd only**.
This drawing should not be copied or reproduced without written consent.
All dimensions are to be checked on site prior to setting out and fabrication and **ON Architecture Ltd** should be notified of any discrepancy prior to proceeding further.
For Construction & Fabrication Purposes - Do not scale from this drawing, use only the illustrated dimensions herein. Additional dimensions are to be requested and checked directly.
Illustrated information from 3rd party consultants/specialists is shown as indicatively only See other consultant / specialist drawings for full information and detail.
All aspects of the architectural design concerning fire performance / fire safety (whether or not illustrated / annotated) are to be considered as For Approval only, irrespective of the drawing status / suitability.

Scale: 1:50
0 1 3 5m

Key:



Materials:

- 1 Pre-treated black / feather-edge timber cladding
- 2 Blackbird paint
- 3 FloPlast uPVC guttering
- 4 Marble stone floor tiles
- 5 Black aluminium doors and windows
- 6 Stone effect porcelain tiles

All survey drawings produced by OmegaGeo
Please refer to Job Ref. 2414908, Drawing no. 2 of 3
for further details

Revision	Date	Note	Amended	Checked
Rev	Date	Note	Amended	Checked

ON ARCH TECT URE

Canterbury Studio
Logan House, St Andrews Close
Canterbury,
CT1 2RP

info@onarchitecture.co.uk
onarchitecture.co.uk
01227 634334

Project Title
WHITEHOUSE FARM, LAND WAY

Client's Details
WINDMILL CONSTRUCTION

Drawing Title
**BUILDING 4 - PROPOSED FLOOR PLAN
AND ELEVATIONS AS CONSTRUCTED**

Block Number
24.051-ONA-ZZ-XX-DR-A - 0300.000

Scale
1:50 @ A1

Date
MAY 2024

Drawn
IH

Checked
JR

Drawing Status
PLANNING

Project No.
24.051

Drawing No.
0300.000

Status
P

Revision
