






Proposed Elevation 6 as constructed

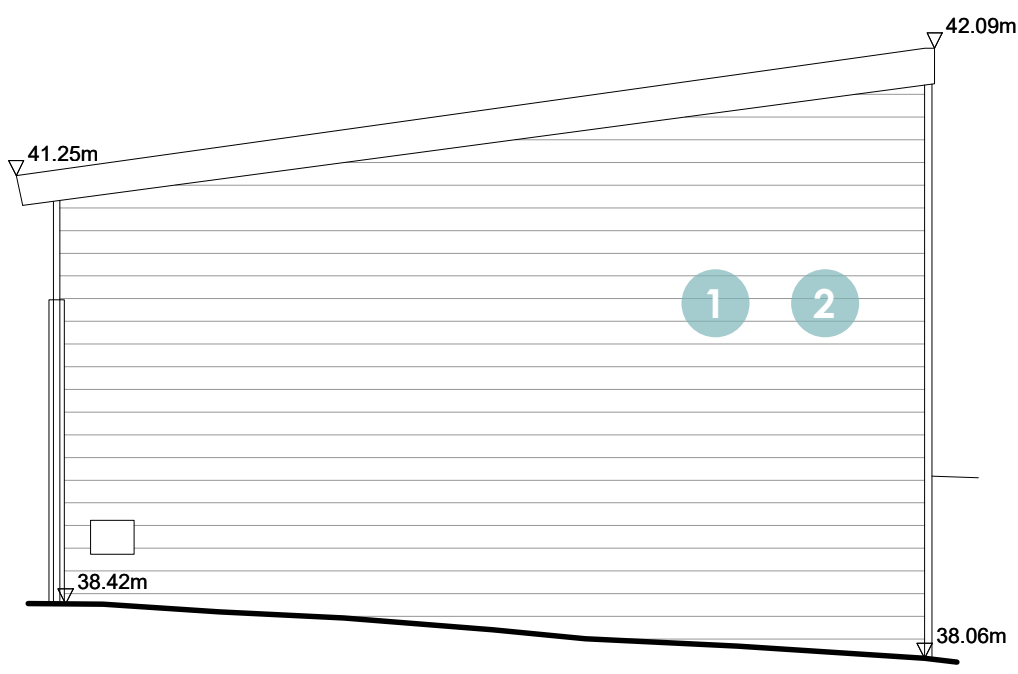

Proposed Elevation 7 as constructed

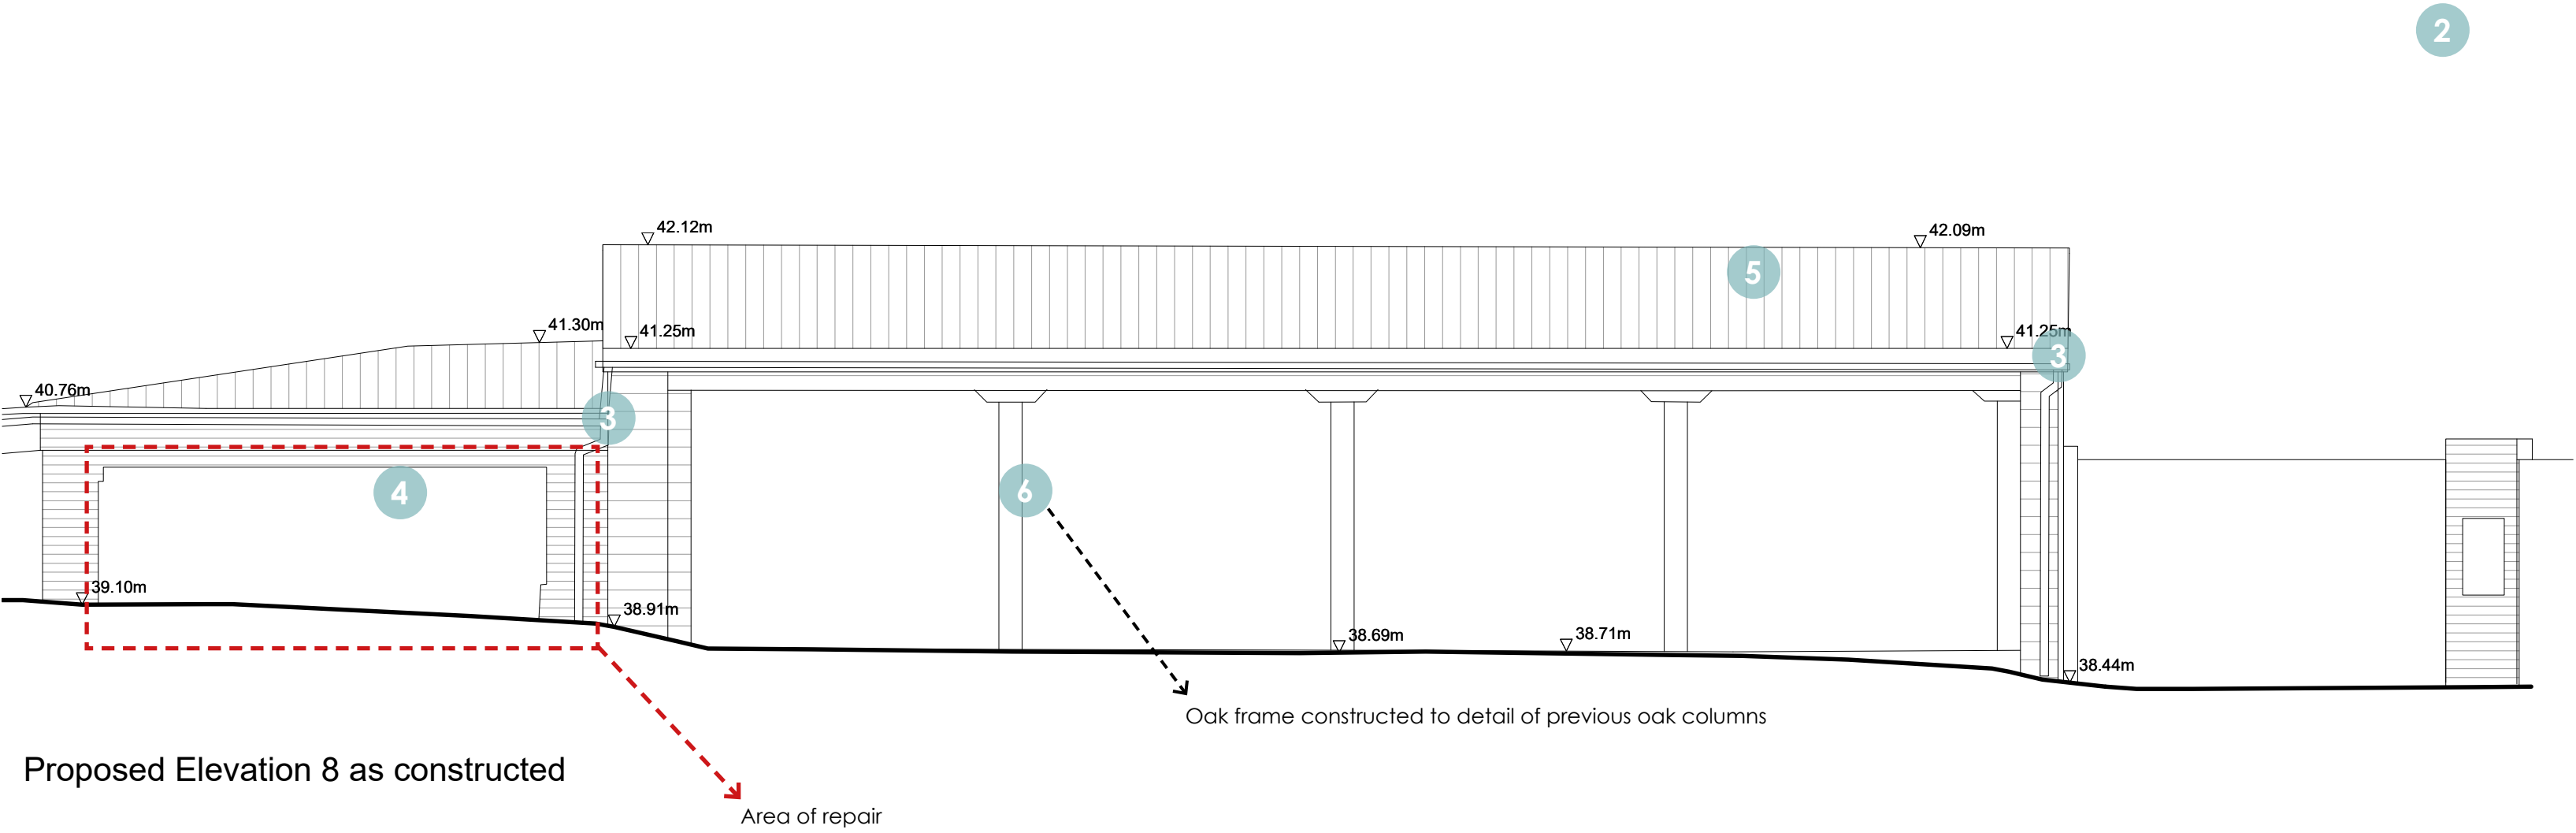

Proposed Elevation 8 as constructed

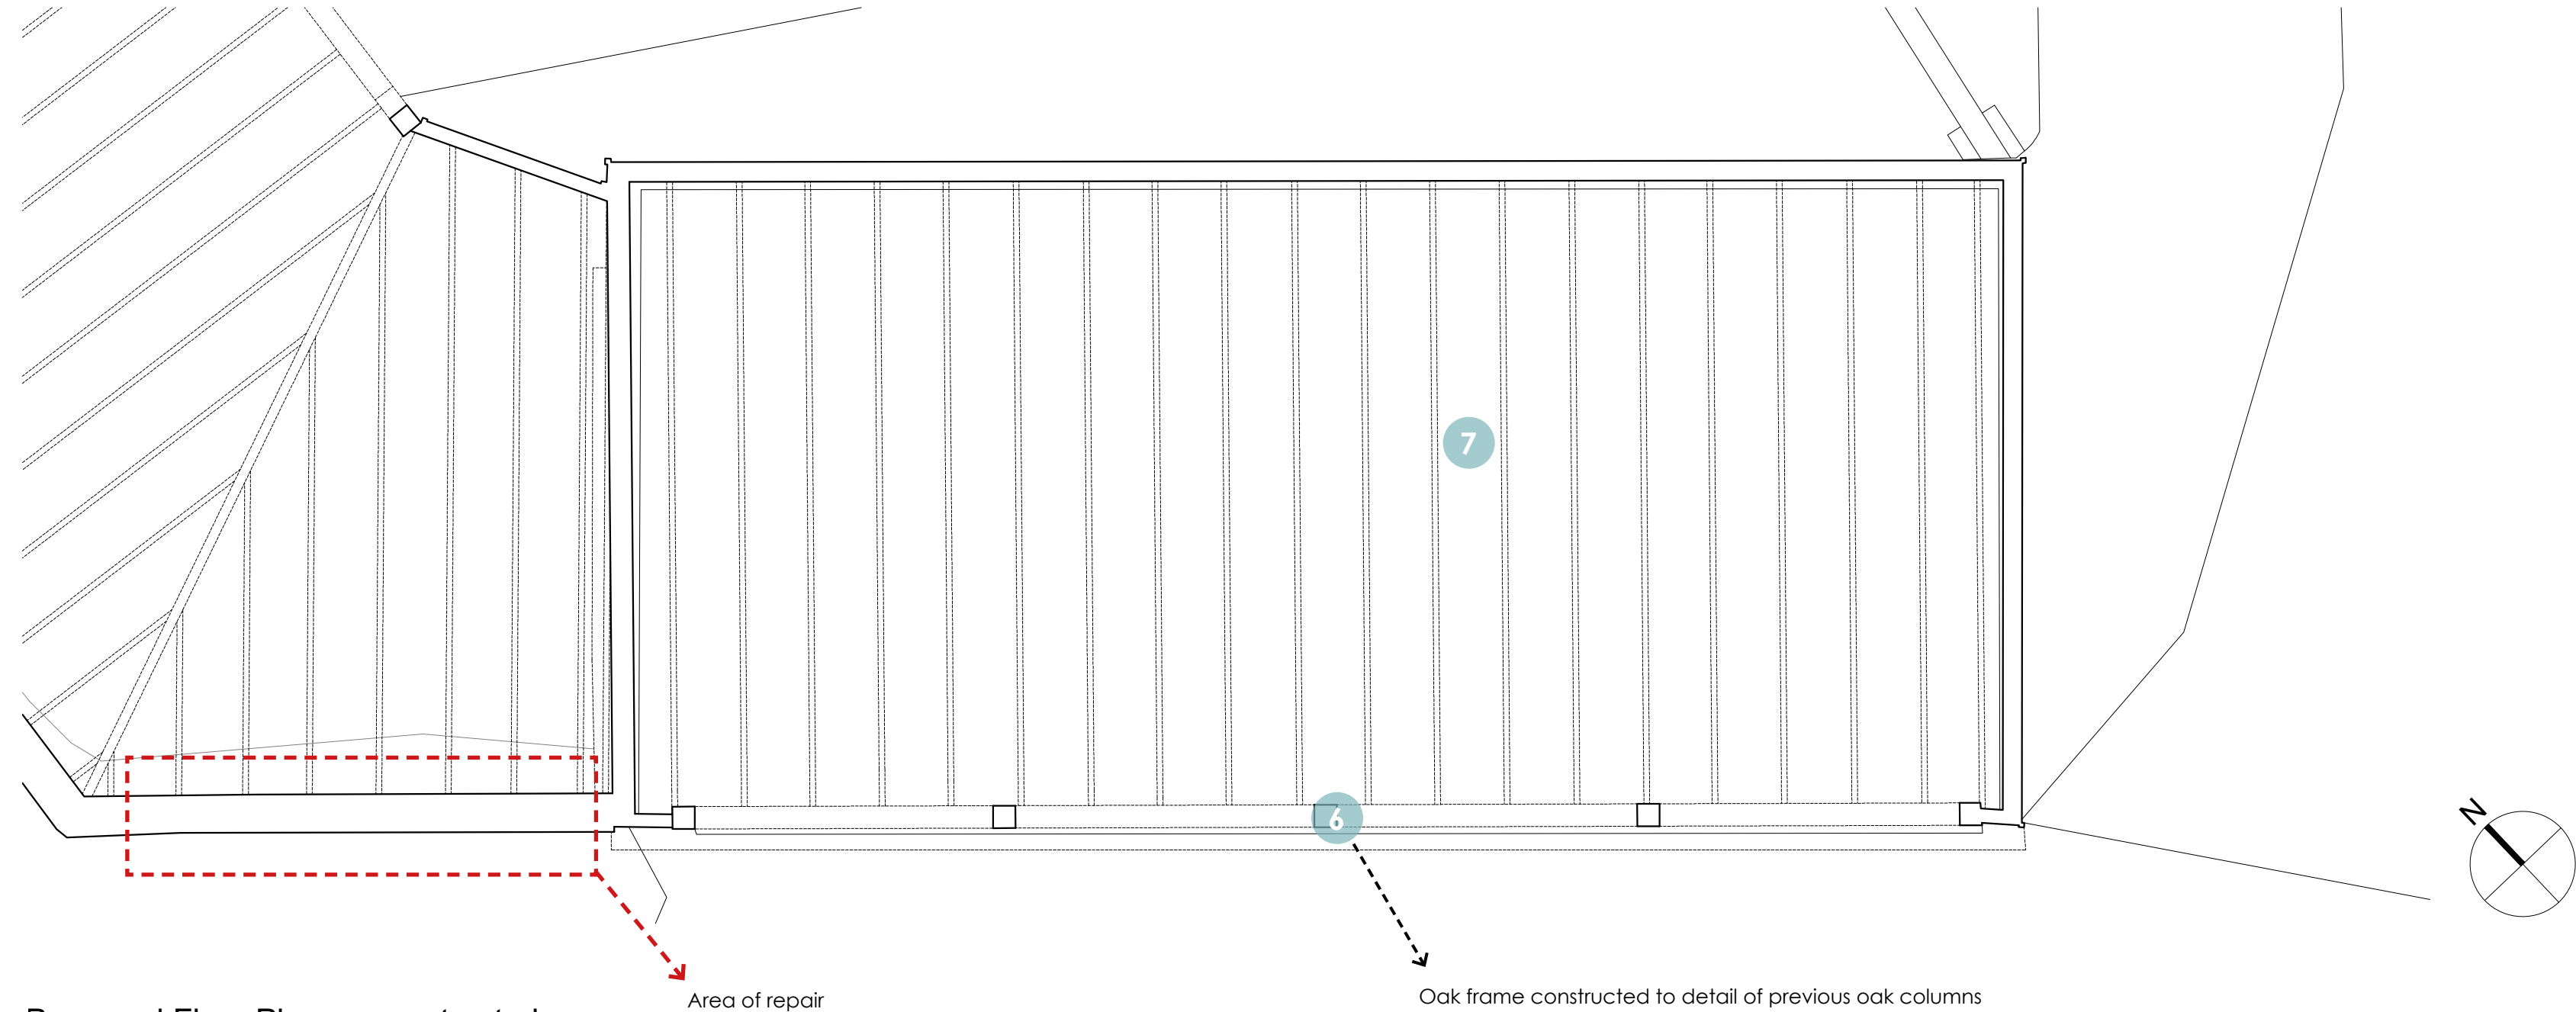

Proposed Floor Plan as constructed



Photo of Elevation 6



Photo of Elevation 7



Photo of Elevation 8

This drawing and the design are the copyright of **ON Architecture Ltd only**.
This drawing should not be copied or reproduced without written consent.

All dimensions are to be checked on site prior to setting out and fabrication and **ON Architecture Ltd** should be notified of any discrepancy prior to proceeding further.

For Construction & Fabrication Purposes - Do not scale from this drawing, use only the illustrated dimensions herein. Additional dimensions are to be requested and checked directly.


Illustrated information from 3rd party consultants/specialists is shown as indicatively only. See other consultant / specialist drawings for full information and detail.

All aspects of the architectural design concerning fire performance / fire safety (whether or not illustrated / annotated) are to be considered as For Approval only, irrespective of the drawing status / suitability.

Scale: 1:50

0 1 3 5m

Key:

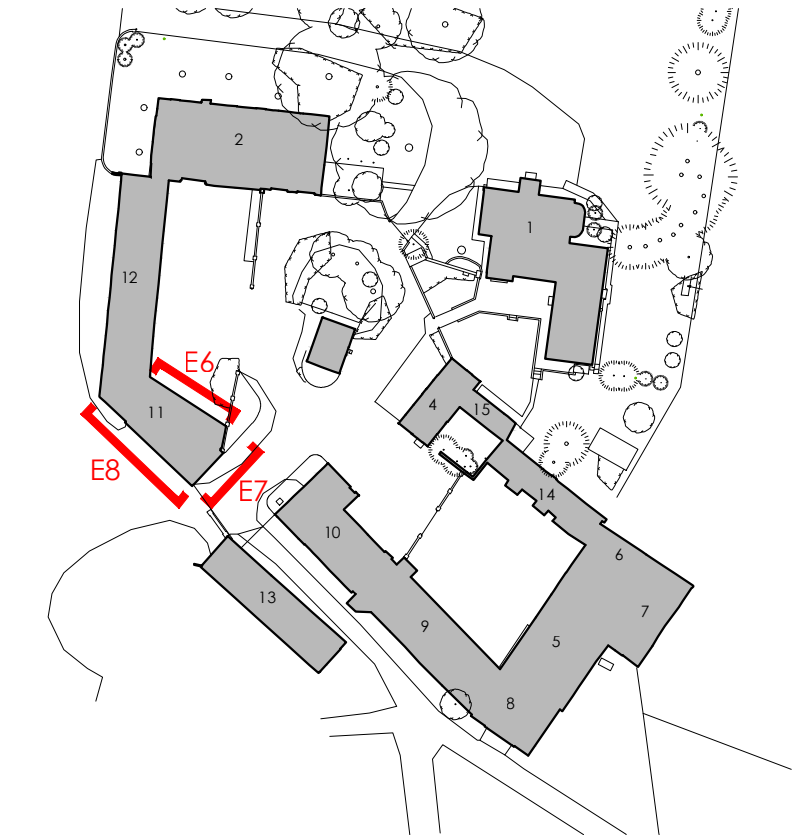

Materials:

- 1 Pre-treated black / feather-edge timber cladding
- 2 Blackbird paint
- 3 Cast iron guttering
- 4 Flint wall repaired using lime mortar mix (area of repair highlighted)
- 5 Onduline corrugated roof
- 6 Replaced oak frame timber columns
- 7 Concrete floor

All survey drawings produced by OmegaGeo
Please refer to Job Ref. 2414908, Drawing no. 2 of 3
for further details

Revision Note & Date		Amended		Checked	
Rev	Date	Note			

ON
ARCH
TECT
URE

Canterbury Studio
Logan House, St Andrews Close
Canterbury,
CT1 2RP
info@onarchitecture.co.uk
onarchitecture.co.uk
01227 634334

Project Title
WHITEHOUSE FARM, LAND WAY

Client's Details
WINDMILL CONSTRUCTION

Drawing Title
**BUILDING 11 - PROPOSED FLOOR
PLAN AND ELEVATIONS AS
CONSTRUCTED**
BIM Number
24.051-ONA-ZZ-XX-DR-A - 0302.000

Scale 1:50 @ A1 Date MAY 2024 Drawn IH Checked JR

Drawing Status
PLANNING

Project No.	Drawing No.	Status	Revision
24.051	0302.000	P	----