




Proposed Elevation 14 as constructed

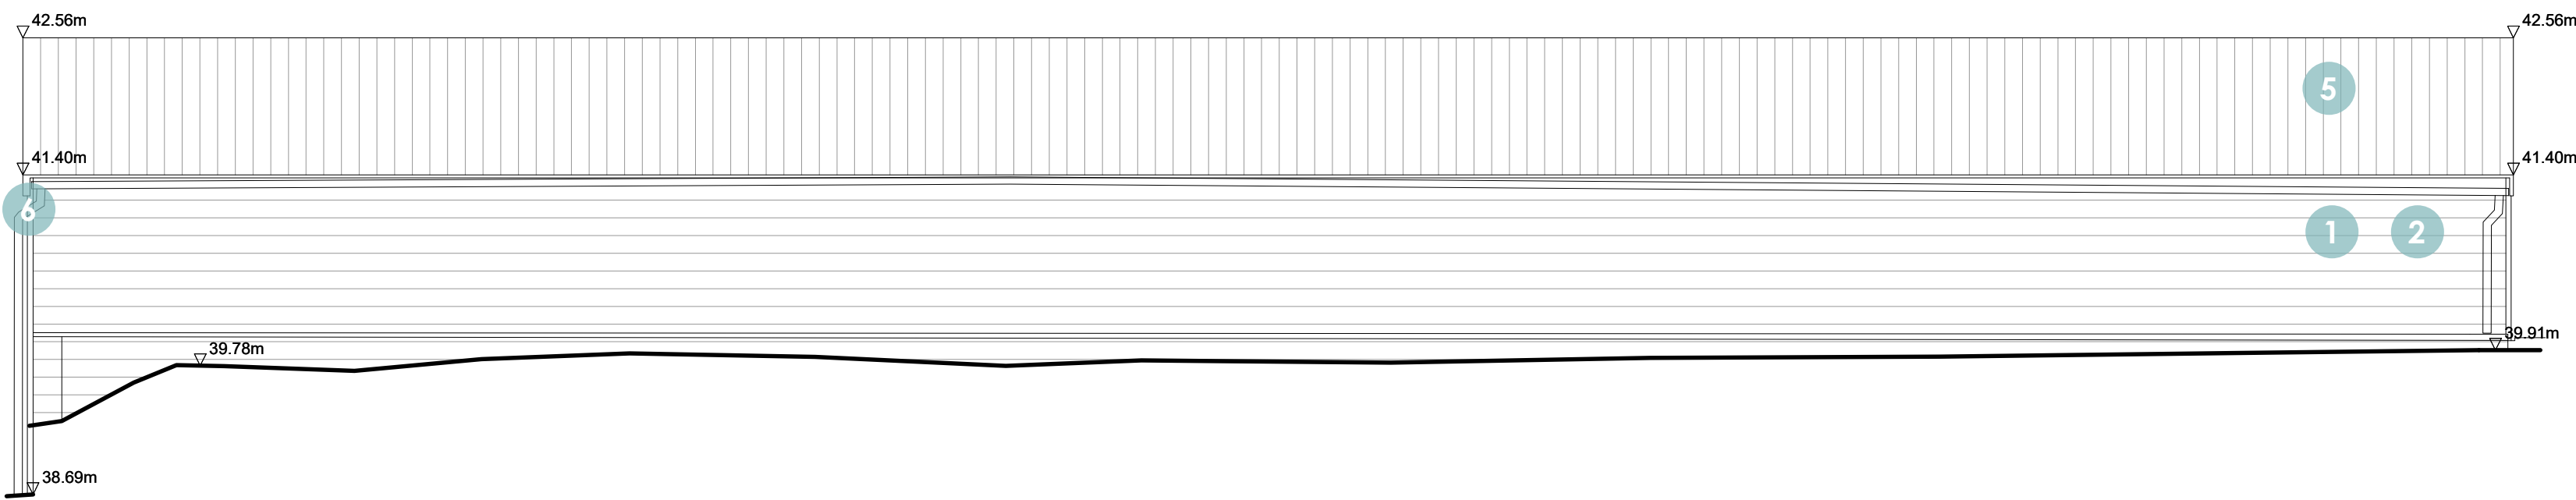


Proposed Elevation 16 as constructed

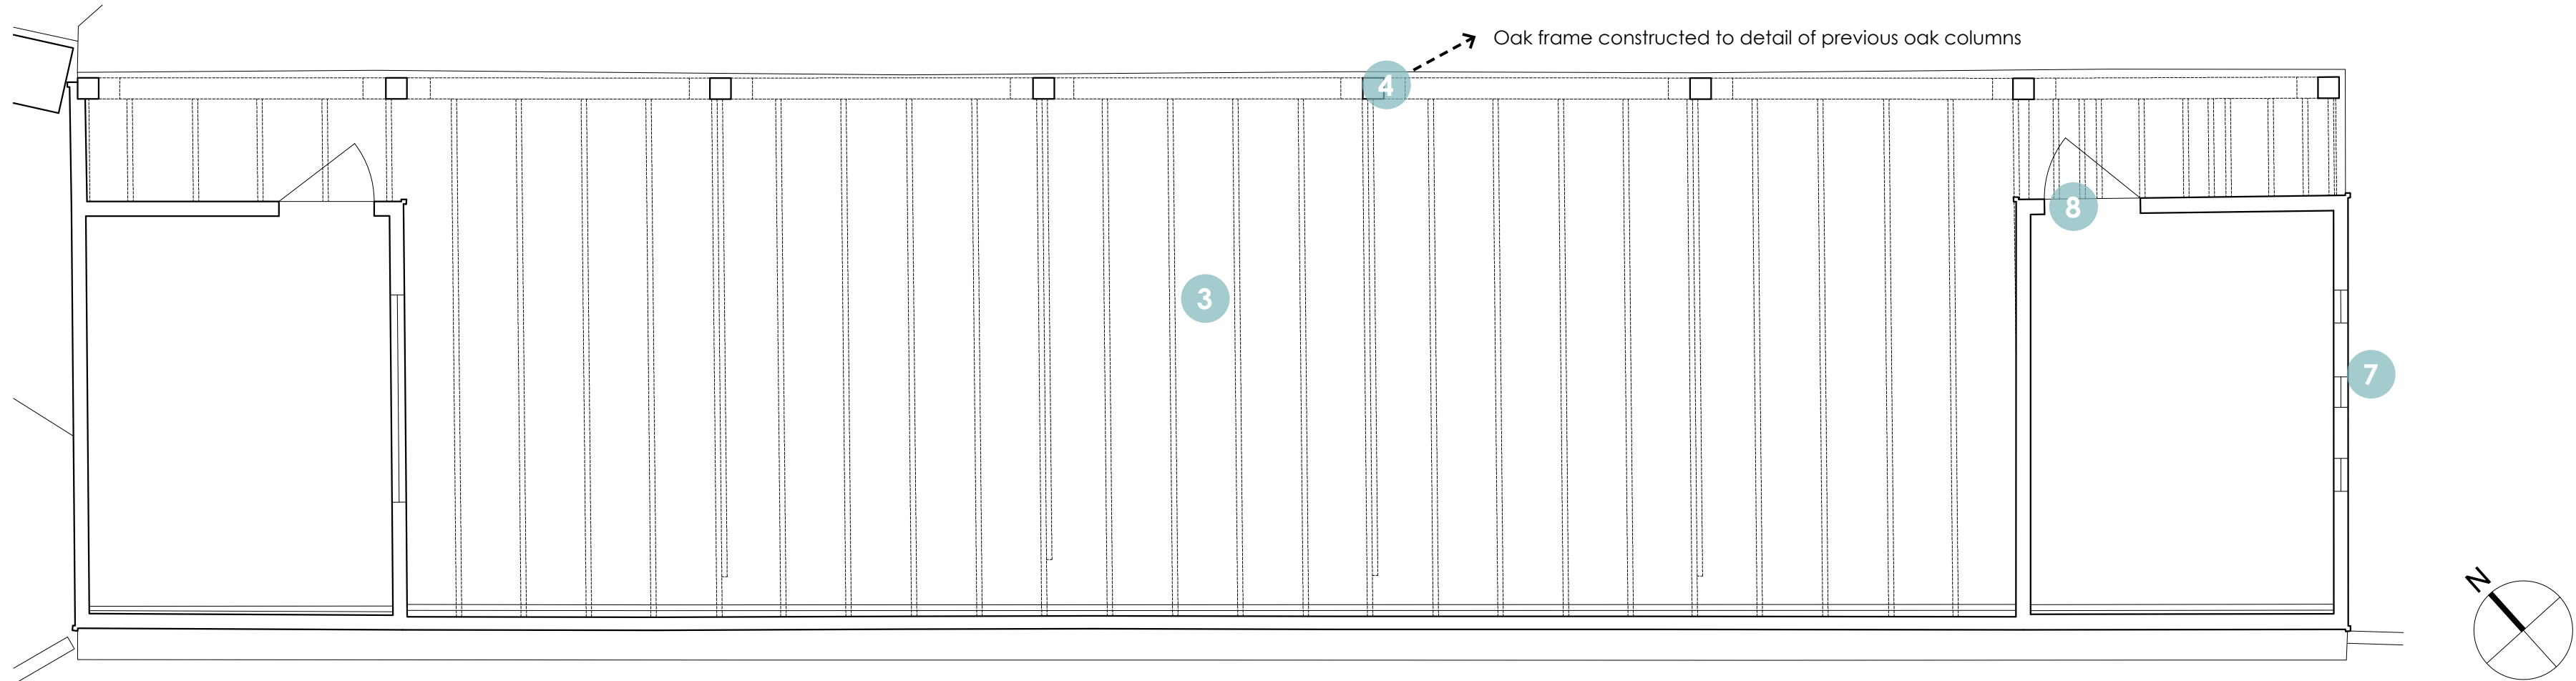

Proposed Floor Plan as constructed

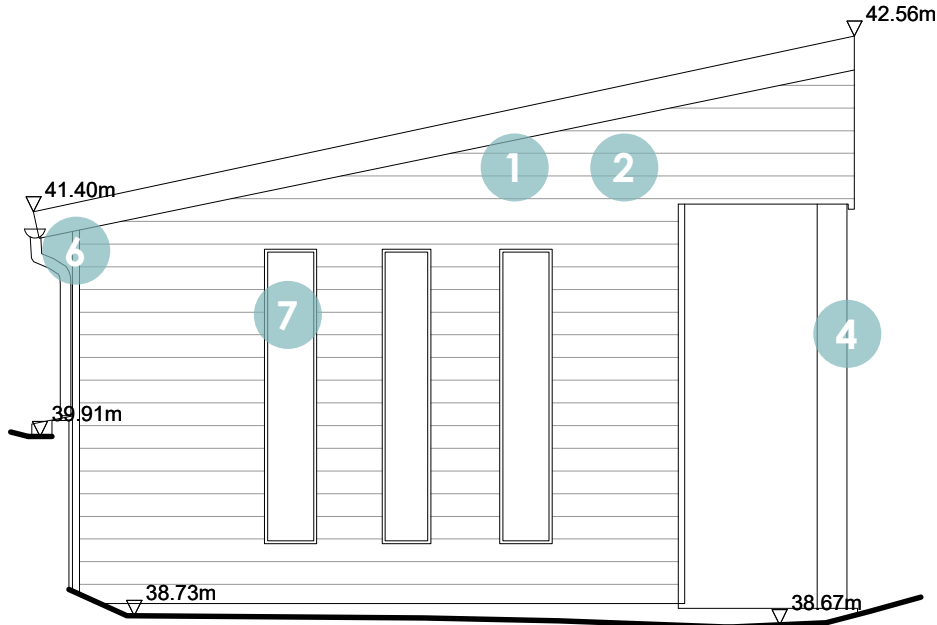


Proposed Elevation 15 as constructed

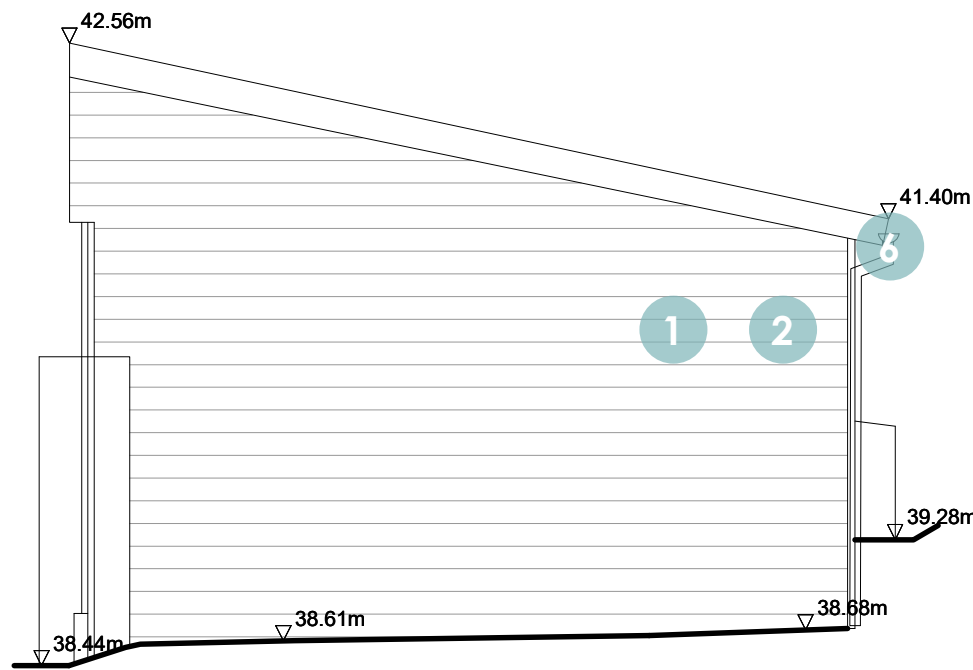


Proposed Elevation 17 as constructed



This drawing and the design are the copyright of **ON Architecture Ltd only**.
This drawing should not be copied or reproduced without written consent.
All dimensions are to be checked on site prior to setting out and fabrication and **ON Architecture Ltd** should be notified of any discrepancy prior to proceeding further.
For Construction & Fabrication Purposes - Do not scale from this drawing, use only the illustrated dimensions herein. Additional dimensions are to be requested and checked directly.
Illustrated information from 3rd party consultants/specialists is shown as indicatively only. See other consultant / specialist drawings for full information and detail.
All aspects of the architectural design concerning fire performance / fire safety (whether or not illustrated / annotated) are to be considered as For Approval only, irrespective of the drawing status / suitability.

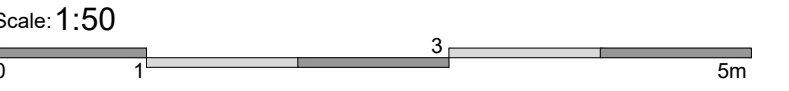

Key:

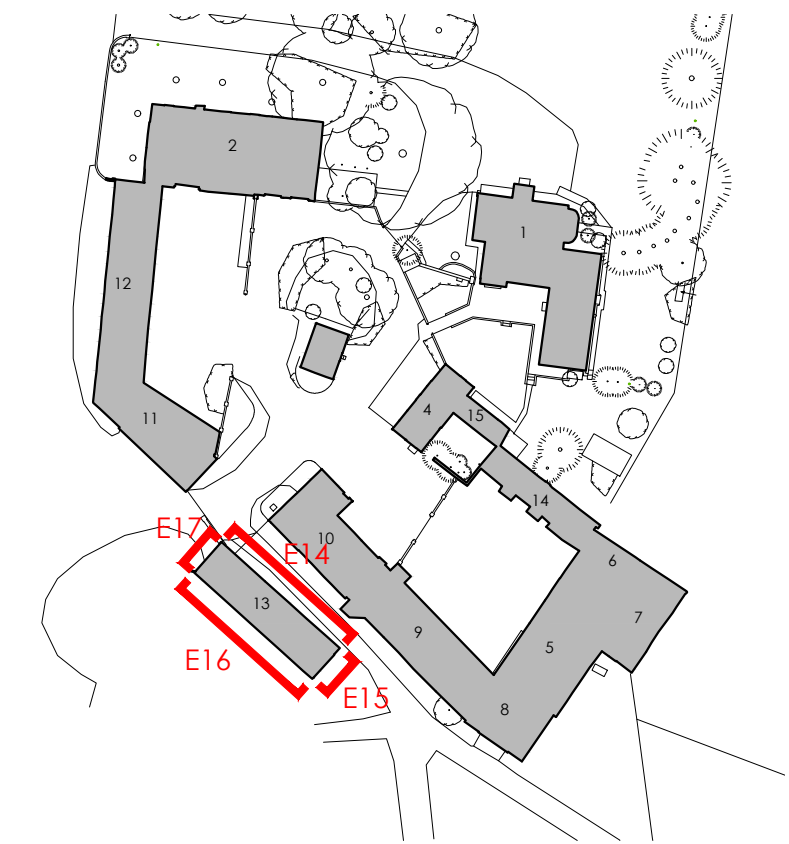

Materials:

- 1 Pre-treated black / feather-edge timber cladding
- 2 Blackbird paint
- 3 Concrete slab
- 4 Replaced oak frame timber columns
- 5 Onduline corrugated roof
- 6 Cast iron guttering
- 7 Black aluminium windows
- 8 Black timber frame doors

All survey drawings produced by OmegaGeo
Please refer to Job Ref. 2414908, Drawing no. 2 of 3
& 3 of 3 for further details

Revision Note & Date				Amended		Checked
Rev	Date	Note				

ON
ARCH
TECT
URE

Canterbury Studio
Logan House, St Andrews Close
Canterbury,
CT1 2RP
info@onarchitecture.co.uk
onarchi tecture.co.uk
01227 634334

Project Title
WHITEHOUSE FARM, LAND WAY

Client's Details
WINDMILL CONSTRUCTION

Drawing Title
**BUILDING 13 - PROPOSED FLOOR
PLAN AND ELEVATIONS AS
CONSTRUCTED**
BM Number
24.051-ONA-ZZ-XX-DR-A - 0304.000

Scale	Date	Drawn	Checked
1:50 @ A1	MAY 2024	IH	JR

Drawing Status
PLANNING

Project No.	Drawing No.	Status	Revision
24.051	0304.000	P	----