
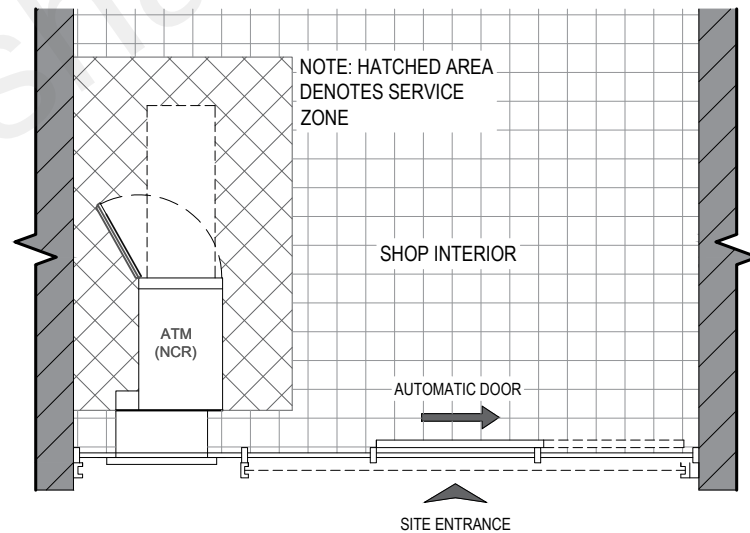
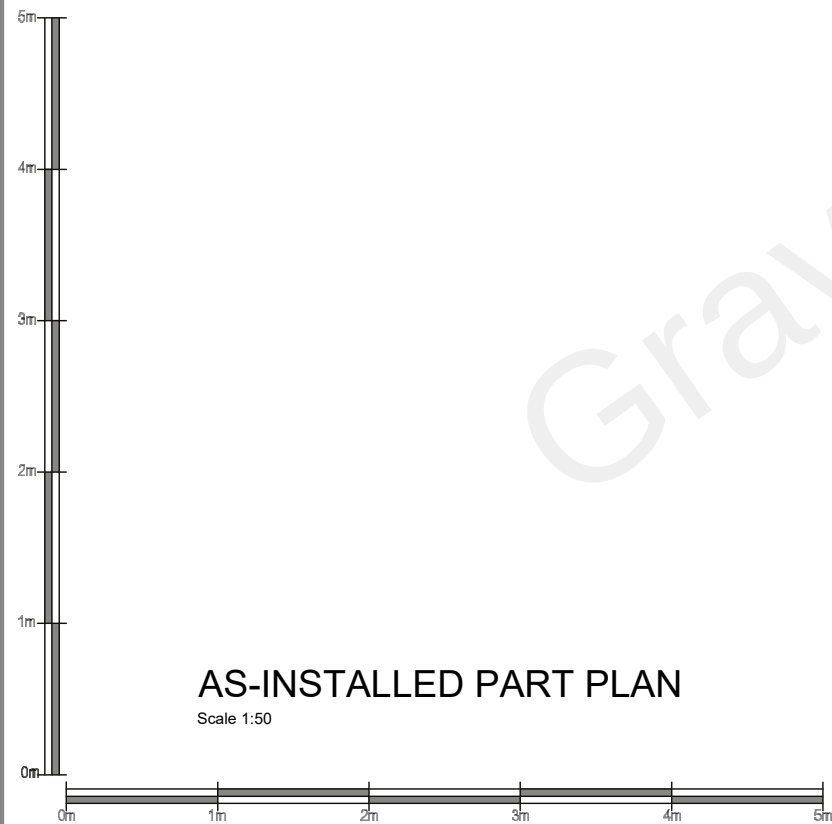


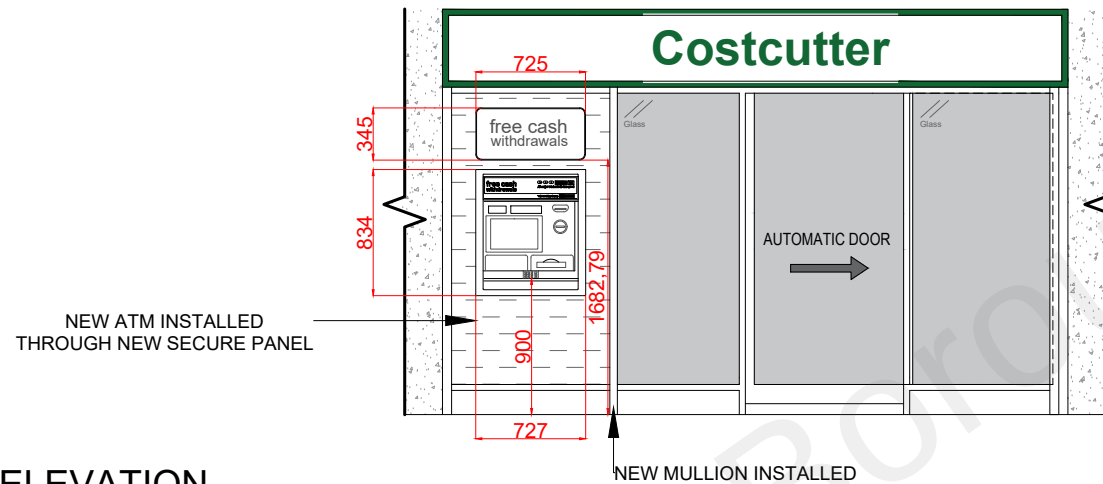

Date: Comments: By:

GENERAL NOTES:
1) All dimensions in millimeters unless otherwise stated.

Site:
Costcutter The Hive,
9 The Hive,
Northfleet,
Gravesend,
DA11 9DE

Drawing Title:
As-Installed Plan and Elevation

Ref: T020864_AI	Date: 12/04/2022	Rev:
Scale: 1:50	Paper: A3	Date Rev: