



Smart Structural Calculations Ltd

108 Glencoe Road
Coventry, CV31GP


Proposed front elevation

Customer: Mr Ahmad Mowafak Alzaim

Site address: 33 St Davids Cres_ DA12 4AS

Drawing scale: 1/50

Page number: 7

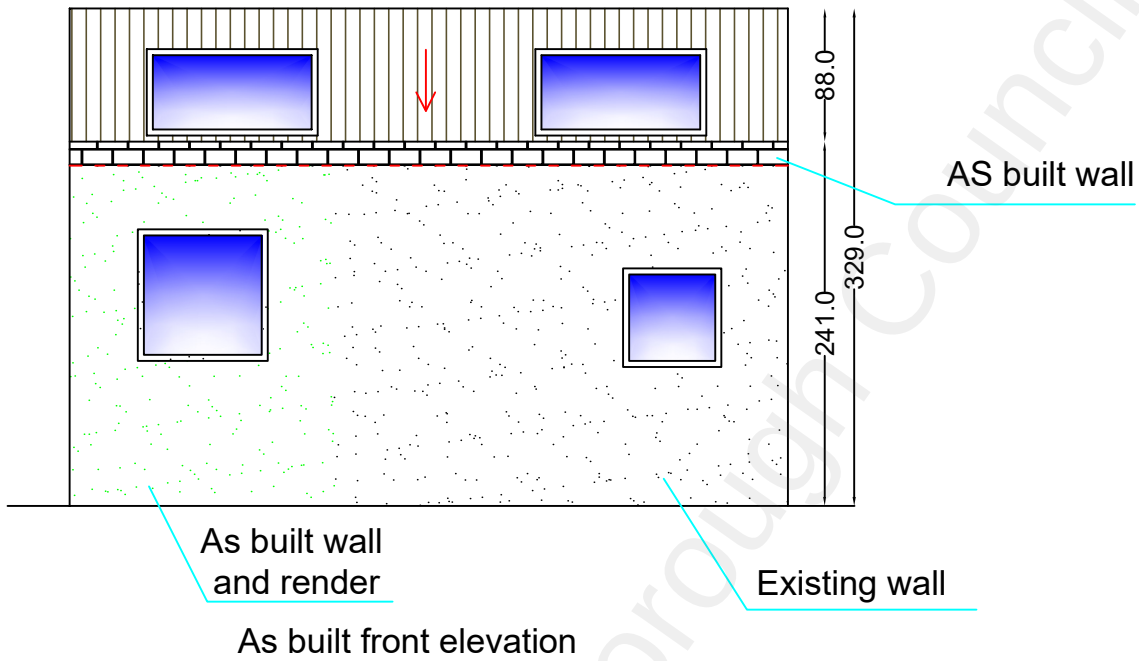

As built front elevation