



Smart Structural Calculations Ltd

108 Glencoe Road
Coventry, CV31GP


Proposed rear elevation

Customer: Mr Ahmad Mowafak Alzaim

Site address: 33 St Davids Cres_ DA12 4AS

Drawing scale: 1/50

Page number: 9

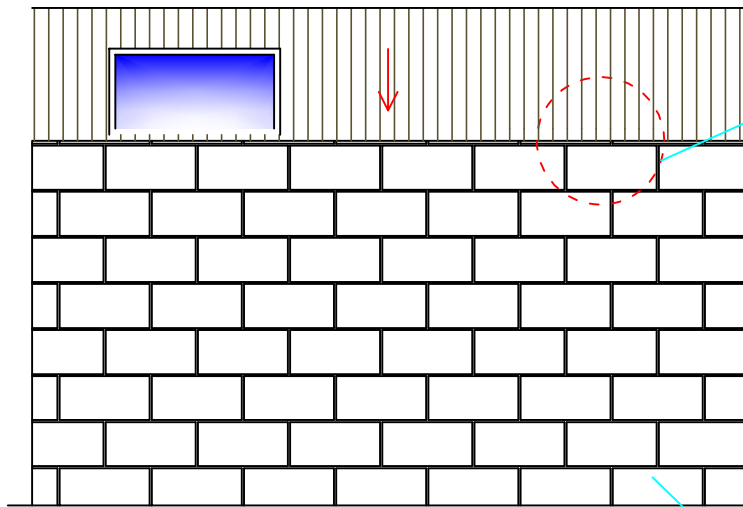

C(See the details page-page number 5)

241.0

As built rear elevation

As built wall



As built rear elevation