




KEY:
Building/Bay Containing PbO
fitted with Flood Gate

Employee Work Area

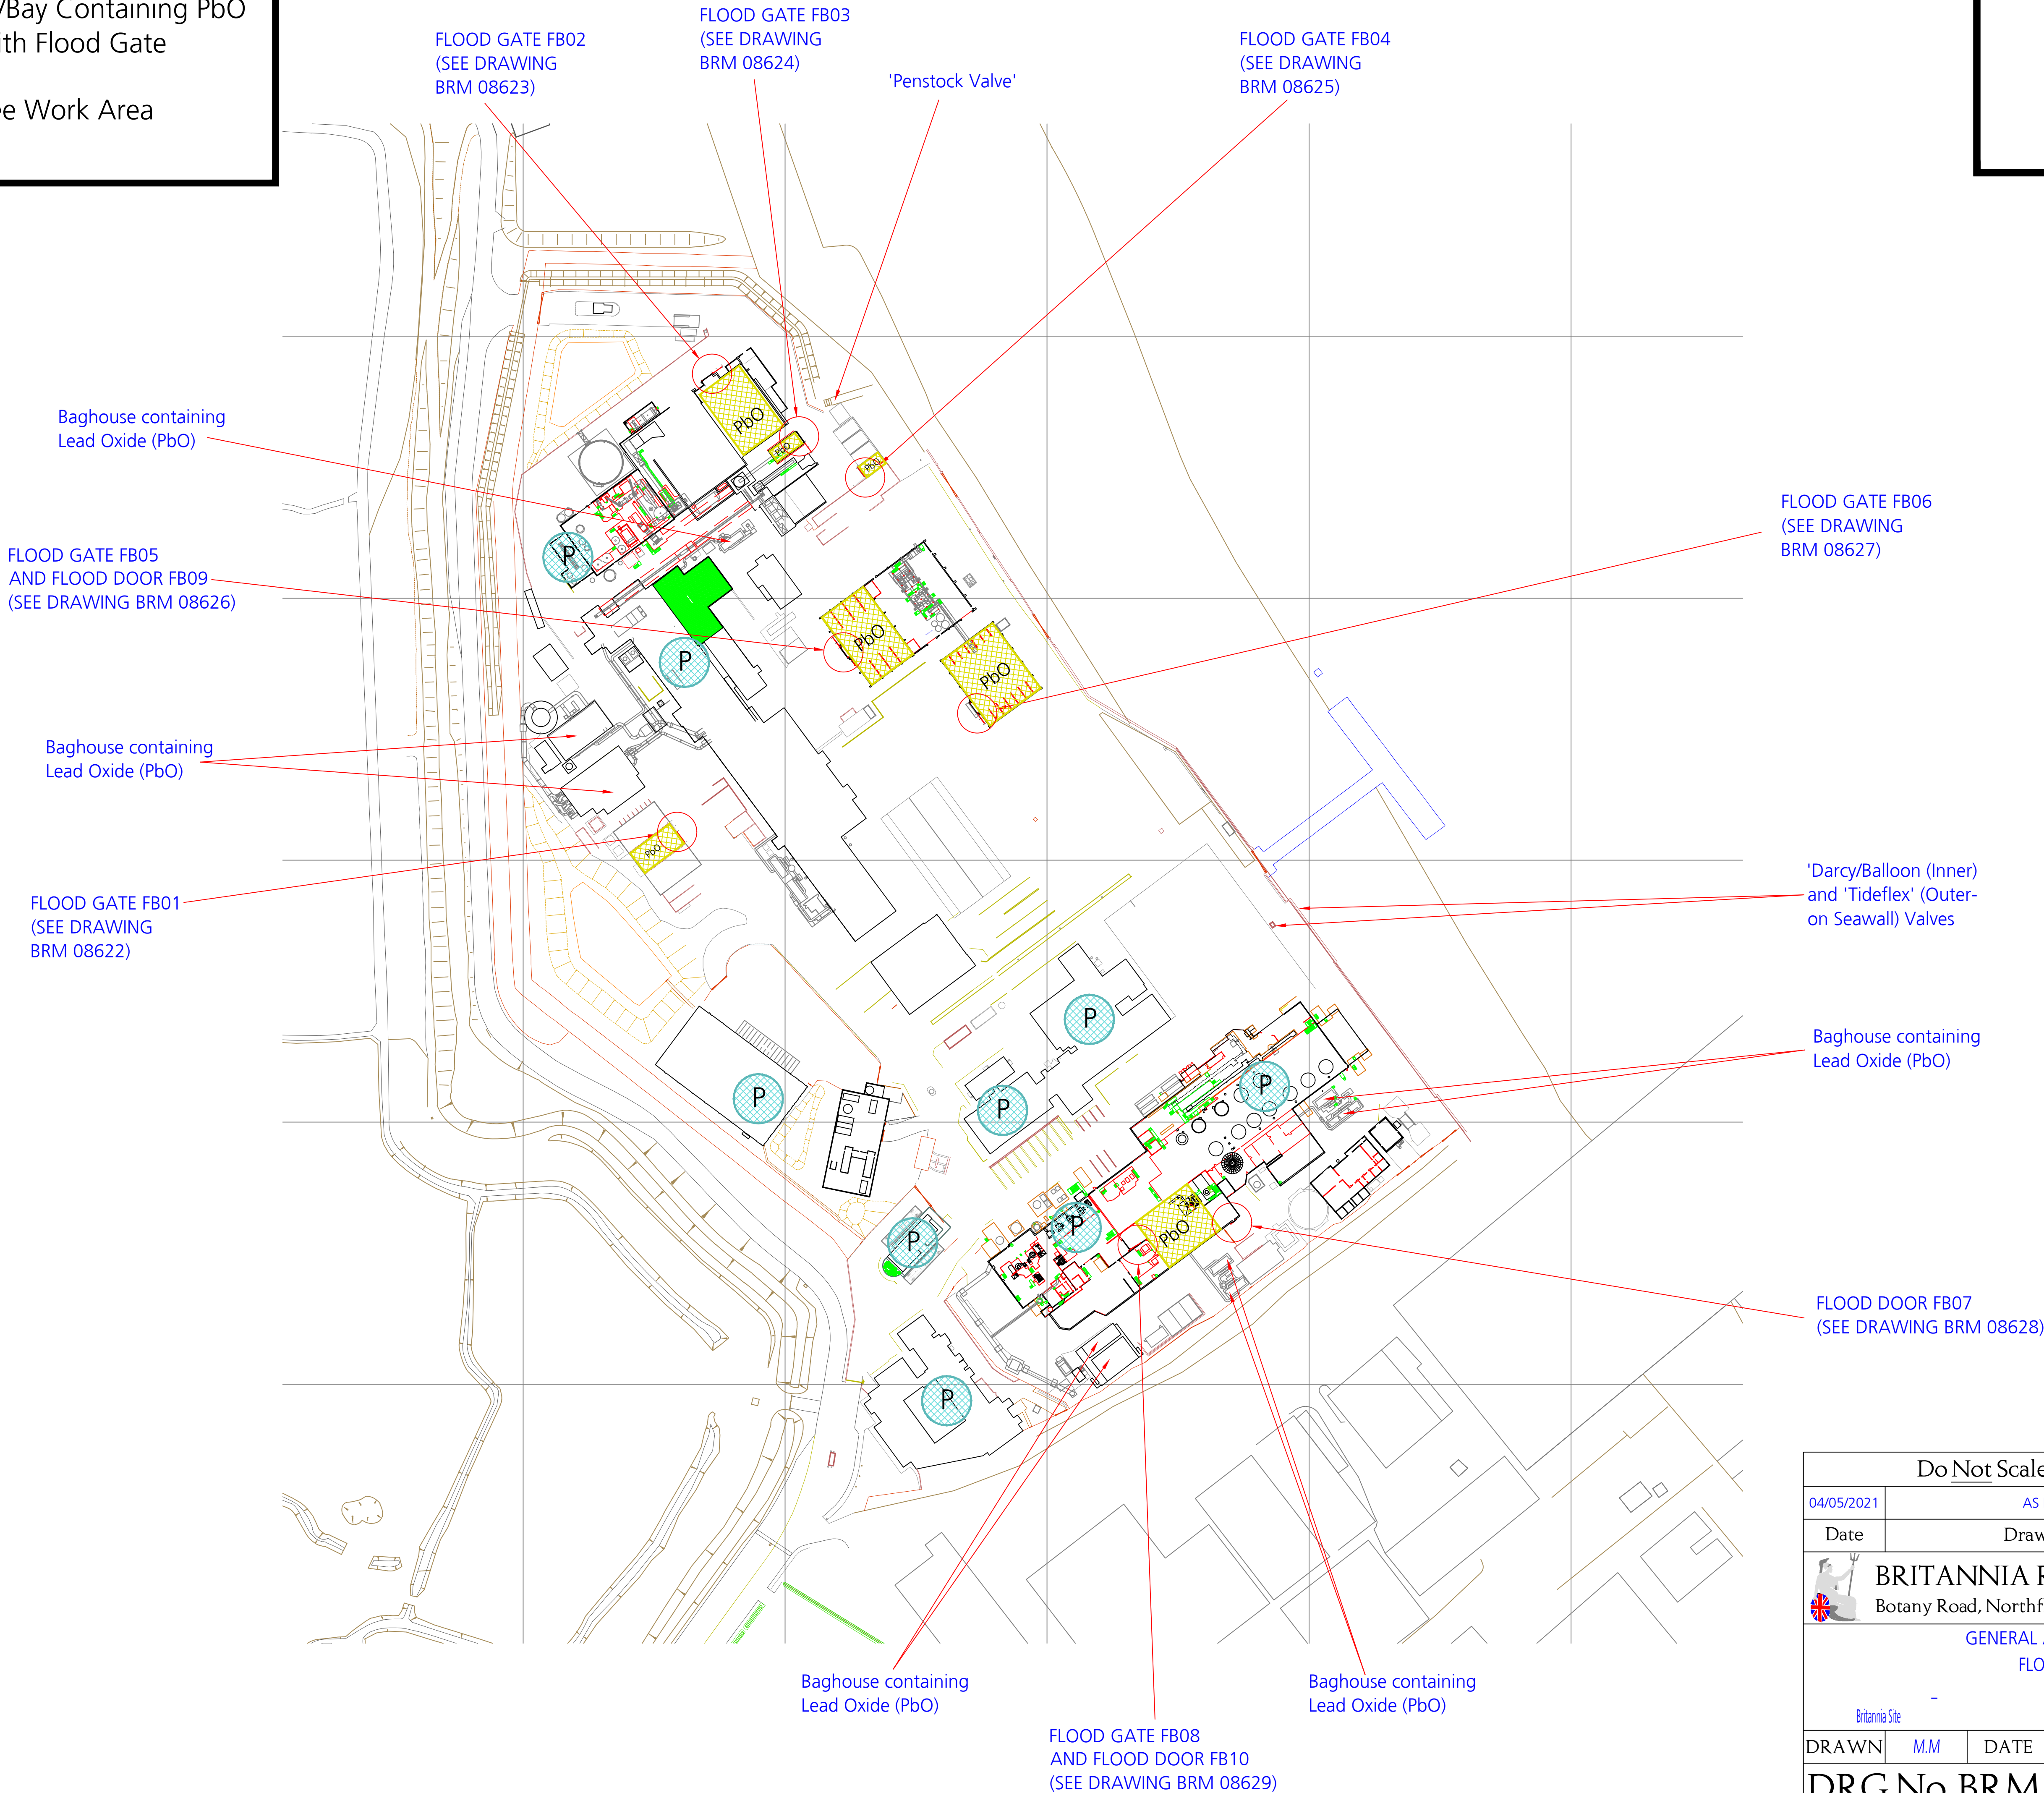

AutoCAD

Do <u>Not</u> Scale, If in Doubt Ask			
04/05/2021	AS INSTALLED		G.W
Date	Drawing Status		By
 BRITANNIA REFINED METALS LTD. Botany Road, Northfleet, Kent, DA11 9BG.			
GENERAL ARRANGEMENT FLOOD GATE			
-			
Britannia Site			
DRAWN	M.M	DATE	04/05/2021
		SCALE	1: 1000
		(A1 ONLY)	
DRG No BRM 08621 B			