


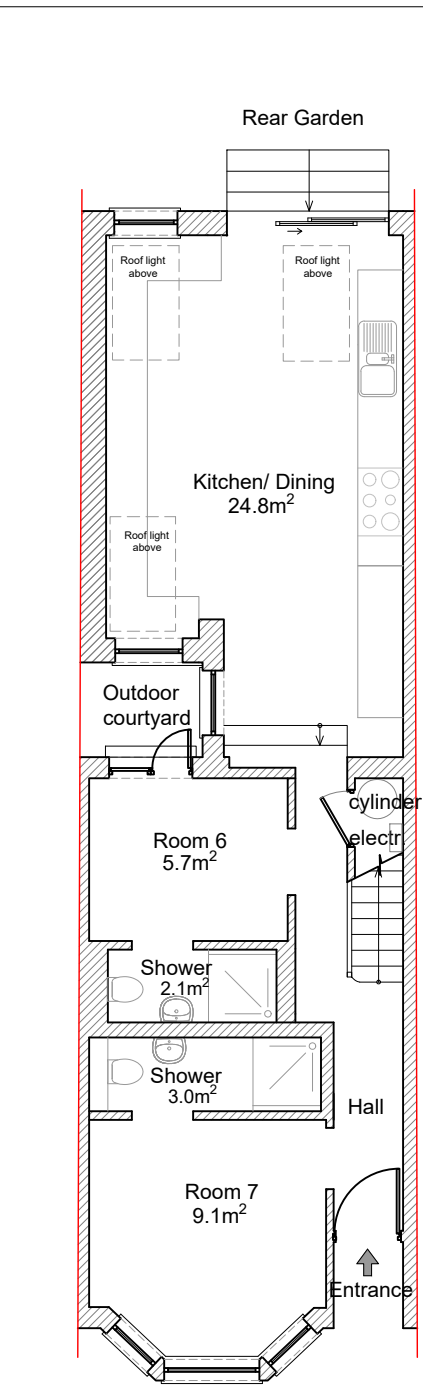


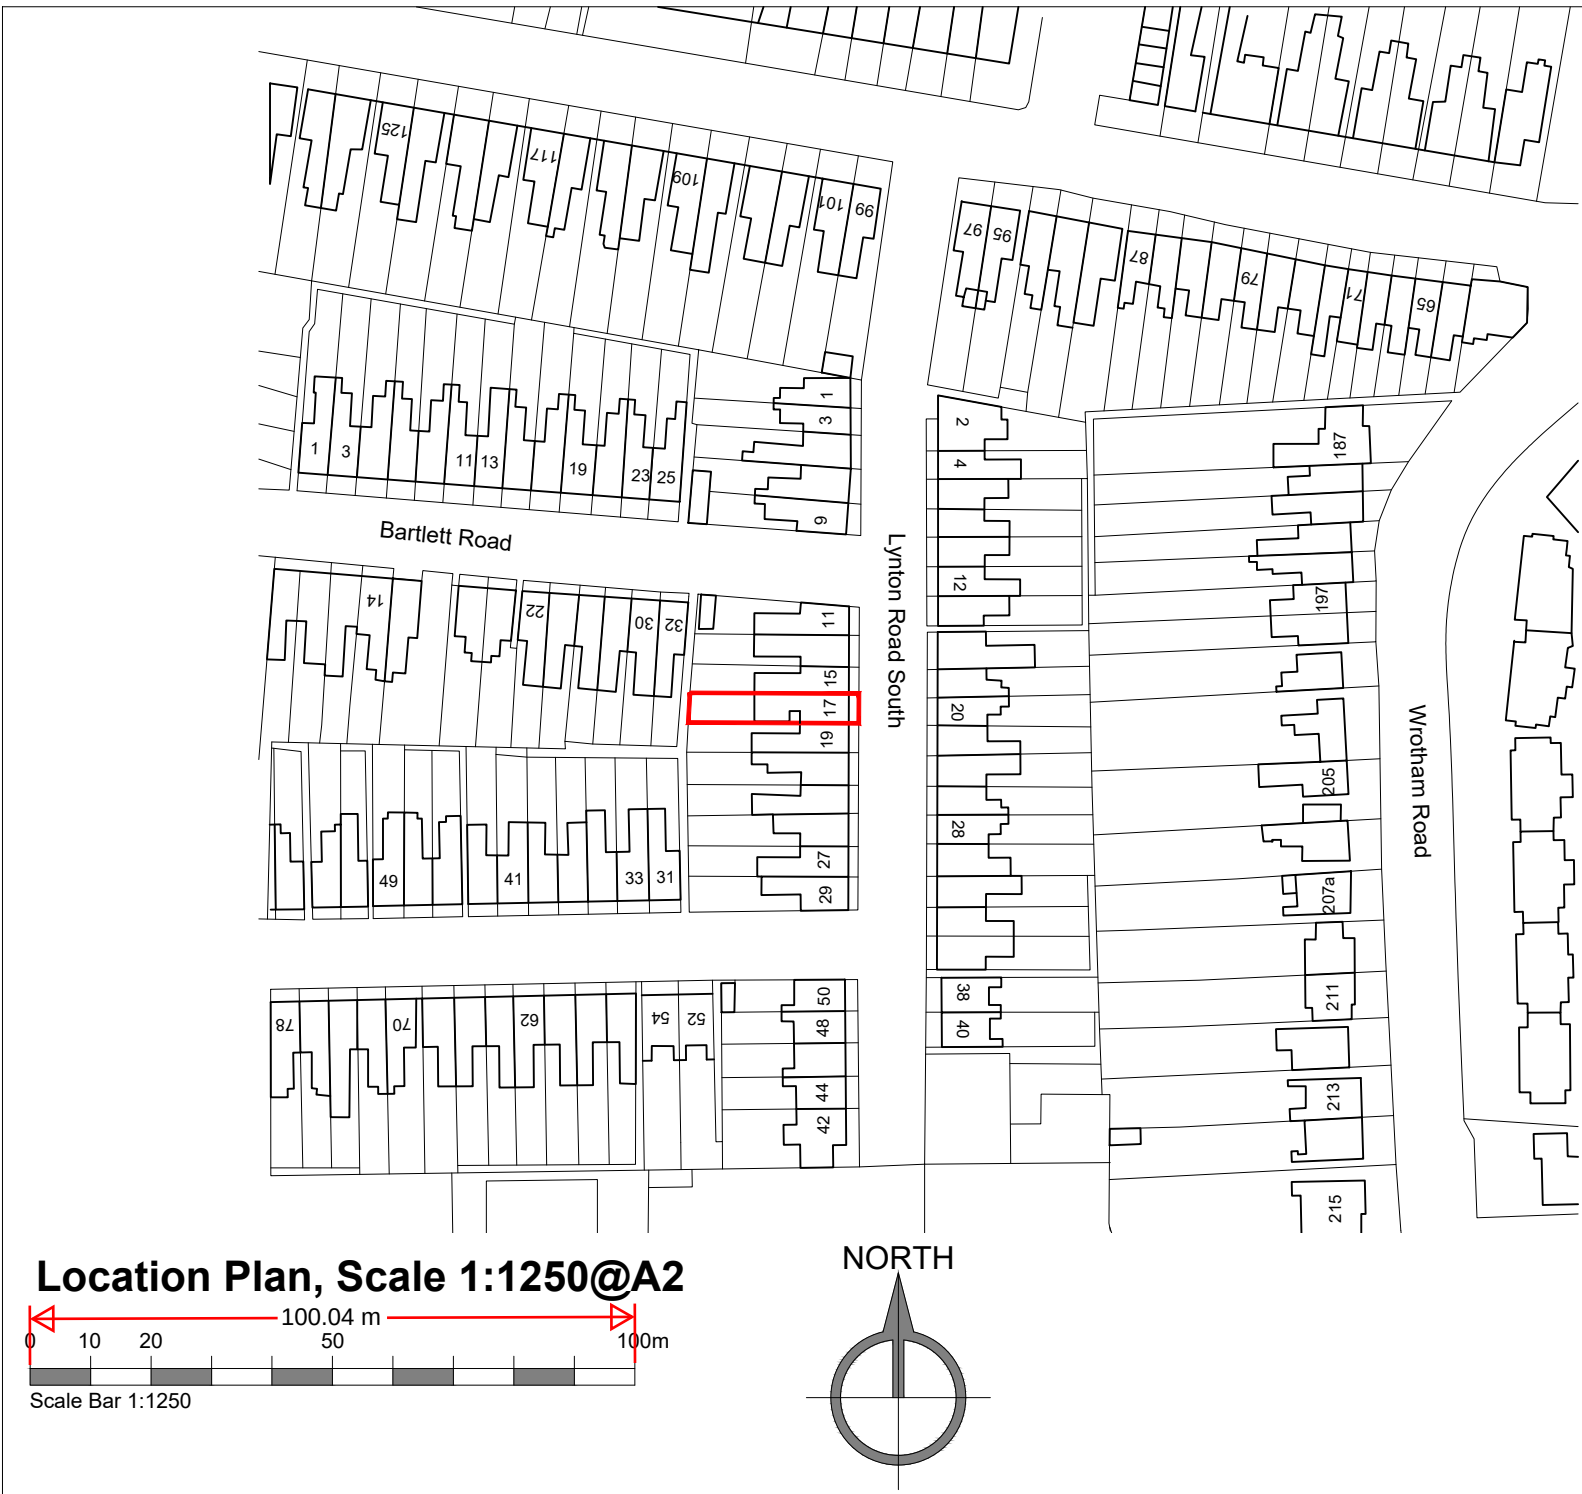


As Built Ground Floor Plan,
Scale 1:100@A2

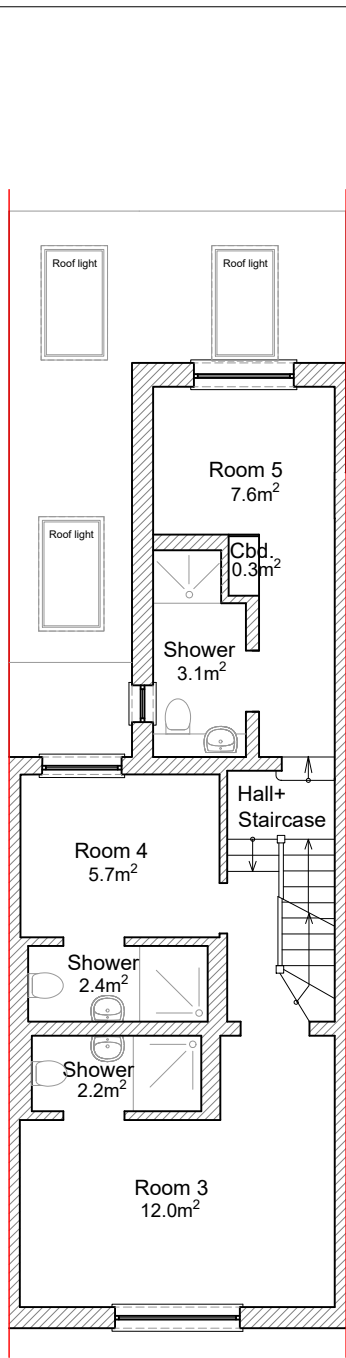


As Built First Floor Plan,
Scale 1:100@A2

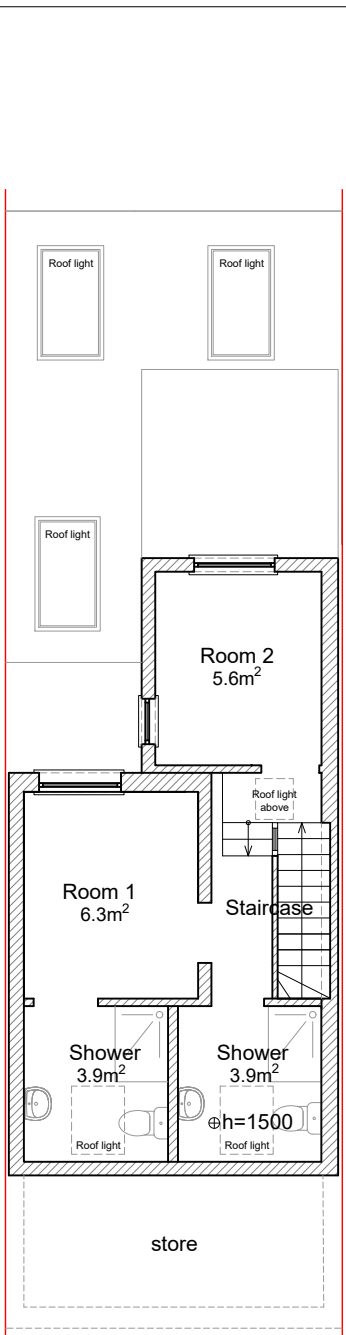


As Built Loft Floor Plan,
Scale 1:100@A2

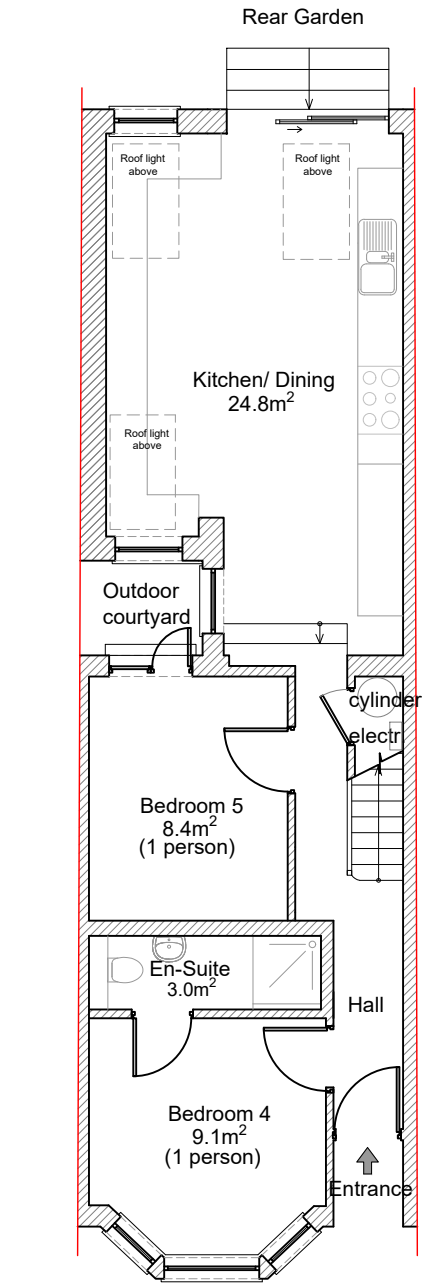

Proposed Ground Floor Plan,
Scale 1:100@A2

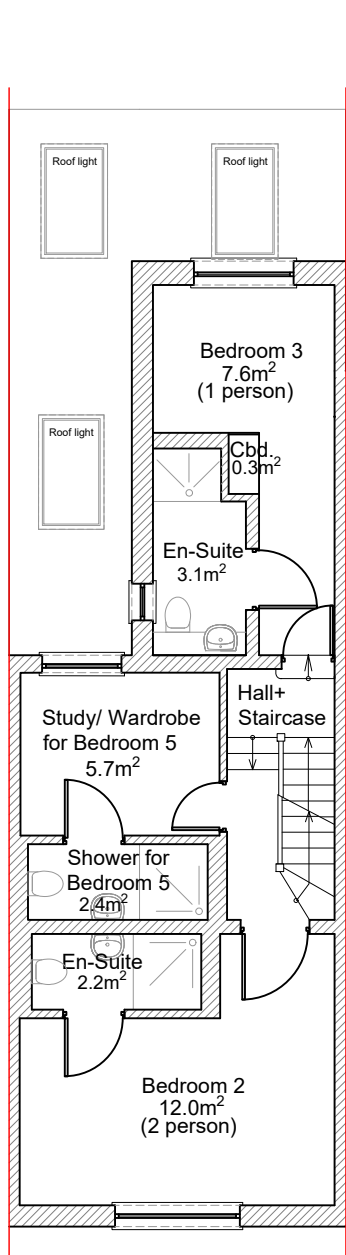

Proposed First Floor Plan,
Scale 1:100@A2

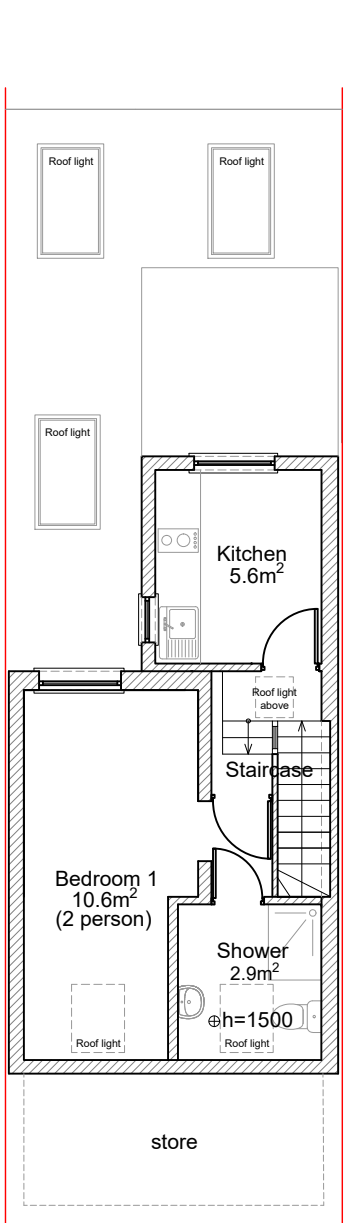

Proposed Loft Floor Plan,
Scale 1:100@A2

DO NOT SCALE - FOR PLANNING PURPOSES ONLY.
ARCHITECTS TO BE INFORMED OF ALL DISCREPANCIES IN
DIMENSIONS.
CONTRACTOR TO CHECK ALL DIMENSIONS ON SITE.
ANY UNAUTHORISED COPYING WILL CONSTITUTE
INFRINGEMENT OF COPYRIGHT.
ALL RIGHTS RESERVED.
COPYRIGHT© PROARC LTD.

Rev	Details	Date
-----	---------	------

PLANNING APPLICATION

RIBA Chartered Practice

PROARC
Architecture & Properties

www.proarc.one
maciej@proarc.one
M: 07511251343 T: 01634 353 323
Reg. Office: 42 Valley Road, Gillingham, Kent, ME7 2EU

Project Title **Proposed 5 bedroom 7 person
HMO with relation to as built
survey.**

Drawing Title
**Location Plan, Existing and
Proposed Drawings**

Address 17 Lynton Road South,
Gravesend, DA11 7NF

Drawn KW	Checked MW	Scale as indicated@A2	Date 25/03/2024
Dwg No 2403	Rev No PL02		