
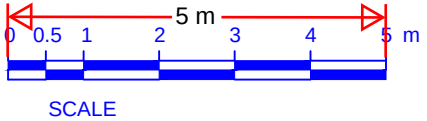


NOTES
DRAWING SHOWING AS BUILT
STREET SCENE. BUILDING IS
400MM BELOW THE AS APPROVED
BUILT LINE.

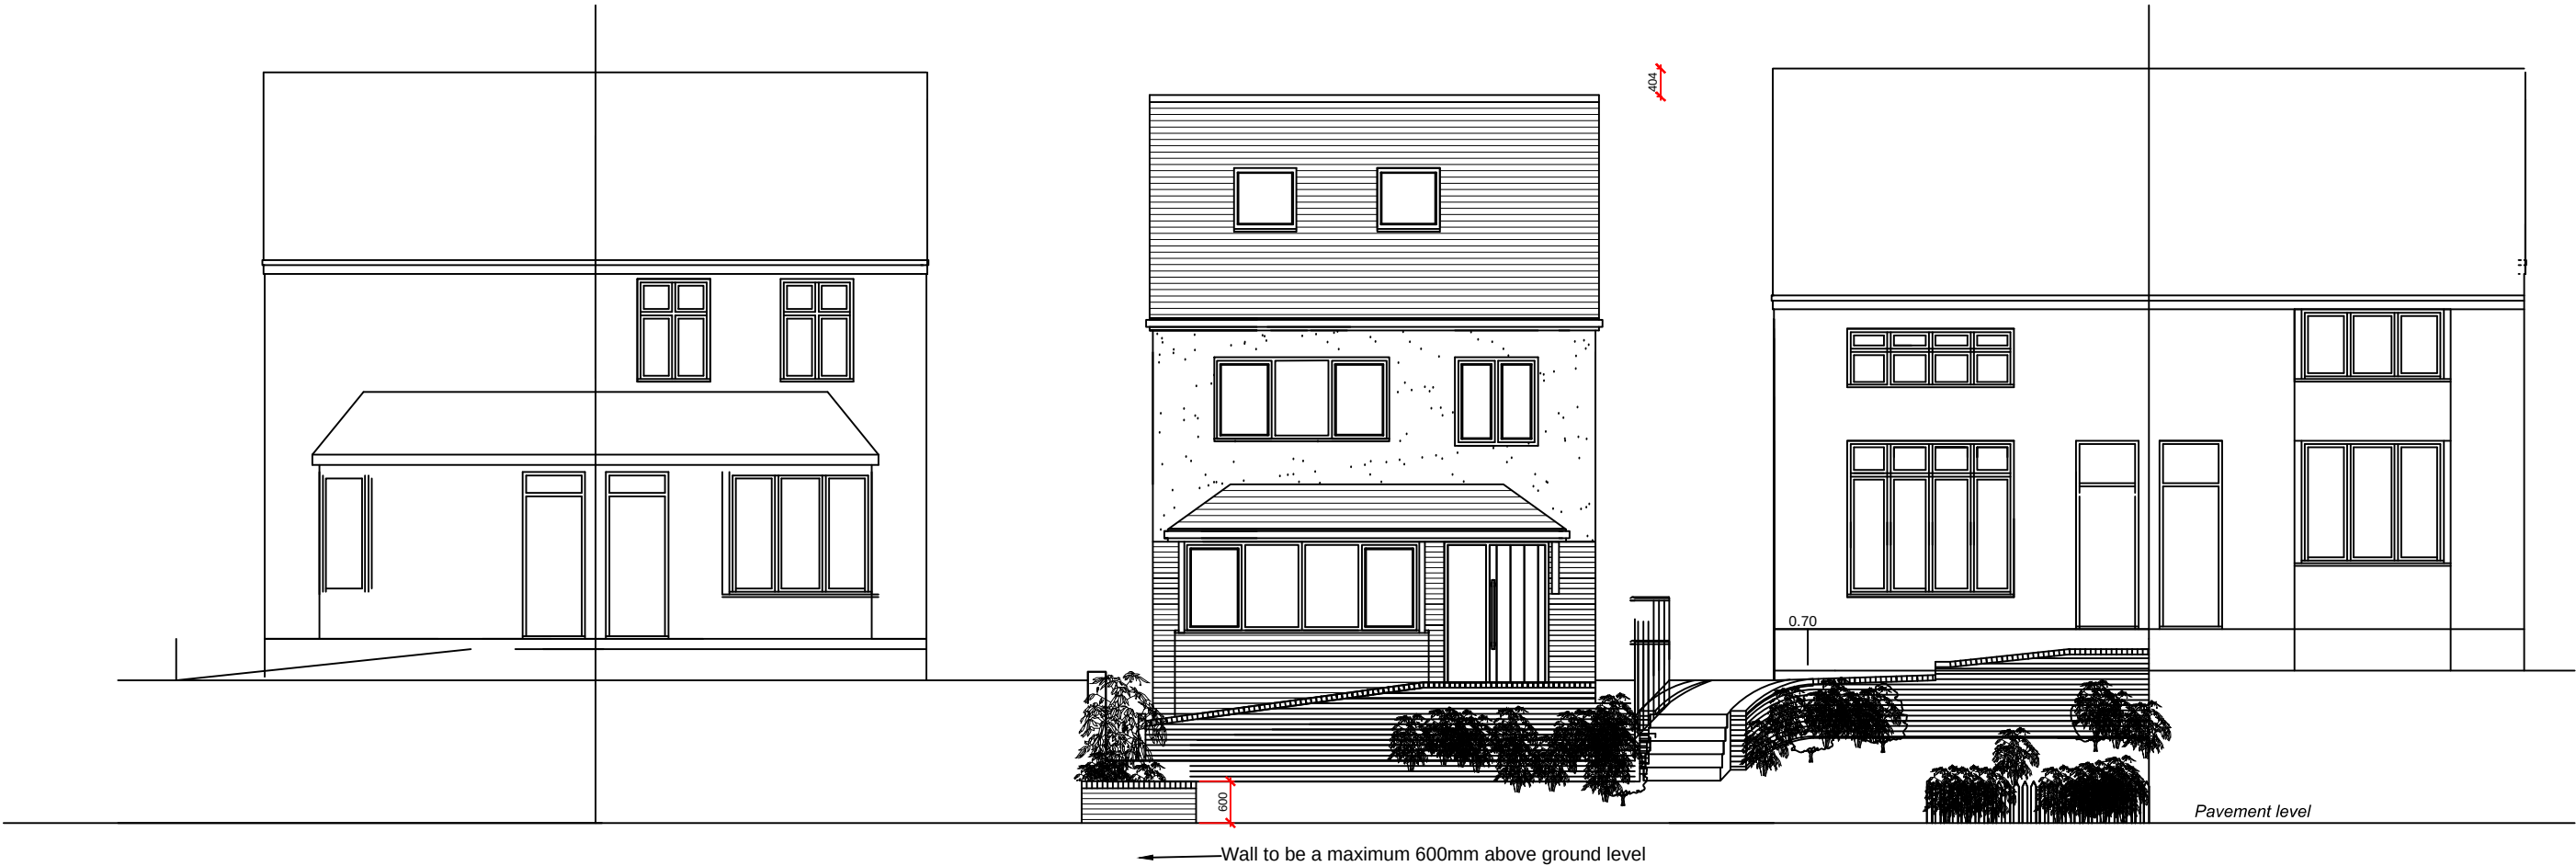

S HANSPAL BSc MRICS

PROJECT
NEW HOUSE
FOR MR JOHAL

ADDRESS
LAND BETWEEN
53 AND 55 FORGE LANE
HIGHAM KENT ME3 7AH

DWG No. FLP.04	SCALE 1:100 @ A3	DATE DEC 2023
-------------------	---------------------	------------------