



- NOTE:**
- 1 - Existing boundary fence to be removed
 - 2 - Existing Ground Floor WC and utility room removed
 - 3 - Existing floor finishes stripped back to existing sub-base throughout Ground Floor.
 - 4 - Hipped roof structure to be removed

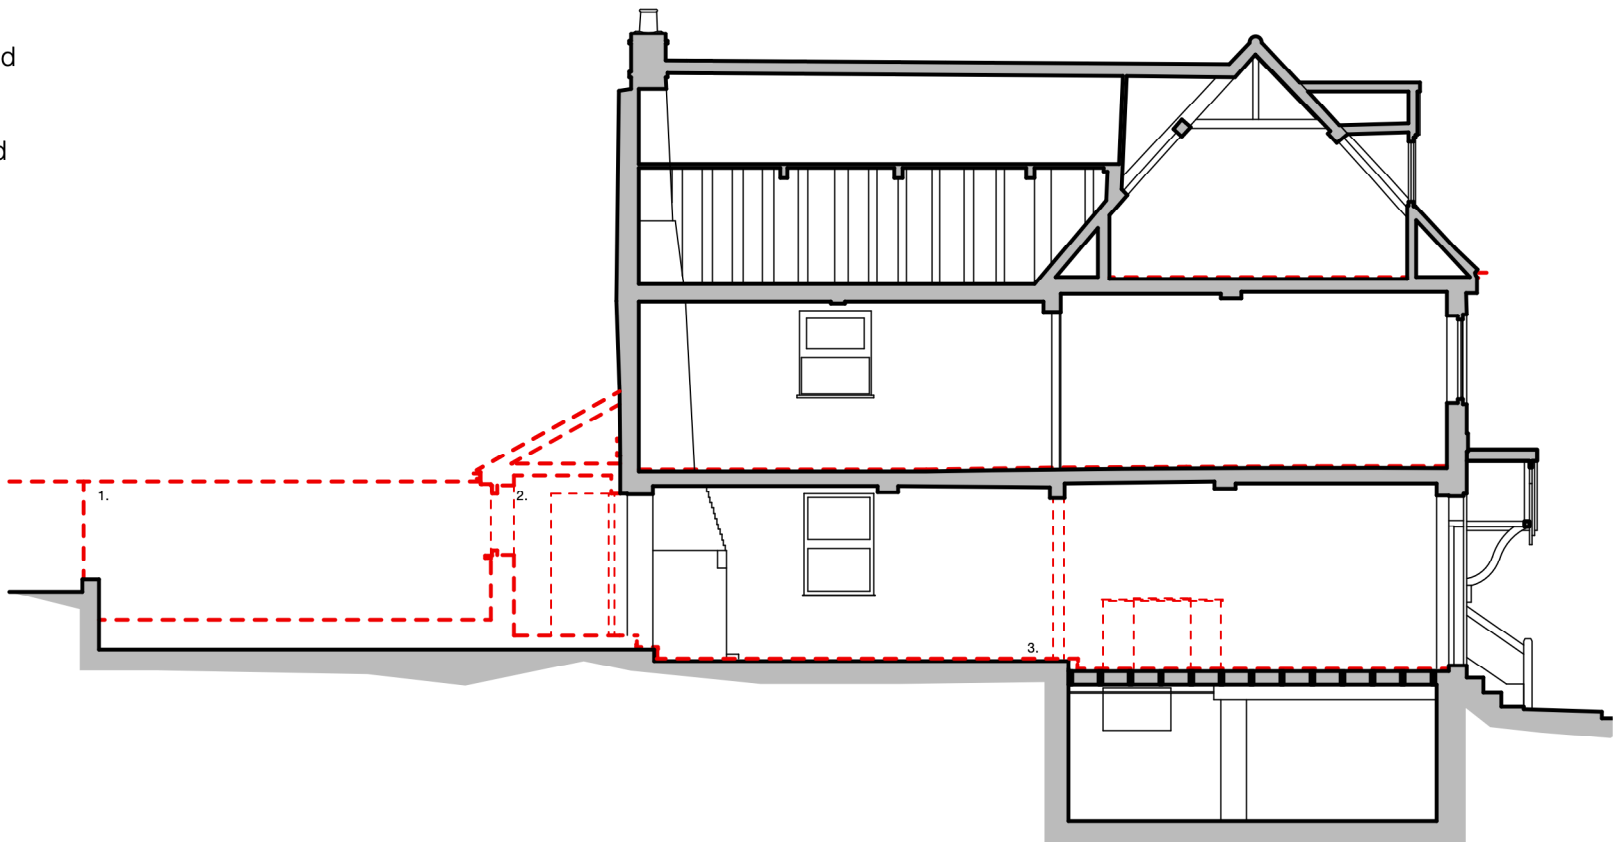

Section A-A

- KEY:**
- Demolition - - - - -
 - Element to be retained and relocated - - - - -

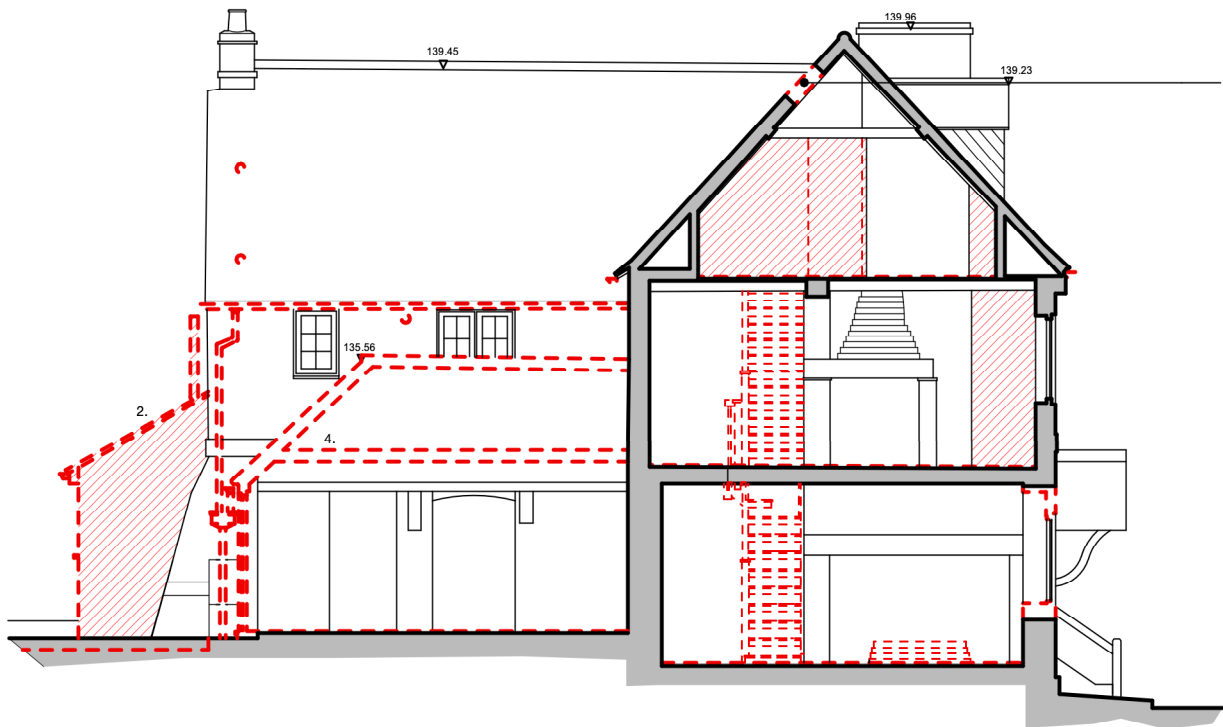

Section B-B

The Street Meopham

The Street Meopham

- GENERAL NOTES**
- 1. This drawing is the copyright of Haines Phillips Architects.
 - 2. Do not scale from this drawing. Use figured dimensions only.
 - 3. This drawing must not be used for land transfer purposes, or for construction purposes unless accompanied by an Architect's Instruction.

DRAWING ISSUE STATUS		
ISSUE	STATUS	COMMENT
P	PRELIMINARY	For comment and review
PL	PLANNING	Planning/ Listed Building Application
BR	BUILDING REGS	Building Regs Application
T	TENDER	For pricing purposes only
C	CONSTRUCTION	For procurement & construction
FC	FINAL	Record drawings on completion
L	CONSTRUCTION LEGAL	Conveyancing or other legal purposes

REVISIONS		
REV	DATE	NOTES
1	20/10/25	Planning Issue.

**HAINES
PHILLIPS
ARCHITECTS**

Tankerton Works
12 Argyle Walk
London WC1H 8HA
t 020 7833 9324
f 020 7837 2864
e office@hainesphillips.co.uk

JOB TITLE
**Elizabeth House,
The Street, Meopham,
DA13 0AJ**

DRAWING TITLE
Sections Demolitions

DRAWN	DATE
AZ	Feb 2025
JOB NR	SCALE
4412	1:100@A3
DRAWING NO.	ISSUE REVISION
DM340	PL 1