


- NOTES
- 1 DO NOT SCALE
 - 2 All dimensions are to be checked and discrepancies reported before construction
 - 3 To be read in conjunction with all relevant Architect's and consultants drawings



FRONT ELEVATION AS PROPOSED

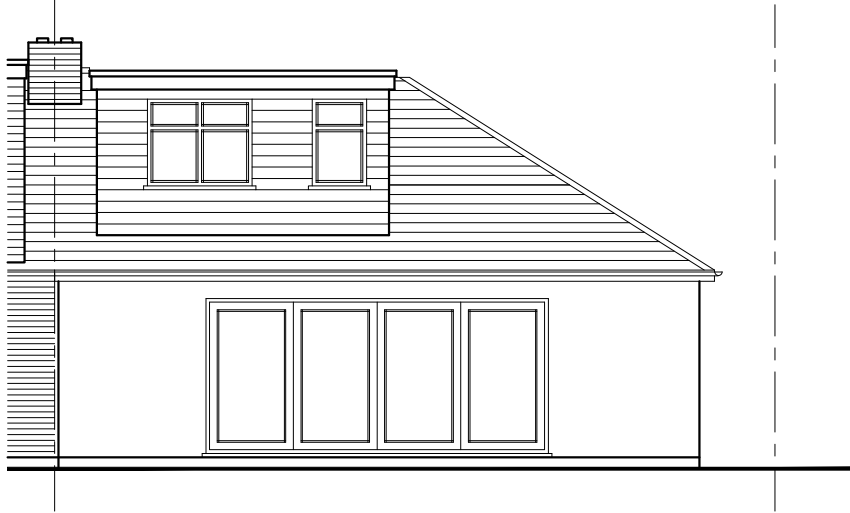

REAR ELEVATION AS PROPOSED



SIDE ELEVATION AS PROPOSED

A	Drawing revised to show correct roof as-built roof details	10/01/25
Rev.	Description	Date



METRO DESIGN & BUILD LTD.
Metro House, Northgate Industrial Park,
Collier Row Road, RM5 2BG
Tel : 07968 912230
metro-design@outlook.com

Architectural Services
Aman Manku
Dileep Manku

Construction Services
Daljinder Manku

PROJECT 5 UPPER AVENUE
INSTEAD RISE
GRAVESEND
KENT DA13 9DA

TITLE ELEVATIONS AS PROPOSED
(EXISTING)

DATE SCALE
OCT 2024 A3 = 1:100

PROJECT NO. DRG. NO. REV.
25000B 13 A