


No.	Date	Rev. by	Description
P01	29.10.2025	HE	Preliminary Issue
P02	07.11.2025	HE	Design Development
P03	26.01.2026	LB	Design Development
C01	27.02.2026	HE	Construction Issue

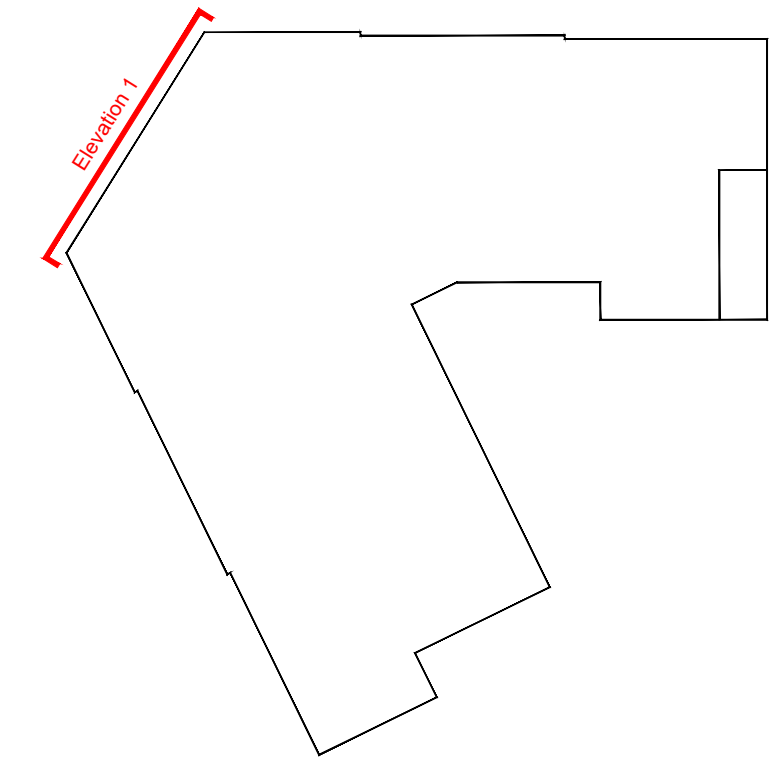

KEY PLAN

Proposed Residential Development, Milton Place, Gravesend.

KEY TO SYMBOLS ELEVATION

m.j. --- Movement Joint positions are shown indicatively. Structural engineer to confirm locations

ED01 External door reference

WG01 Window reference

* Windows marked thus to be egress windows

Safety Glass Indicates location of safety glass

drawing detail Detail Drawing Number

KEY TO SYMBOLS ELEVATION

□ Indicates position of tile vents

↑ tap Cold water bib tap

m.j. --- Movement Joint positions are shown indicatively. Structural engineer to confirm locations

ED01 External door reference

WG01 Window reference

* Windows marked thus to be egress windows

Safety Glass Indicates location of safety glass

Obscure Indicates obscure glazing

drawing detail Detail Drawing Number

Materials Key:

1 - Brick Type 1: Cream

2 - Brick Type 2: White

3 - Alternating courses of brick type 1 and 2 (commencing in brick type 2 at finished floor level, alternating above and below)

Refer to Materials Schedule for specified items

Client

Hill Residential

Project Title

Proposed Residential Development

Milton Place

Gravesend

Kent

Drawing Description

Plots 1 - 61

Apartment Block

Elevations Sheet 1 of 7

Elevation 1

Scale Date Created Checked


1:50 @ A1 October 2025 LB

Drawing Status


CONSTRUCTION

Drawing Number Revision

MPG-CLA-AA-ZZ-D-A-00800 C01

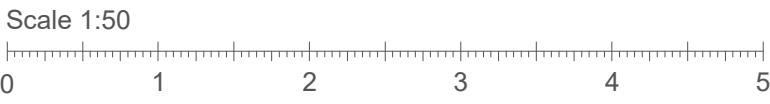

No.	Date	Rev. by	Description
P01	29.10.2025	HE	Preliminary Issue
P02	07.11.2025	HE	Design Development
P03	28.01.2026	LB	Design Development
C01	27.02.2026	HE	Construction Issue

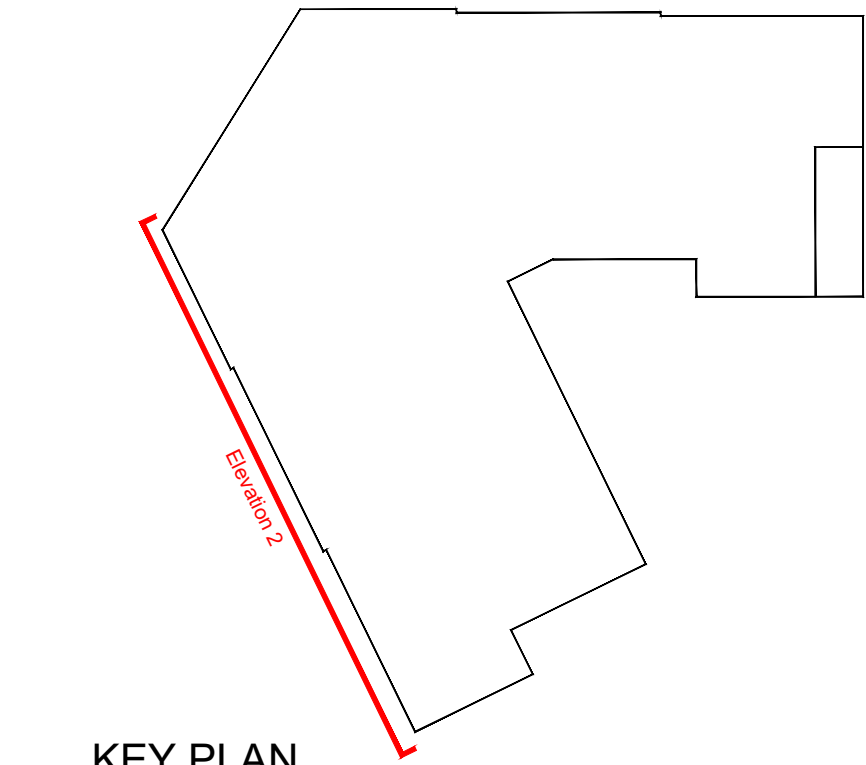

KEY PLAN

Proposed Residential Development, Milton Place, Gravesend.

KEY TO SYMBOLS ELEVATION

m.j. --- Movement Joint positions are shown indicatively. Structural engineer to confirm locations

ED01 External door reference

WG01 Window reference

* Windows marked thus to be egress windows

Safety Glass Indicates location of safety glass

Obscure Indicates obscure glazing

drawing detail Detail Drawing Number

KEY TO SYMBOLS ELEVATION

□ Indicates position of tile vents

↑ tap Cold water bib tap

m.j. --- Movement Joint positions are shown indicatively. Structural engineer to confirm locations

ED01 External door reference

WG01 Window reference

* Windows marked thus to be egress windows

Safety Glass Indicates location of safety glass

Obscure Indicates obscure glazing

drawing detail Detail Drawing Number


Materials Key:

1 - Brick Type 1: Cream


2 - Brick Type 2: White

3 - Alternating courses of brick type 1 and 2 (commencing in brick type 2 at finished floor level, alternating above and below)

Refer to Materials Schedule for specified items

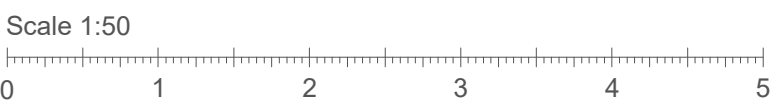

No.	Date	Rev. by	Description
P01	29.10.2025	HE	Preliminary Issue
P02	07.11.2025	HE	Design Development
P03	26.01.2026	LB	Design Development
C01	27.02.2026	HE	Construction Issue
C02	10.03.2026	LP	Swift box added and set out.

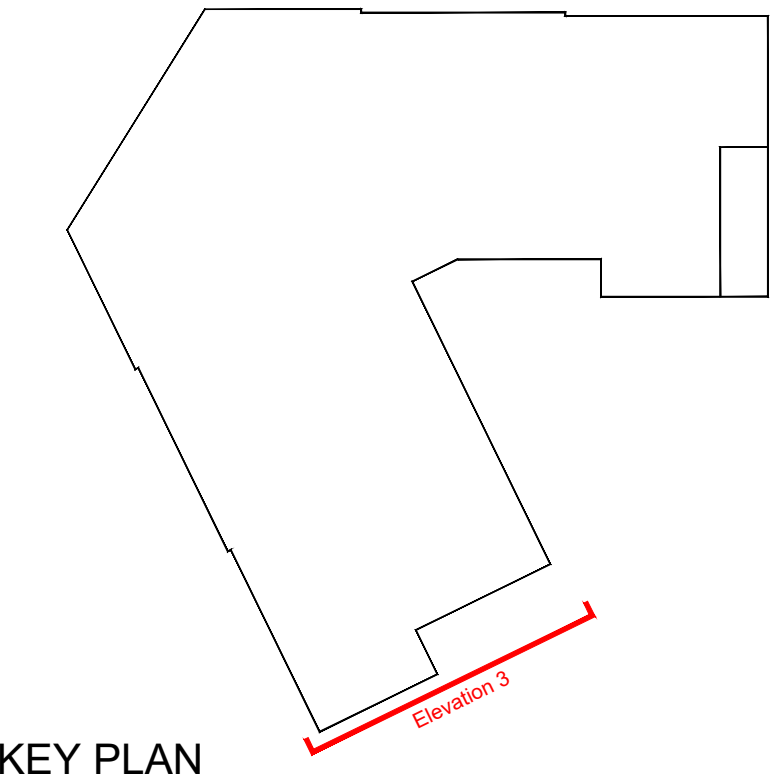

KEY PLAN

Proposed Residential Development, Milton Place, Gravesend.

KEY TO SYMBOLS ELEVATION

m.j. --- Movement Joint positions are shown indicatively. Structural engineer to confirm locations

ED01 External door reference

WG01 Window reference

* Windows marked thus to be egress windows

Safety Glass Indicates location of safety glass

Obscure Indicates obscure glazing

drawing detail Detail Drawing Number

KEY TO SYMBOLS ELEVATION

Indicates position of tile vents

tap Cold water bib tap

m.j. --- Movement Joint positions are shown indicatively. Structural engineer to confirm locations

ED01 External door reference

WG01 Window reference

* Windows marked thus to be egress windows

Safety Glass Indicates location of safety glass

Obscure Indicates obscure glazing

drawing detail Detail Drawing Number

Swift Brick


Materials Key:

1 - Brick Type 1: Cream



2 - Brick Type 2: White

3 - Alternating courses of brick type 1 and 2 (commencing in brick type 2 at finished floor level, alternating above and below)

Refer to Materials Schedule for specified items

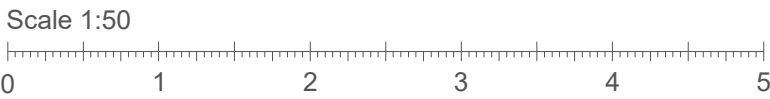

No.	Date	Rev. by	Description
P01	29.10.2025	HE	Preliminary Issue
P02	07.11.2025	HE	Design Development
P03	26.01.2026	LB	Design Development
C01	27.02.2026	HE	Construction Issue
C02	10.03.2026	LP	Swift box added and set out.

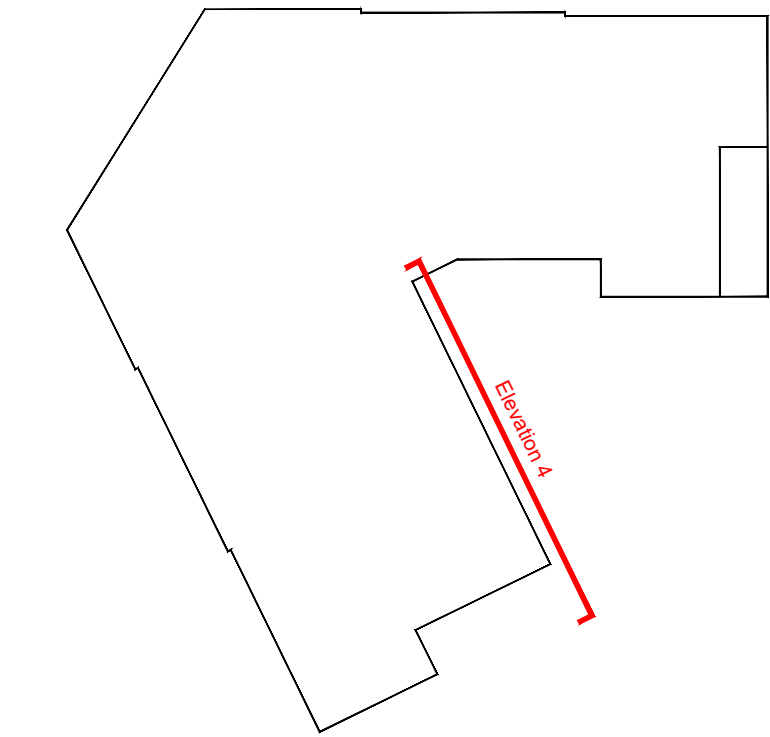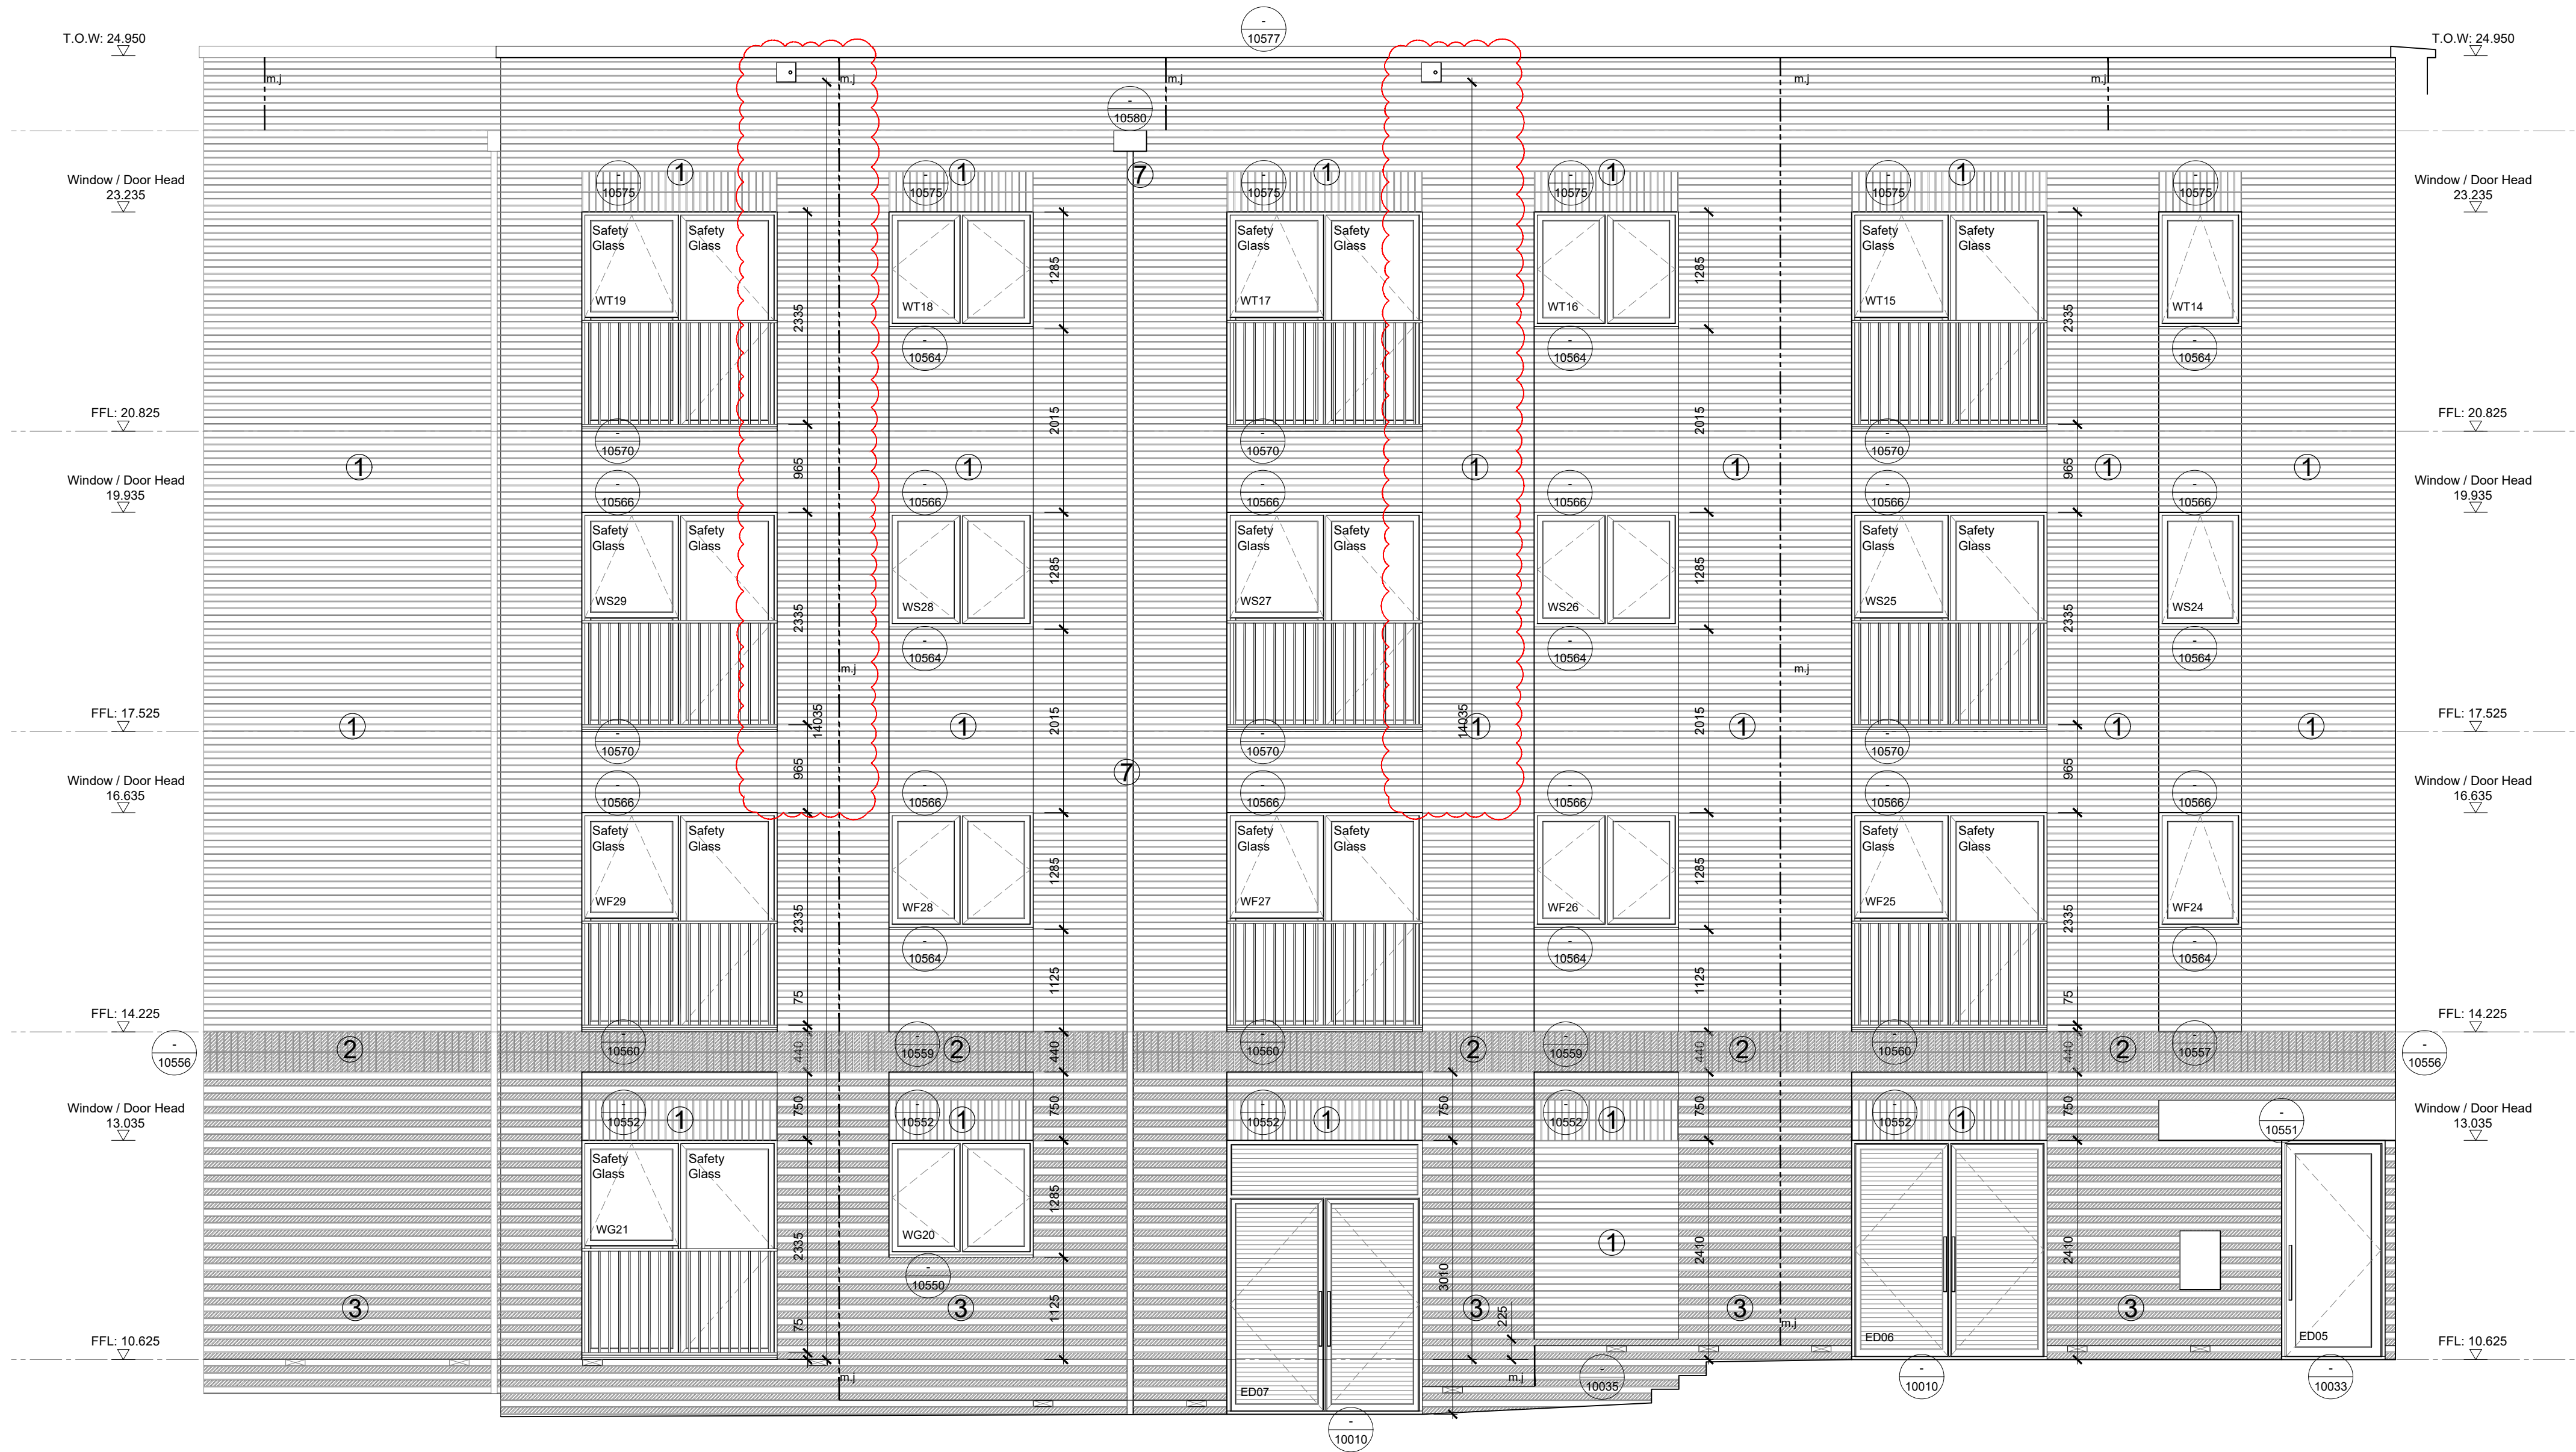

KEY PLAN

Proposed Residential Development, Milton Place, Gravesend.

KEY TO SYMBOLS ELEVATION

m.j. --- Movement Joint positions are shown indicatively. Structural engineer to confirm locations

ED01 External door reference

WG01 Window reference

* Windows marked thus to be egress windows

Safety Glass Indicates location of safety glass

Obscure Indicates obscure glazing

drawing detail Detail Drawing Number

KEY TO SYMBOLS ELEVATION

Indicates position of tile vents

tap Cold water bib tap

m.j. --- Movement Joint positions are shown indicatively. Structural engineer to confirm locations

ED01 External door reference

WG01 Window reference

* Windows marked thus to be egress windows

Safety Glass Indicates location of safety glass

Obscure Indicates obscure glazing

drawing detail Detail Drawing Number

Swift Brick

Materials Key:



1 - Brick Type 1: Cream

2 - Brick Type 2: White

3 - Alternating courses of brick type 1 and 2 (commencing in brick type 2 at finished floor level, alternating above and below)

Refer to Materials Schedule for specified items

No.	Date	Rev. by	Description
P01	29.10.2025	HE	Preliminary Issue
P02	07.11.2025	HE	Design Development
P03	26.01.2026	LB	Design Development
C01	27.02.2026	HE	Construction Issue
C02	10.03.2026	LP	Swift box added and set out.

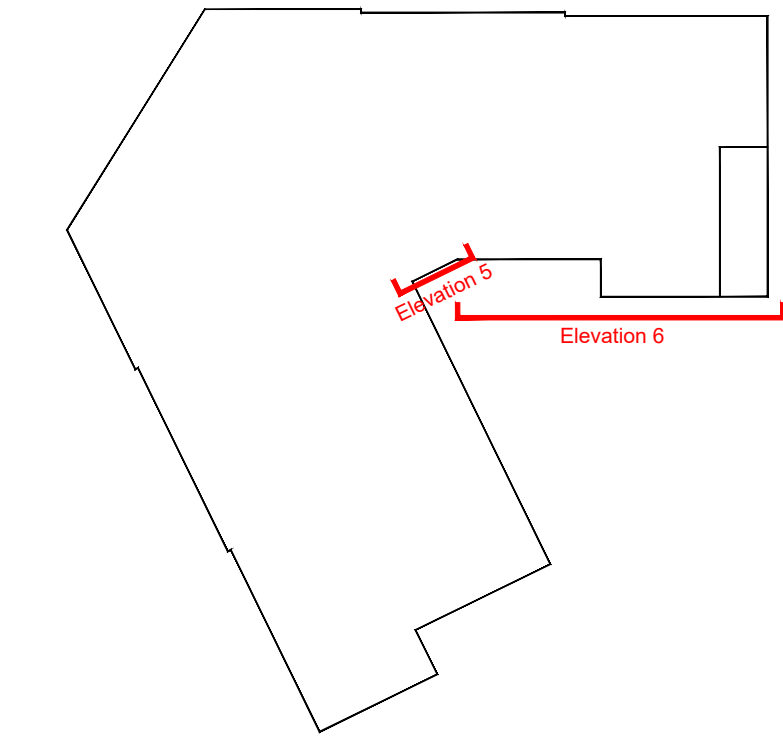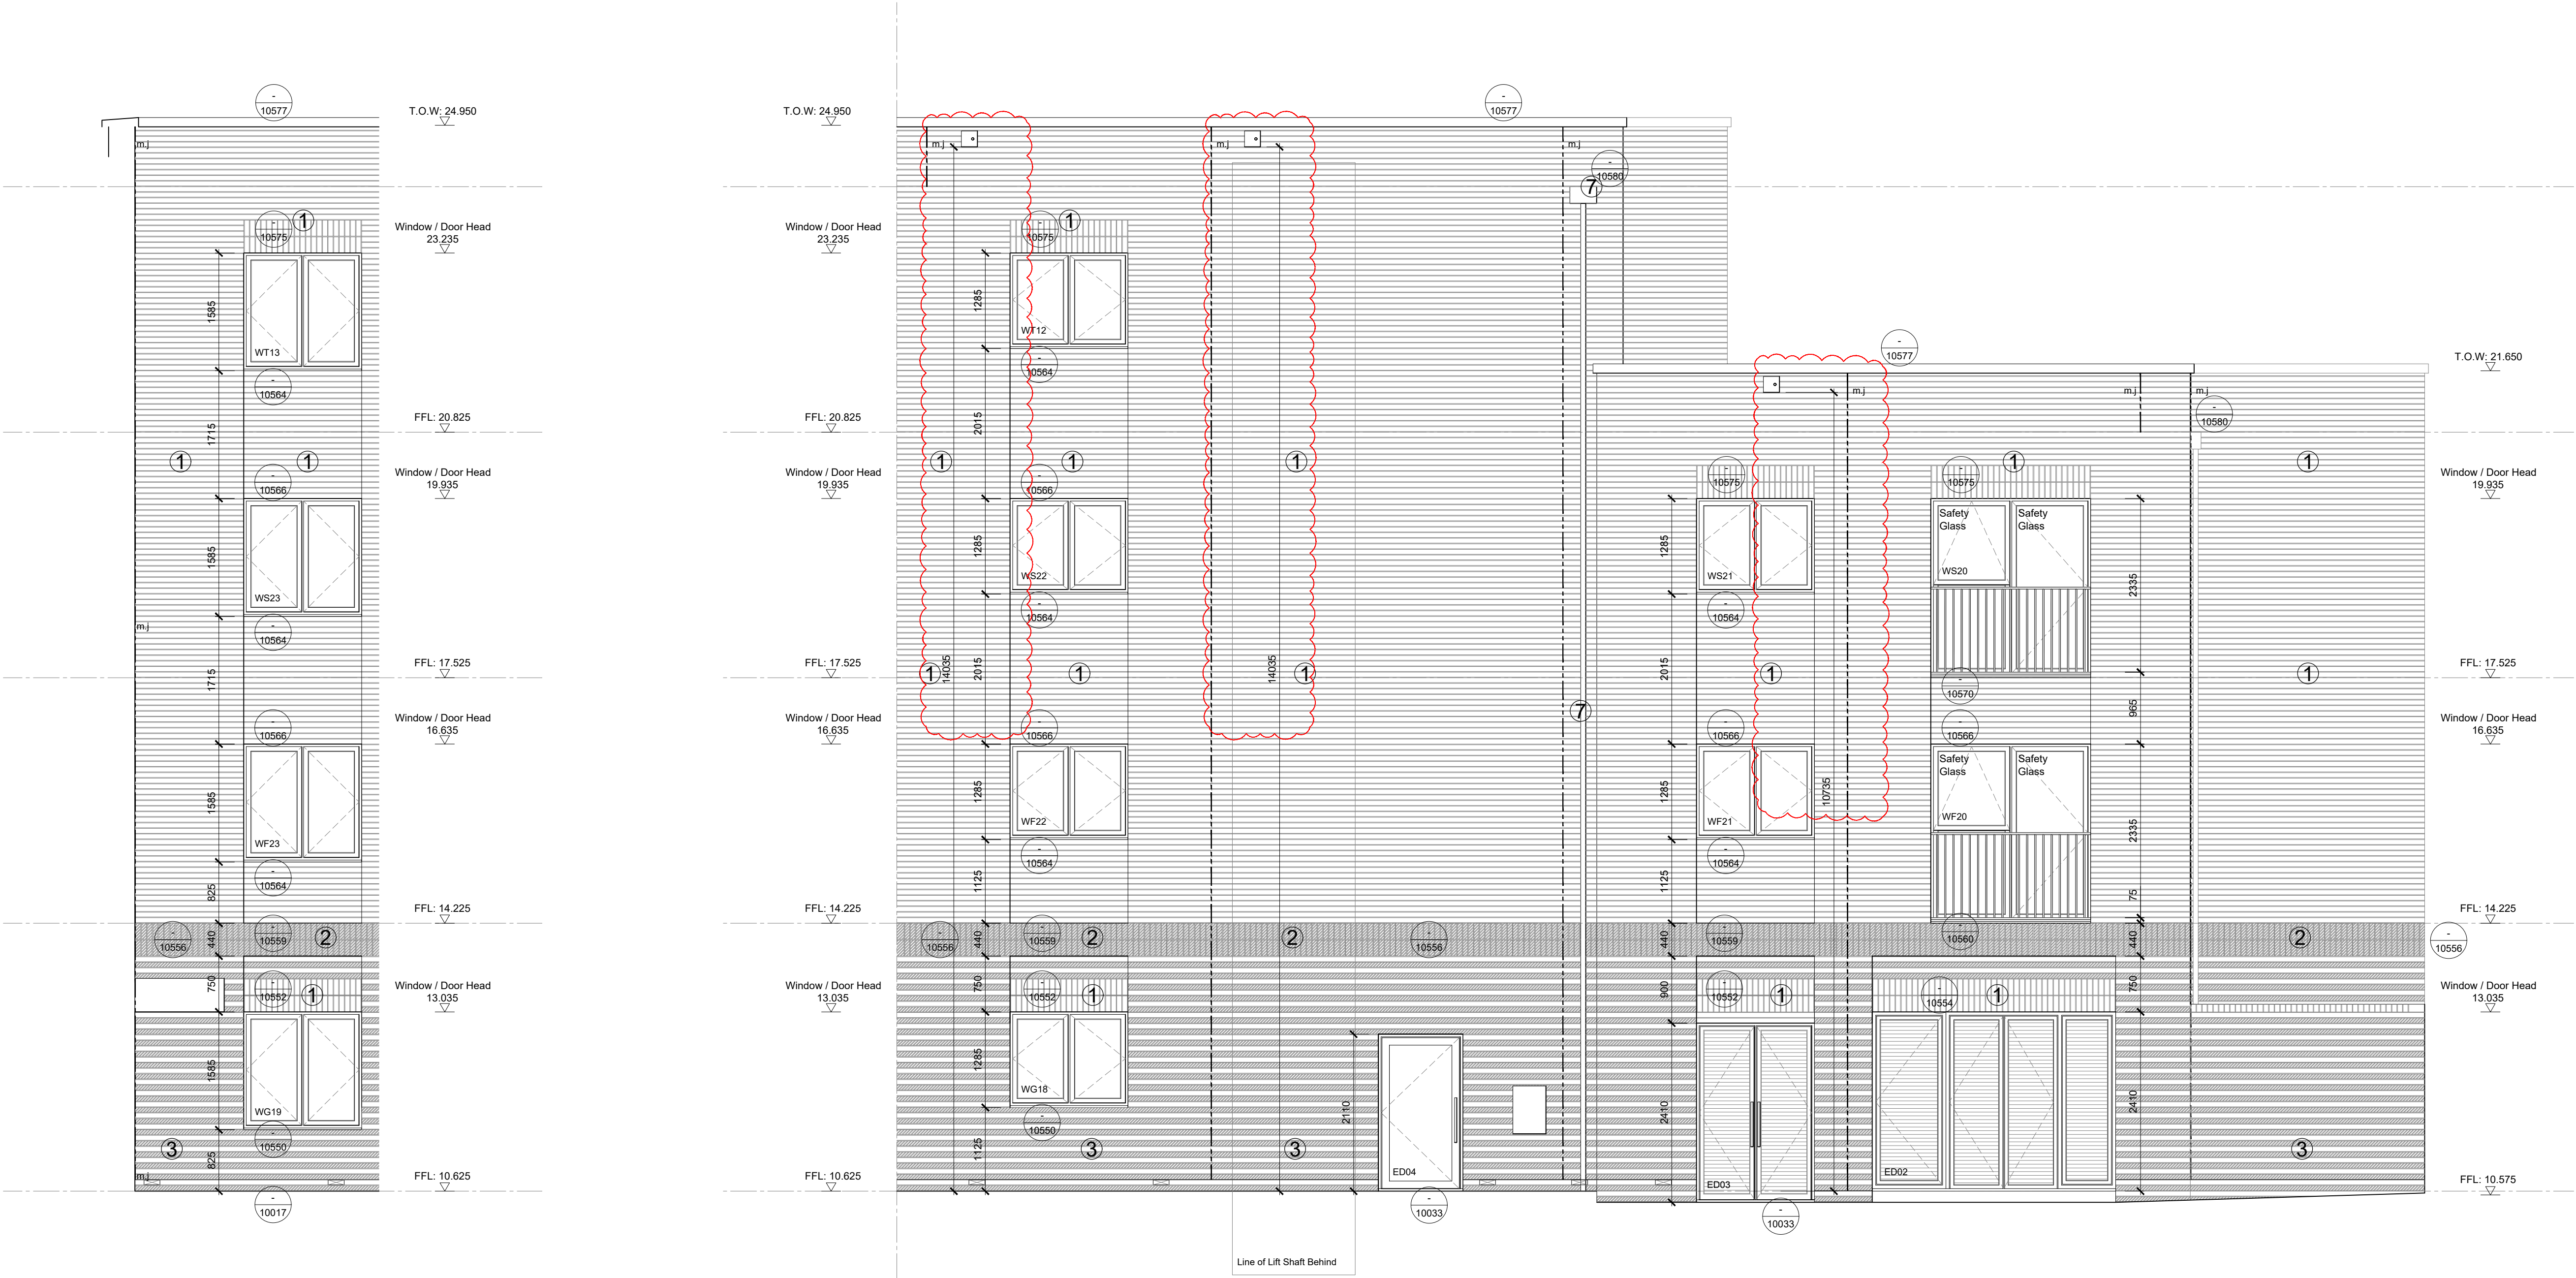

KEY PLAN

Proposed Residential Development, Milton Place, Gravesend.

KEY TO SYMBOLS ELEVATION

m.j. --- Movement Joint positions are shown indicatively. Structural engineer to confirm locations

ED01 External door reference

WG01 Window reference

* Windows marked thus to be egress windows

Safety Glass Indicates location of safety glass

Obscure Indicates obscure glazing

drawing detail Detail Drawing Number

KEY TO SYMBOLS ELEVATION

Indicates position of tile vents

tap Cold water bib tap

m.j. --- Movement Joint positions are shown indicatively. Structural engineer to confirm locations

ED01 External door reference

WG01 Window reference

* Windows marked thus to be egress windows

Safety Glass Indicates location of safety glass

Obscure Indicates obscure glazing

drawing detail Detail Drawing Number

Swift Brick


Materials Key:

1 - Brick Type 1: Cream

2 - Brick Type 2: White

3 - Alternating courses of brick type 1 and 2 (commencing in brick type 2 at finished floor level, alternating above and below)

Refer to Materials Schedule for specified items

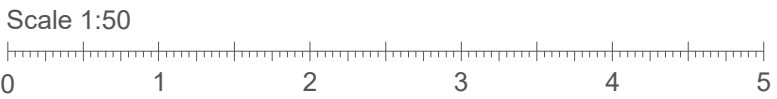

No.	Date	Rev. by	Description
P01	29.10.2025	HE	Preliminary Issue
P02	07.11.2025	HE	Design Development
P03	26.01.2026	LB	Design Development
C01	27.02.2026	HE	Construction Issue
C02	10.03.2026	LP	Swift box added and set out.

KEY TO SYMBOLS ELEVATION

Indicates position of tile vents

Cold water bib tap

Movement Joint positions are shown indicatively. Structural engineer to confirm locations

ED01

External door referenceWG01Windows marked thus to be egress windowsSafety GlassObscuredrawing detailSwift Brick

Materials Key:

1 - Brick Type 1: Cream

2 - Brick Type 2: White



3 - Alternating courses of brick type 1 and 2 (commencing in brick type 2 at finished floor level, alternating above and below)

Refer to Materials Schedule for specified items

KEY TO SYMBOLS ELEVATION

Movement Joint positions are shown indicatively. Structural engineer to confirm locations


ED01

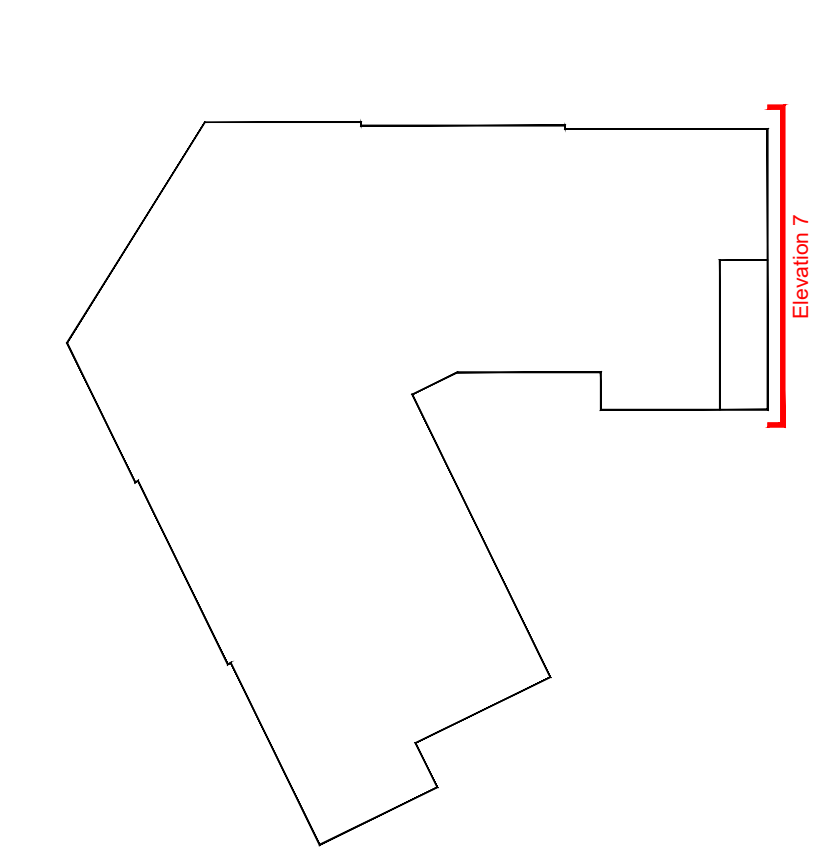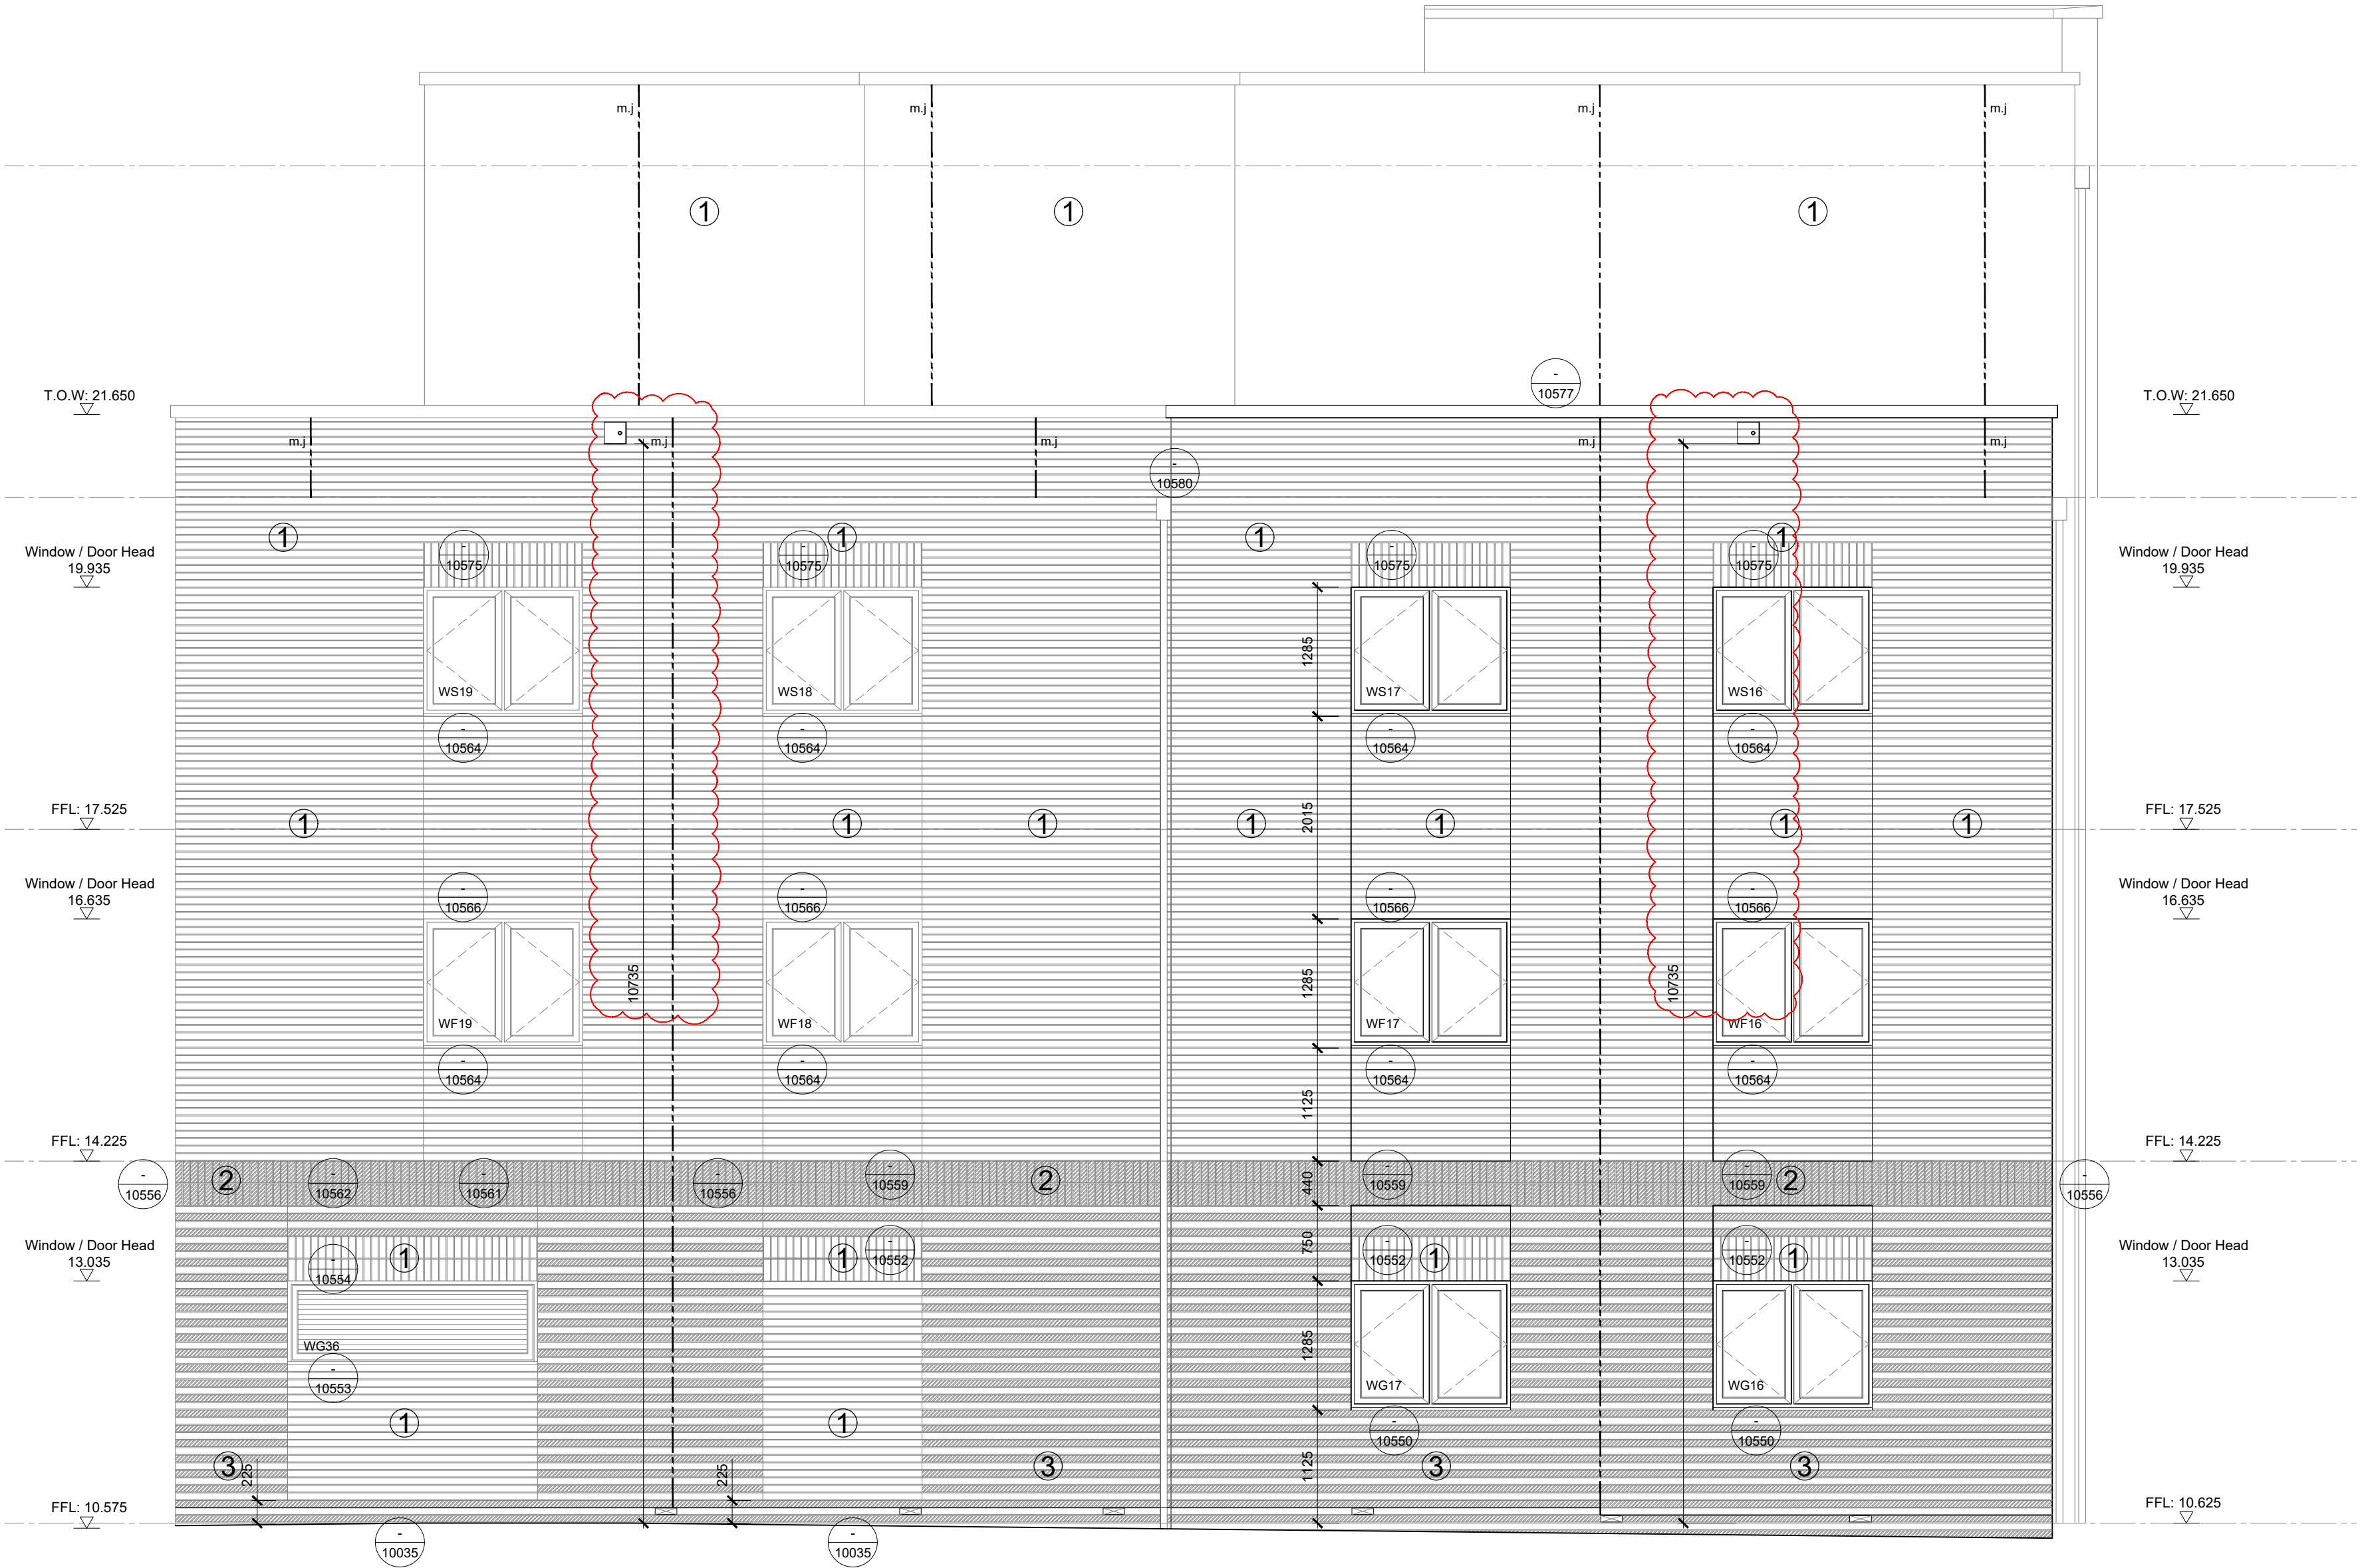External door referenceWG01Windows marked thus to be egress windowsSafety Glassdrawing detail

KEY PLAN

Proposed Residential Development, Milton Place, Gravesend.

No.	Date	Rev. by	Description
P01	29.10.2025	HE	Preliminary Issue
P02	07.11.2025	HE	Design Development
P03	28.01.2026	LB	Design Development
C01	27.02.2026	HE	Construction Issue

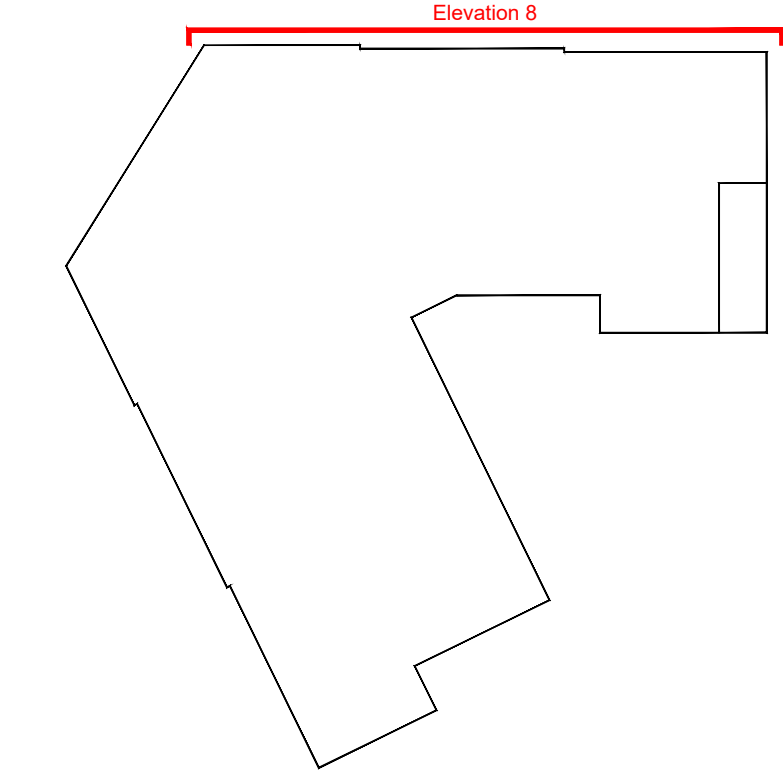

KEY PLAN

Proposed Residential Development, Milton Place, Gravesend.

KEY TO SYMBOLS ELEVATION	
	Indicates position of tile vents
	Cold water bib tap
	Movement Joint positions are shown indicatively. Structural engineer to confirm locations
ED01	External door reference
WG01	Window reference
*	Windows marked thus to be egress windows
Safety Glass	Indicates location of safety glass
Obscure	Indicates obscure glazing
drawing detail	Detail Drawing Number


Materials Key:

1 - Brick Type 1: Cream
2 - Brick Type 2: White
3 - Alternating courses of brick type 1 and 2, (commencing in brick type 2 at finished floor level, alternating above and below)

Refer to Materials Schedule for specified items

KEY TO SYMBOLS ELEVATION	
	Movement Joint positions are shown indicatively. Structural engineer to confirm locations
ED01	External door reference
WG01	Window reference
*	Windows marked thus to be egress windows
Safety Glass	Indicates location of safety glass
drawing detail	Detail Drawing Number

Hill Residential

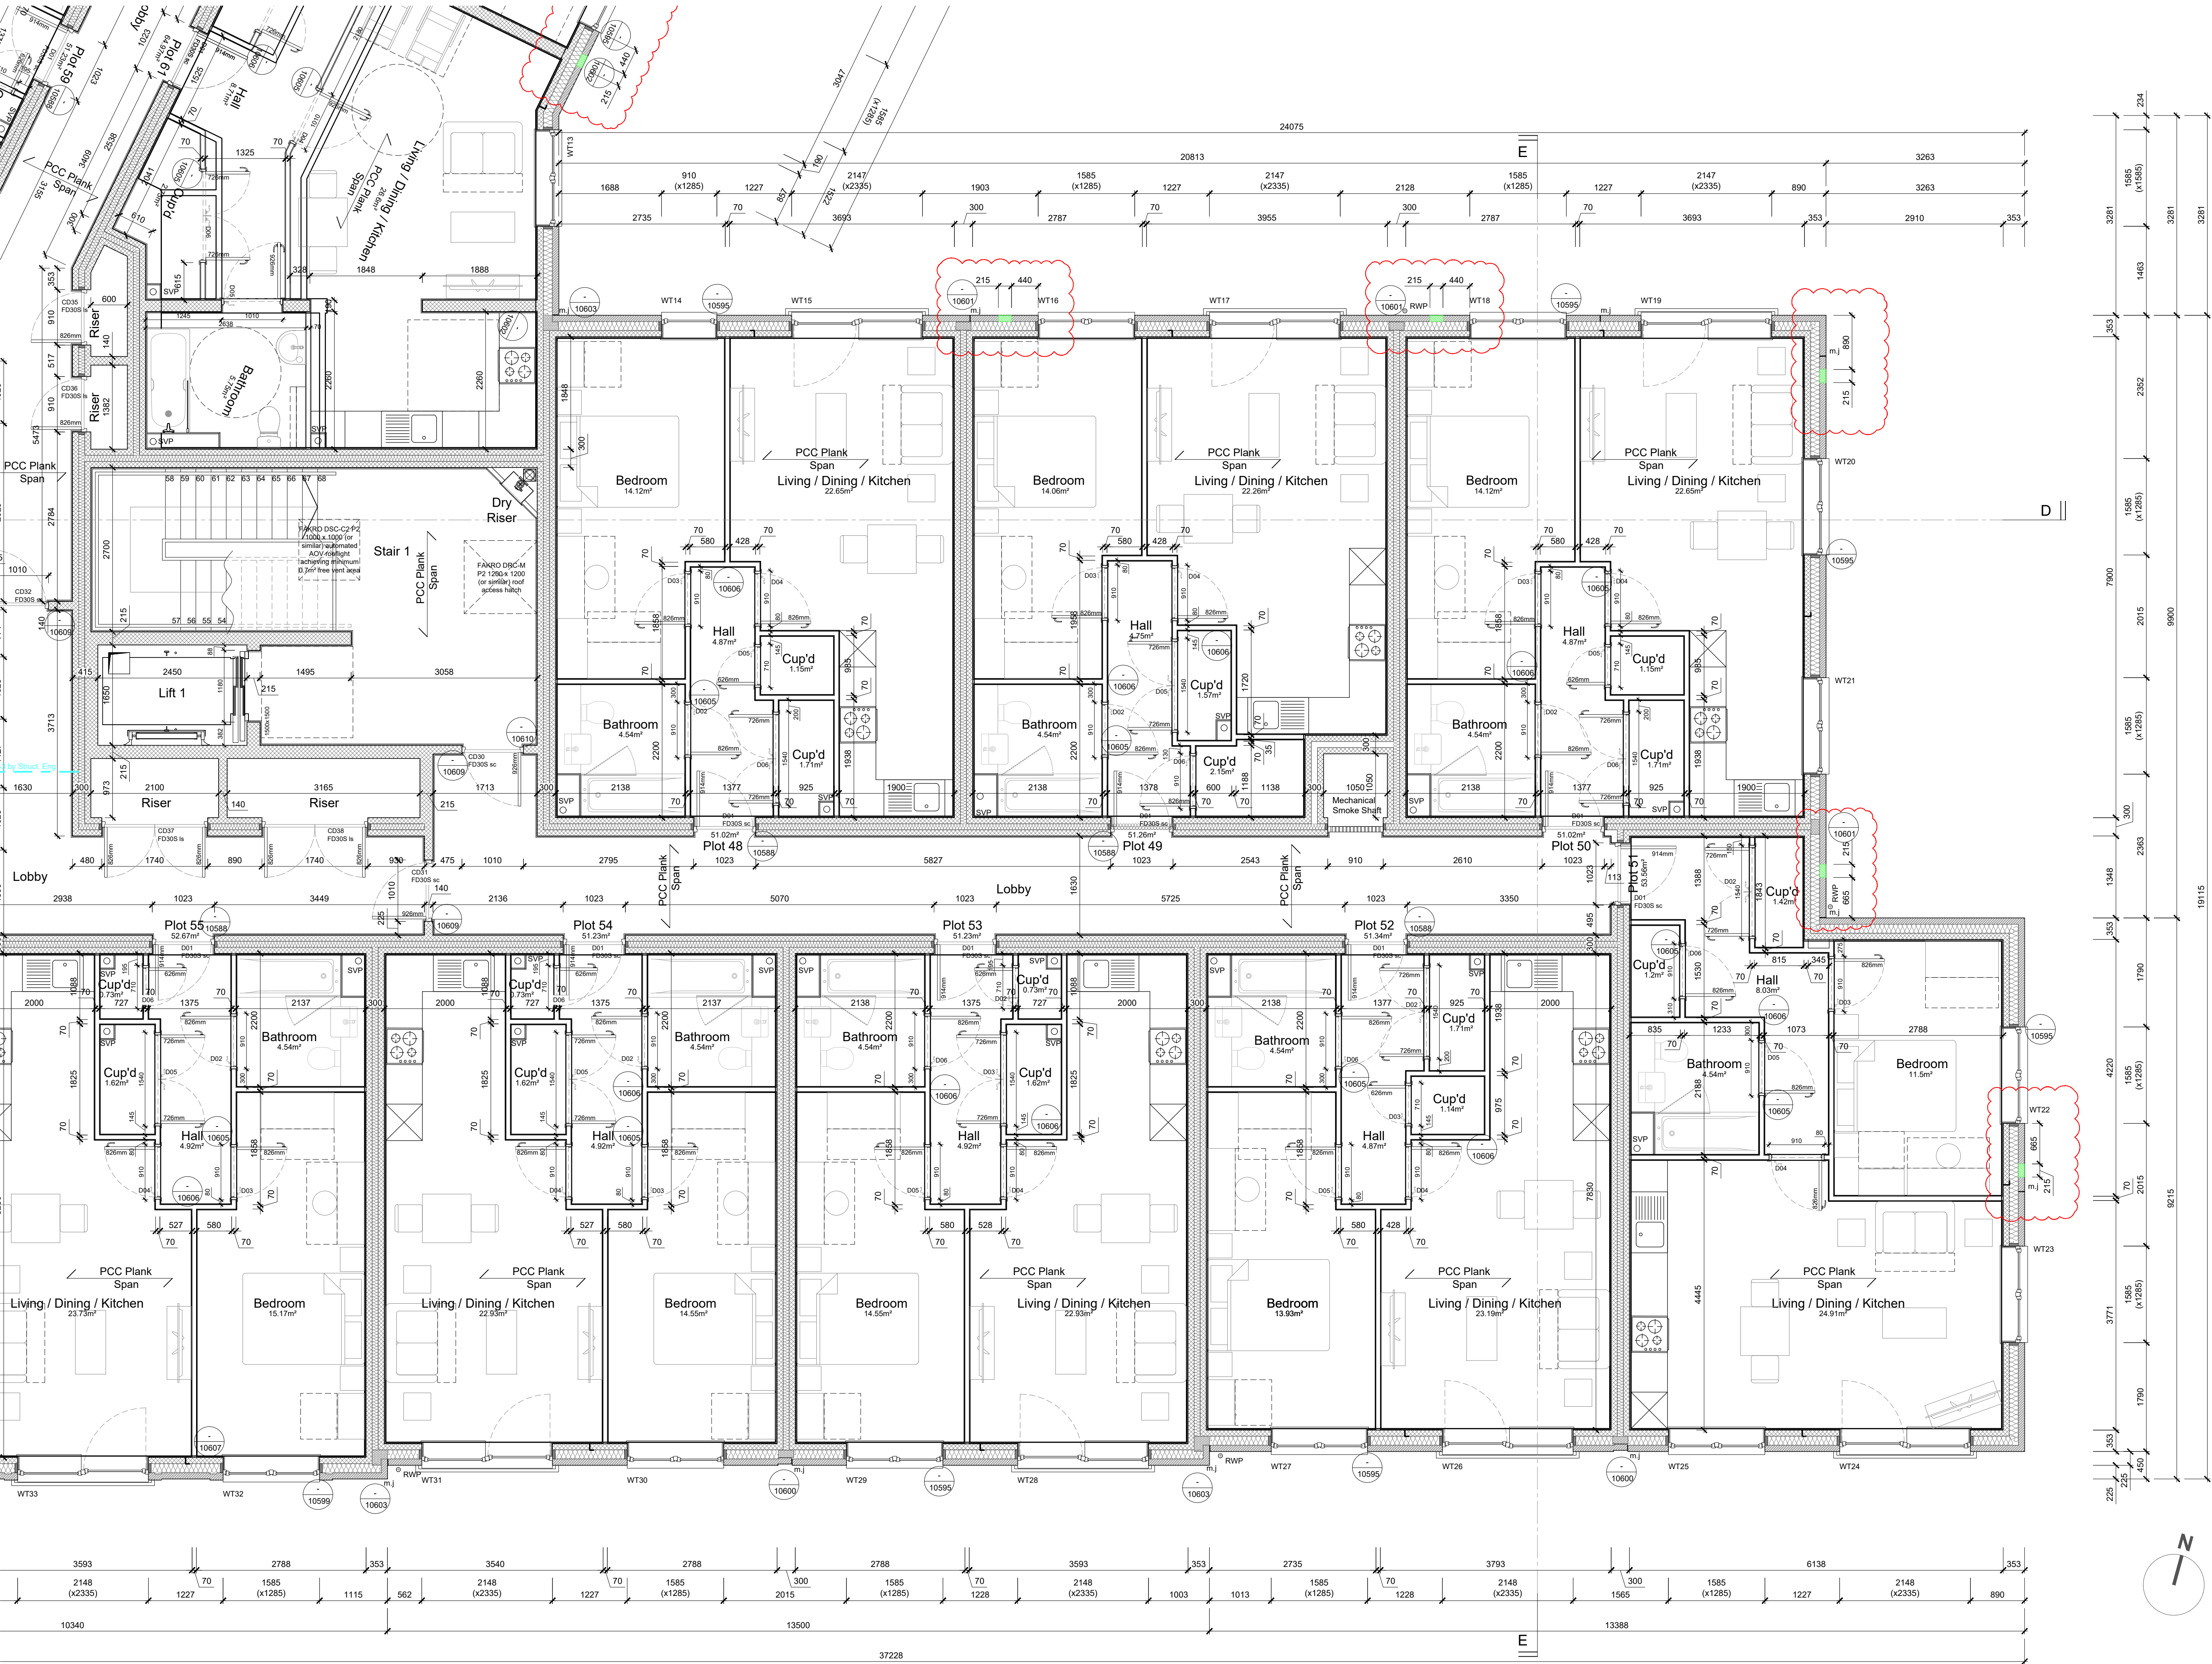

Report all discrepancies, errors and omissions. Verify all dimensions on site before commencing any work on site or preparing shop drawings.

All materials, components and workmanship are to comply with the relevant British Standards, Codes of Practice, and appropriate manufacturers recommendations that from time to time shall apply.

For all specialist work, see relevant drawings. This drawing and design are copyright of Clague LLP. Registration number: OC335948.

62 Burgate - Canterbury - Kent - CT1 2BH

2 Kinsbourne Court - Luton Road - Harpenden - Hertfordshire - AL5 3BL

8 Disney Street - London - SE1 1JF

Do Not Scale. Scaling permitted for planning purposes only.

No.	Date	Rev. by	Description
P01	16.10.2025	LP	Preliminary Issue
P02	28.10.2025	HE	Lift Shaft Size Amended
P03	07.11.2025	HE	Design Development
P04	10.12.2025	LB	Door to Stair 1 and wall arrangement inc riser amended
P05	28.01.2026	LB	AOV rooftop and access hatch shown. Movement Joints & Windposts added.
C01	27.02.2026	MA	M4(3) Replanned. Reference details added. Construction Issue
C02	10.03.2026	LP	Swift box added and set out.

KEY TO SYMBOLS SUPERSTRUCTURE

- Facing brickwork
- Blockwork (refer to structural engineers drawings for strengths)
- Timber Stud Partitions (refer to detail drawings)
- Timber buttressing partition (refer to detail drawings)
- movement joint
- SS foul drain stub stack with air admittance valve
- SP foul drain soil pipe (non ventilating)
- SVP foul drain soil and vent pipe
- ceiling mounted MEV extract grille (refer to M&E drawings for setting out)
- Detail Drawing Number
- WG01 Window reference
- ED01 External door reference
- D01 Internal door reference
- FD30 30 minute fire door (s) denotes requirement for smoke seals
- Vertical cavity fire barrier. Refer to construction details and notes.
- Swift Brick

CLAGUE ARCHITECTS

www.clague.co.uk 01227 762 060 info@clague.co.uk

Client
Hill Residential

Project Title
Proposed Residential Development
Milton Place
Gravesend
Kent

Drawing Description
Plots 1 - 61
Apartment Block
Third Floor Plan
Sheet 1 of 3

Scale Date Created Checked
1:50 @ A1 October 2025 LB / MTP

Drawing Status
CONSTRUCTION

Drawing Number
MPG-CLA-AA-03-D-A-00500

Revision
C02

Report all discrepancies, errors and omissions. Verify all dimensions on site before commencing any work on site or preparing shop drawings.

All materials, components and workmanship are to comply with the relevant British Standards, Codes of Practice, and appropriate manufacturers recommendations that from time to time shall apply.

For all specialist work, see relevant drawings. This drawing and design are copyright, of Clague LLP. Registration number: OC335948.

62 Burgate - Canterbury - Kent - CT1 2BH

2 Kinsbourne Court - Luton Road - Harpenden - Hertfordshire - AL5 3BL

8 Disney Street - London - SE1 1JF

Do Not Scale. Scaling permitted for planning purposes only.

No.	Date	Rev. by	Description
P01	16.10.2025	LP	Preliminary Issue
P02	29.10.2025	HE	Lift Shaft Size Amended
P03	07.11.2025	HE	Design Development
P04	10.12.2025	LB	Door to Stair 1 and wall arrangement inc riser amended
P05	28.01.2026	LB	AOV rooflight and access hatch shown. 190mm Blockwork walls added to Plot 61
C01	27.02.2026	MA	Movement Joints & Windposts added. M4(3) Replanned.
C02	23.03.2026	HE	Reference details added. Construction Issue
			Windposts removed to coordinate with markup.
			See revision clouds.

KEY TO SYMBOLS SUPERSTRUCTURE

- Facing brickwork
- Blockwork (refer to structural engineers drawings for strengths)
- Timber Stud Partitions (refer to detail drawings)
- Timber butressing partition (refer to detail drawings)
- movement joint
- SS foul drain stub stack with air admittance valve
- SP foul drain soil pipe (non ventilating)
- SVP foul drain soil and vent pipe
- ceiling mounted MEV extract grille (refer to M&E drawings for setting out)
- Detail Drawing Number
- WG01 Window reference
- ED01 External door reference
- D01 Internal door reference
- FD30 30 minute fire door (s) denotes requirement for smoke seals
- Vertical cavity fire barrier. Refer to construction details and notes.
- Swift Brick

CLAGUE ARCHITECTS

www.clague.co.uk 01227 702 060 info@clague.co.uk

Client
Hill Residential

Project Title
Proposed Residential Development
Milton Place
Gravesend
Kent

Drawing Description
Plots 1 - 61
Apartment Block
Third Floor Plan
Sheet 2 of 3



Scale Date Created Checked
1:50 @ A1 October 2025 LB / MTP

Drawing Status

CONSTRUCTION

Drawing Number Revision

MPG-CLA-AA-03-D-A-00501 C02

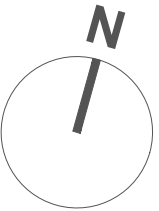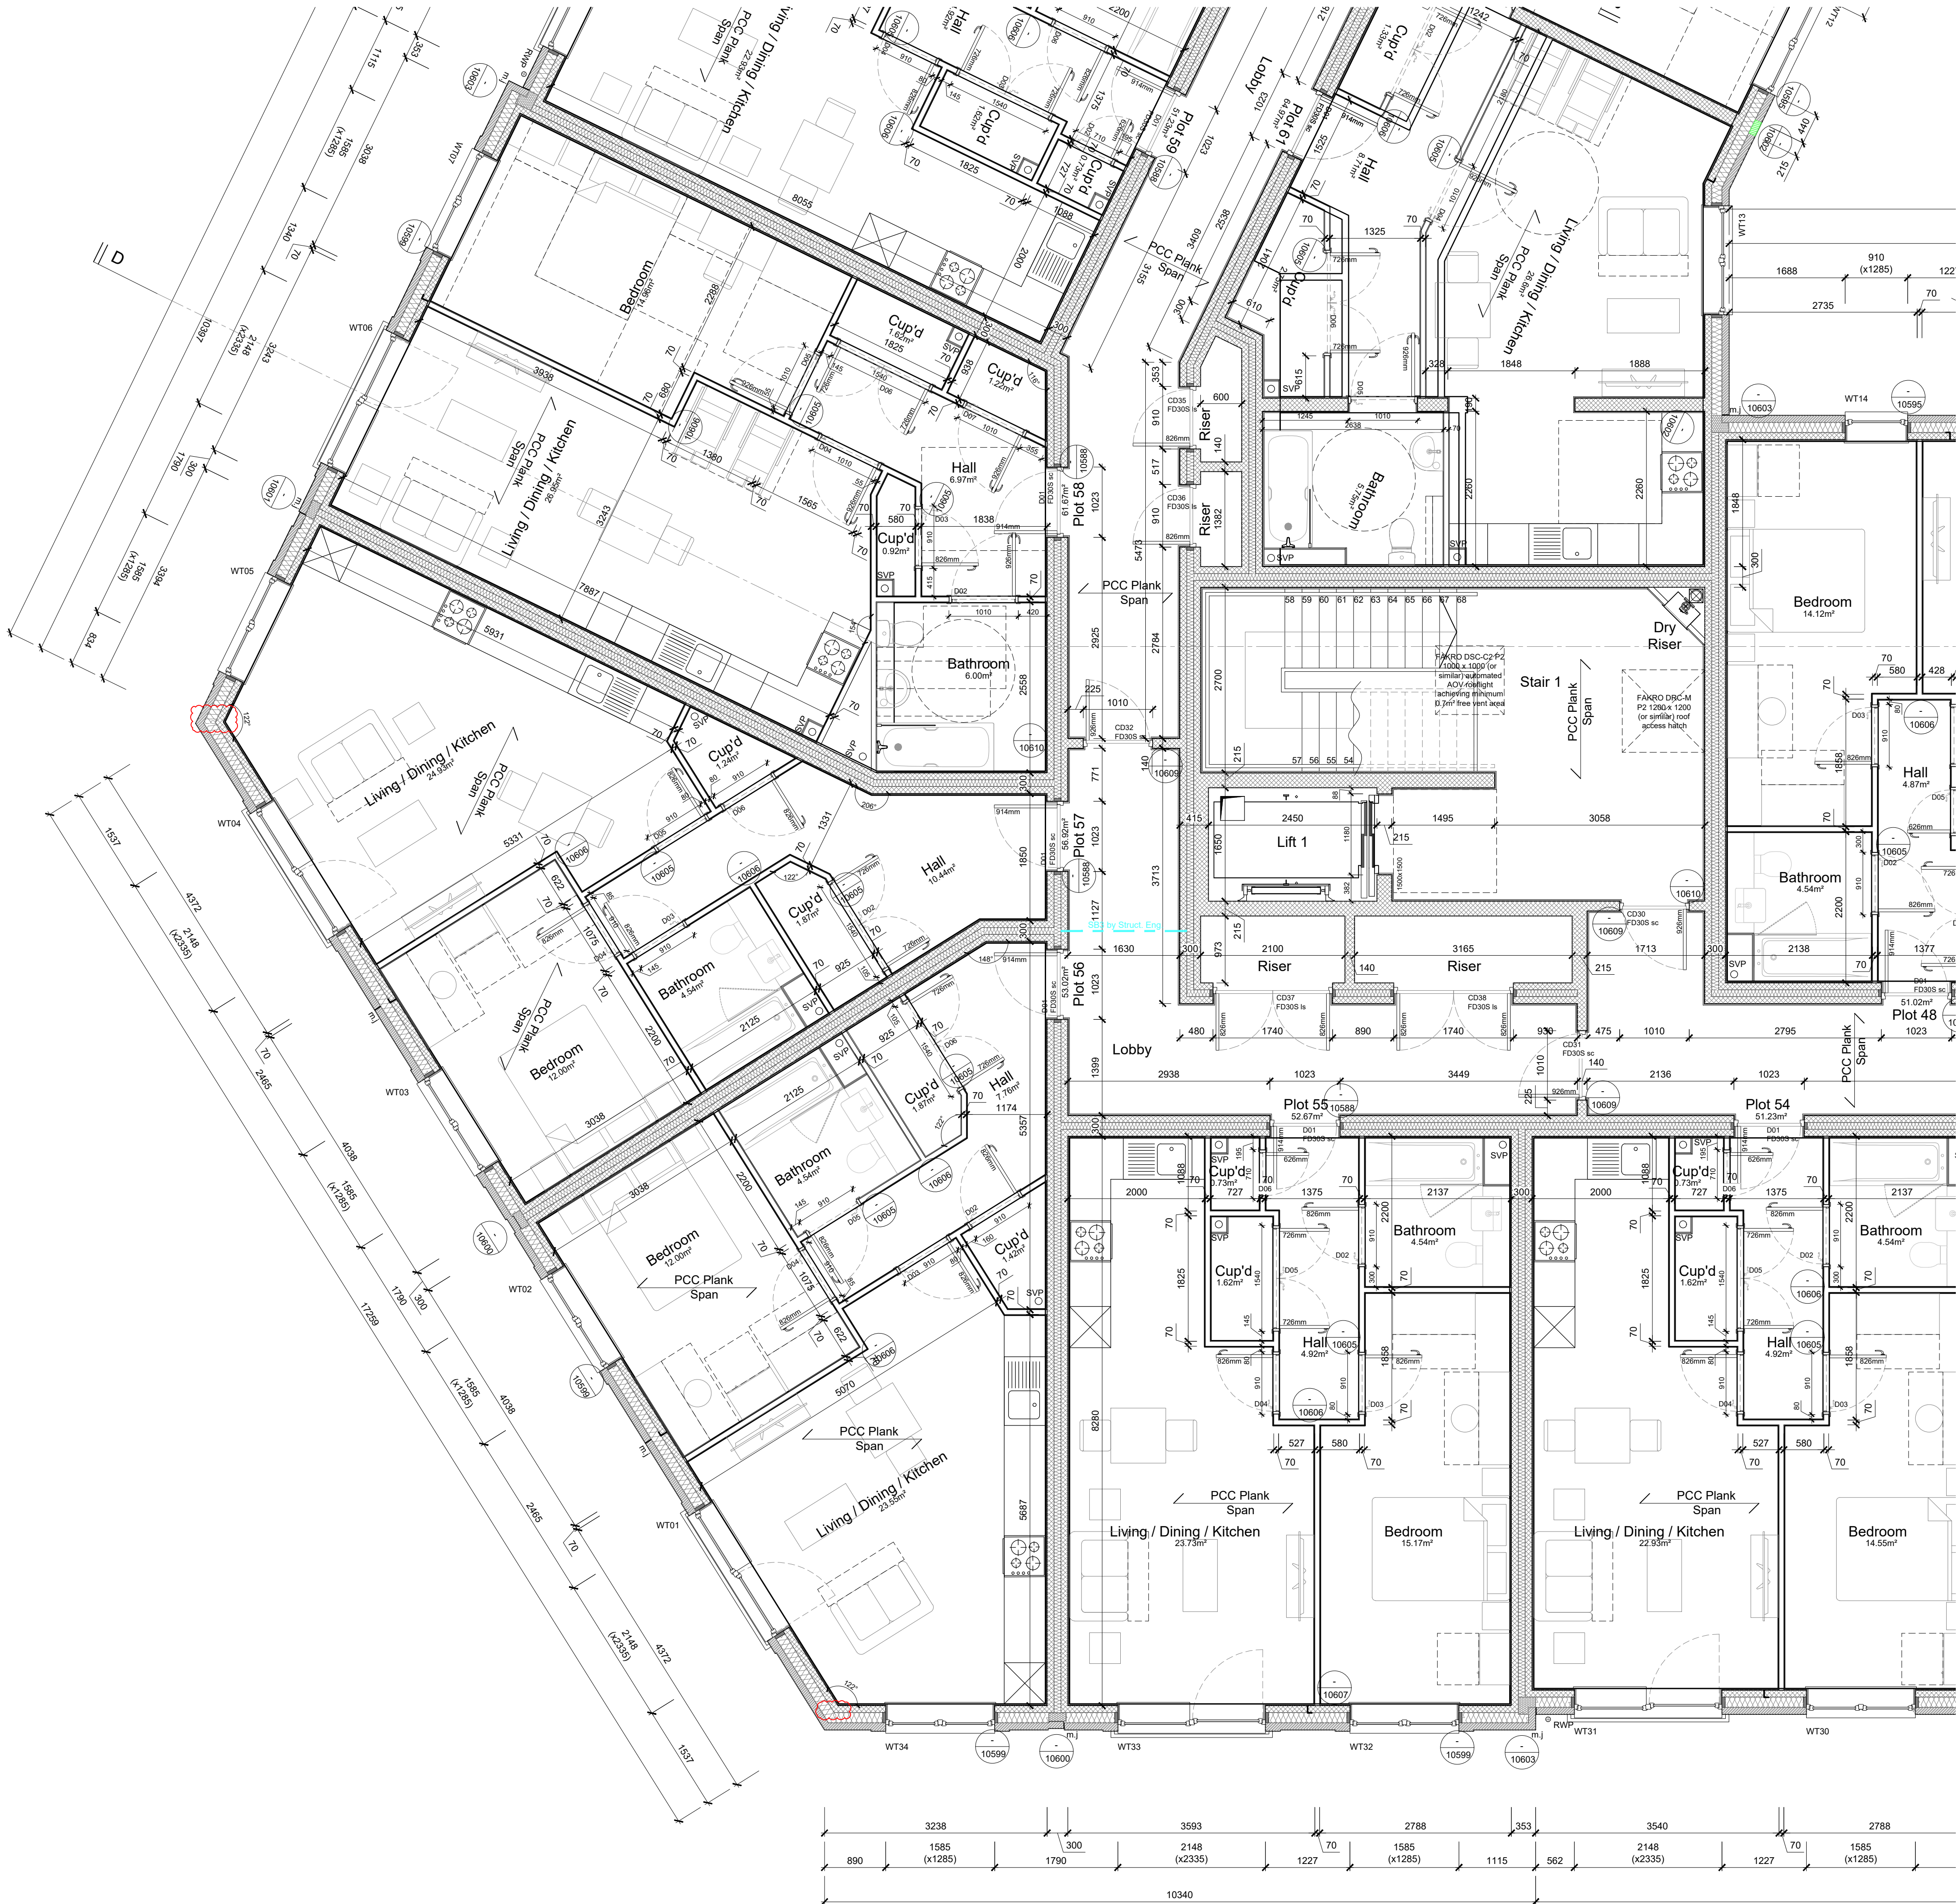

Scale 1:50

0 1 2 3 4 5

Report all discrepancies, errors and omissions. Verify all dimensions on site before commencing any work on site or preparing shop drawings.

All materials, components and workmanship are to comply with the relevant British Standards, Codes of Practice, and appropriate manufacturers recommendations that from time to time shall apply.

For all specialist work, see relevant drawings. This drawing and design are copyright, of Clague LLP. Registration number: OC335948.

62 Burgate - Canterbury - Kent - CT1 2BH

2 Kinsbourne Court - Luton Road - Harpenden - Hertfordshire - AL5 3BL

8 Disney Street - London - SE1 1JF

Do Not Scale. Scaling permitted for planning purposes only.

No.	Date	Rev. by	Description
P01	16.10.2025	LP	Preliminary Issue
P02	29.10.2025	HE	Lift Shaft Size Amended
P03	07.11.2025	HE	Design Development
P04	10.12.2025	LB	Door to Stair 2 and wall arrangement amended. AOV rooftop shown. Door to Stair 2 and wall arrangement amended. 190mm Blockwork walls added to Plot 61 Movement Joints & Windposts added.
P05	28.01.2026	LB	M4(3) Replanned. Reference details added. Construction Issue
C01	27.02.2026	MA	Swift box added and set out.
C02	10.03.2026	LP	Window reference added to AOV.
C03	23.03.2026	HE	See revision cloud.

