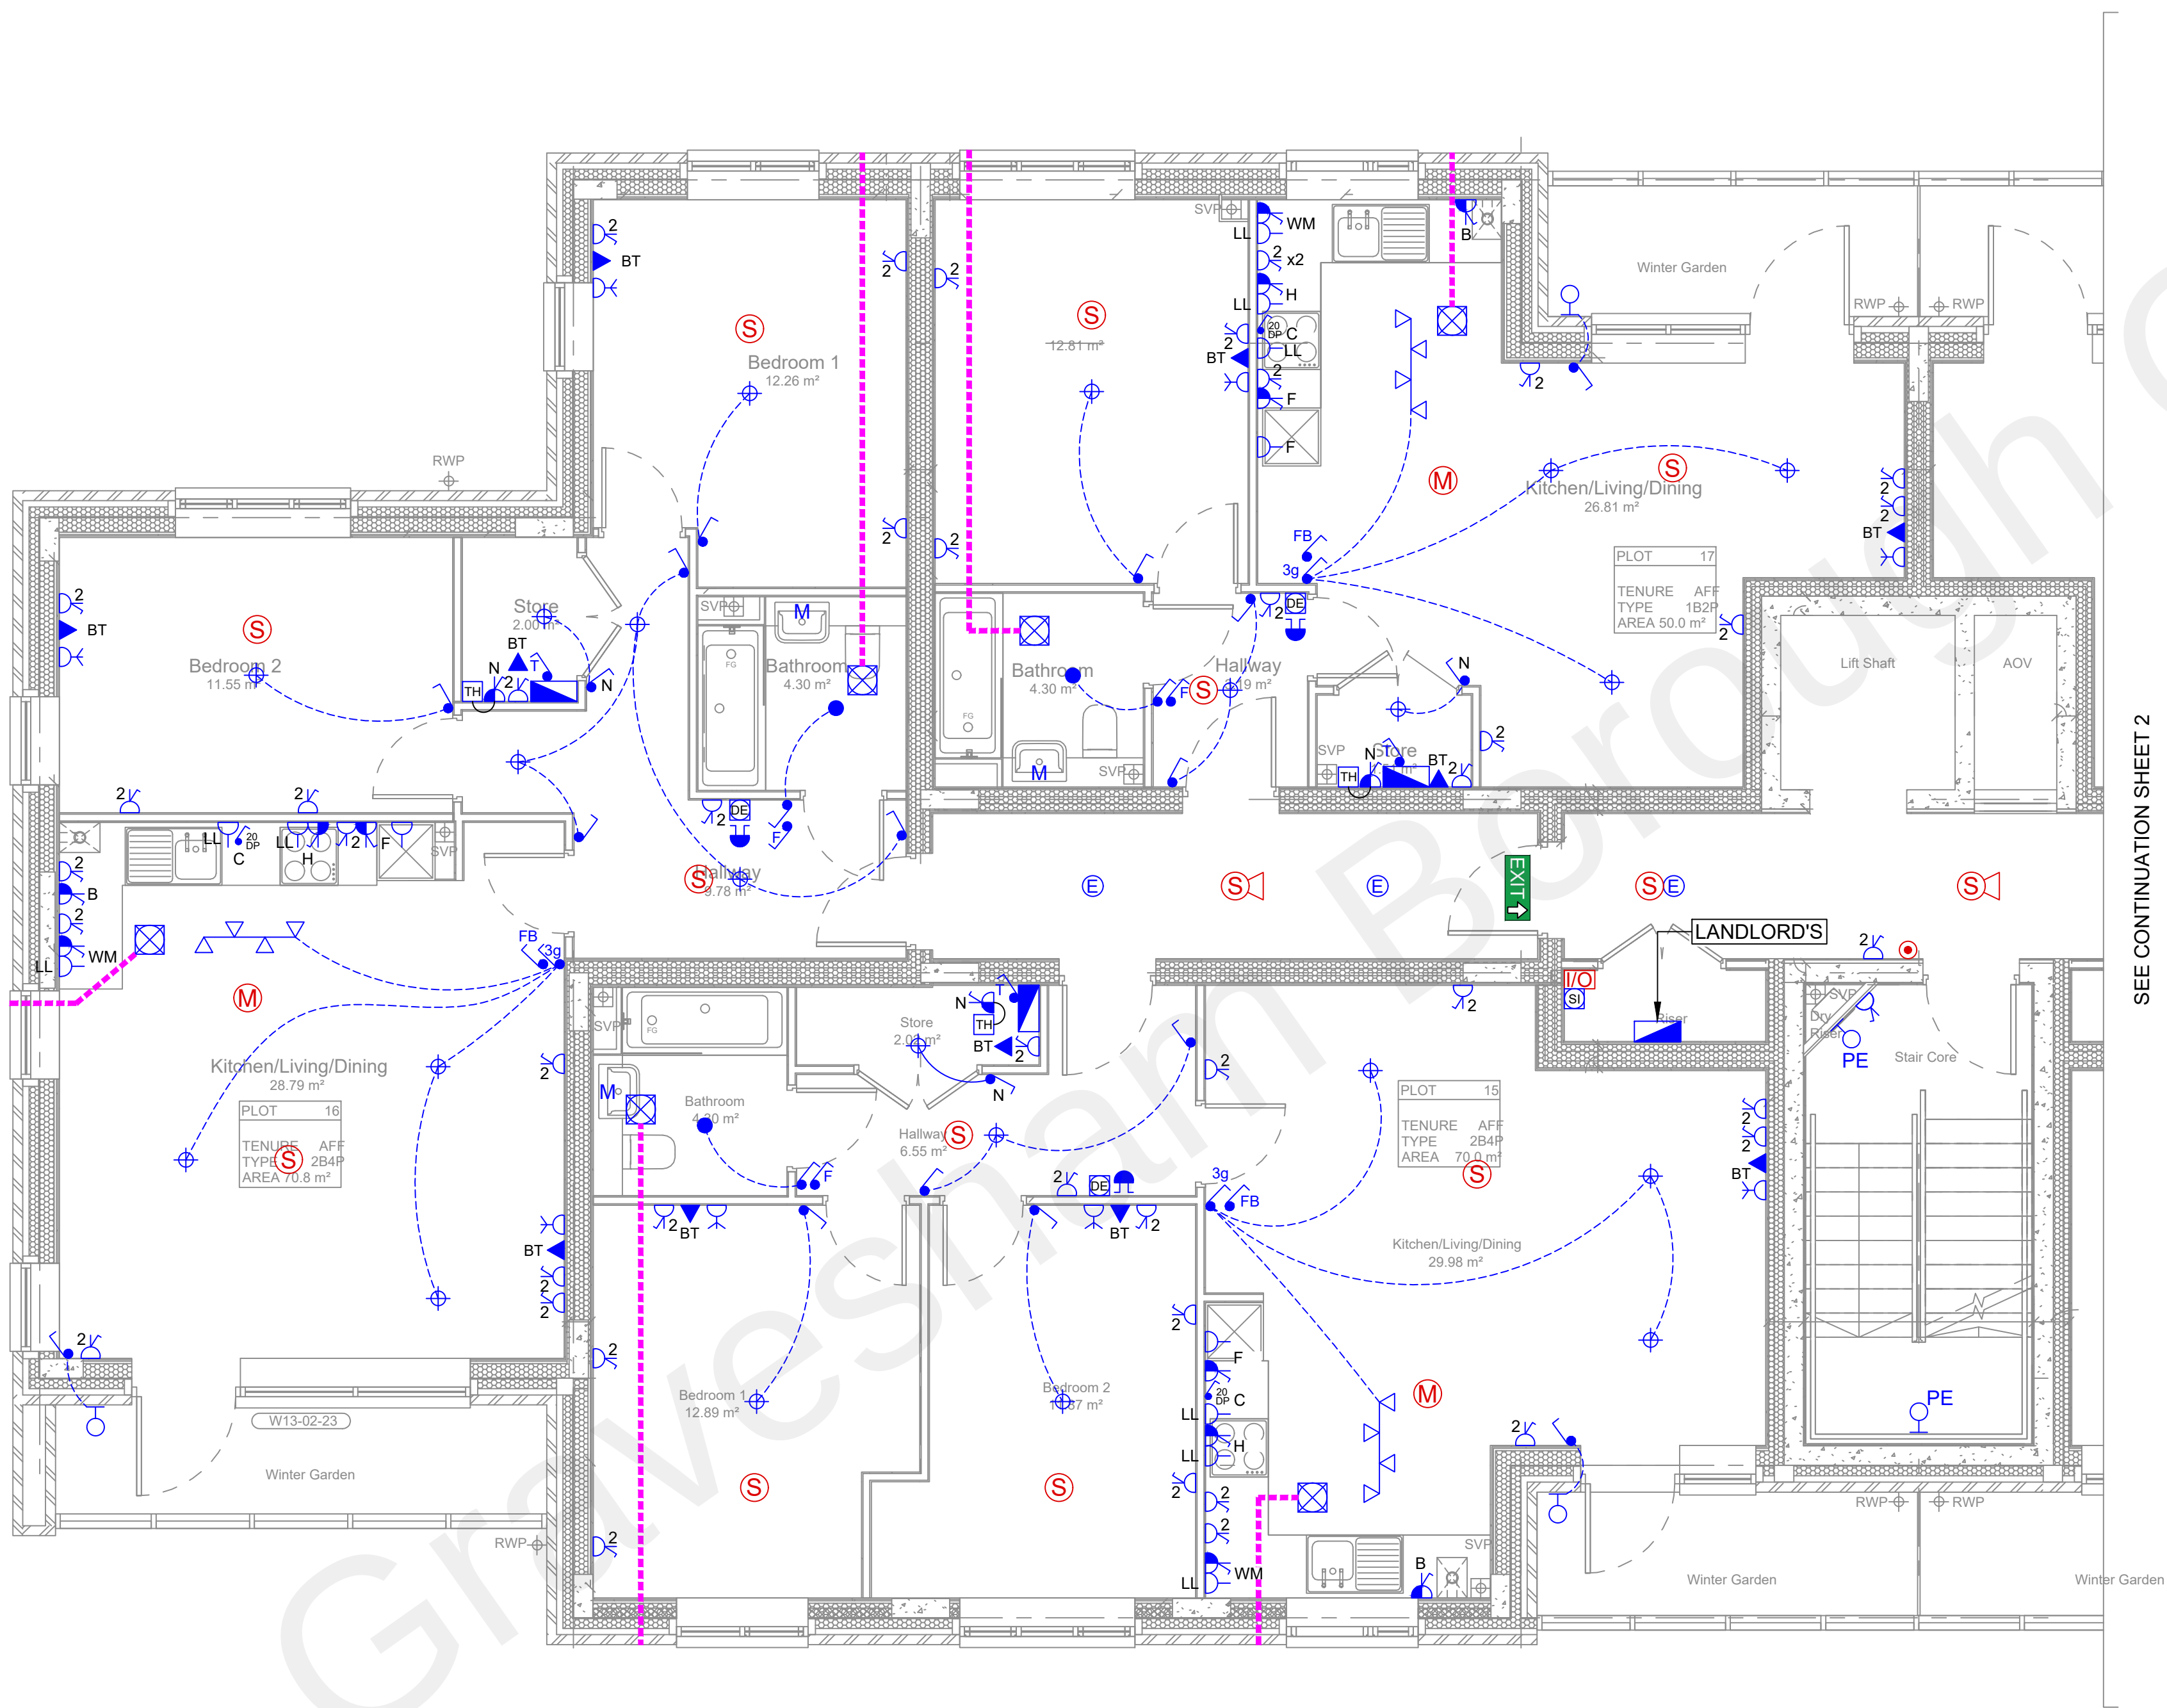


ELECTRICAL SERVICES	
	IP65 21w LED 1200mm surface mounted from OVIA Lingar U-Lite range
	As above, with emergency pack
	Circular surface mounted 18w LED with corridor arrow + emergency from OVIA Inceptor range
	Circular surface mounted 18w LED with eyelid cover, IP65 rated + PIR & emergency from OVIA Inceptor
	Circular IP54 bulkhead + LED lamp from OVIA Barra range
	White pendant fitting 150mm + LED lamp
	Circular IP44 LED 9w
	Chrome 4bar spot light + LED lamps
	Exit sign
	Mirror light.
	Single gang rocker switch. 'N' denotes neon.
	2 & 3 gang rocker light switch.
	PIR sensor
	Door entry hand set
	Door bell
	Unswitched single socket outlet
	Single switched socket
	Twin switched socket outlet
	Switched fused spur. 'N' denotes neon.
	Secondary telephone outlet
	TV outlet
	Combined heat & carbon monoxide detector
	Smoke detector
	Carbon monoxide detector
	Manual call point
	Interface
	Smoke detector c/w sounder
	Fire alarm panel
	Fan isolator switch
	Neon fan booster switch
	Greenwood Airvac Unity CV2GIP extract fan
	PVC rigid ducting 204 x 60mm
	Test switch
	Sprinkler interface
	Consumer unit
	20A double pole switch
	Tubular heater

• THIS DOCUMENT IS COPYRIGHT OF THE ORIGINATOR AND MUST BE TREATED AS CONFIDENTIAL.
• THIS DOCUMENT MUST NOT BE ALTERED, REPRODUCED OR DISTRIBUTED WITHOUT PRIOR WRITTEN CONSENT OF THE ORIGINATOR.
• DO NOT SCALE THIS DOCUMENT. ALL DIMENSIONS MUST BE CHECKED ON SITE PRIOR TO COMMENCEMENT OF ANY RELATED WORKS.
• THIS DOCUMENT MUST BE READ IN CONJUNCTION WITH ALL SUPPORTING DOCUMENTS PRODUCED BY THE ORIGINATOR.
• USERS OF THIS DOCUMENT ARE RESPONSIBLE FOR CHECKING WHICH REVISION IS CURRENT.

Notes & Symbols:

Fixing Heights:

- General purpose sockets, telephone & TV outlets 450mm FFL to bottom.
- Outlets above worktops 150mm FFL to bottom.
- Light switches & door entry 1200mm FFL to bottom.
- Consumer units 1500mm FFL to bottom.
- Lamp holders 2100mm FFL.

Abbreviations:

C - Cooker
F - Fridge
H - Hob
B - Boiler
WM - Washing machine
LL - Low level
N - neon

Rev.	Date.	Description.



Unit 11, Palace Industrial Estate, Bircholt Road,
Maidstone, Kent, ME15 9XU
Tel: 01622 688334 Email: enquiries@jws Kent.com

Project:
ST. PATRICK'S GARDEN

Drawing Title:
SECOND FLOOR
ELECTRICAL SERVICES
SHEET 1 OF 2

Scale: 1:50@A1	Date: 27/09/21
-------------------	-------------------

Drawing Status:
AS INSTALLED

Drawing No. ST PATRICK'S/05	Revision:
--------------------------------	-----------