




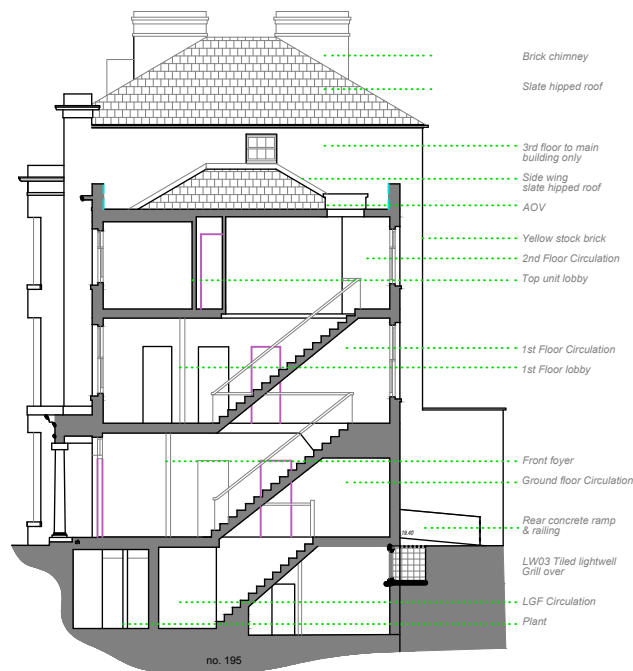

As Built Section AA
@ scale 1:200

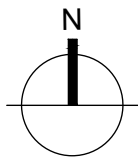


As Built North Facing Elevation
@ scale 1:200

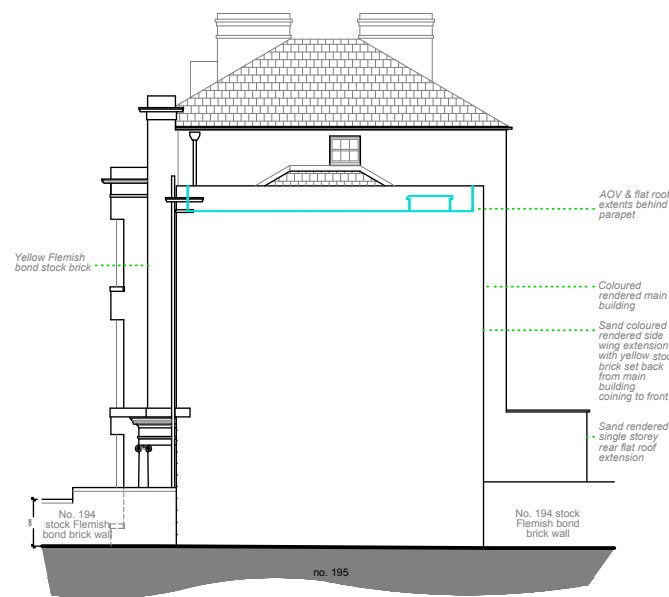


As Built East Facing Elevation
@ scale 1:200



As Built West Facing Elevation
@ scale 1:200

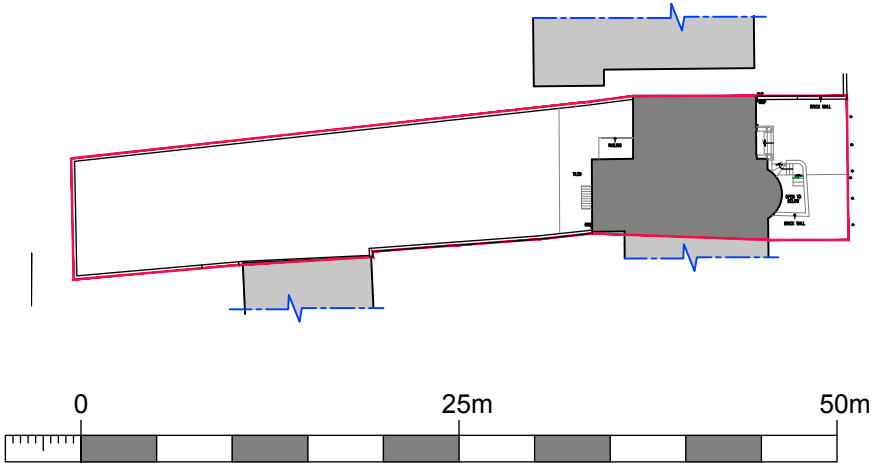

Site Plan @ 1:500

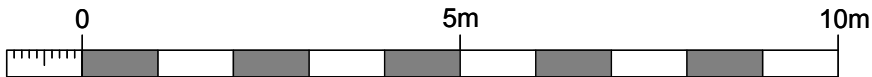

Floor Plans @ 1:100

NOTES:

Report all discrepancies, errors and omissions.

Verify all dimensions on site before commencing any work on site or preparing shop drawings.

All materials, components and workmanship are to comply with the relevant British Standards, Codes of Practice and appropriate manufacturers recommendations.

See relevant drawings for all specialist work.

This drawing and design are copyright of James Clague Architects Ltd, company registration number 8664802

Rev	Date	Description
-----	------	-------------

Project Title
Railton Proposed Flatted Schemes
195 Parrock Street
Gravesend
Kent DA12 1EW

Drawing Description
As Built Elevations and Sections

Scale
1:200 @ A3

Date
July 2026

Drawn By
AF

Latchmere House, 26 Watling Street,
Canterbury, Kent CT1 2UD
T: 01227 649 073
E: info@jamesclague.co.uk
W: jamesclague.co.uk

Drawing Number
28711_EX05

Revision
-