


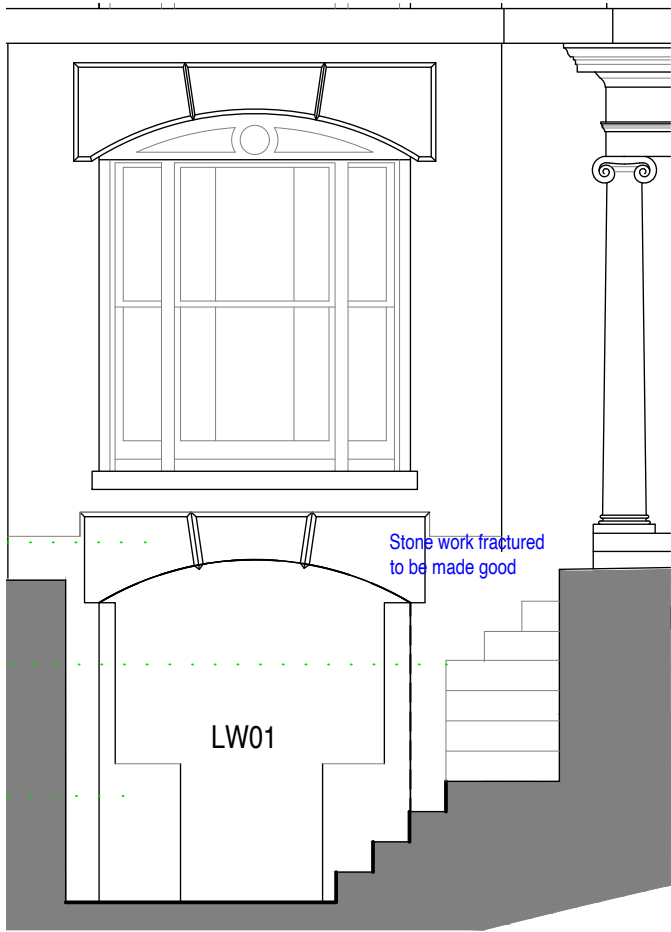


Aperture without infill, currently supported with acrow props

Front Sectional Elevation dd As Existing




New centralised door and side windows
Yellow stock brick facing made good


As Proposed @ scale 1:50

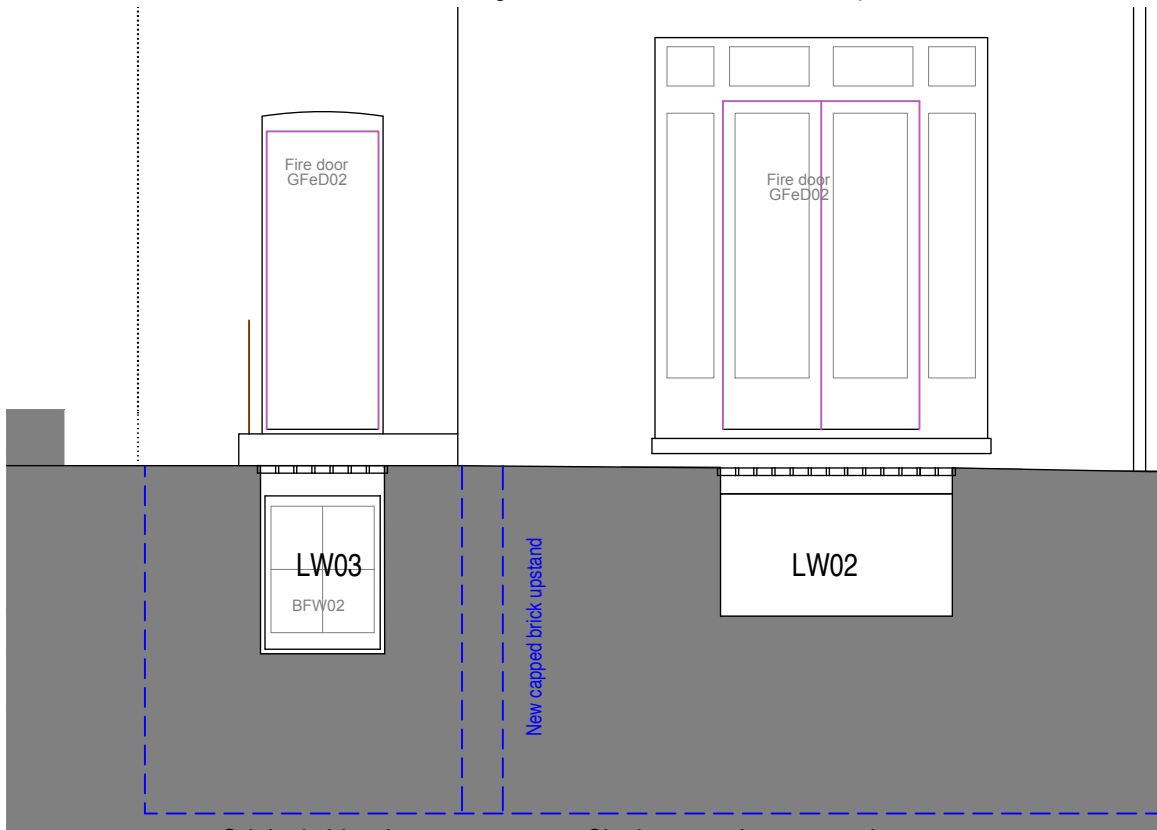


Original side wing
Single storey later extension over
Rear Sectional Elevation cc As Proposed @ scale 1:50

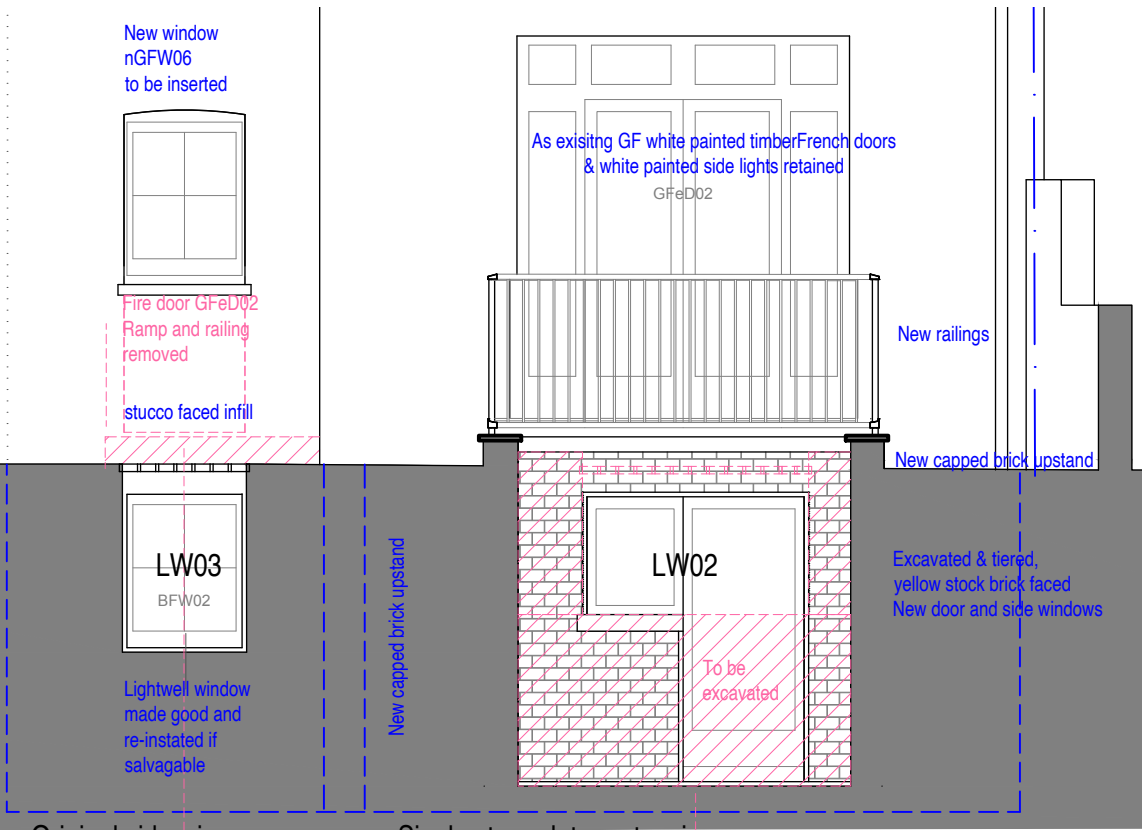


Original side wing
Single storey later extension over
Rear Sectional Elevation cc As Proposed @ scale 1:50

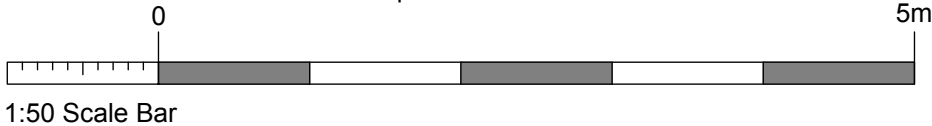

- Notes: For proposals see schedule of works
- LW01 Front bay lightwell aperture to be retained as existing;
New centralised 1/2 glazed door with side light sash windows
(to match those approve for neighbouring property 196)
New safety railings and gated access.
- LW02 No proposed changes to smaller rear lightwell
Existing window BFW02 to be retained
- LW03 Larger rear lightwell to be extended, brick lined and tiered.
Infill under existing aperture to be removed to provide level
threshold for new fully glazed door and window.
Brick upstand; coping stone and lightwell railings over
(tying into GF Juliet balcony over)

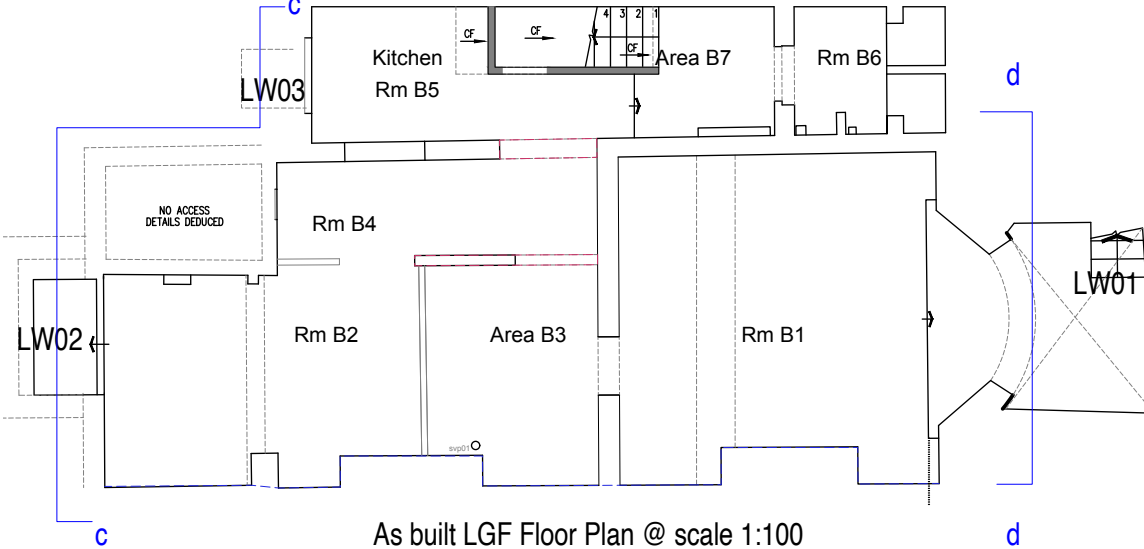

As built LGF Floor Plan @ scale 1:100

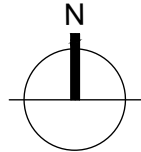

NOTES:

Report all discrepancies, errors and omissions.

Verify all dimensions on site before commencing any work on site or preparing shop drawings.

All materials, components and workmanship are to comply with the relevant British Standards, Codes of Practice and appropriate manufacturers recommendations.

See relevant drawings for all specialist work.

This drawing and design are copyright of James Clague Architects Ltd, company registration number 8664802

Rev Date Description

Project Title
Railton Proposed Flatted Schemes
195 Parrock Street
Gravesend
Kent DA12 1EW

Drawing Description
As Built and As Proposed
Front and Rear Lightwells LW011, 02 & 03

Scale
1:50 @ A3

Date
July 2026

Drawn By
AF

Latchmere House, 26 Watling Street,
Canterbury, Kent CT1 2UD
T: 01227 649 073
E: info@jamesclague.co.uk
W: jamesclague.co.uk

Drawing Number
28711_EX06

Revision
-