




ASBUILT FRONT ELEVATION

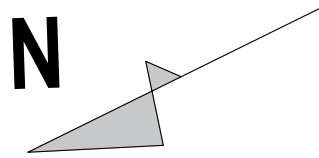


ASBUILT REAR ELEVATION

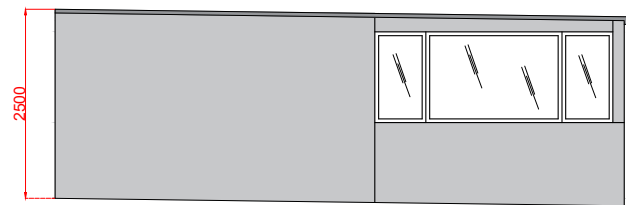


ASBUILT WEST SIDE ELEVATION

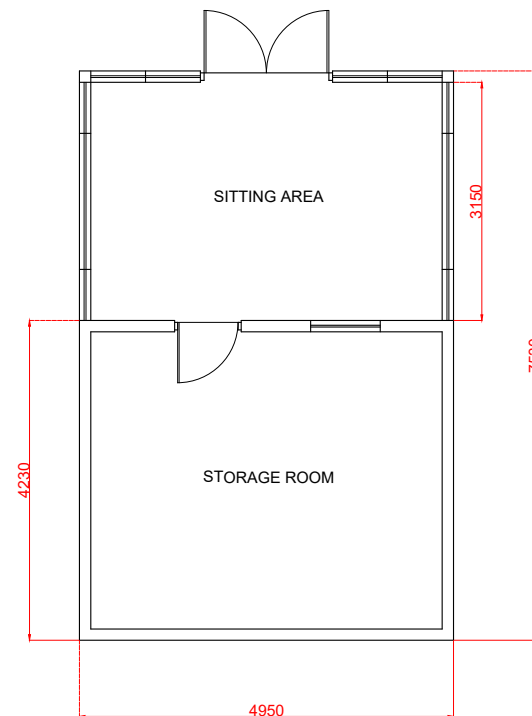


ASBUILT OUTBUILDING PLAN

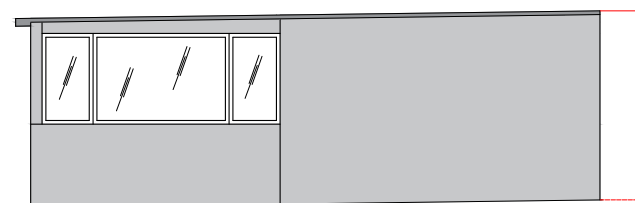

ASBUILT EAST SIDE ELEVATION

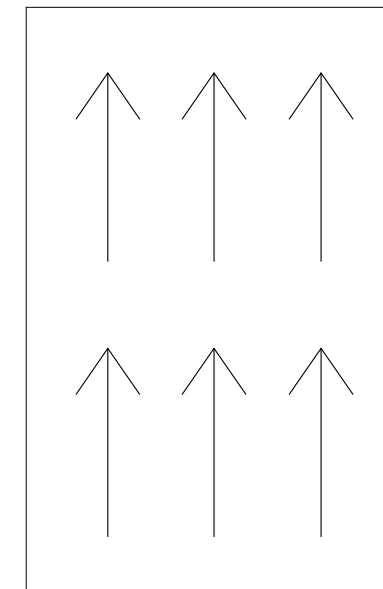

ASBUILT ROOF PLAN

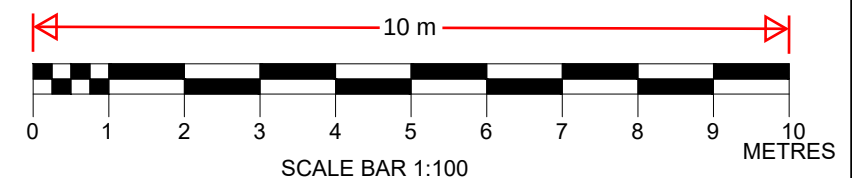

DWG NO : 54 -DA12 5RS -001 Rev 2.0

DWG UNITS : ALL UNITS IN MILLIMETER
SCALE : 1 : 100 @ A3

ASBUILT OUTBUILDING DWG

NOTE:

All the Elevations are drawn above ground floor level. Sub structures are not drawn.

KOVIL CONSULTANCY

PROJECT : 54, VALLEY DRIVE , GRAVESEND, DA12 5RS

TITLE : ASBUILT OUTBUILDING PLANS & ELEVATIONS DWG

DRAWN BY :Sutha (SA)

DATE : 01-05-2024