


Old Road West

Wrotham road

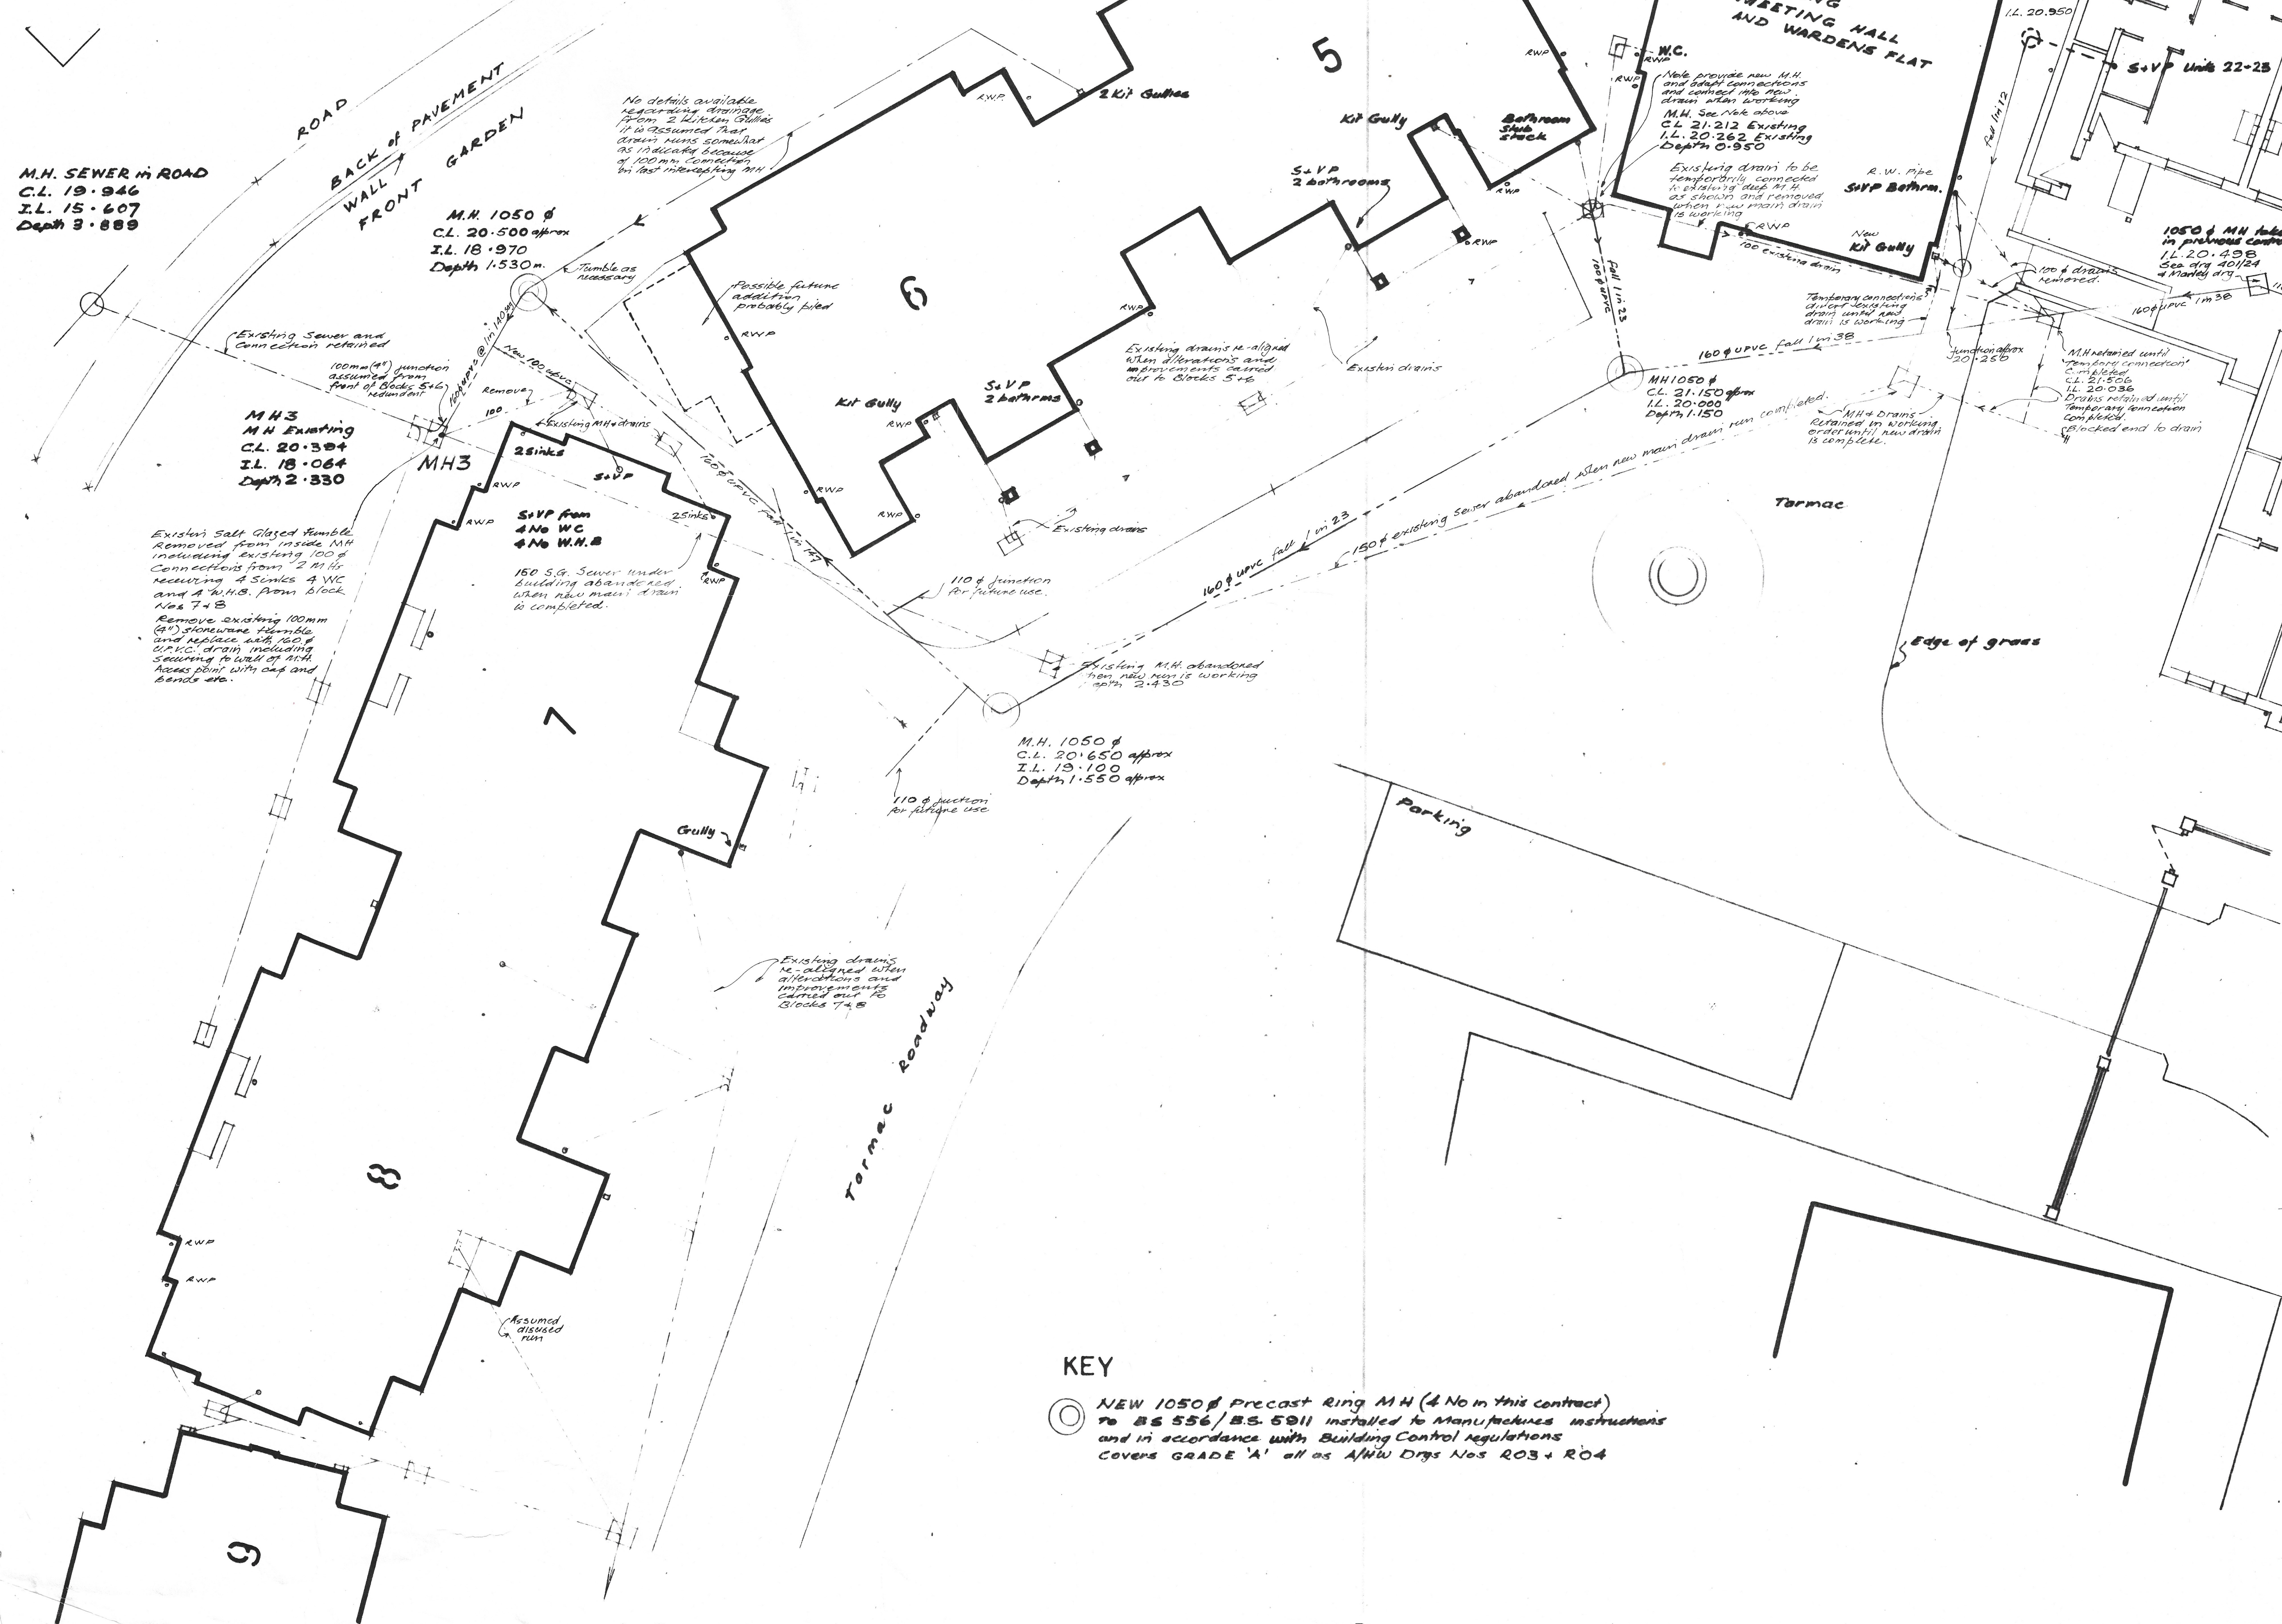

Notes 1 No dimensions are to be scaled from this drawing. 2 Contractors must verify all figured dimensions on site before commencing work. 3 Errors or omissions must be reported to the Architects. 4 All work must comply with relevant Building Regulations, B.S. C. of P. and manufacturers recommendations. 5 This drawing is the copyright of the Architects and must not be reproduced or used without permission.			
NOTE Drains not carried out exactly as shown on this drawing As built drawings awaited from Contractors			
12-4-92, Layout of Drains altered. Date: 12-4-92 Revisions:			
Job RE-BUILDING PROGRAMME PHASES 1 + 2			
Location ST. THOMAS'S ALMSHOUSES OLD ROAD WEST GRAVESEND KENT			
Client THE TRUSTEES			
Content DRAINAGE WORKS REALIGNMENT RENEWING 'ORIGINAL' SEWER RUN			
Cavell Malloch Associates Chartered Architects Surveyors 23 Wrotham Road Gravesend Kent DA11 0PA Gravesend (0474) 552701			
Scale 1:100		Date Feb 1992	
Job No. 4010 Drains	Dr. No. D 5	Rev. A	