




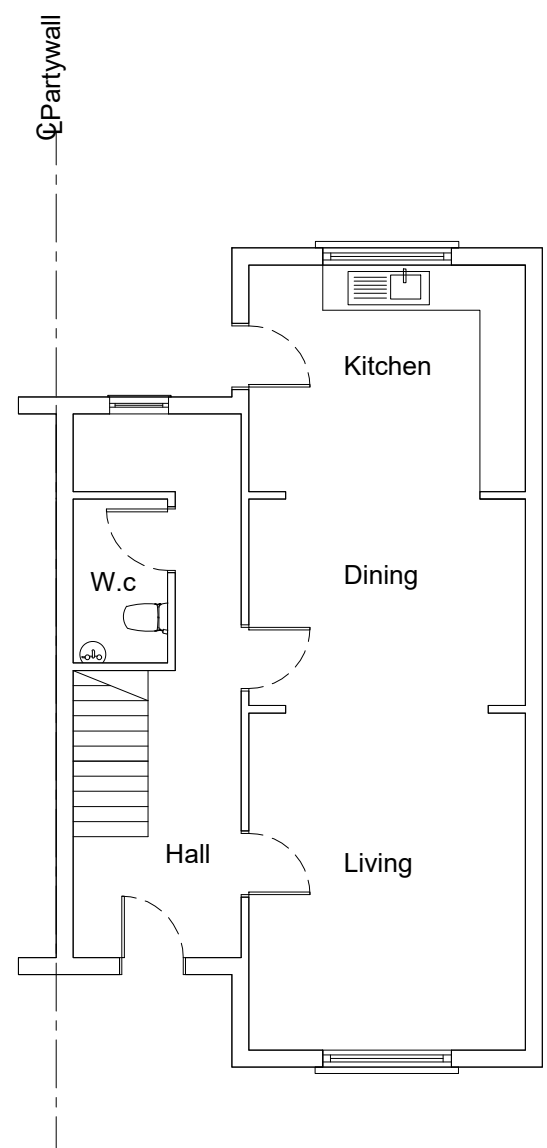


Pre-Existing Ground Floor Plan

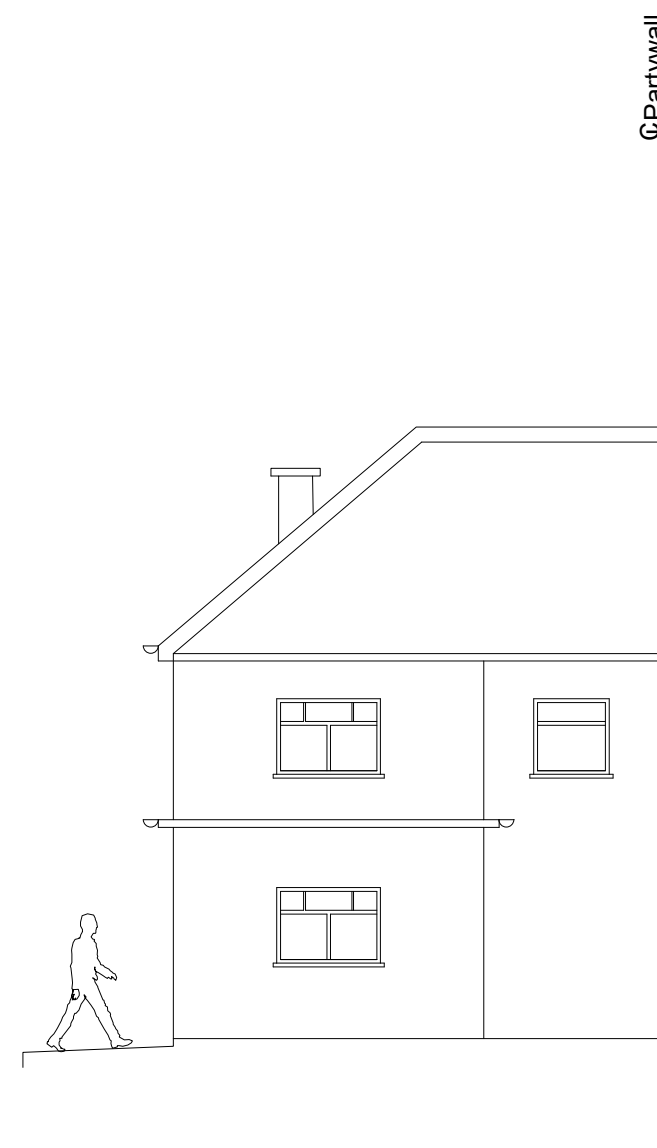


Pre-Existing Rear Elevation

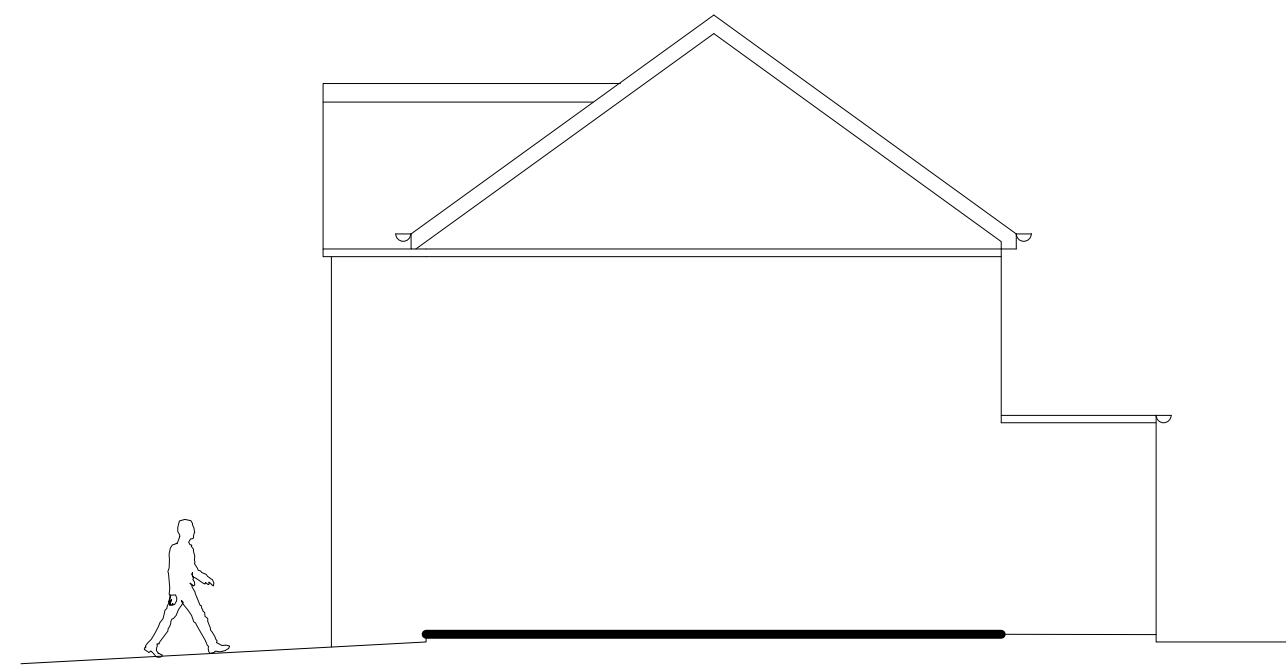


Pre-Existing Side Elevation

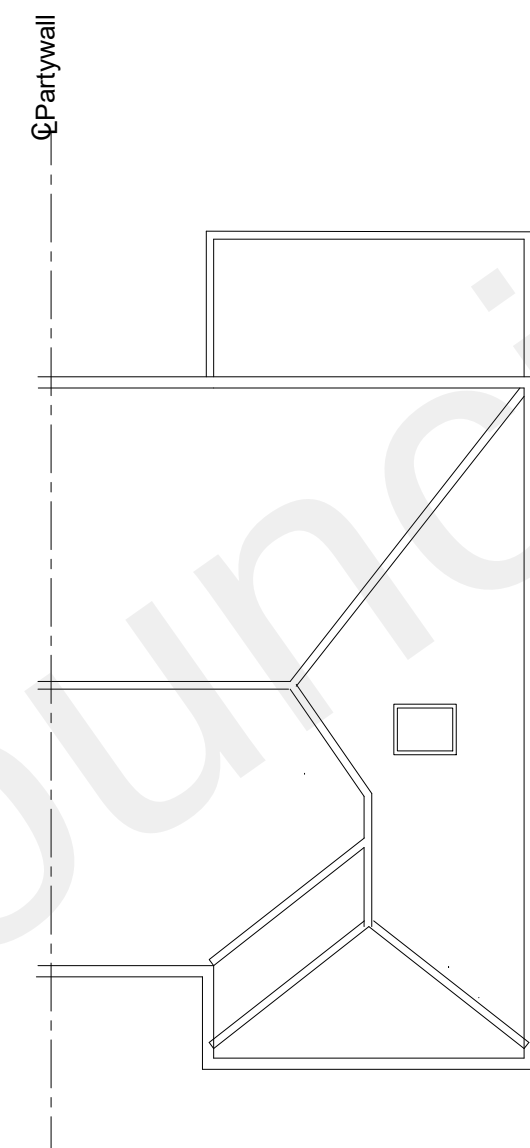


Pre-Existing Roof Plan

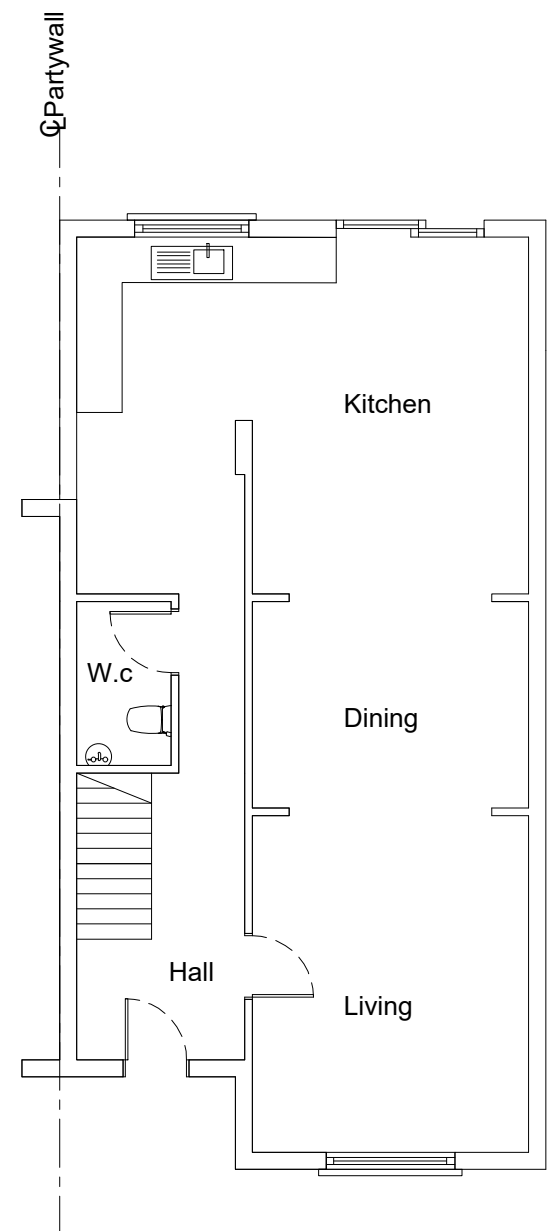


As Built Ground Floor Plan

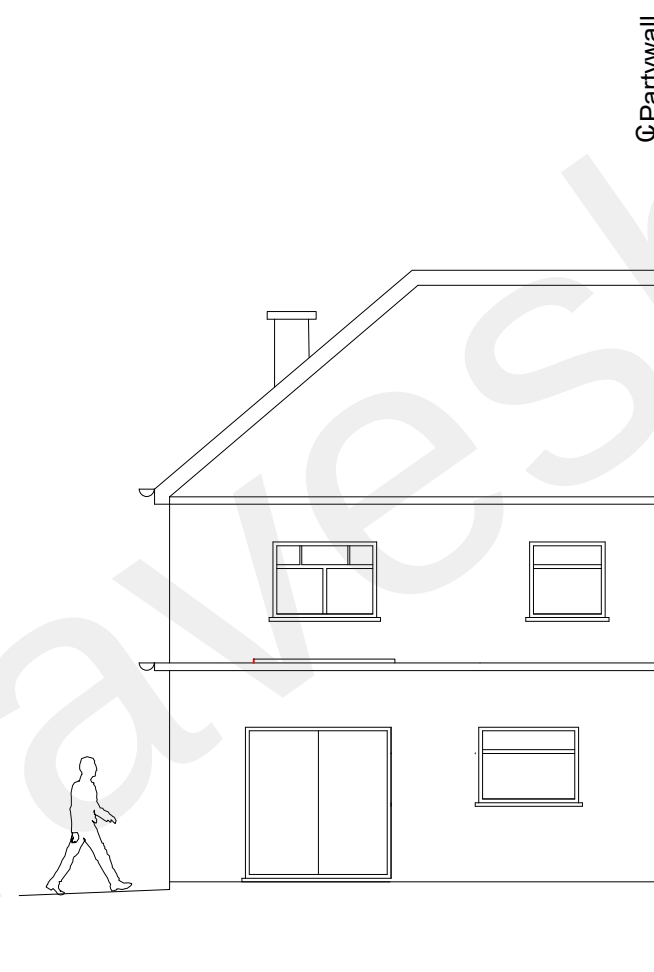


As Built Rear Elevation

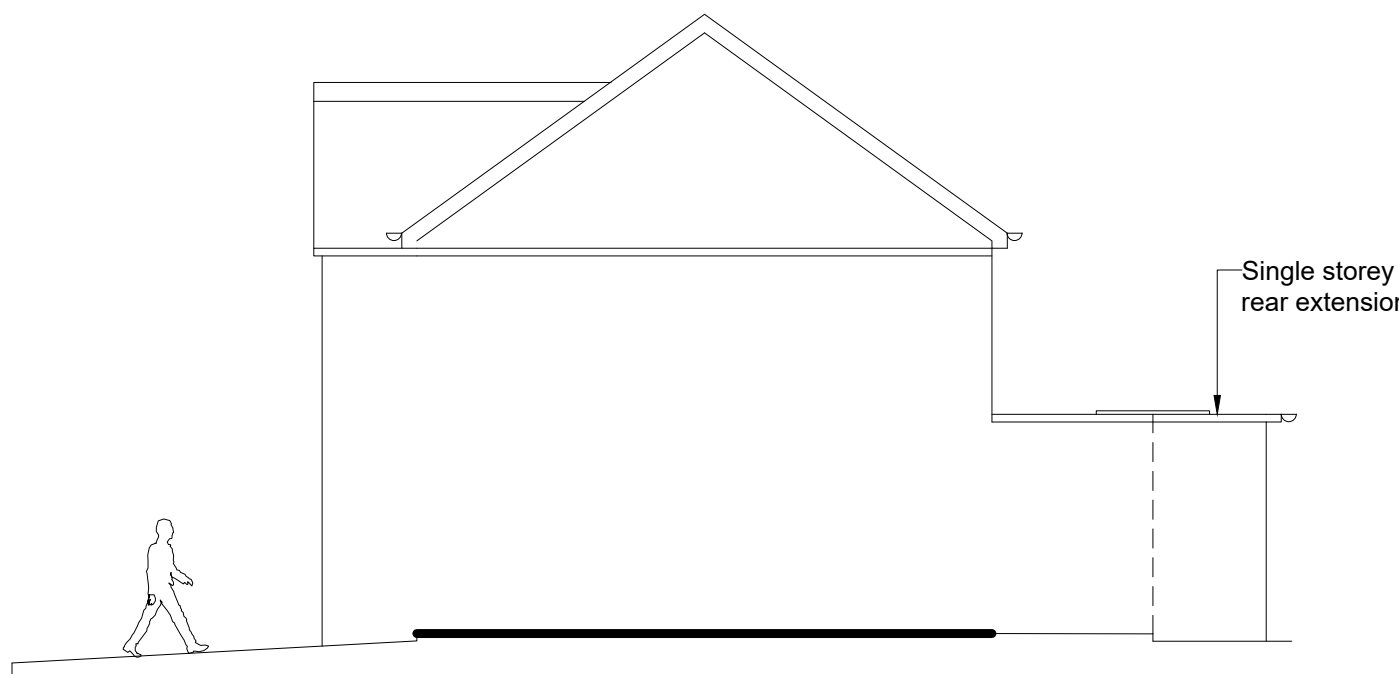

As Built Side Elevation

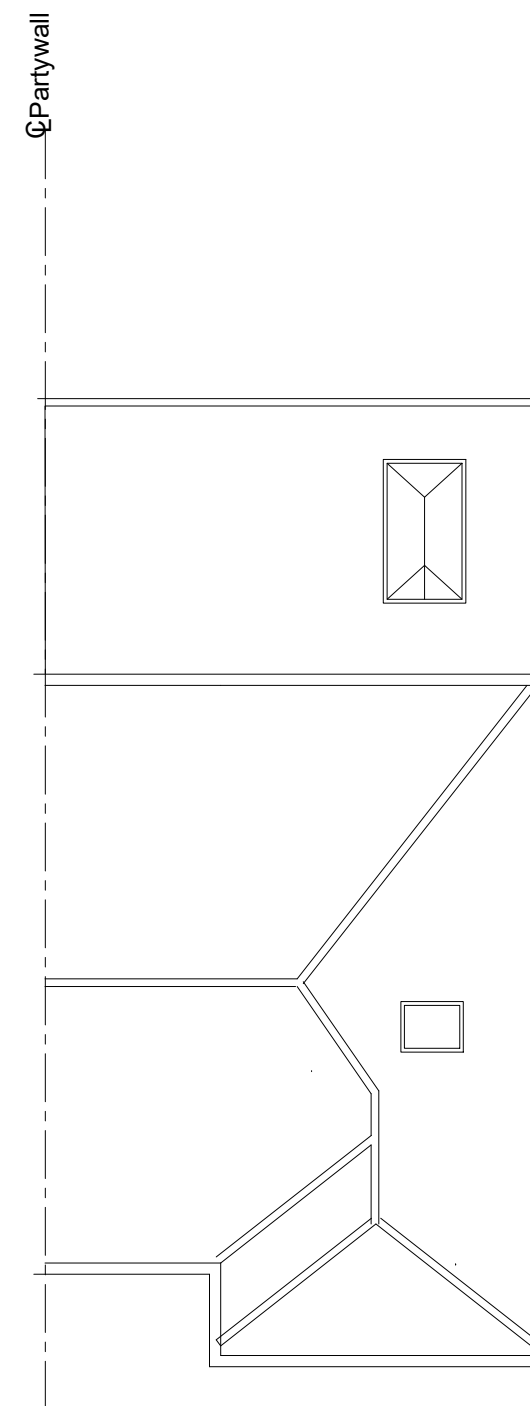

As Built Roof Plan

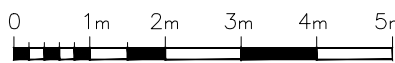

Retrospective
Application

BI	ISSUED TO GRAVESHAM		MC
Rev		Date	By


www.designerplan.co.uk
OFFICE 48, 95 WILTON ROAD, VICTORIA, LONDON, SW1V 1BZ
T: 07940121222

Job Title
152 Lower Higham Rd, DA12 2NN

Drawing Title
Single Storey Rear Extension

Scale 1:100 @ A1	Date Aug ` 22	Drawn By MC
Job No. 515-1000-990	Dwg No. P03	Rev P2