
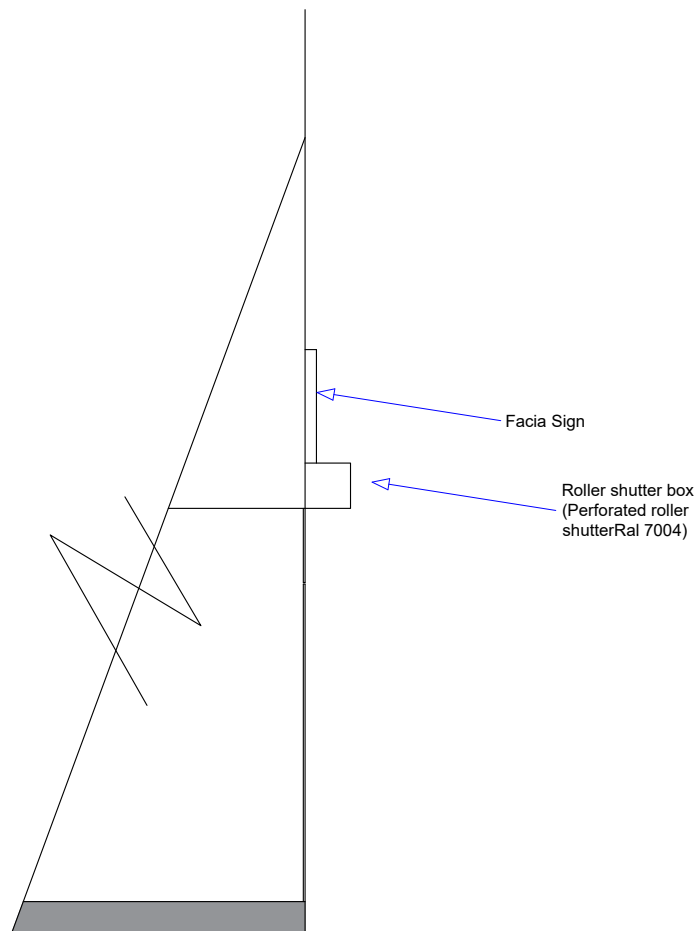
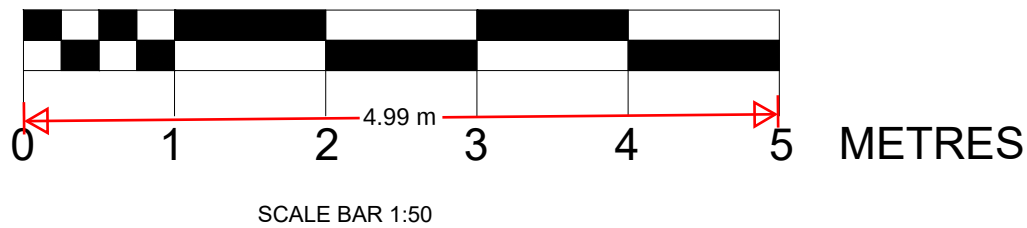


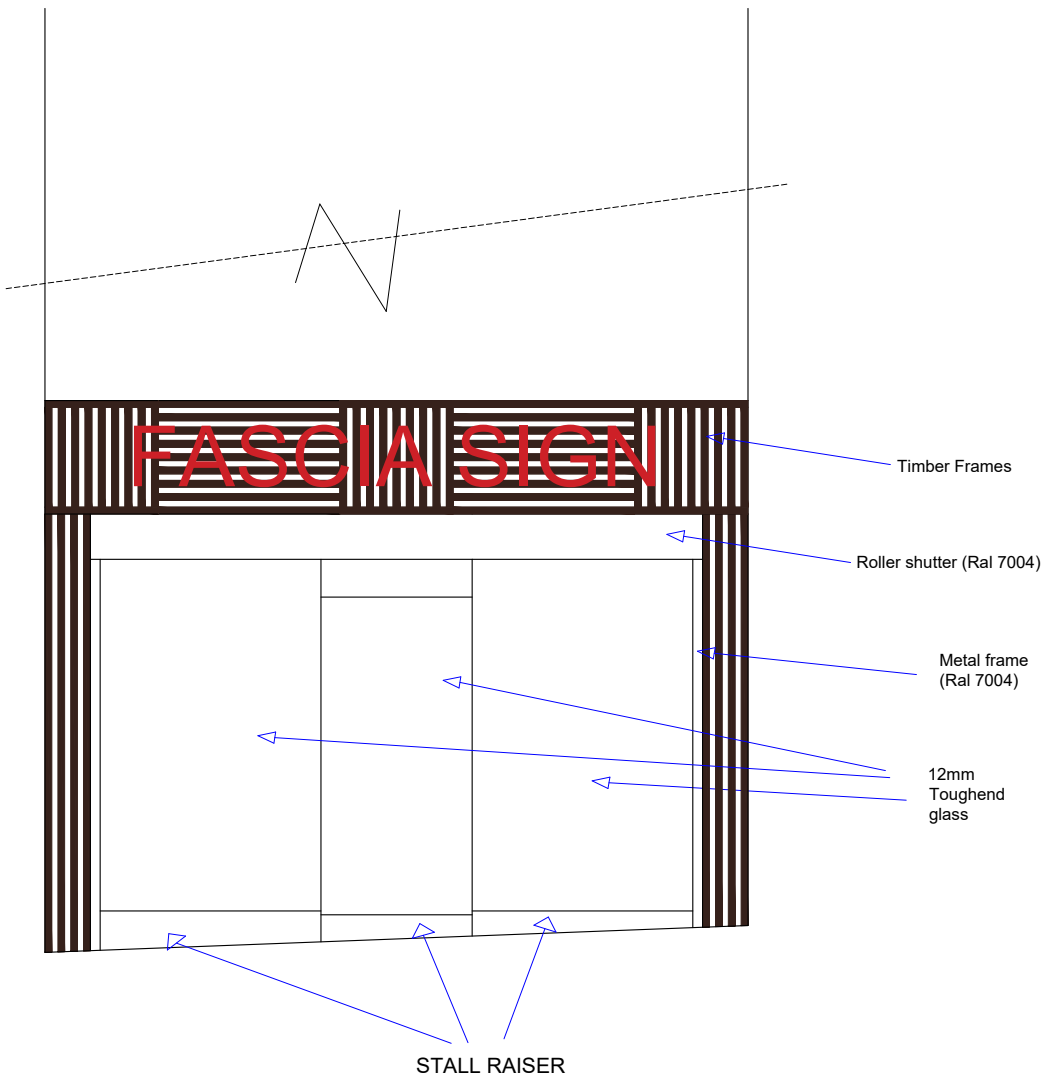

NOTES:
All dimensions are to be checked on site and measurements checked prior to works being carrier out.
Any works carried out prior to necessary approvals being obtained will be at the owner own risk and expense.
All the pictures are not in scale

Rev	Date	By	Chkd	Description

Client & Address
**30, QUEEN STREET,
GRAVESEND, DA12 2EE**

Project
**PROPOSED SHOP FRONT
INSTALLATION**



**KOVIL
CONSULTANCY**

KOVIL CONSULTANCY
172, Blackfen Road,
Sidcup, Kent
DA15 8PT
Mob: 07507236300
sutha@kovilgroups.co.uk

Scale : 1:50 @ A3	Date : 29/09/2025
-----------------------------	-----------------------------

Drawing Title :
ASBUILT SHOP FRONT

Drawing No : 7-DA12 2EQ- 000001	Rev. A 02
---	---------------------