
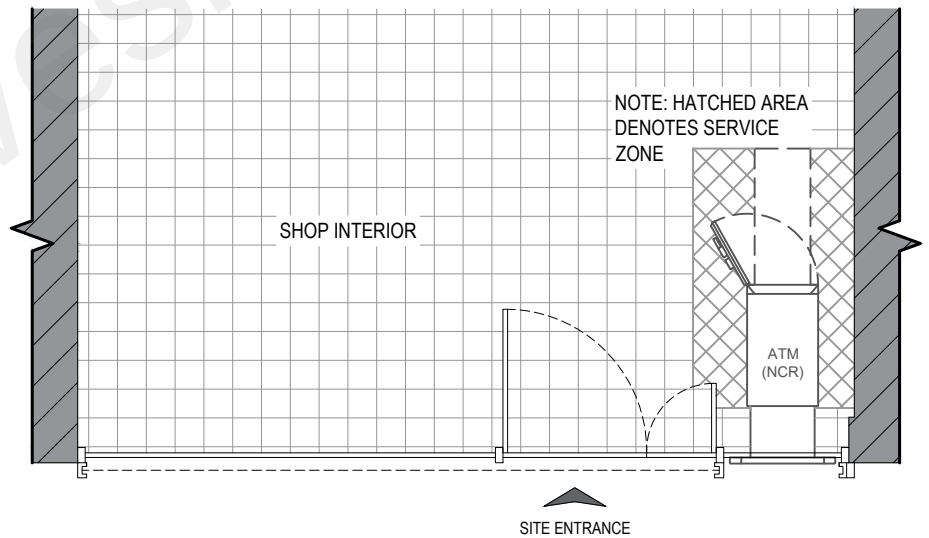
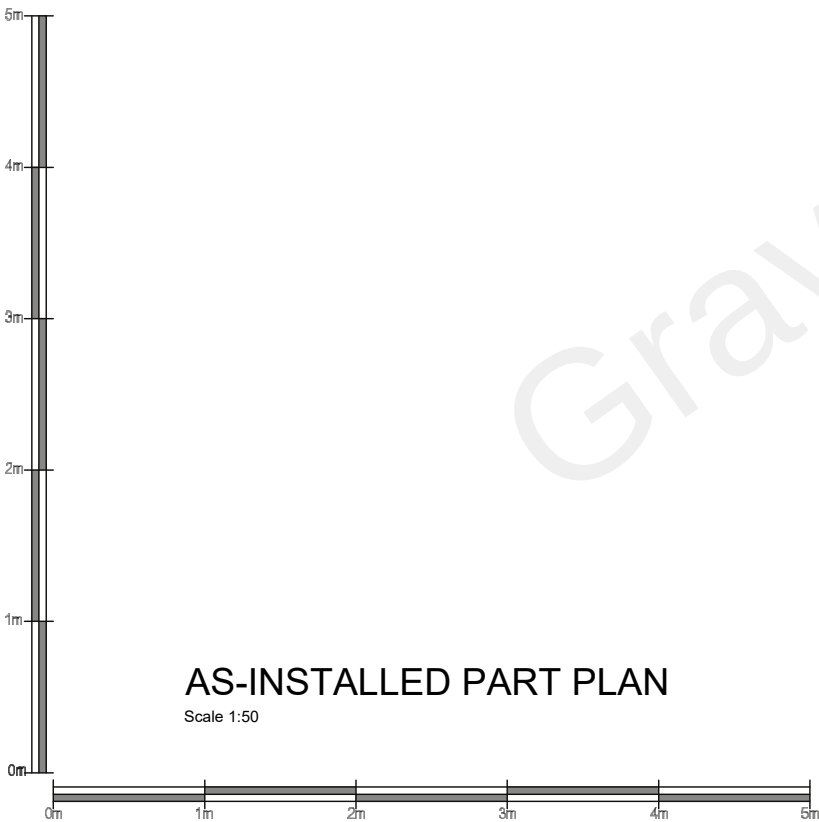


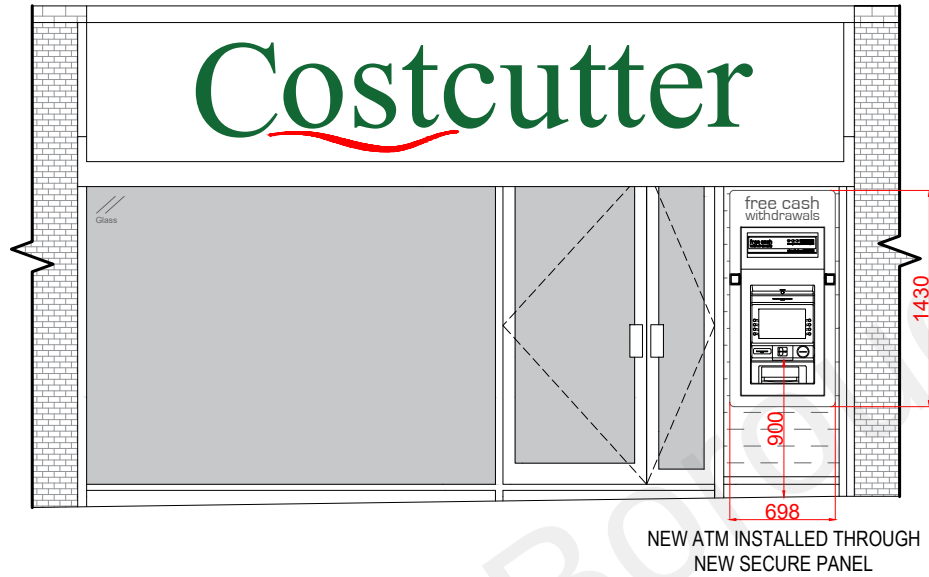

Date: Comments: By:

GENERAL NOTES:
1) All dimensions in millimeters unless otherwise stated.

Site:
Costcutter Rochester Road,
127 ROCHESTER ROAD,
GRAVESEND,
DA12 2HU

Drawing Title:
As-Installed Plan and Elevation

Ref: T020805_AI	Date: 11/02/2022	Rev:
Scale: 1:50	Paper: A3	Date Rev: