




PROPOSED GARAGE & OFFICE

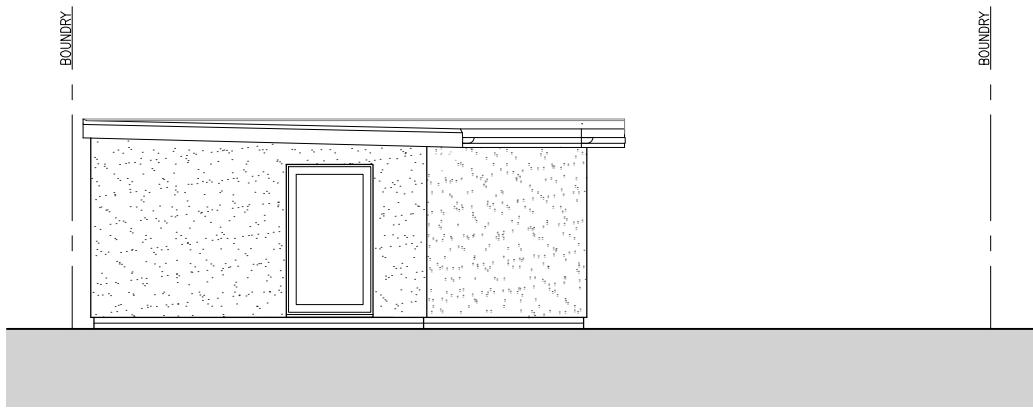


PROPOSED SIDE ELEVATION
1:100

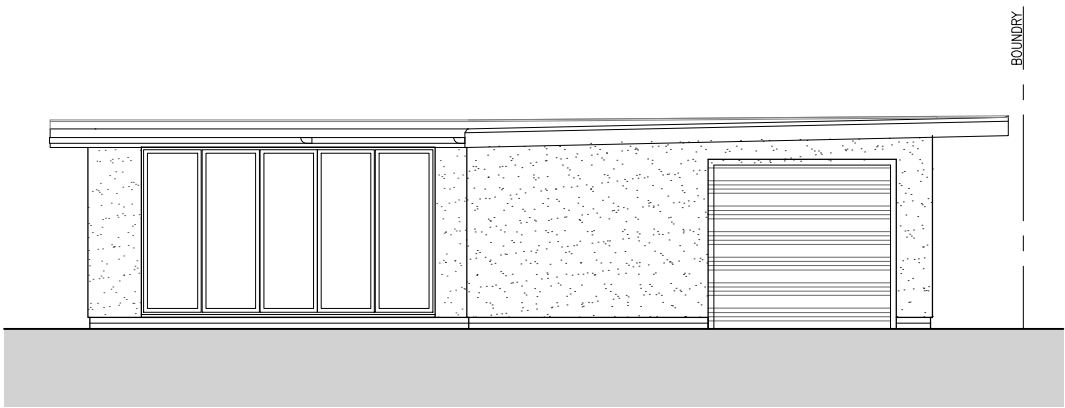


PROPOSED FRONT ELEVATION
1:100

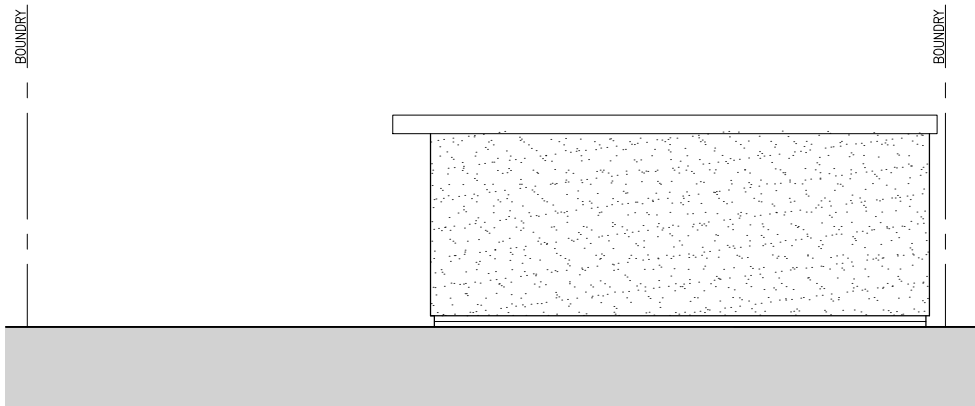


PROPOSED SIDE ELEVATION
1:100

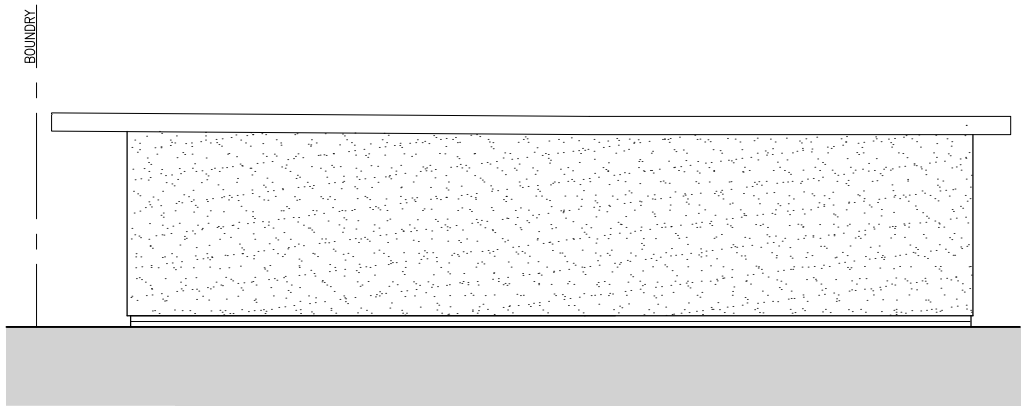

PROPOSED REAR ELEVATION
1:100

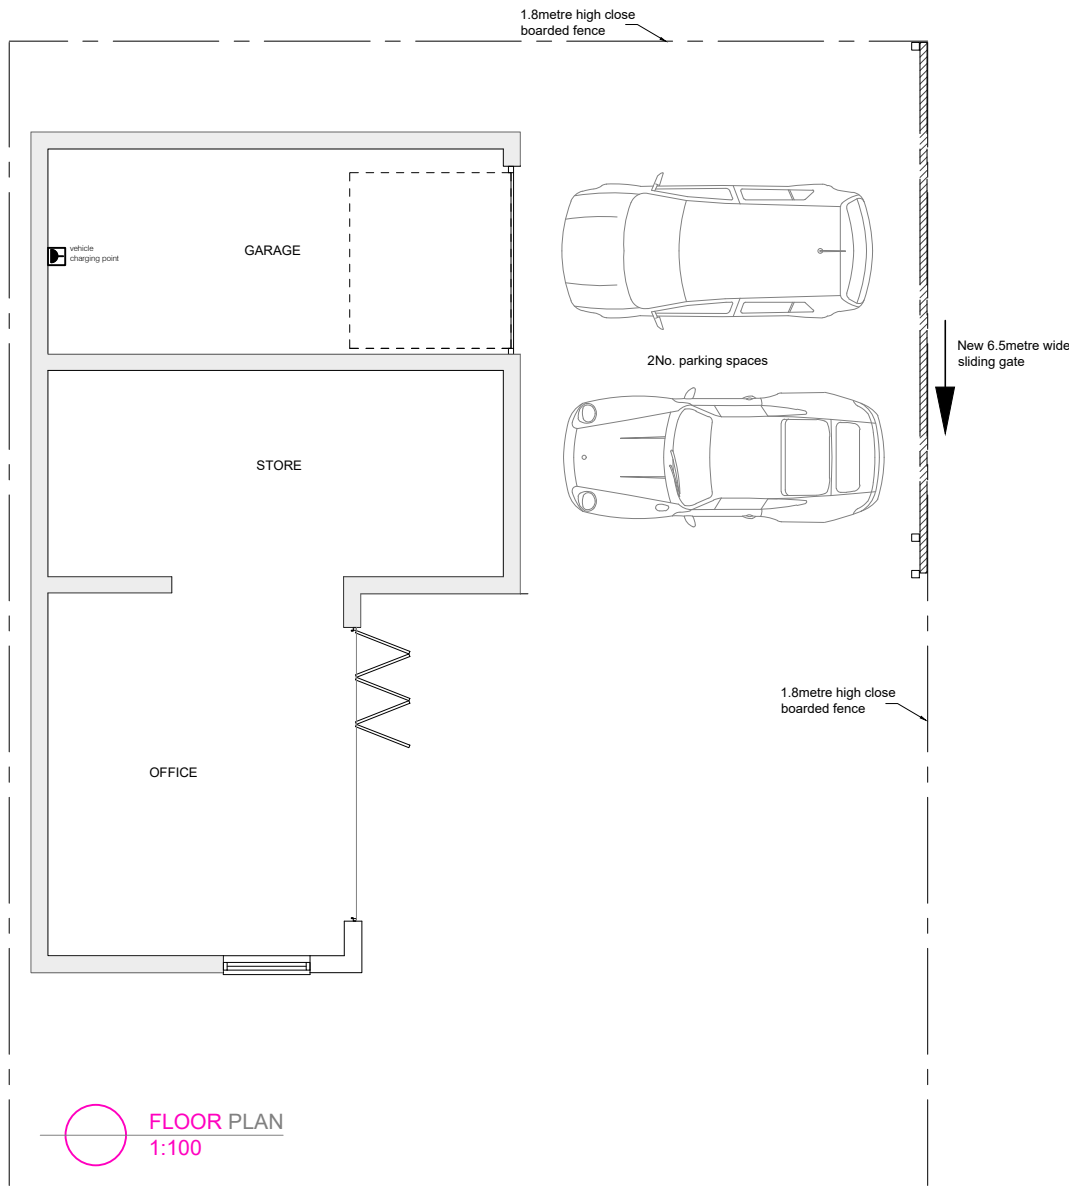

FLOOR PLAN
1:100

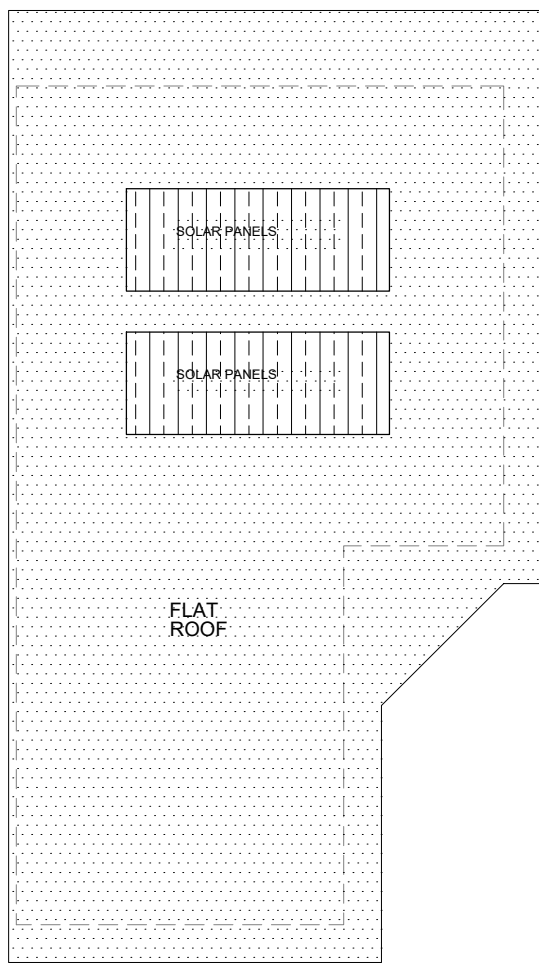

ROOF PLAN
1:100



Rev C Up-dated to as built so far and Client instruction
Rev B Carport removed and garage roof changed to flat roof

JOB TITLE		DRAWING TITLE		
196 LOWER HIGHAM ROAD		PROPOSED GARAGE AND OFFICE		
GRAVESEND		PLANS, ELEVATIONS & SECTION		
KENT DA12 2NN		SCALE 1:100@A2	DRAWING NUMBER BDS-LHR-P903	REVISION C
DATE DEC '20				

