




KEY:
Building/Bay Containing PbO
fitted with Flood Gate

Employee Work Area

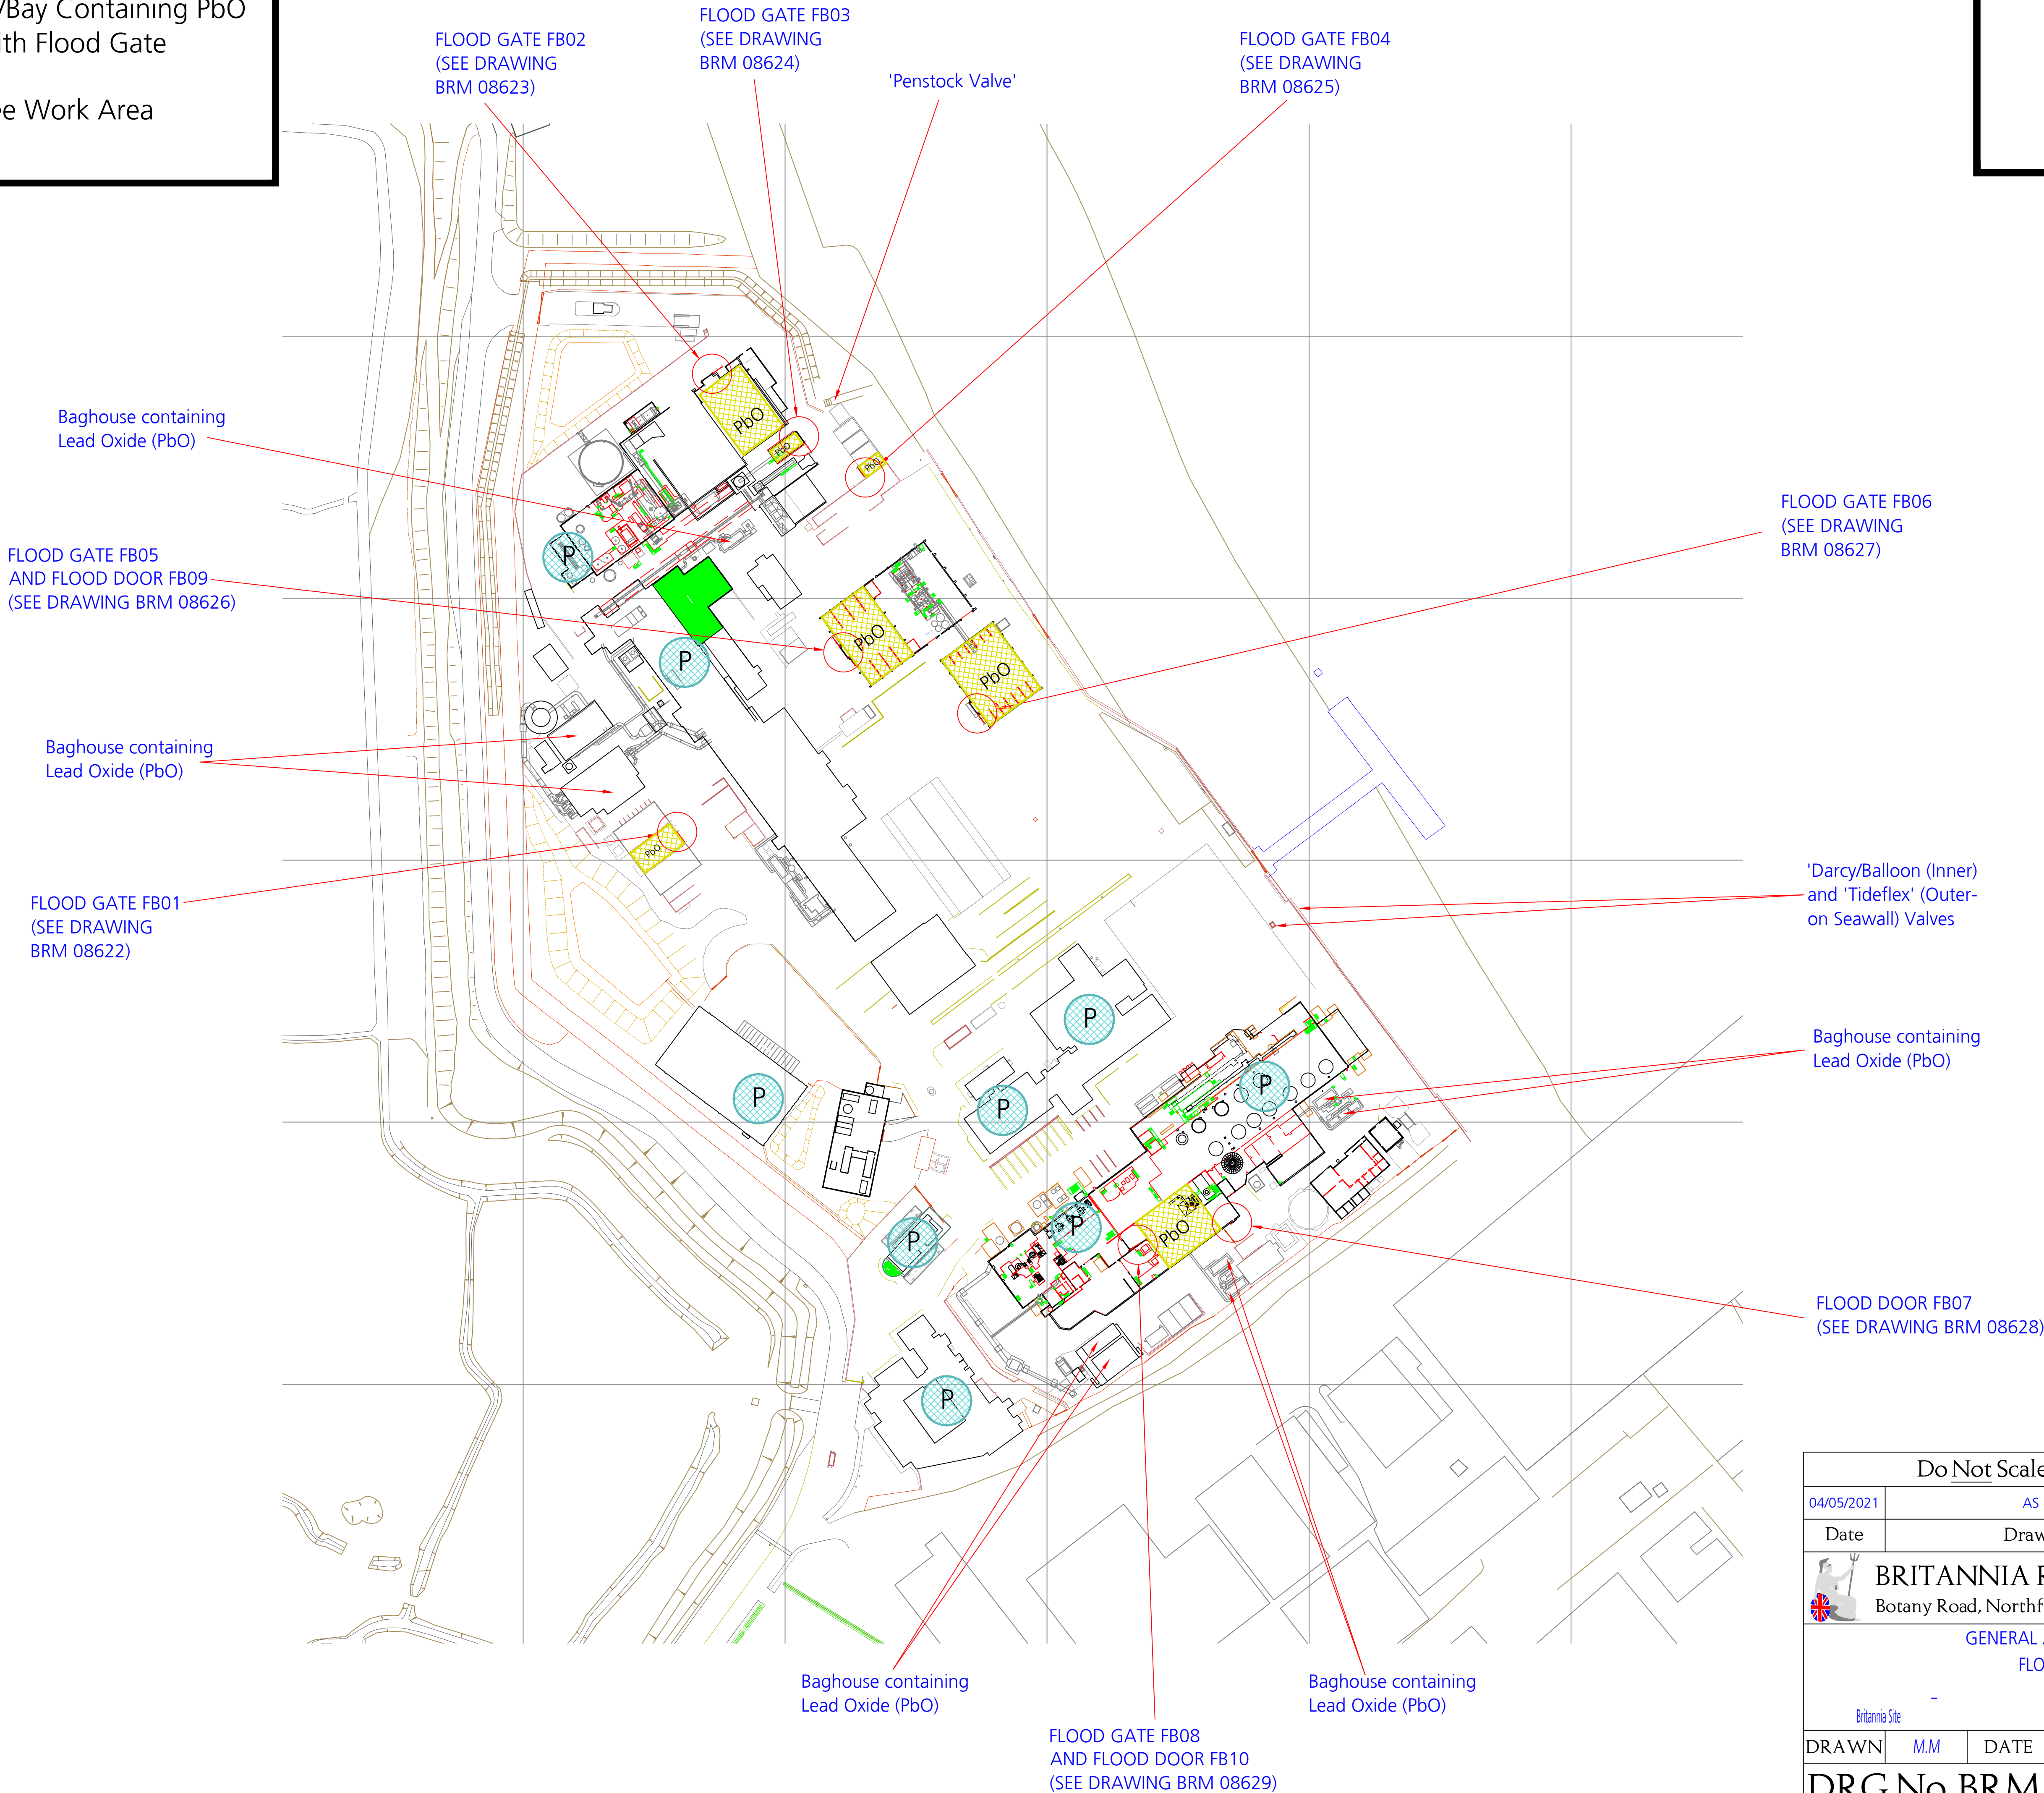

AutoCAD

Do <u>Not</u> Scale, If in Doubt Ask				
04/05/2021	AS INSTALLED			GW
Date	Drawing Status			By
 BRITANNIA REFINED METALS LTD. Botany Road, Northfleet, Kent, DA11 9BG.				
GENERAL ARRANGEMENT FLOOD GATE				
- -				
Britannia Site				
DRAWN	M.M	DATE	04/05/2021	SCALE (A1 ONLY)
				1: 1000
DRG No BRM 08621 B				