


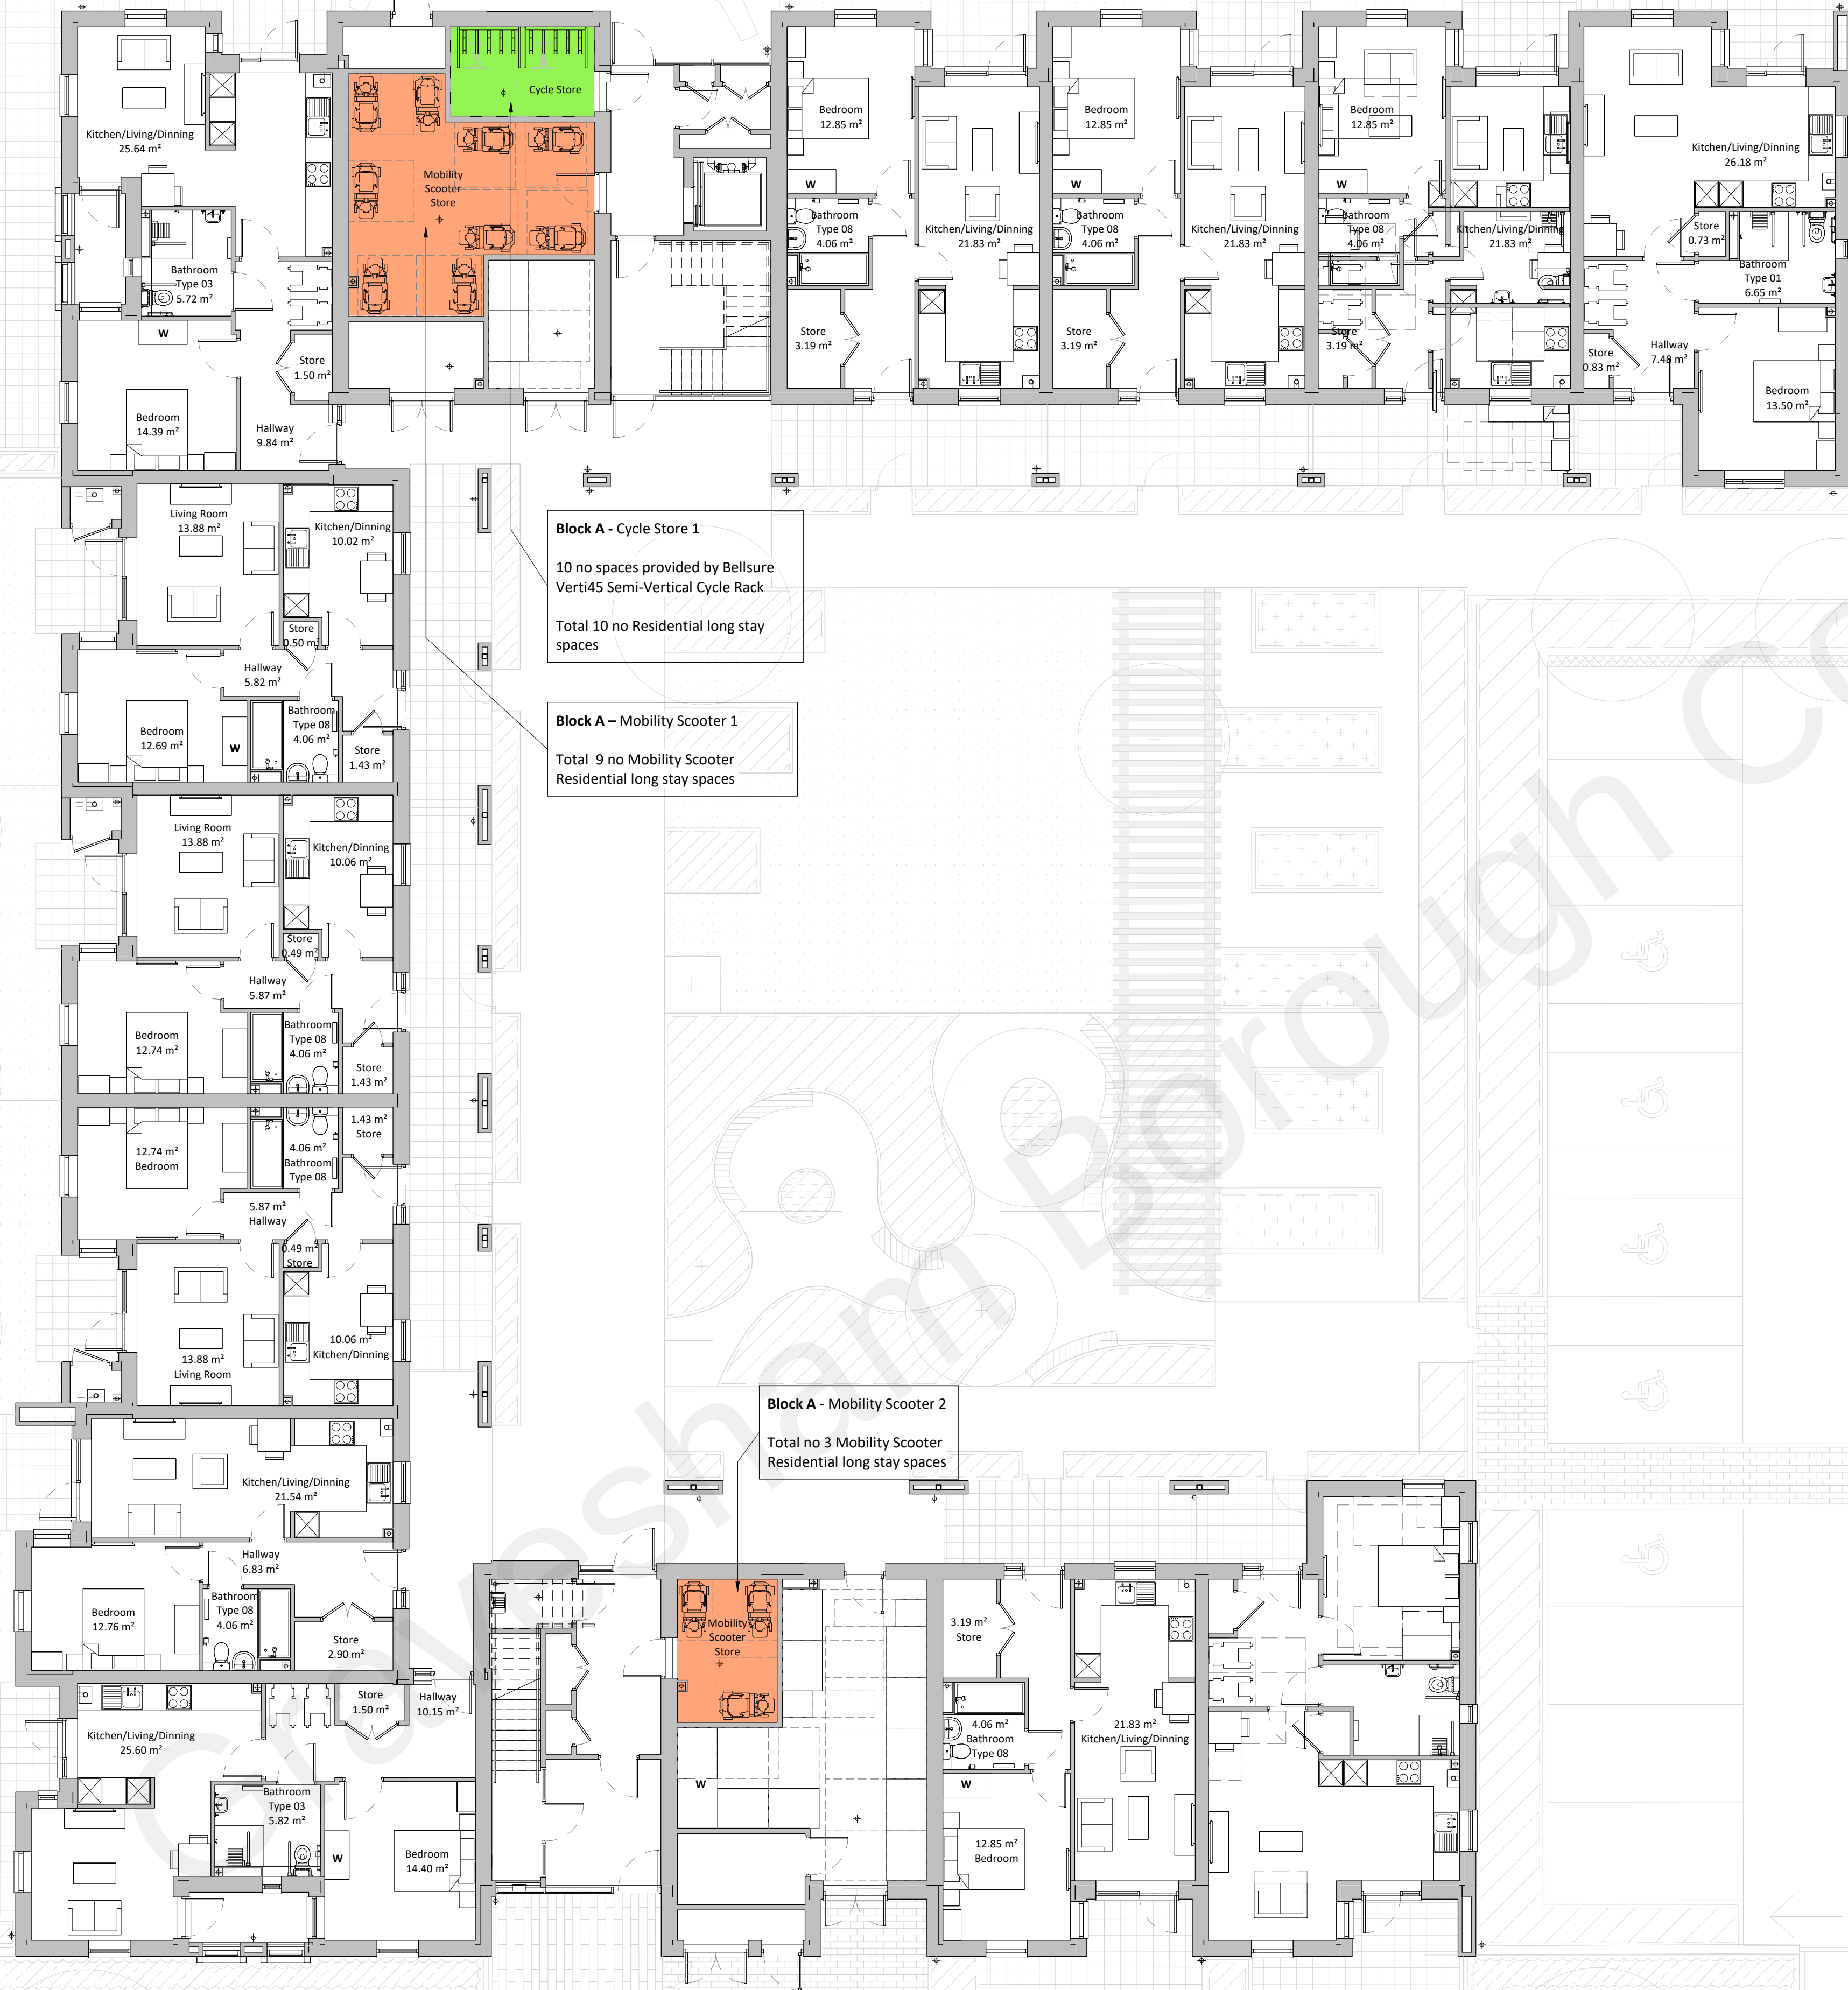

KEY	
	Residents cycle store
	Mobility Scooter

Gravesham Borough Council provisional requirements:	
Long Stay - 1 per unit	
Short Stay - n/a	
Valley Drive Block A communal cycle store:	
Long Stay - 10 long stay cycle spaces total:	
10 no Bellsure Verti45 Semi-Vertical Cycle Rack (located within secure cycle parking at ground)	
Mobility Scooter - 12 long stay mobility scooter spaces (located within secure parking ground)	
Door Security - key access by residents (request basis)	

TO BE READ IN CONJUNCTION WITH DRAWINGS	
FOR SITE SETTING OUT AND BUILDING COORDINATES REFER TO DRAWINGS 0100 SERIES	
FOR GA FURNITURE LAYOUTS REFER TO DRAWING 1500 SERIES	
TO BE READ IN CONJUNCTION WITH WALLER GRAY STRUCTURAL DRAWINGS	
TO BE READ IN CONJUNCTION WITH M&E CONSULTANTS DRAWINGS	
TO BE READ IN CONJUNCTION WITH LANDSCAPE ARCHITECT DRAWINGS	
ALL DRAWINGS TO BE READ IN CONJUNCTION WITH FIRE REPORT	
ALL DIMENSIONS IN MILLIMETERS	
ALL DIMENSIONS TO STRUCTURE	

Notes:
Do not scale. All dimensions are in millimetres unless otherwise stated. This drawing should be read in conjunction with all relevant project information and contract documentation. All dimensions to be checked prior to fabrication and or commencement of works. All works to comply with all relevant legal standards, building regulations and warranty provider requirements. Report any discrepancies, if in doubt ask.

Revisions:				Rev.	Chkd.
Rev	Status	Date	Description		
PROJ	S3	14.08.20	Preliminary Issue	CO	
CD1	CR	14.03.22	As Built Issue	TL	

Client Name:		Westridge	
Project Name:		Valley Drive	
Drawing Name:		Cycle Strategy Block A	
Drawing Number:		VDR-BPTW-04-00-DR-A-6201	
Project No:		19-251	
RIBA Stage:		CO	
Rev:		CD1	
Status:		CR	
Drawn By:			
Scale:		1:100 @ A1	

AS BUILT

40 Norman Road,
Greenwich, London
SE10 9GX
t 020 8293 5175
bptw.co.uk

