
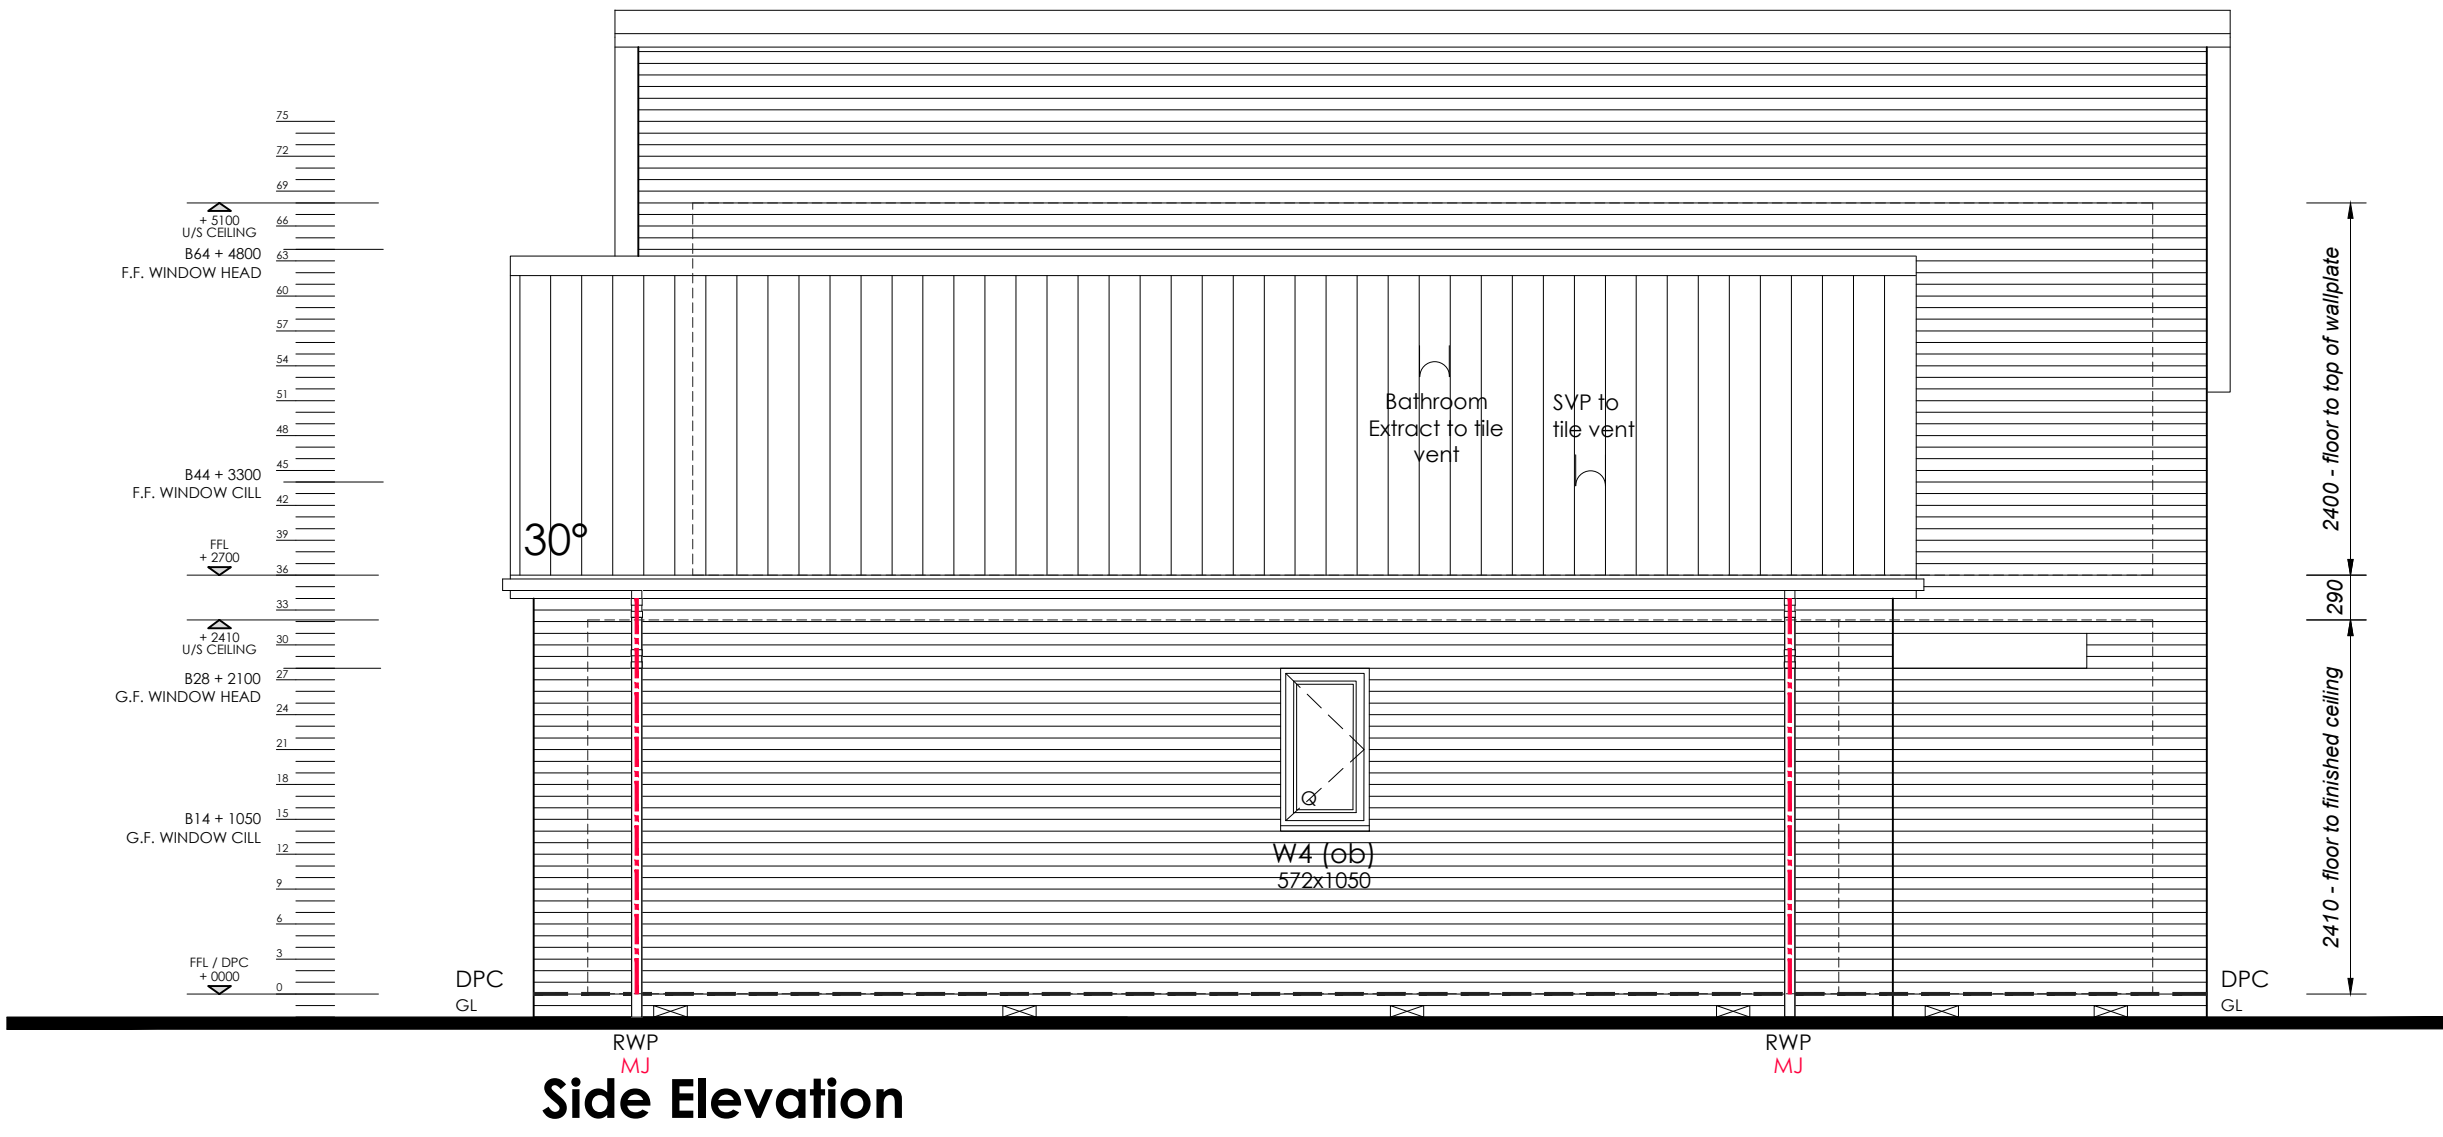
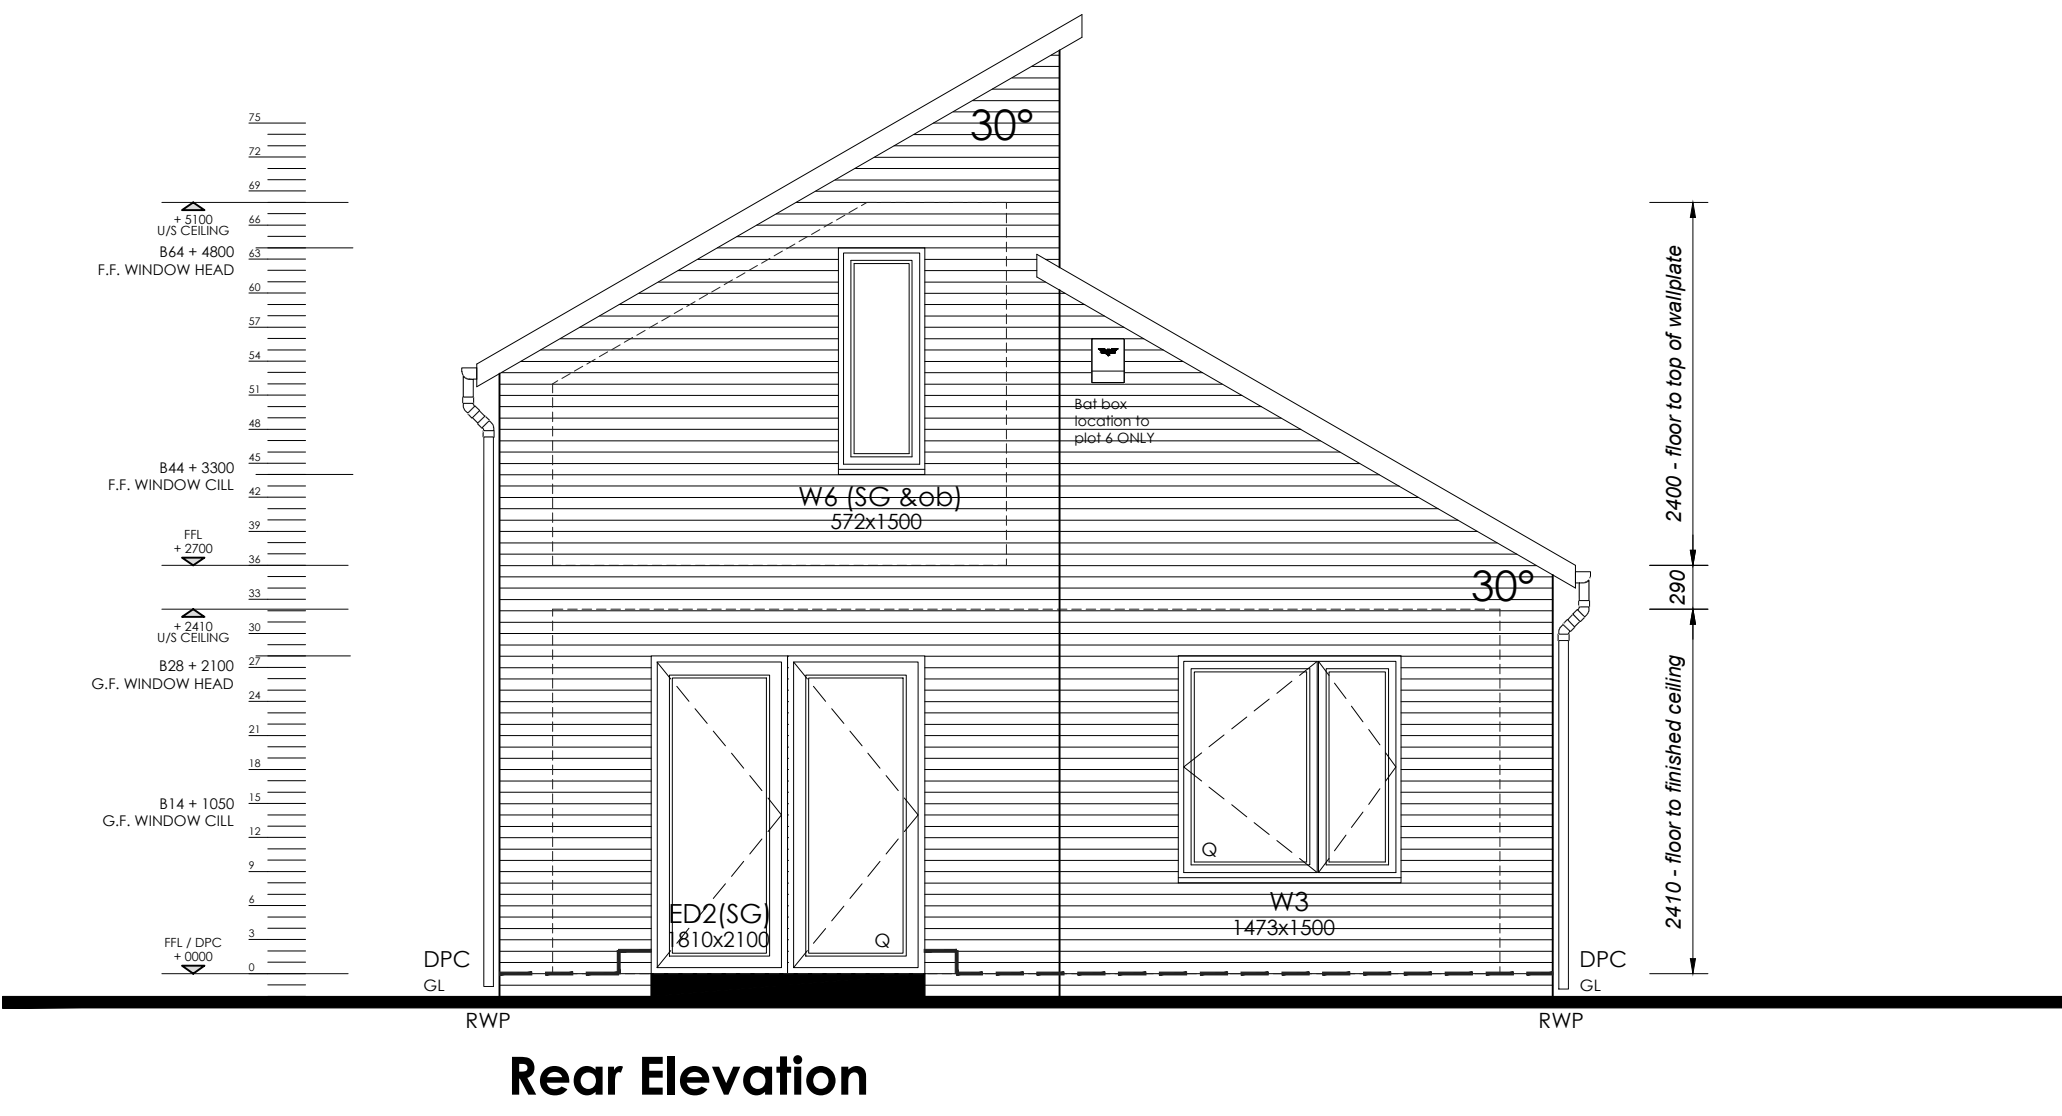
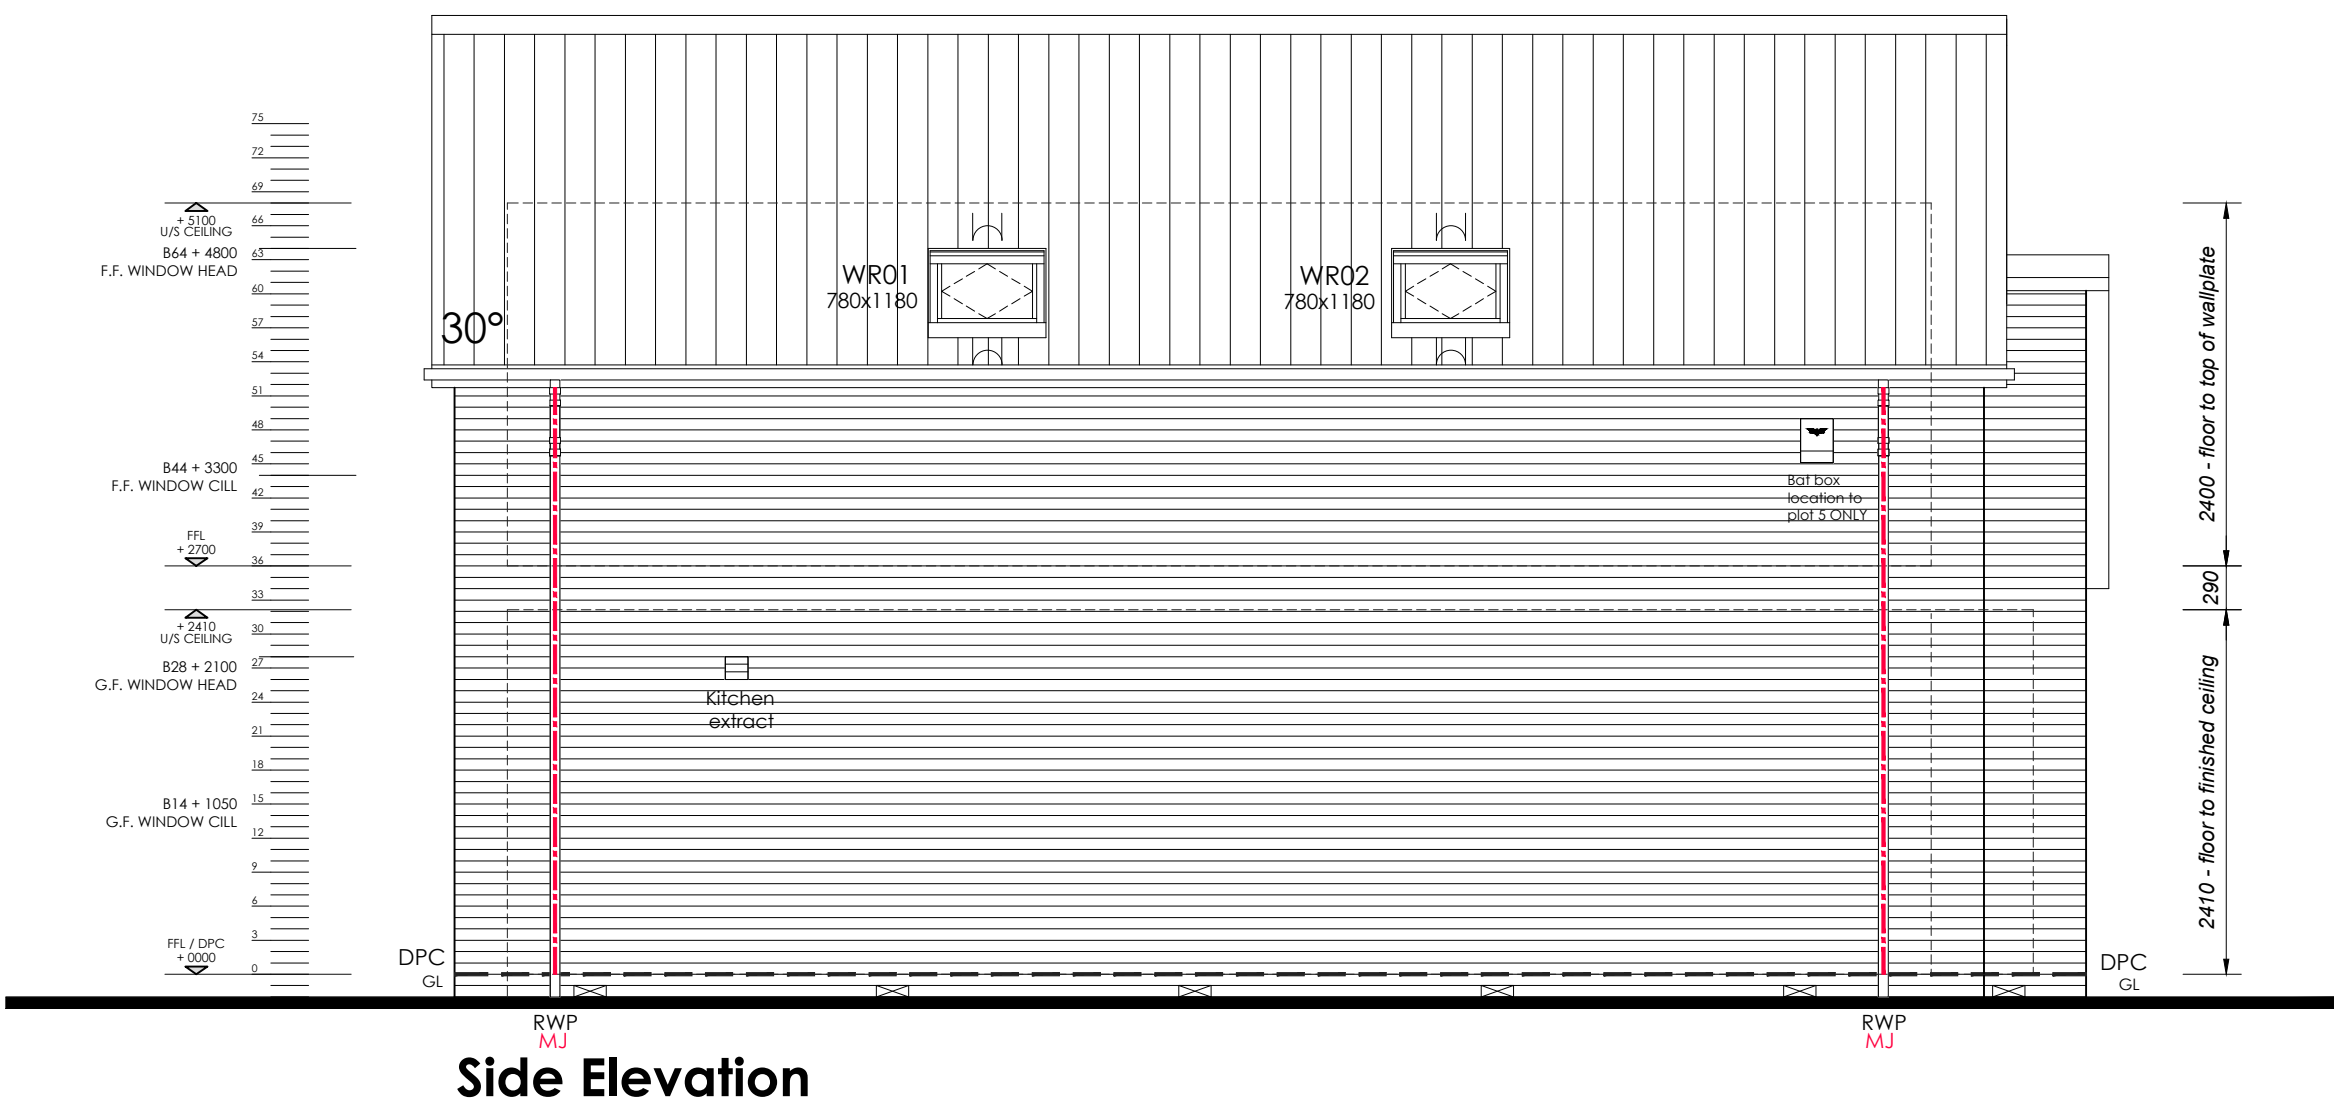



PLOTS 5 & 6
ELEVATIONS

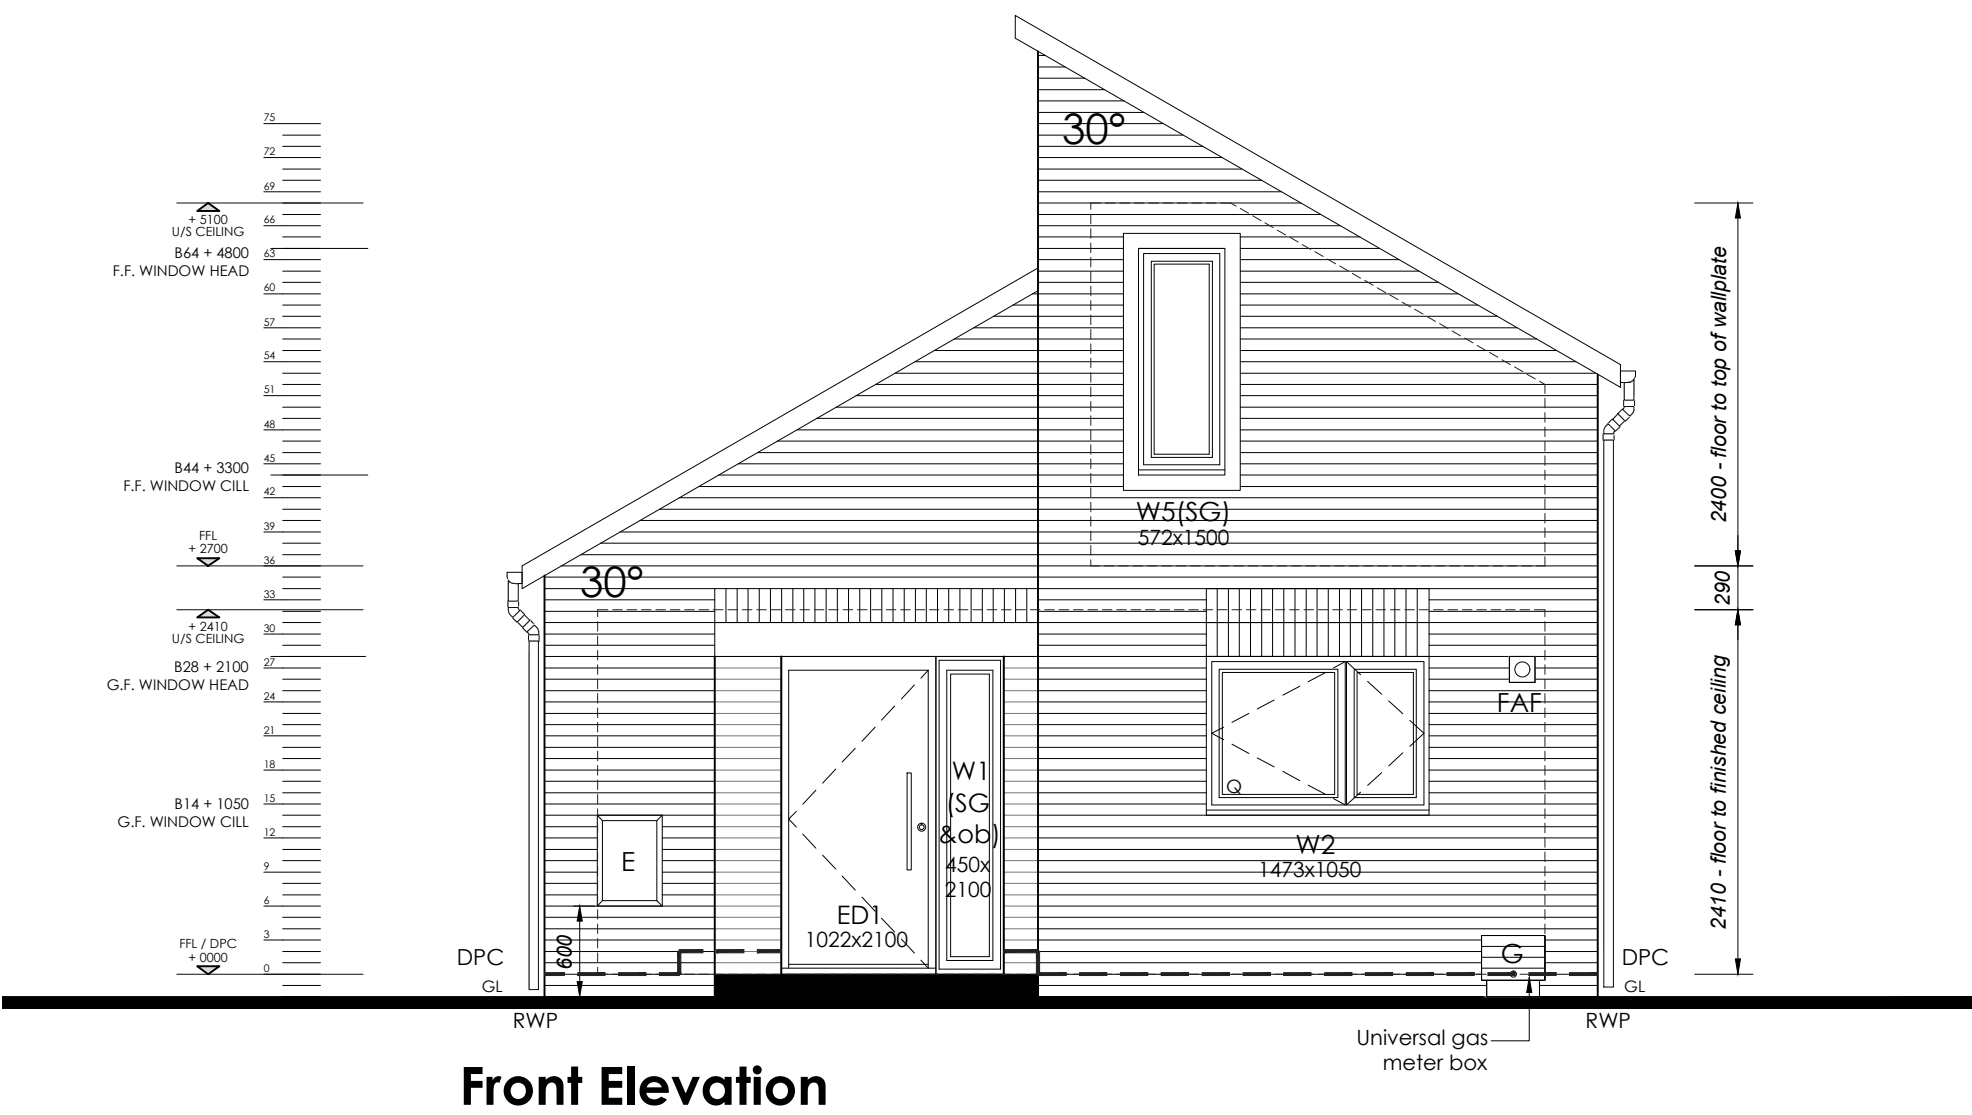

ELEVATION LEGEND	
MJ	Movement Joint
RWP	Rainwater pipe - 63mm diameter
SG	Safety glass
OB	Obscure glass to inner pane only
BF	Boiler flue terminal. To be located at a minimum 300mm from any openable window or internal corner
FAF	Boiler flue terminal. To be located at a minimum 300mm from any openable window or internal corner
SVP	SVP file vent at head of drain run, bathroom extract or en-suite extract
Bathroom / WC/ Kitchen extract	Bathroom / WC/ Kitchen extract
External meter cabinet for either electric meter or gas meter	External meter cabinet for either electric meter or gas meter

External Opening Schedule Plots 5 & 6					
opening reference	opening size	lintel type	lintel size	no. of trickle vents	note
W1 TV ob SG	450 x 2100	L1	See ED1	1	
W2 TV Q	1473 x 1050	L1	1800	2	
W3 TV Q #	1473 x 1500	L1	1800	2	
W4 TV Q ob	572 x 1050	L1	900	1	
W5 TV SG	572 x 1500	L1	900	1	Fixed Shut Planning con.
W6 TV ob SG	572 x 1500	L1	900	1	Fixed Shut Planning con.
WR1 TV	780 x 1180	N/A	N/A	1	
WR2 TV	780 x 1180	N/A	N/A	1	
ED1 Q SG	1022 x 2100		1800	NR	
ED2 TV Q SG	1810 x 2100		2250	2	

NB: ALL LINTELS TO HAVE A MINIMUM OF 150MM BEARING
Egress hinges for escape
SG Safety glass to windows and doors
ob Obscure glazing
Q Ensure compliance with the requirements of Approved Document Q
TV Background Ventilation - 4800mm2/vent
BF Bifold doors
FOR LINTEL REFS, REFER TO MANUFACTURERS SCHEDULE

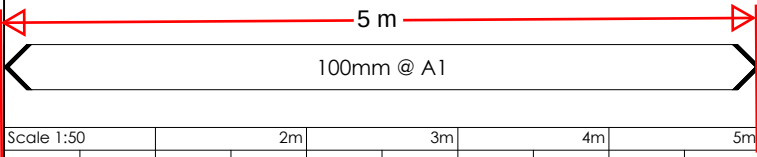


DRAWING STATUS:

AS BUILT

GENERAL NOTES

- DO NOT SCALE
- All dimensions are in millimeters unless stated otherwise

C2A	Bat boxes added as per Ecologist's report.	RB	10/07/24
C2	As built drawing issue.	RB	03/06/24
C1B	Large window opening sash correctly amended back to side hung on W2 & W3.	RB	29/09/23
C1A	Large window opening sash amended to top hung as manufacturers request	MG	22/03/23
C1	Construction issue. W1 updated to be obscure glazing as HA's comments & schedule amended to match. S.E info added.	RB	13/06/22
REV	AMENDMENTS	BY	DATE

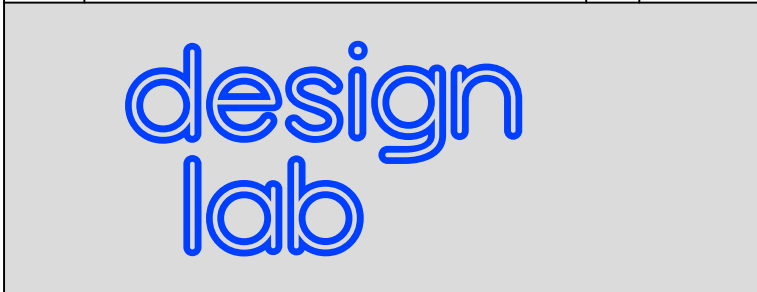

Architectural Design Lab Ltd.
Lombard House
12 - 17 Upper Bridge Street
Canterbury
Kent
CT1 2NF
Tel. no : 01227 634600
Email : mail@adl15.com

Drawn : RB	Date : APRIL 2022
Scale : 1:50@A1	Checked : MG

Title : PLOTS 5 & 6 ELEVATIONS	
Job : LAND AT ARMOURY DRIVE, GRAVESEND, KENT, DA12 1NB	Rev : C2A
Dwg file name: 2202-B-007	A1
Copyright Reserved Architectural Design Lab Ltd.	