
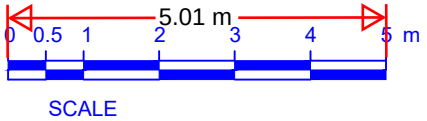


NOTES
DRAWING SHOWING AS BUILT
STREET SCENE. BUILDING IS
400MM BELOW THE AS APPROVED
BUILT LINE.

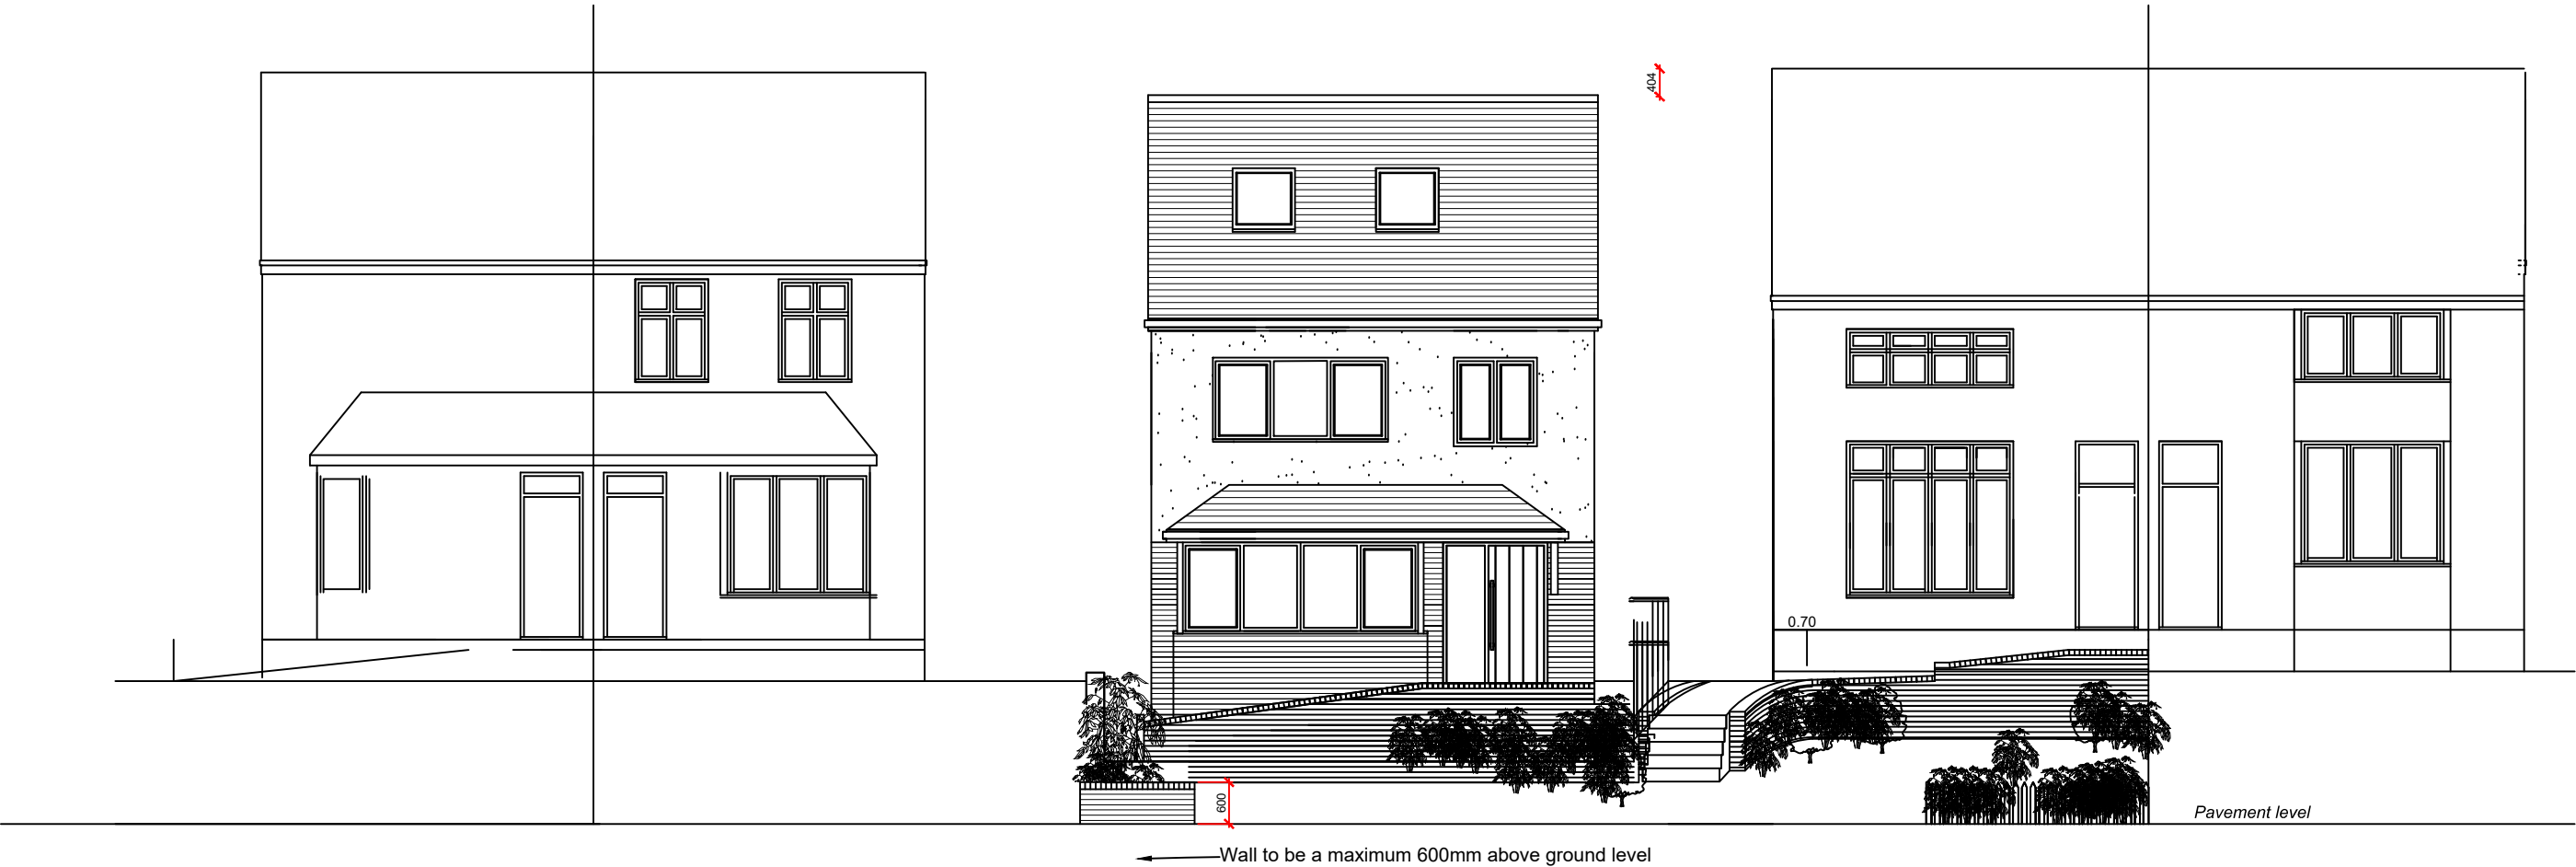

S HANS PAL BSc MRICS

PROJECT
NEW HOUSE
FOR MR JOHAL

ADDRESS
LAND BETWEEN
53 AND 55 FORGE LANE
HIGHAM KENT ME3 7AH

DWG No.	SCALE	DATE
FLP.04	1:100 @ A3	DEC 2023