



NOTES
DRAWING SHOWING AS BUILT
CROSS SECTION.

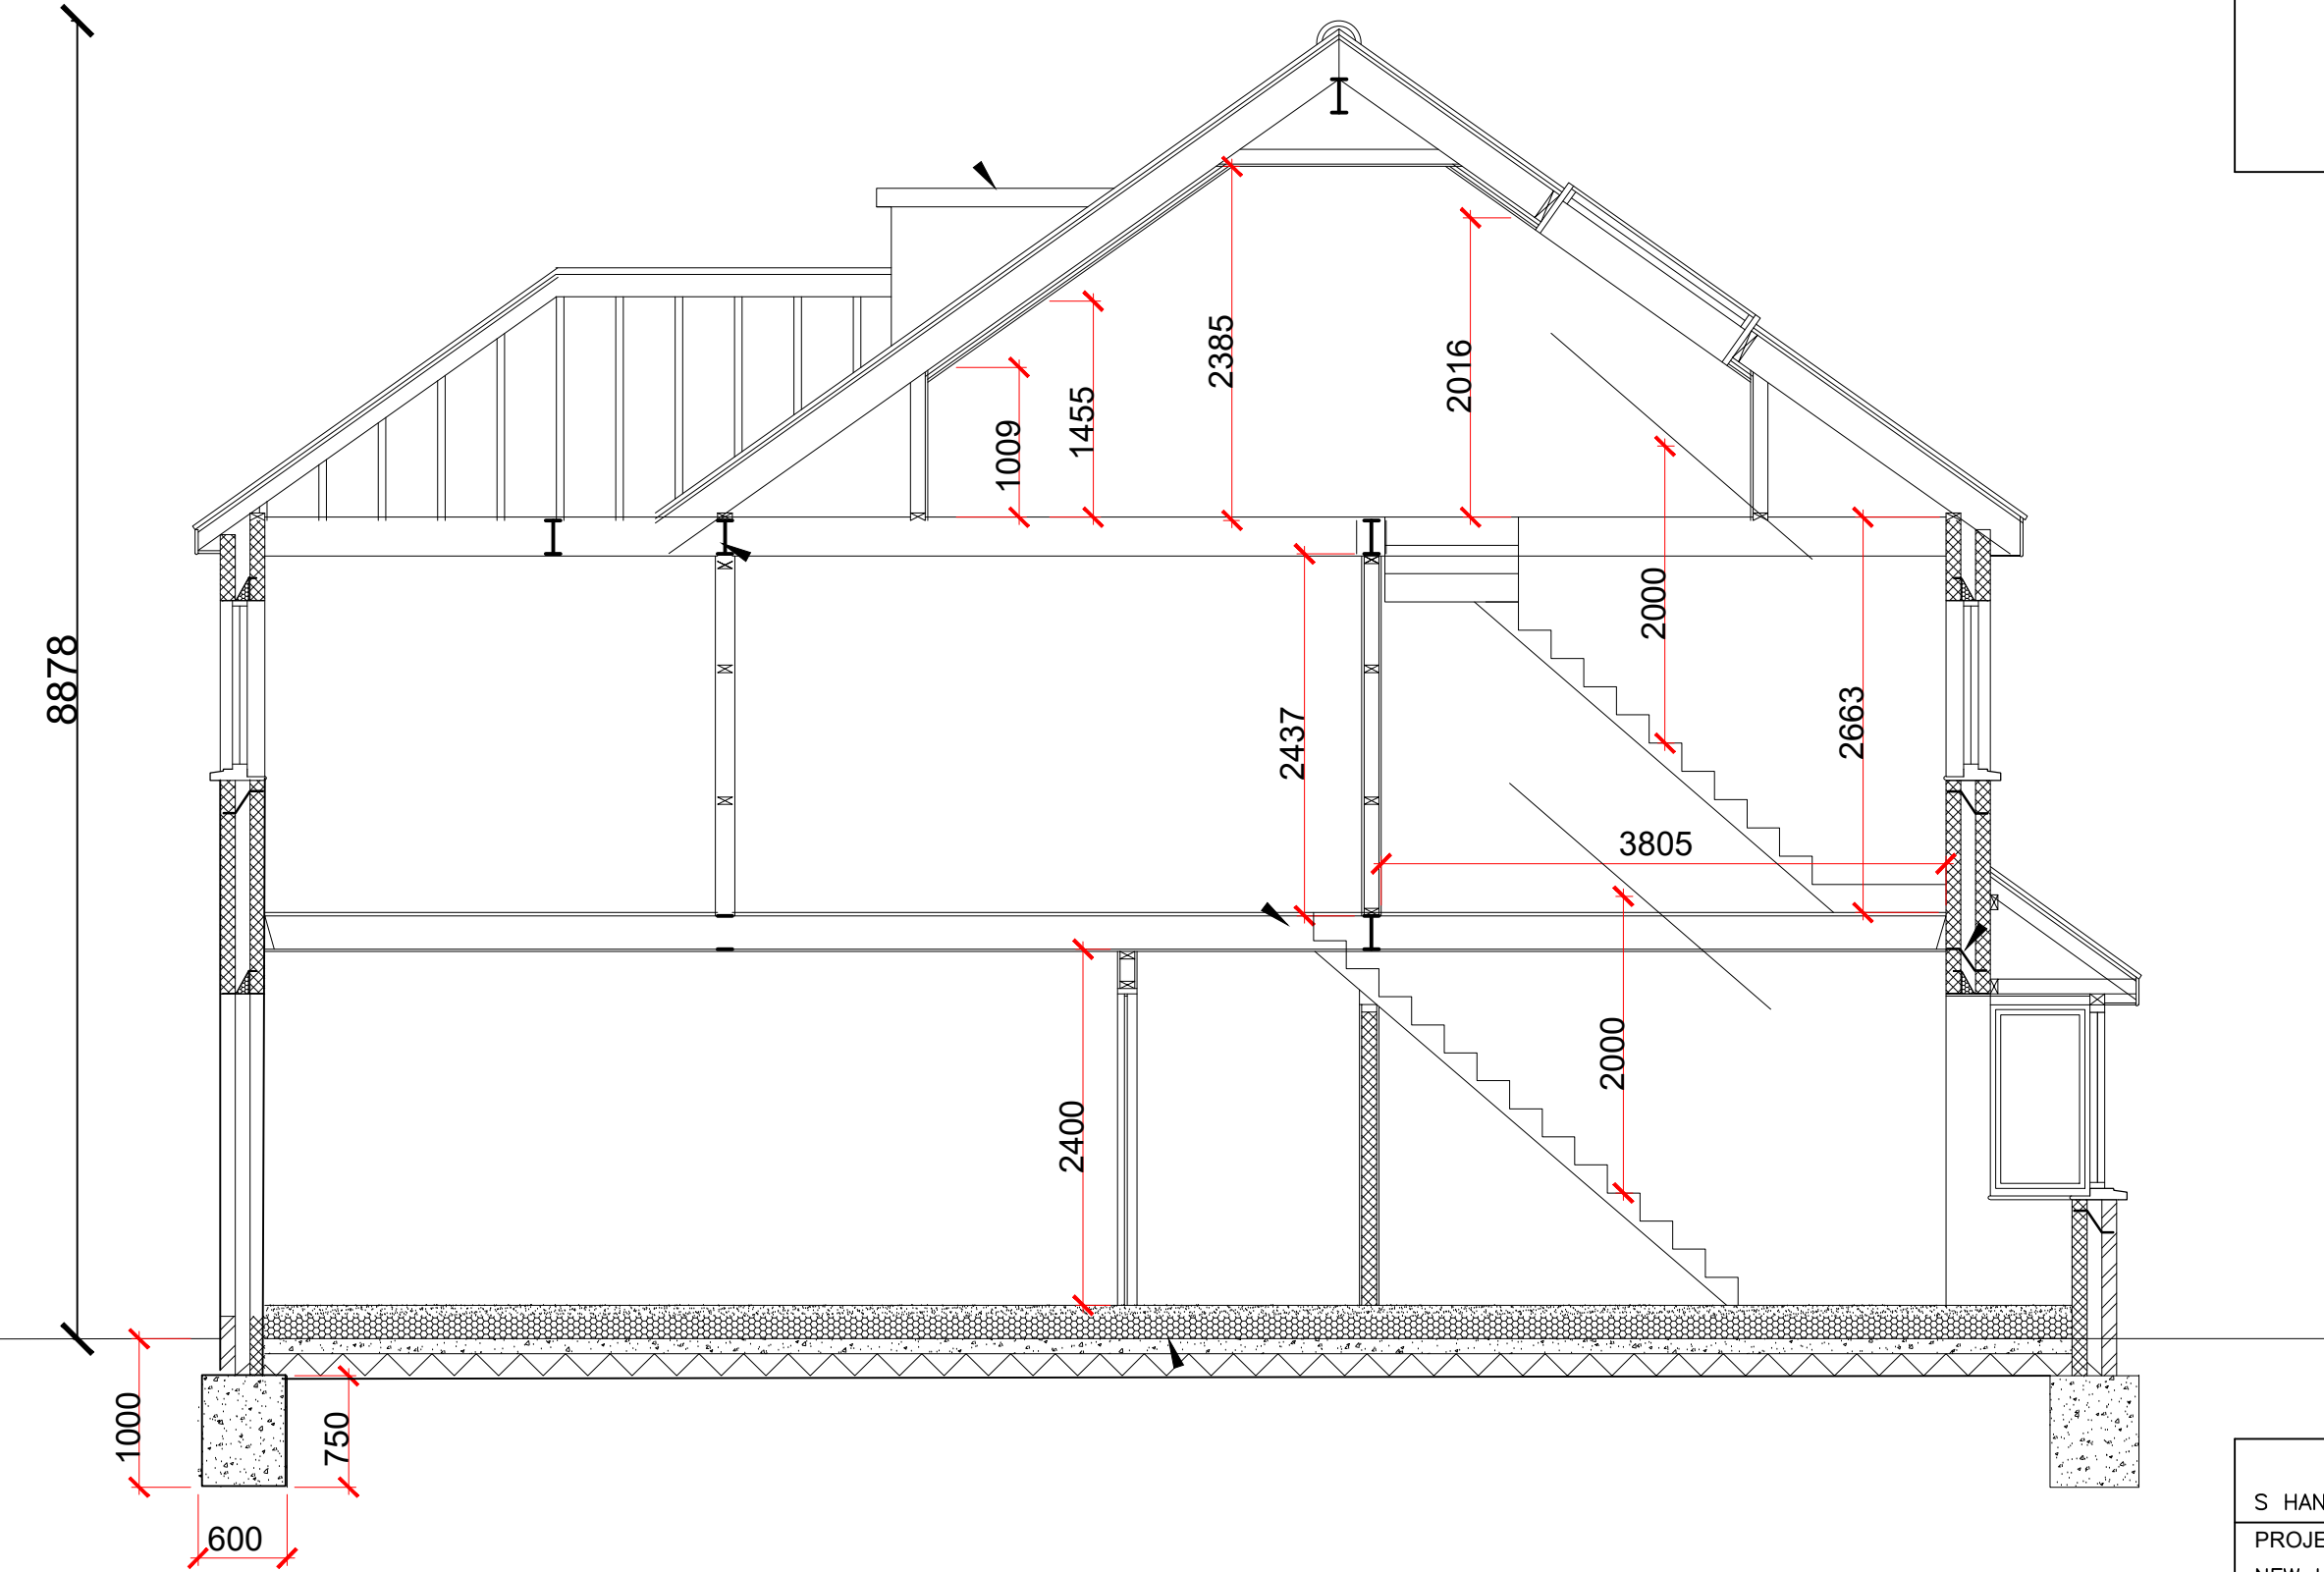

Section A-A

Scale 1:50

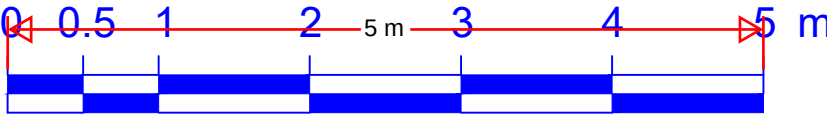

SCALE

S HANSPAL BSc MRICS

PROJECT
NEW HOUSE
FOR MR JOHAL

ADDRESS
LAND BETWEEN
53 AND 55 FORGE LANE
HIGHAM KENT ME3 7AH

DWG No.	SCALE	DATE
FLP.07	1:150 @ A3	MAY 2024