




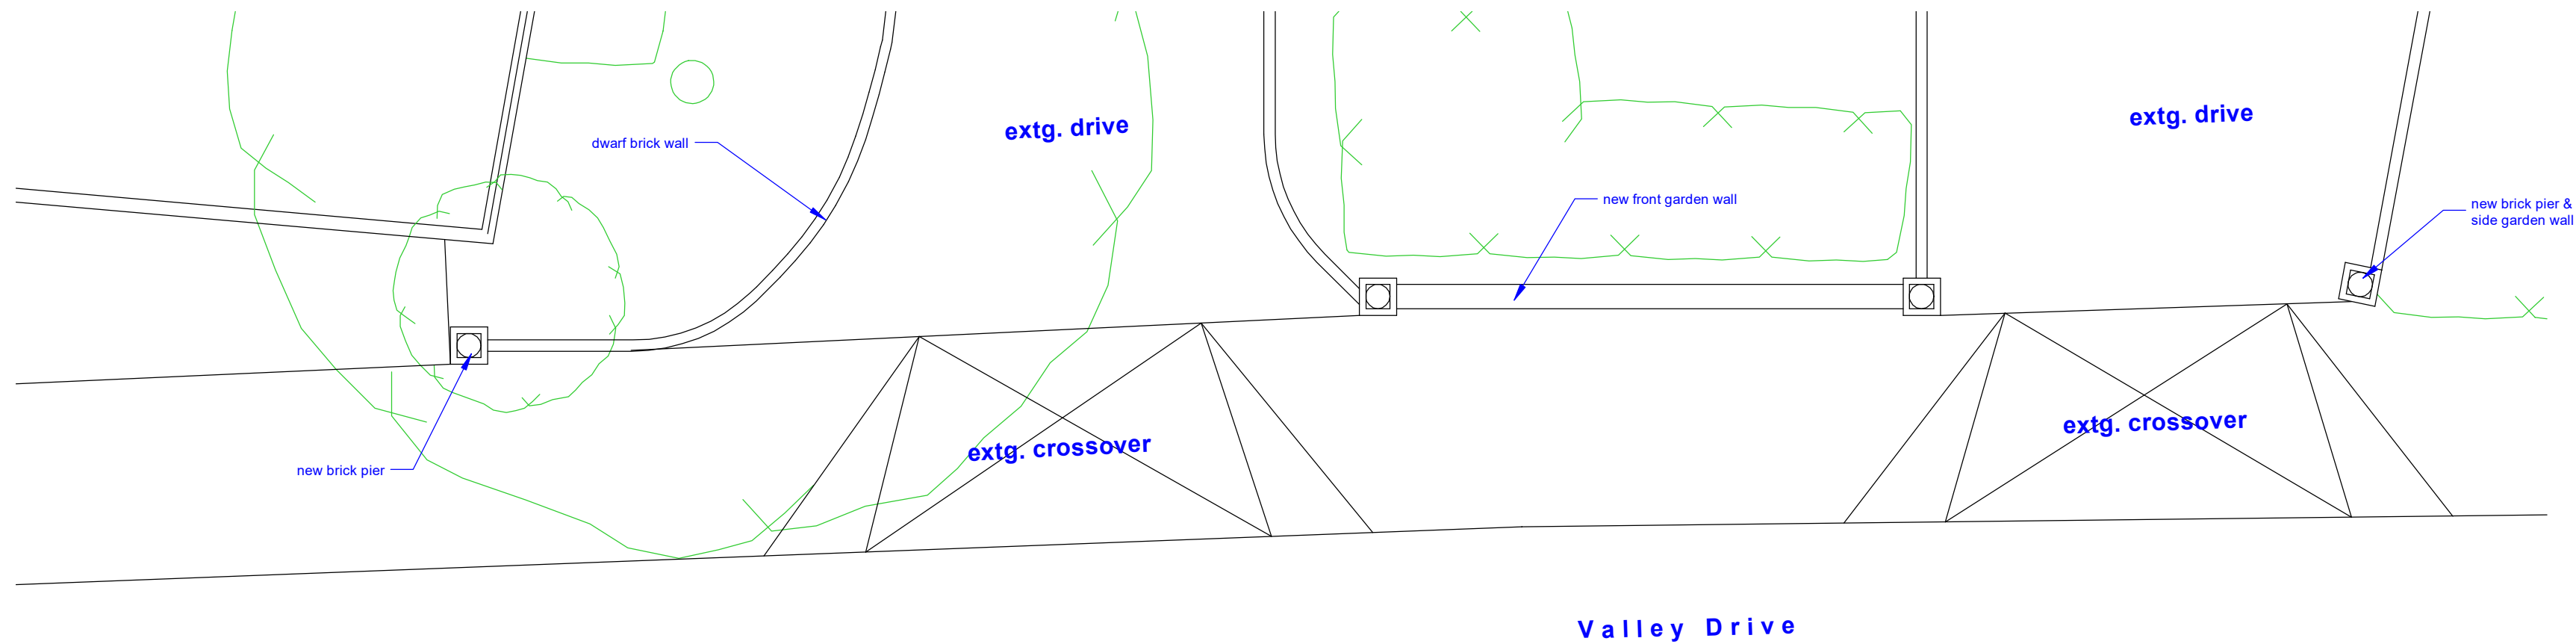

front boundary wall plan as approved under planning reference 20030159

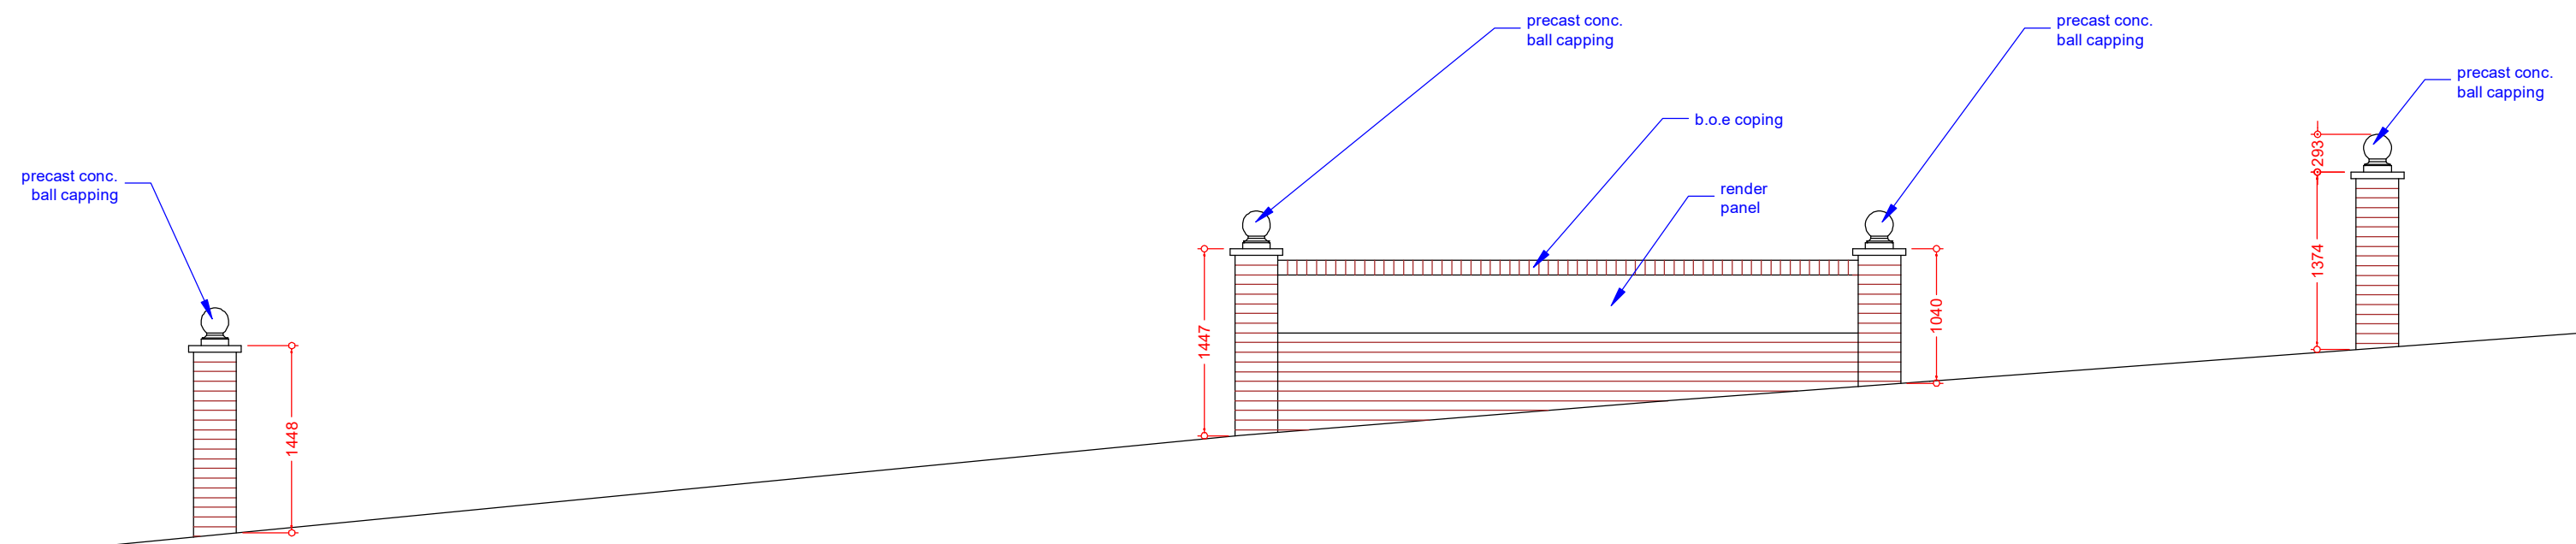


street elevation as approved under planning reference 20030159

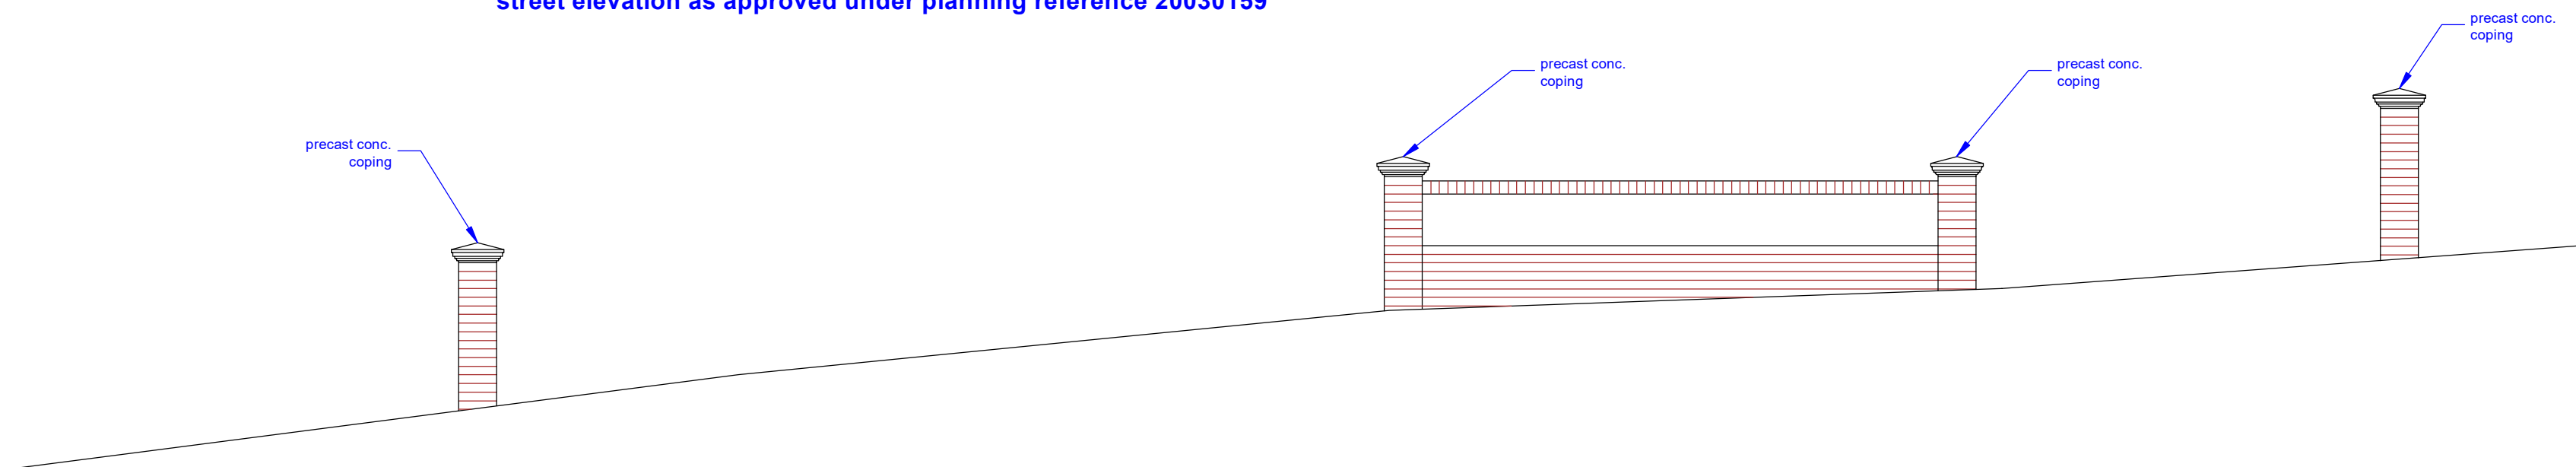

street elevation as built in 2003

This drawing prints A2 @ 1:50

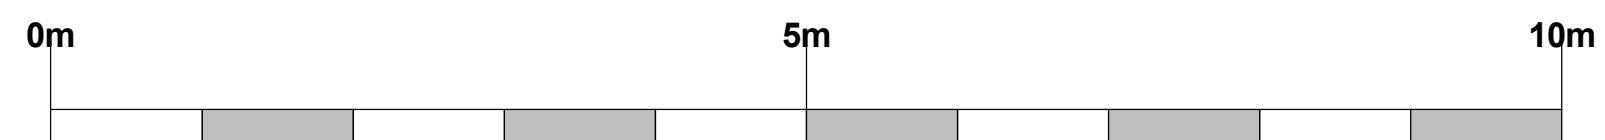

SCHEME / SHEET		
Sunnyside, Valley Drive, Gravesend, DA12 5UE: Dr S & Mr Chaudhry Ahmad Front Boundary Wall As Approved & As Built under Planning Reference 20030159		
Rev. A. Scale Bar Rectified 21Aug23		
SCALE	DATE	DRAWING NUMBER
1:50	August 2023	543/03A
© This drawing remains the property of the Architect and may not be reproduced in whole or part without his written permission.		

JEREMY S. ISHERWOOD B. Sc. (hons), B. Arch. (Wales), R.I.B.A. Chartered Architect 34 Chalky Bank, Gravesend, Kent, DA11 7NY Telephone / Fax: 01474-533793
