


Obscured glazed screen on parapet wall - total height 1.8m min off terrace level

Parapet wall around 2 sides

Railings to same height as parapet wall throughout

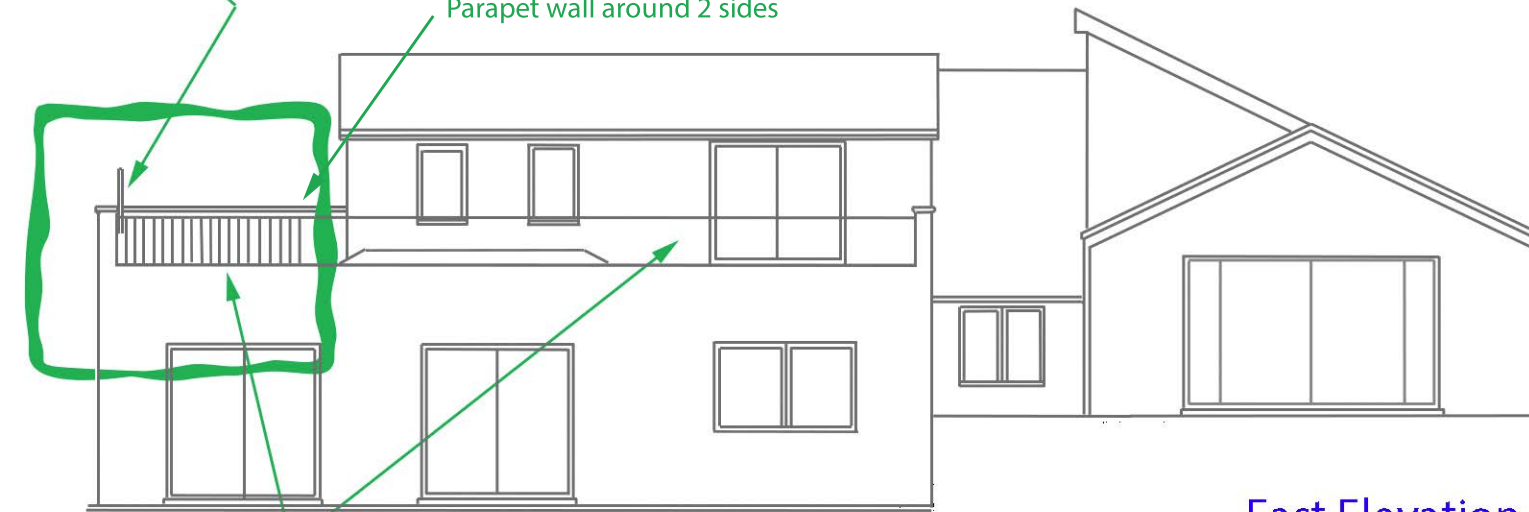

East Elevation



Top eaves of mono-pitch element beyond

Roof inset

hipped roof


Roof profile changed
Chimney with flue (external)

Protruding eaves


Obscure glazed screen as above

Parapet wall around end and side of terrace/patio

Decking

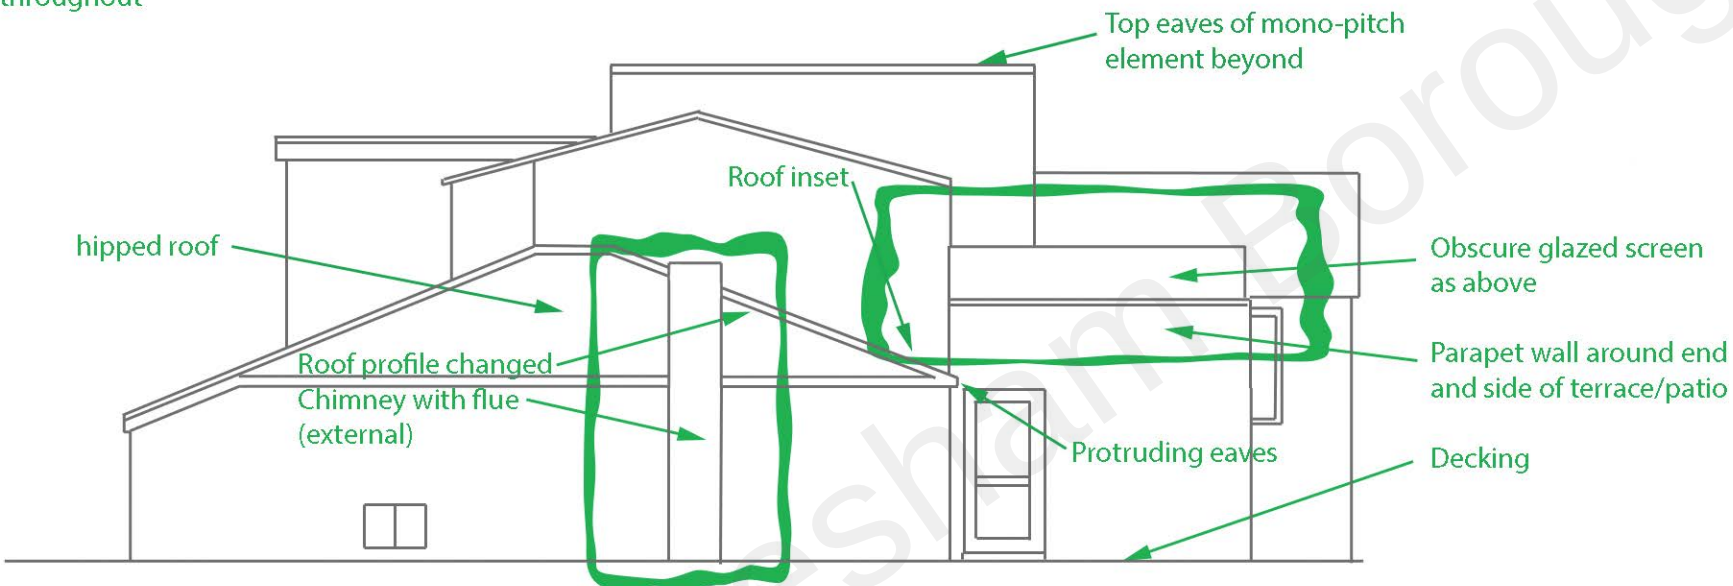

South Elevation

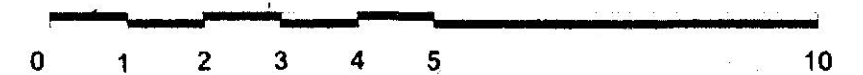

NOTES:

Planning Drawing Only

All dimensions must be checked on site

Client

c/o Agent

Job Title

41A Forge Lane

Scale

1:100@A3L

Drawn by

MS

Date

SEP2021

Drawing Title

As Built S&E Elevations

Drg No.

0795.P.0702

Rev

A