




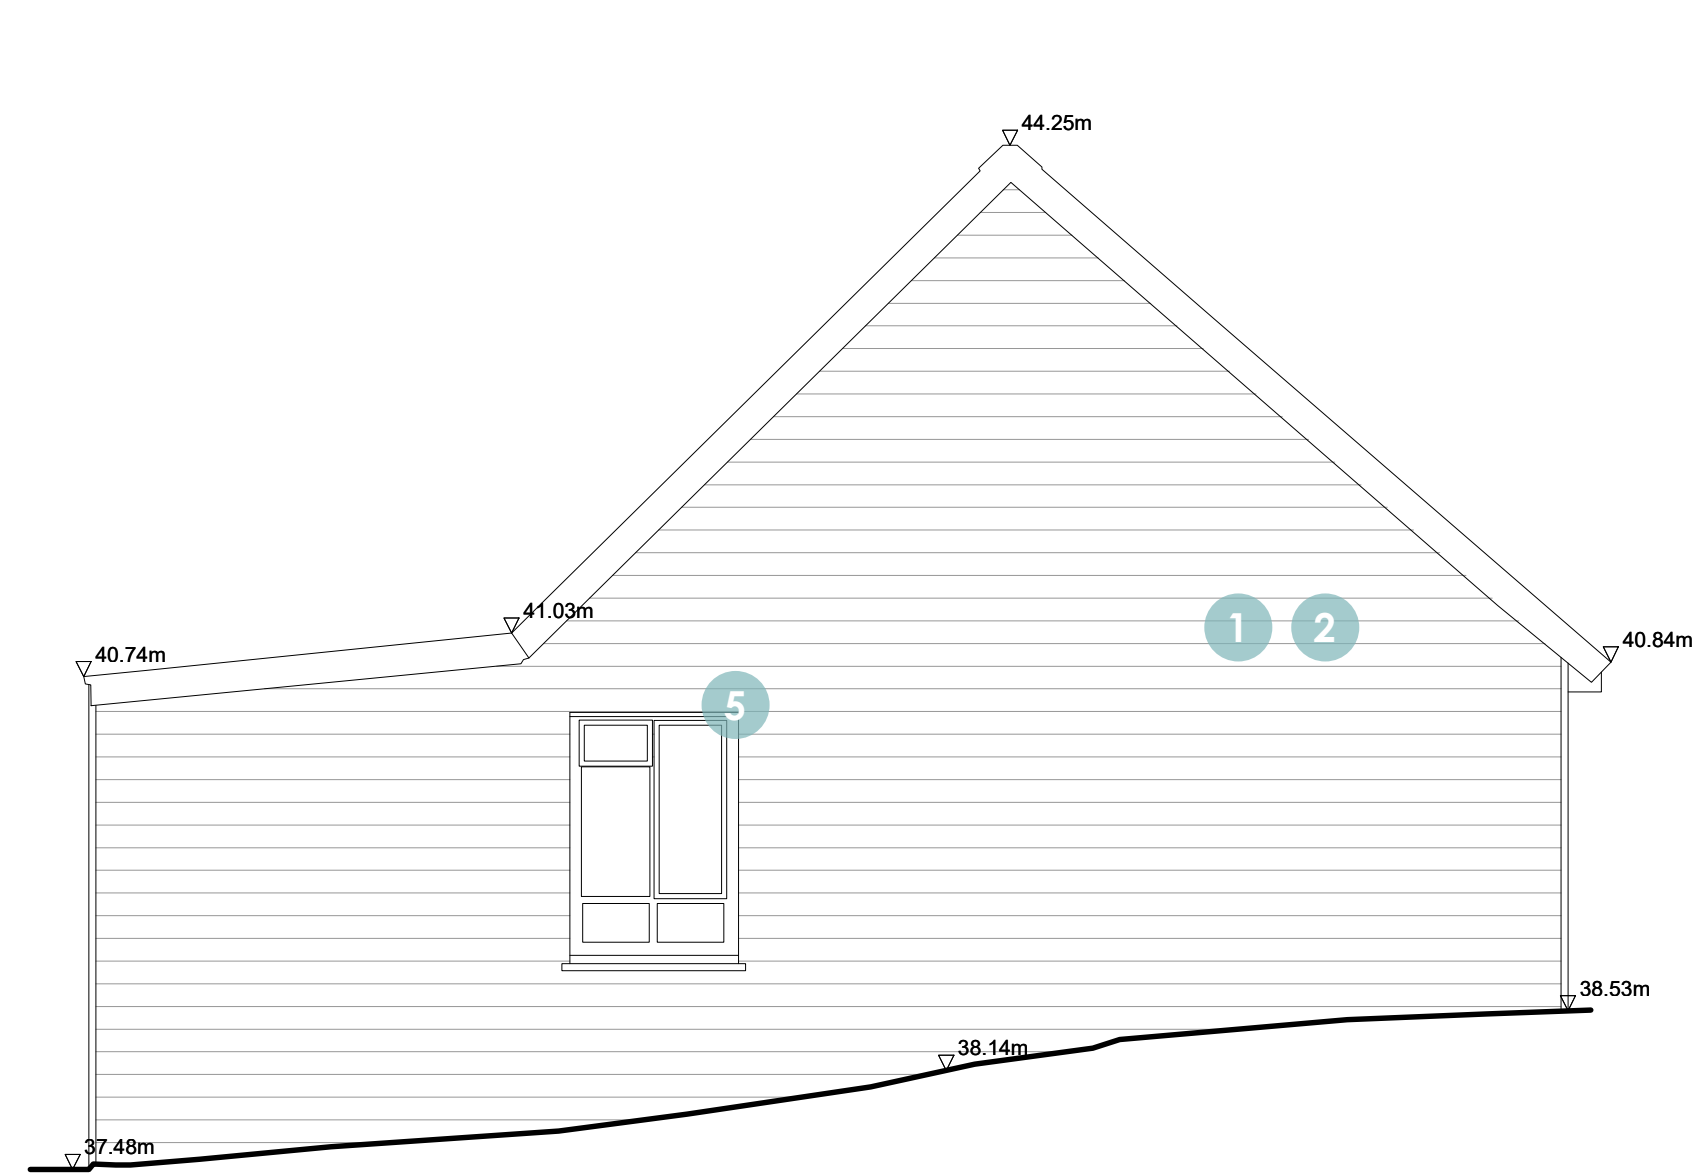


Proposed Elevation 18 as constructed

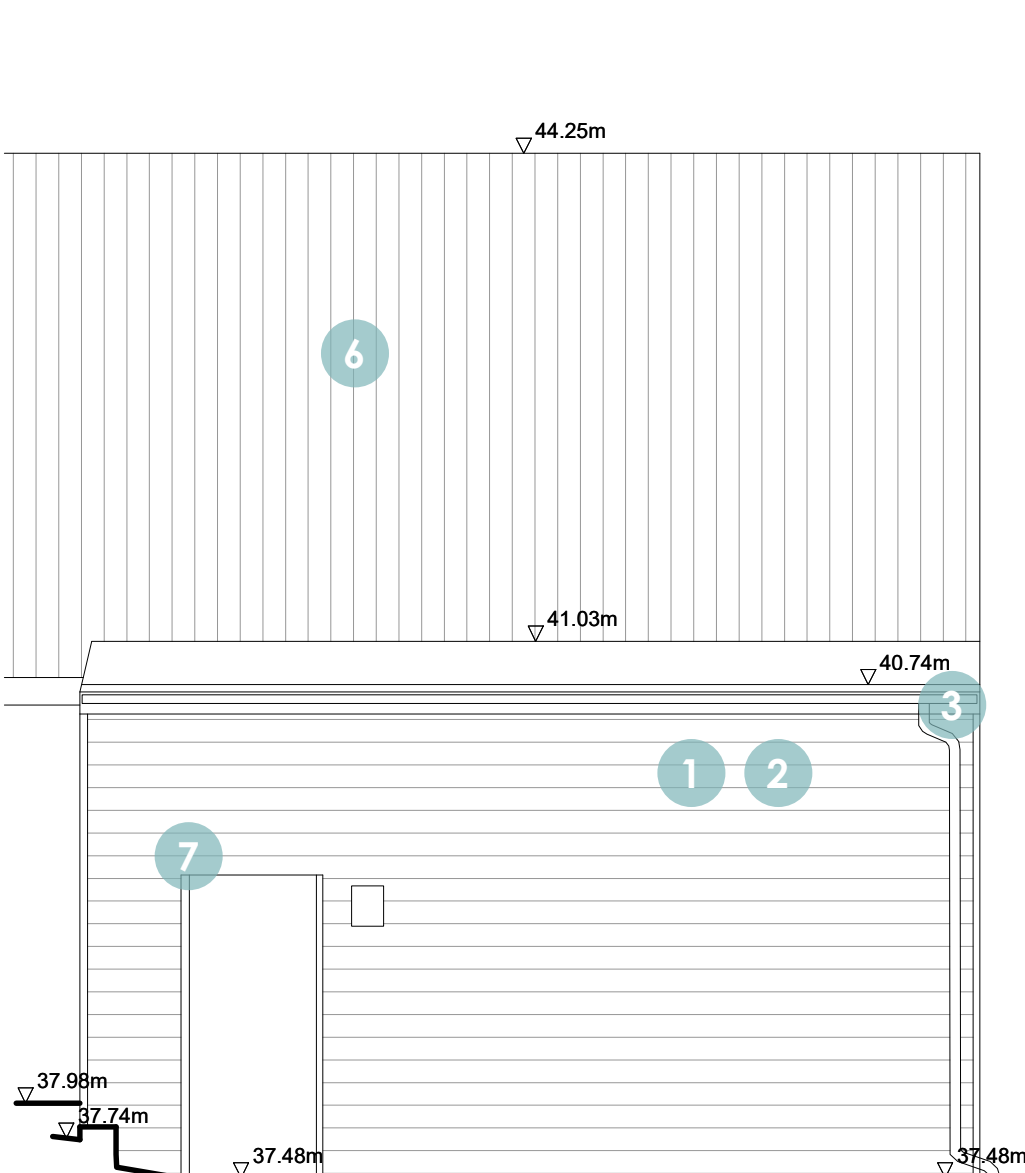

Proposed Elevation 19 as constructed

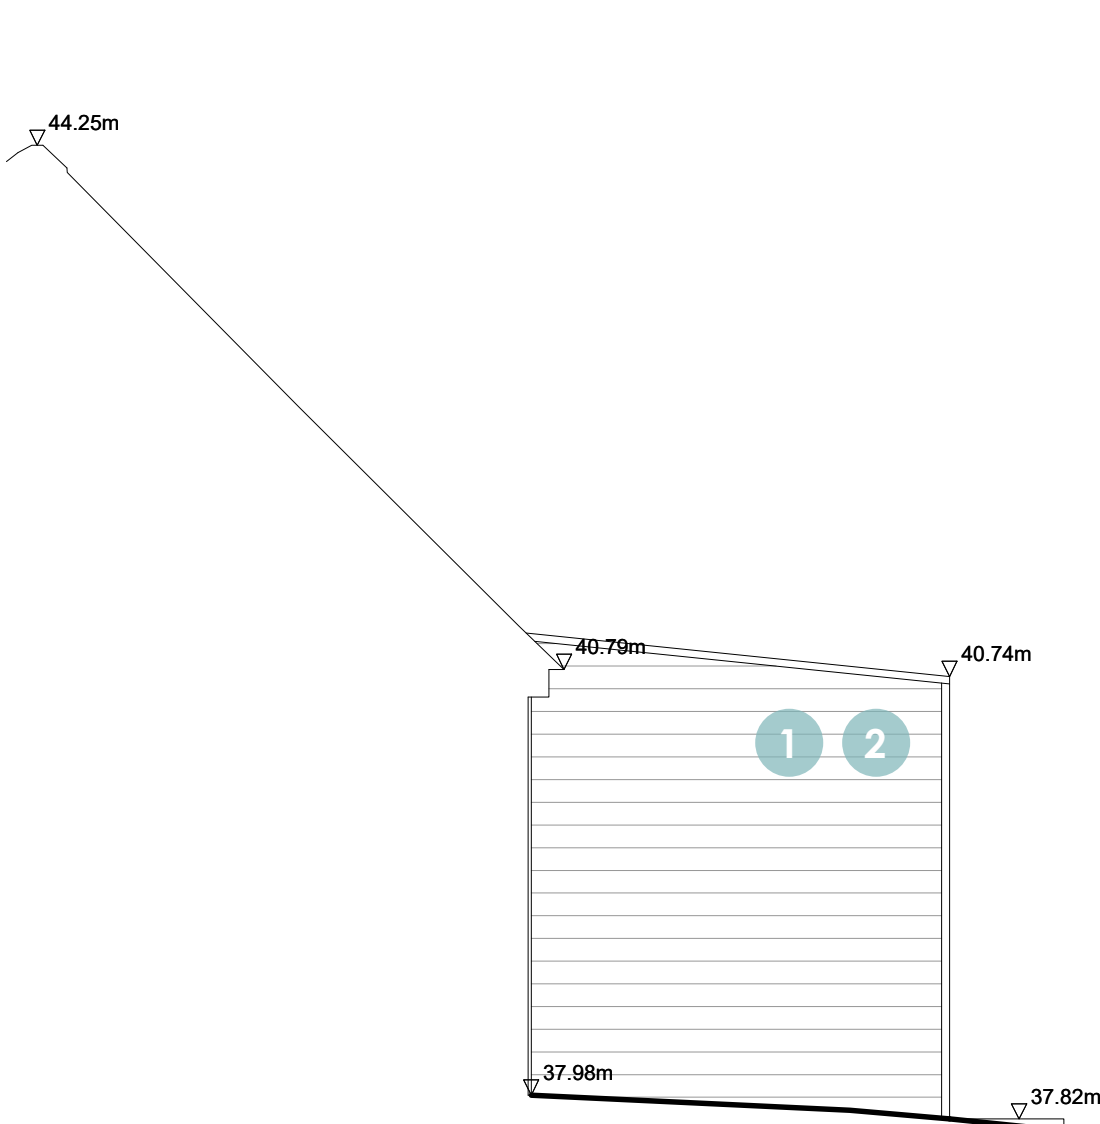

Proposed Elevation 20 as constructed

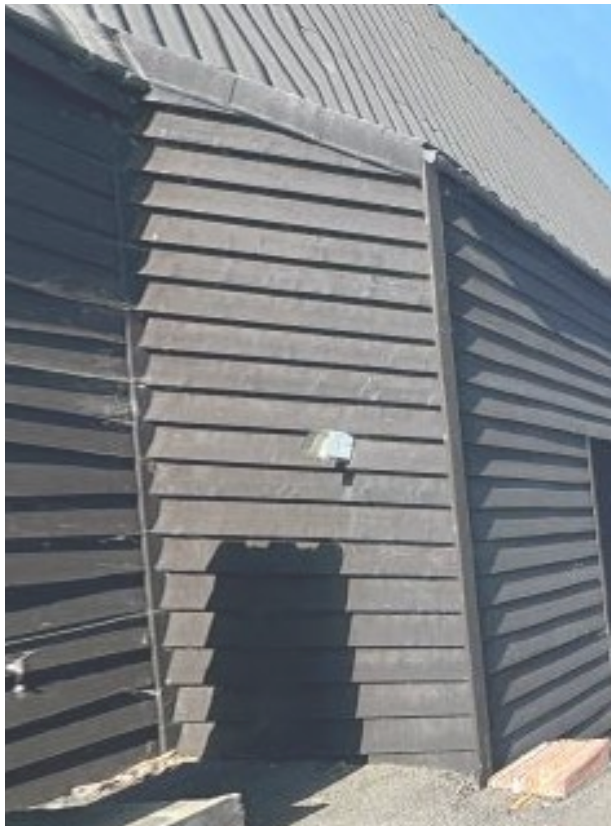

This drawing and the design are the copyright of **ON Architecture Ltd only**.  
This drawing should not be copied or reproduced without written consent.

All dimensions are to be checked on site prior to setting out and fabrication and **ON Architecture Ltd** should be notified of any discrepancy prior to proceeding further.

For Construction & Fabrication Purposes - Do not scale from this drawing, use only the illustrated dimensions herein. Additional dimensions are to be requested and checked directly.


Illustrated information from 3rd party consultants/specialists is shown as indicatively only. See other consultant / specialist drawings for full information and detail.

All aspects of the architectural design concerning fire performance / fire safety (whether or not illustrated / annotated) are to be considered as For Approval only, irrespective of the drawing status / suitability.

Scale: 1:50


0 1 3 5m

Key:

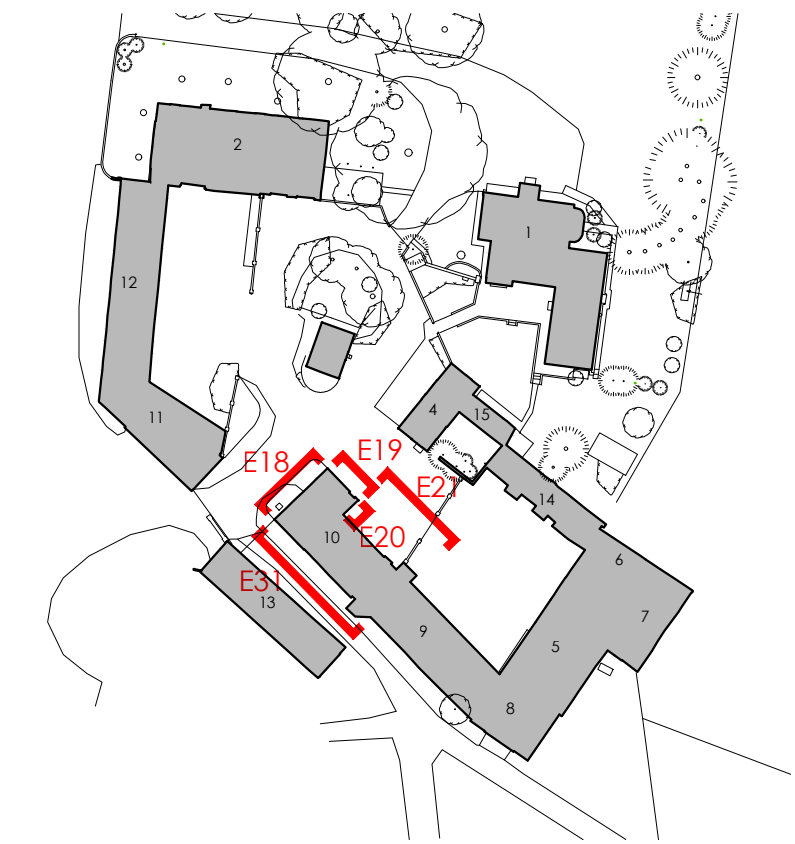


Materials:


- 1 Pre-treated black / feather-edge timber cladding
- 2 Blackbird paint
- 3 FloPlast uPVC guttering
- 4 Flint wall repaired using lime mortar mix (area of repair highlighted)
- 5 Black aluminium window frames
- 6 Onduline corrugated roof
- 7 Black ledger & braced, ply face door

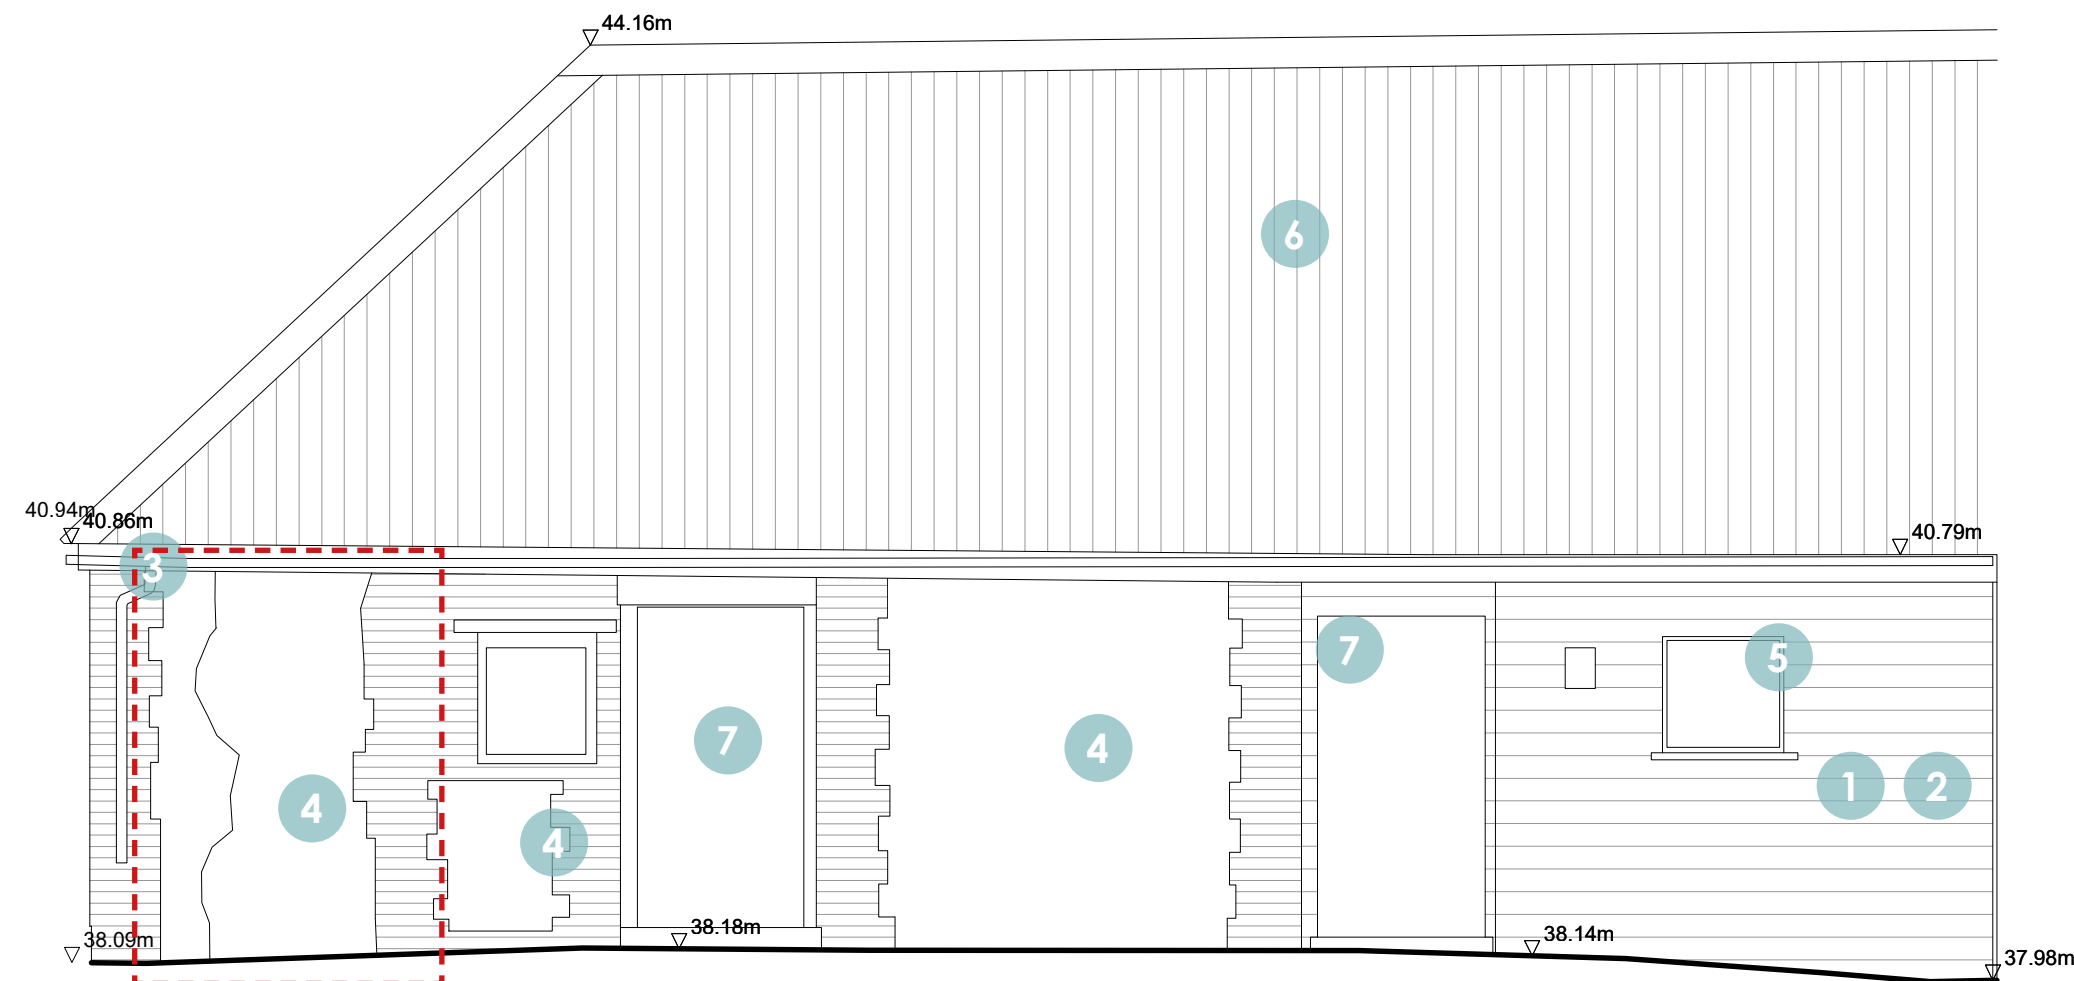

Proposed Elevation 21 as constructed

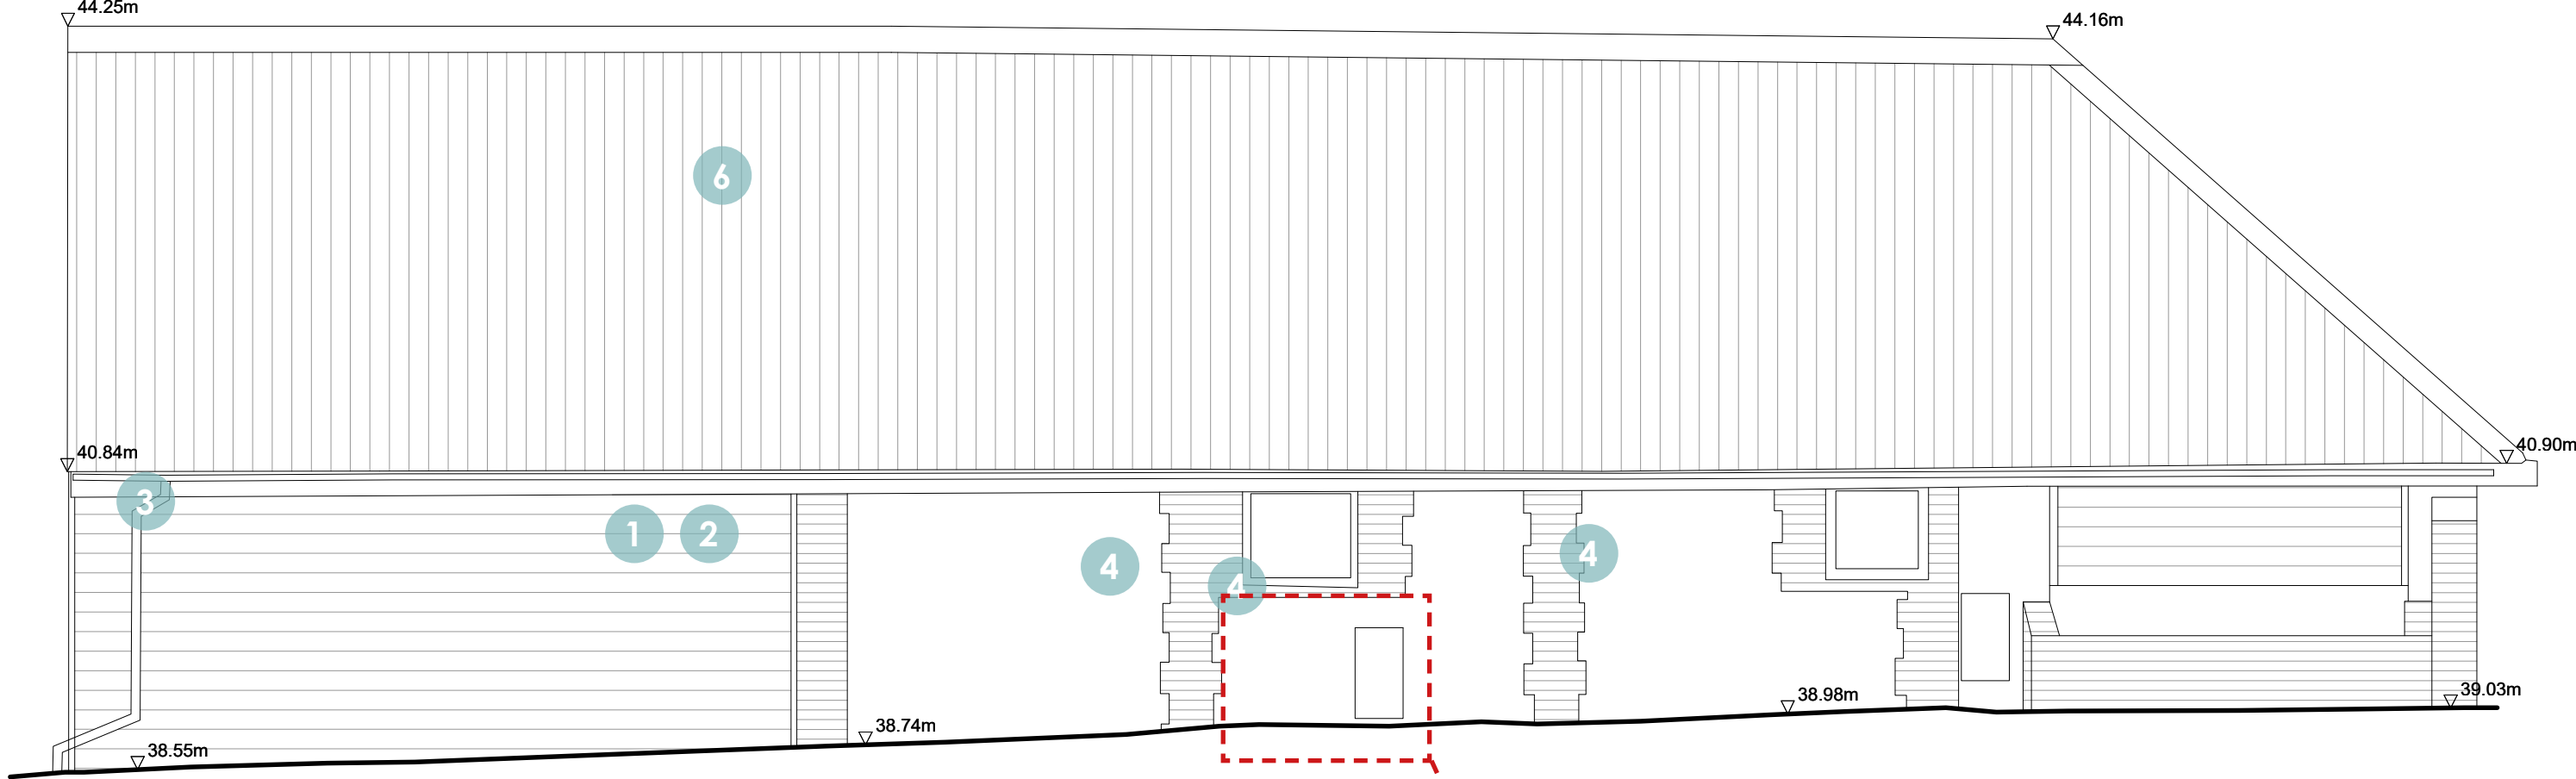

Proposed Elevation 31 as constructed

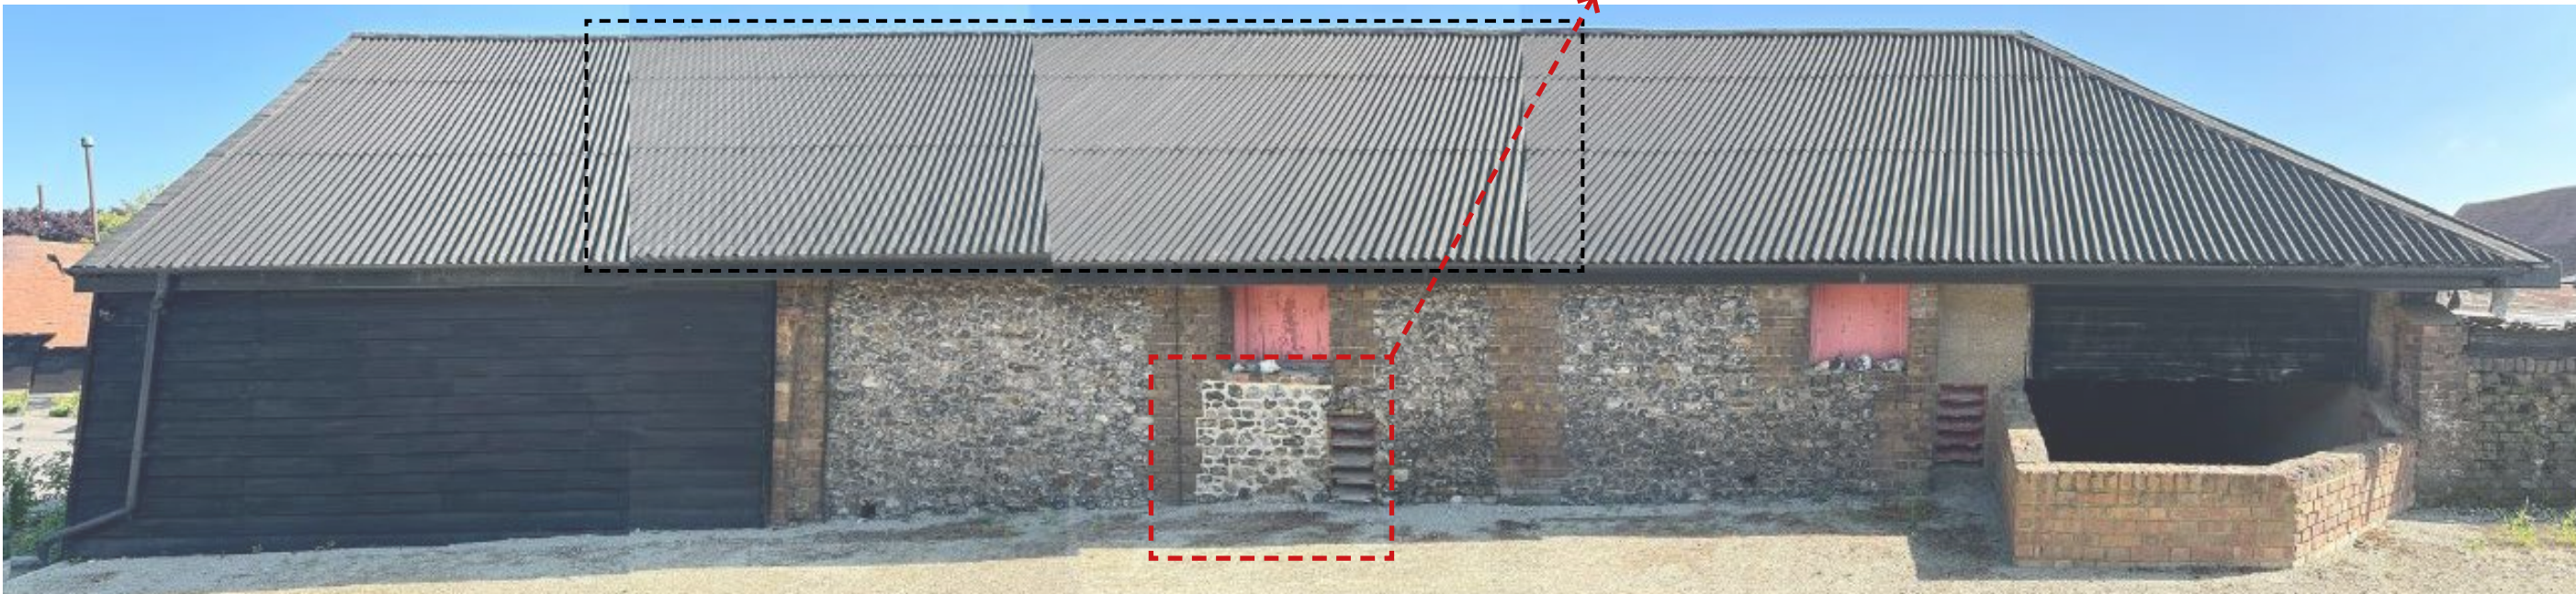

All survey drawings produced by OmegaGeo  
Please refer to Job Ref. 2414908, Drawing no. 1 of 3 and 3 of 3 for further details

| Revision Note & Date |            | Note               |  | Amended | Checked |
|----------------------|------------|--------------------|--|---------|---------|
| Rev                  | Date       |                    |  |         |         |
| P1                   | 04/07/2024 | ANNOTATION UPDATED |  | JR      |         |

**ON**  
ARCH  
ITECT  
URE

Canterbury Studio  
Logan House, St Andrews Close  
Canterbury,  
CT1 2RP

info@onarchitecture.co.uk  
onarchitecture.co.uk  
01227 634334

Project Title  
WHITEHOUSE FARM, LAND WAY

Client's Details  
WINDMILL CONSTRUCTION

Drawing Title  
BUILDING 10 - PROPOSED ELEVATIONS  
AS CONSTRUCTED

BM Number  
24.051-ONA-ZZ-XX-DR-A - 0301.000

Scale Date Drawn Checked  
1:50 @ A1 MAY 2024 IH JR

Drawing Status  
PLANNING

Project No. Drawing No. Status Revision  
24.051 0301.000 P 1