




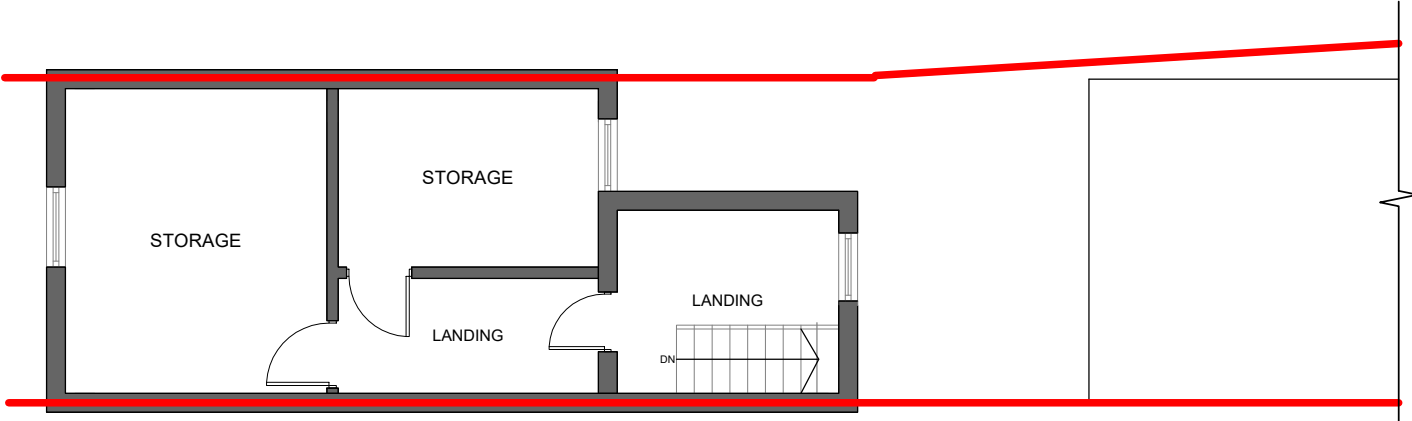


EXISTING
FIRST FLOOR PLAN

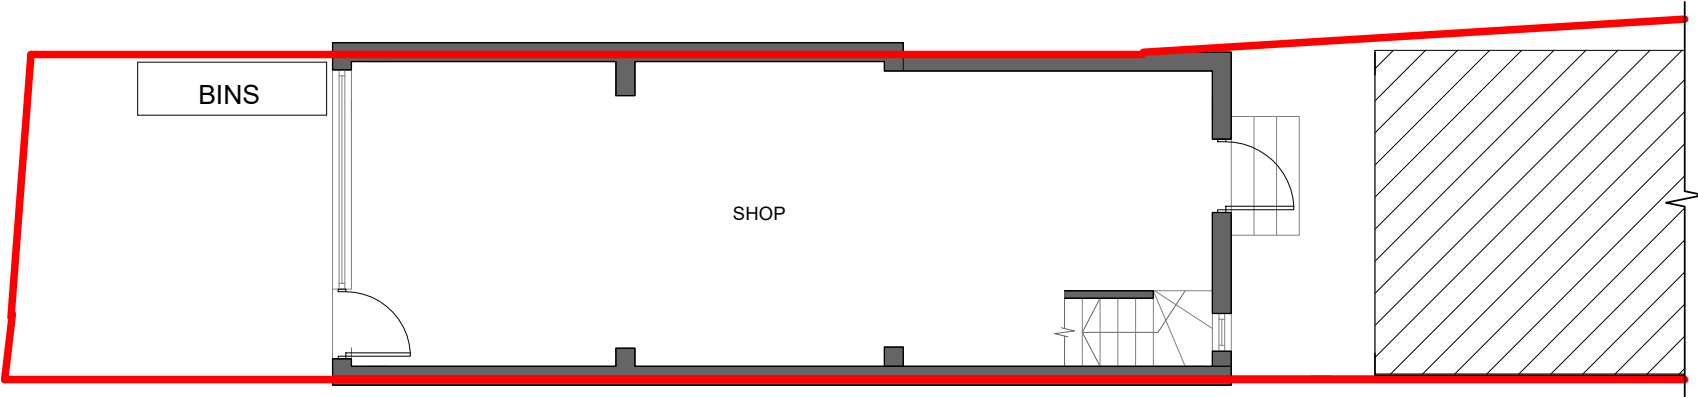

EXISTING
GROUND FLOOR PLAN

Existing Plans (As Built)
1 : 100

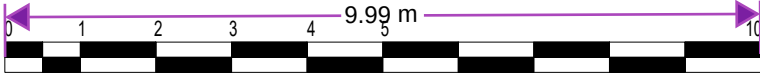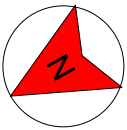

GRAPHIC SCALE: 1:100

No .	Description	Date	6 Stonebridge Rd, Northfleet, Gravesend DA11 9DR	Client		REF	REV
				Mr R Mathusan		.	
			Existing Plans	Date Apr 2025	Sheet number PL/6SR/SD100	Scale (@ A3) 1 : 100	
				Drawn MMK	Sanaa Designs Email - sanaadesigns@outlook.com Mobile - 07583 437570		
				Checked by TK			