



- Do not scale from this drawing.
- All dimensions to be verified on site and is in mm.
- Builder to verify all dimensions, heights and levels prior to commencement of work.
- All documents shall be checked to ensure that they are compatible by the contractor before construction commences. In the event of apparent ambiguity or contradiction the engineer and/ or architect shall be notified immediately.
- The contractor in preparing his estimate shall visit the site and acquaint himself with the problems involved.
- The contractor shall issue all statutory notices to the local Authority during progress completion of works.

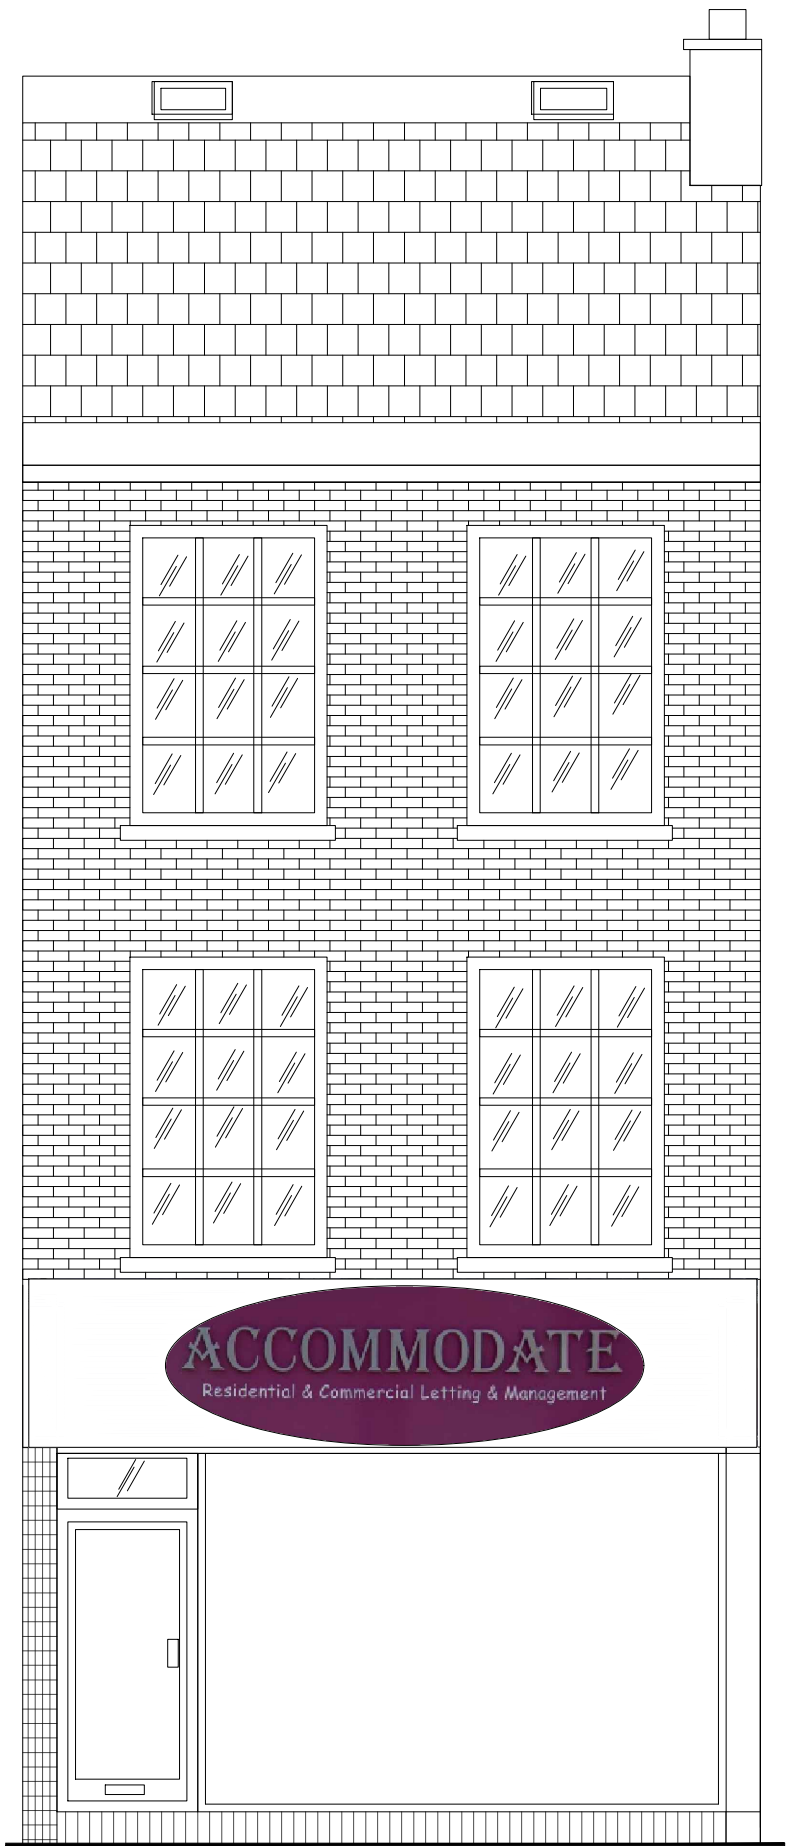

Pre-Existing Front Elevation

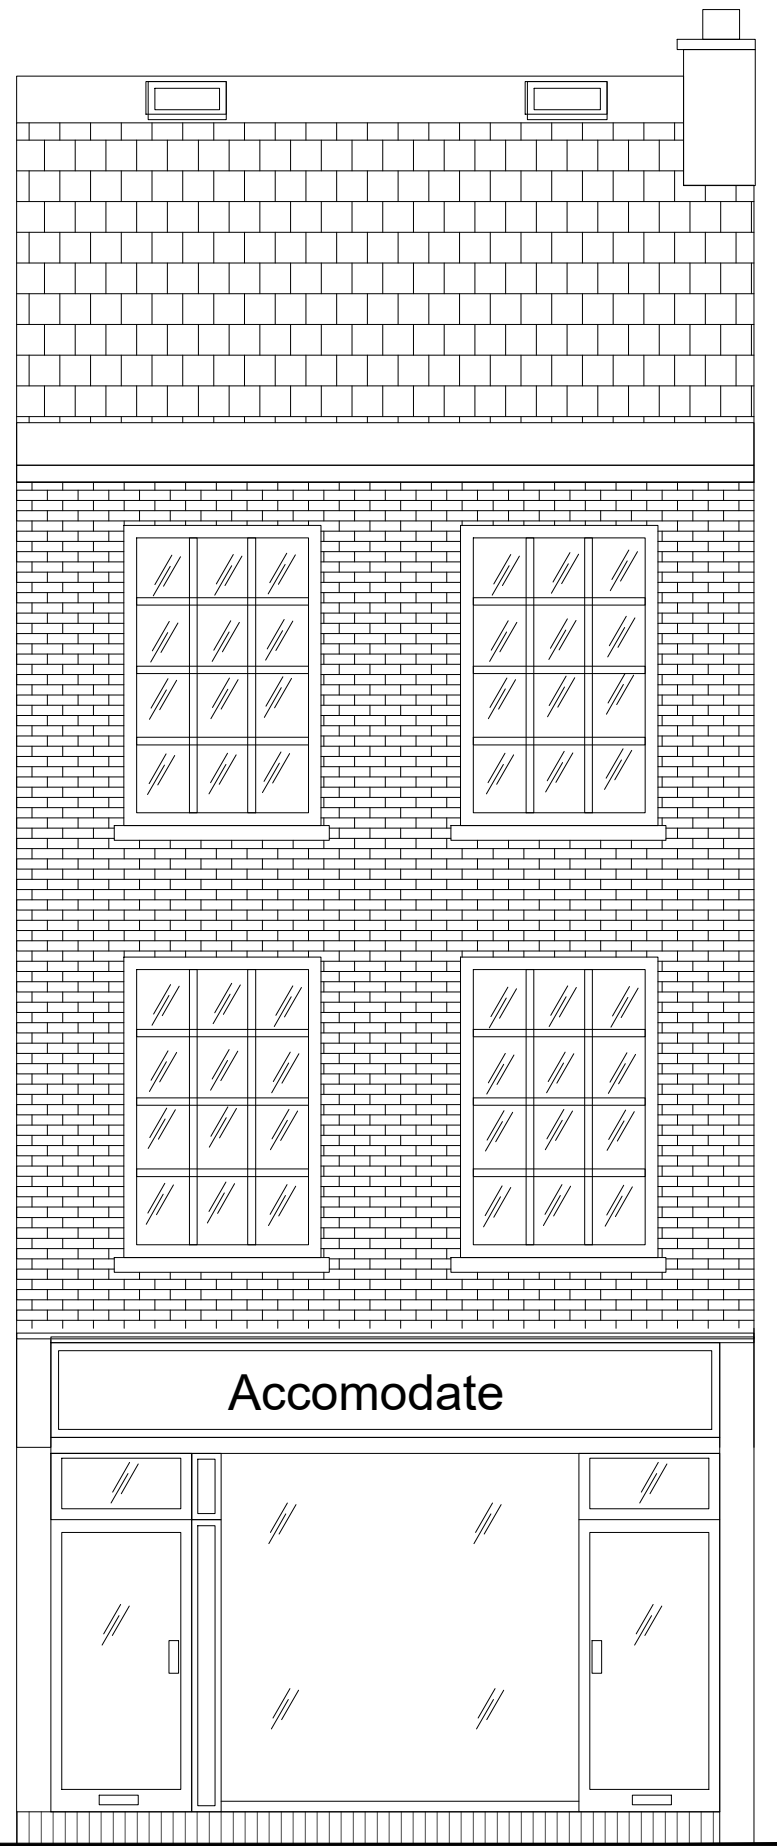

Existing Front Elevation(as built)



A	-	-	-/-/-
REV:	DESCRIPTION:	BY:	DATE:

STATUS: PLANNING

BARRON
EDWARDS
STERLING

Whitehall Place
47 The Terrace,
Gravesend, Kent
DA12 2DL
01474 247 787
info@barronedwards.co.uk
www.barronedwards.co.uk

SITE:
163 Windmill Street
Gravesend
Kent
DA12 1AH

TITLE:
Elevations

SCALE AT A2: 1:50	DATE: 01/03/2023	DRAWN: HH/GK
PROJECT NO: 220202	DRAWING NO: 003	REVISION: A