




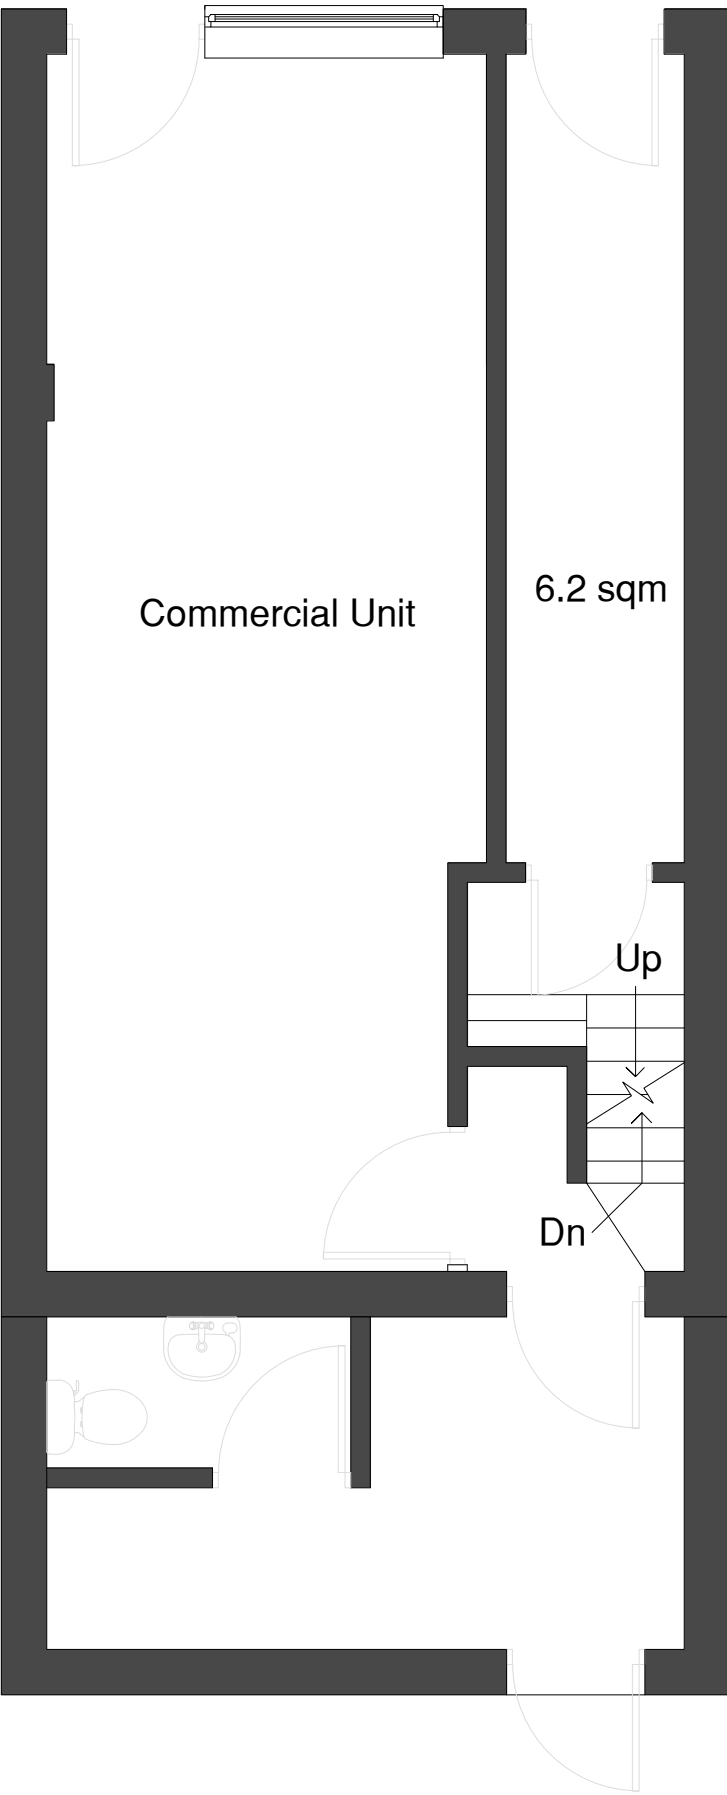


Existing Ground Floor Plan

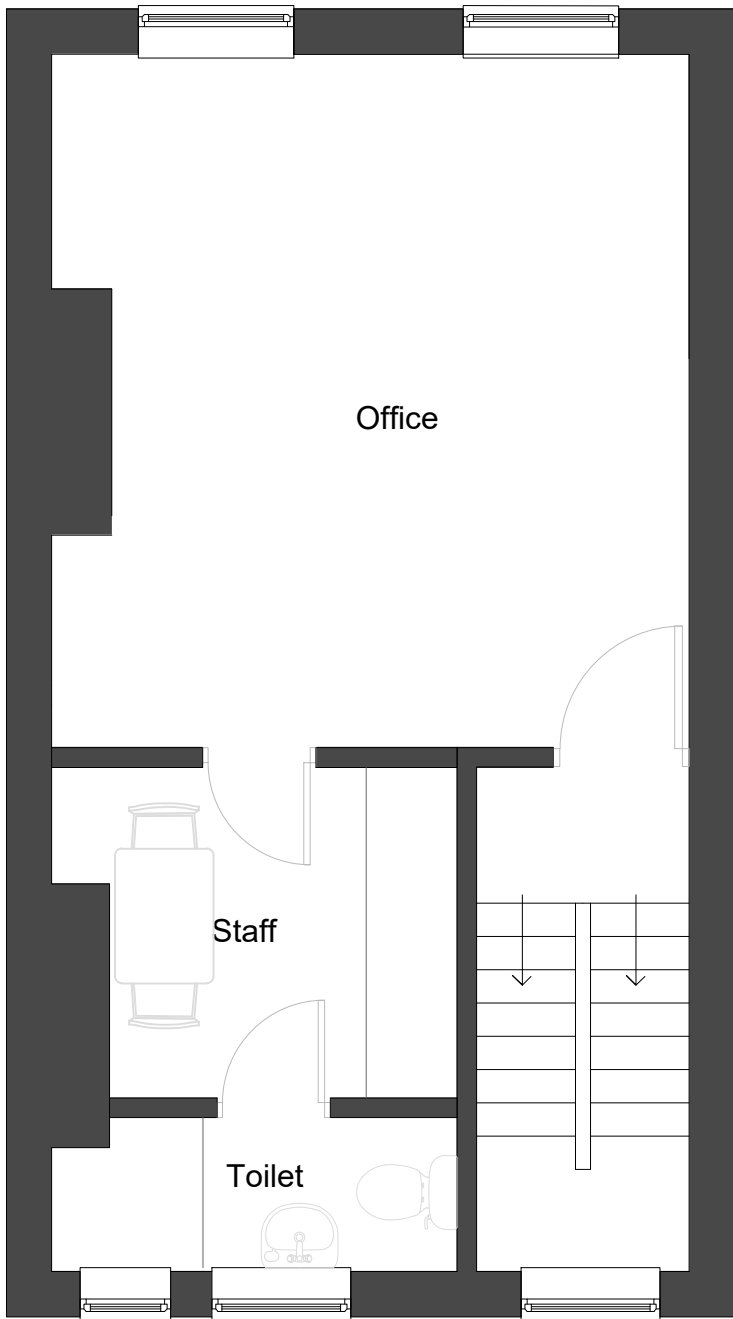

Existing First Floor Plan (as built)

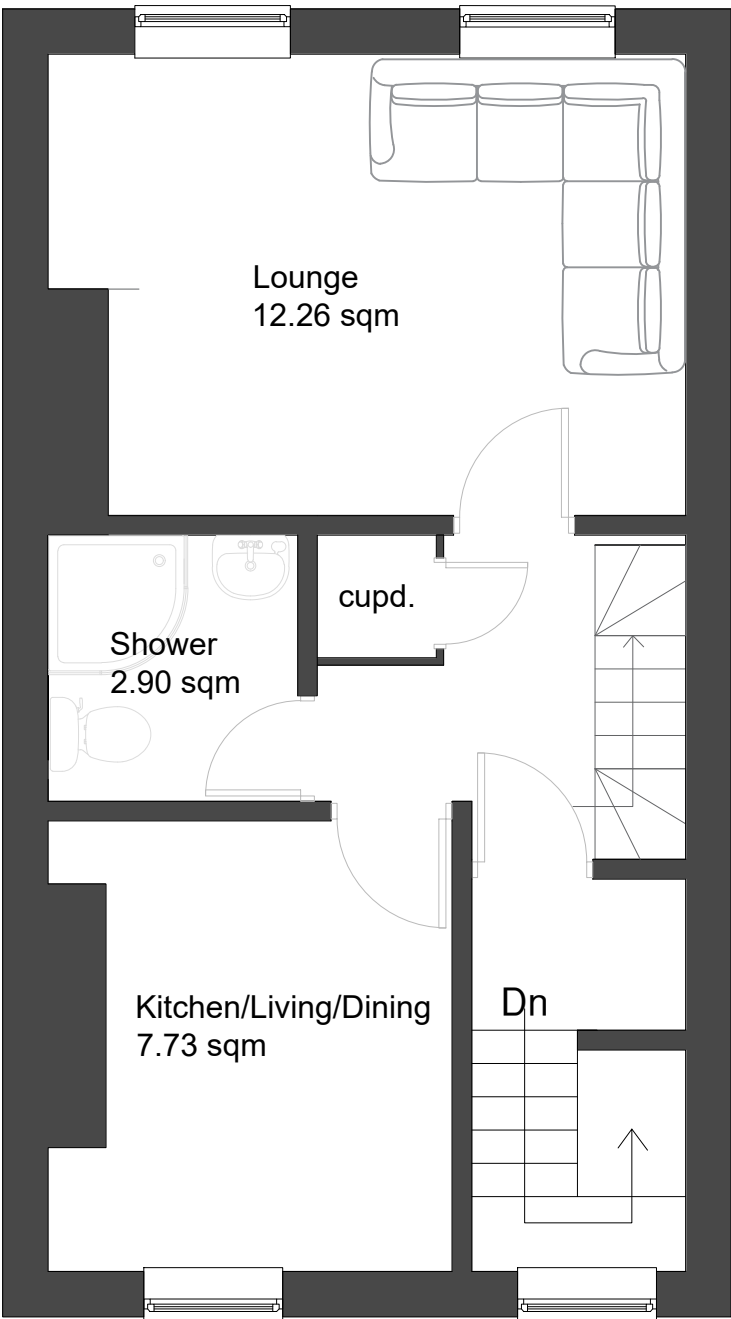

Existing Second Floor Plan (as built)

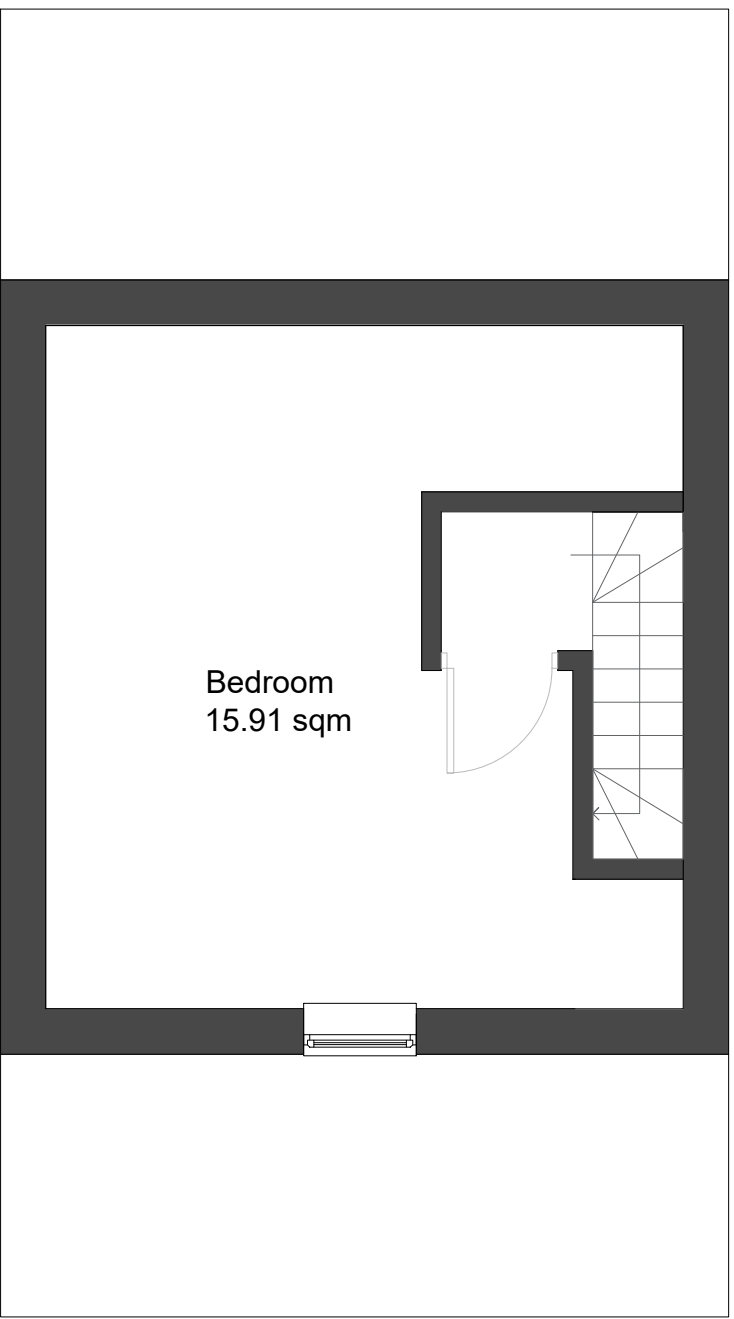

Existing Loft Floor Plan (as built)

Notes:

- Do not scale from this drawing.
- All dimensions to be verified on site and is in mm.
- Builder to verify all dimensions, heights and levels prior to commencement of work.
- All documents shall be checked to ensure that they are compatible by the contractor before construction commences. In the event of apparent ambiguity or contradiction the engineer and/ or architect shall be notified immediately.
- The contractor in preparing his estimate shall visit the site and acquaint himself with the problems involved.
- The contractor shall issue all statutory notices to the local Authority during progress and completion of works.

A	-	-	-/-/-
REV:	DESCRIPTION:	BY:	DATE:

STATUS: PLANNING

Whitehall Place
47 The Terrace,
Gravesend, Kent
DA12 2DL
01474 247 787
info@barronedwards.co.uk
www.barronedwards.co.uk

SITE:	163 Windmill Street Gravesend Kent DA12 1AH
TITLE:	Existing As Built Floor Plans ----- -----

SCALE AT A2: 1:50	DATE: 27/02/2023	DRAWN: GK/SA
PROJECT NO: -----	DRAWING NO: 002	REVISION: B

